


Tree Removal	
Size	N ₂
18"	4

old CFN 184800798
new CFN 1884802
SLM 7.98, 54"
SEE SHEET 117

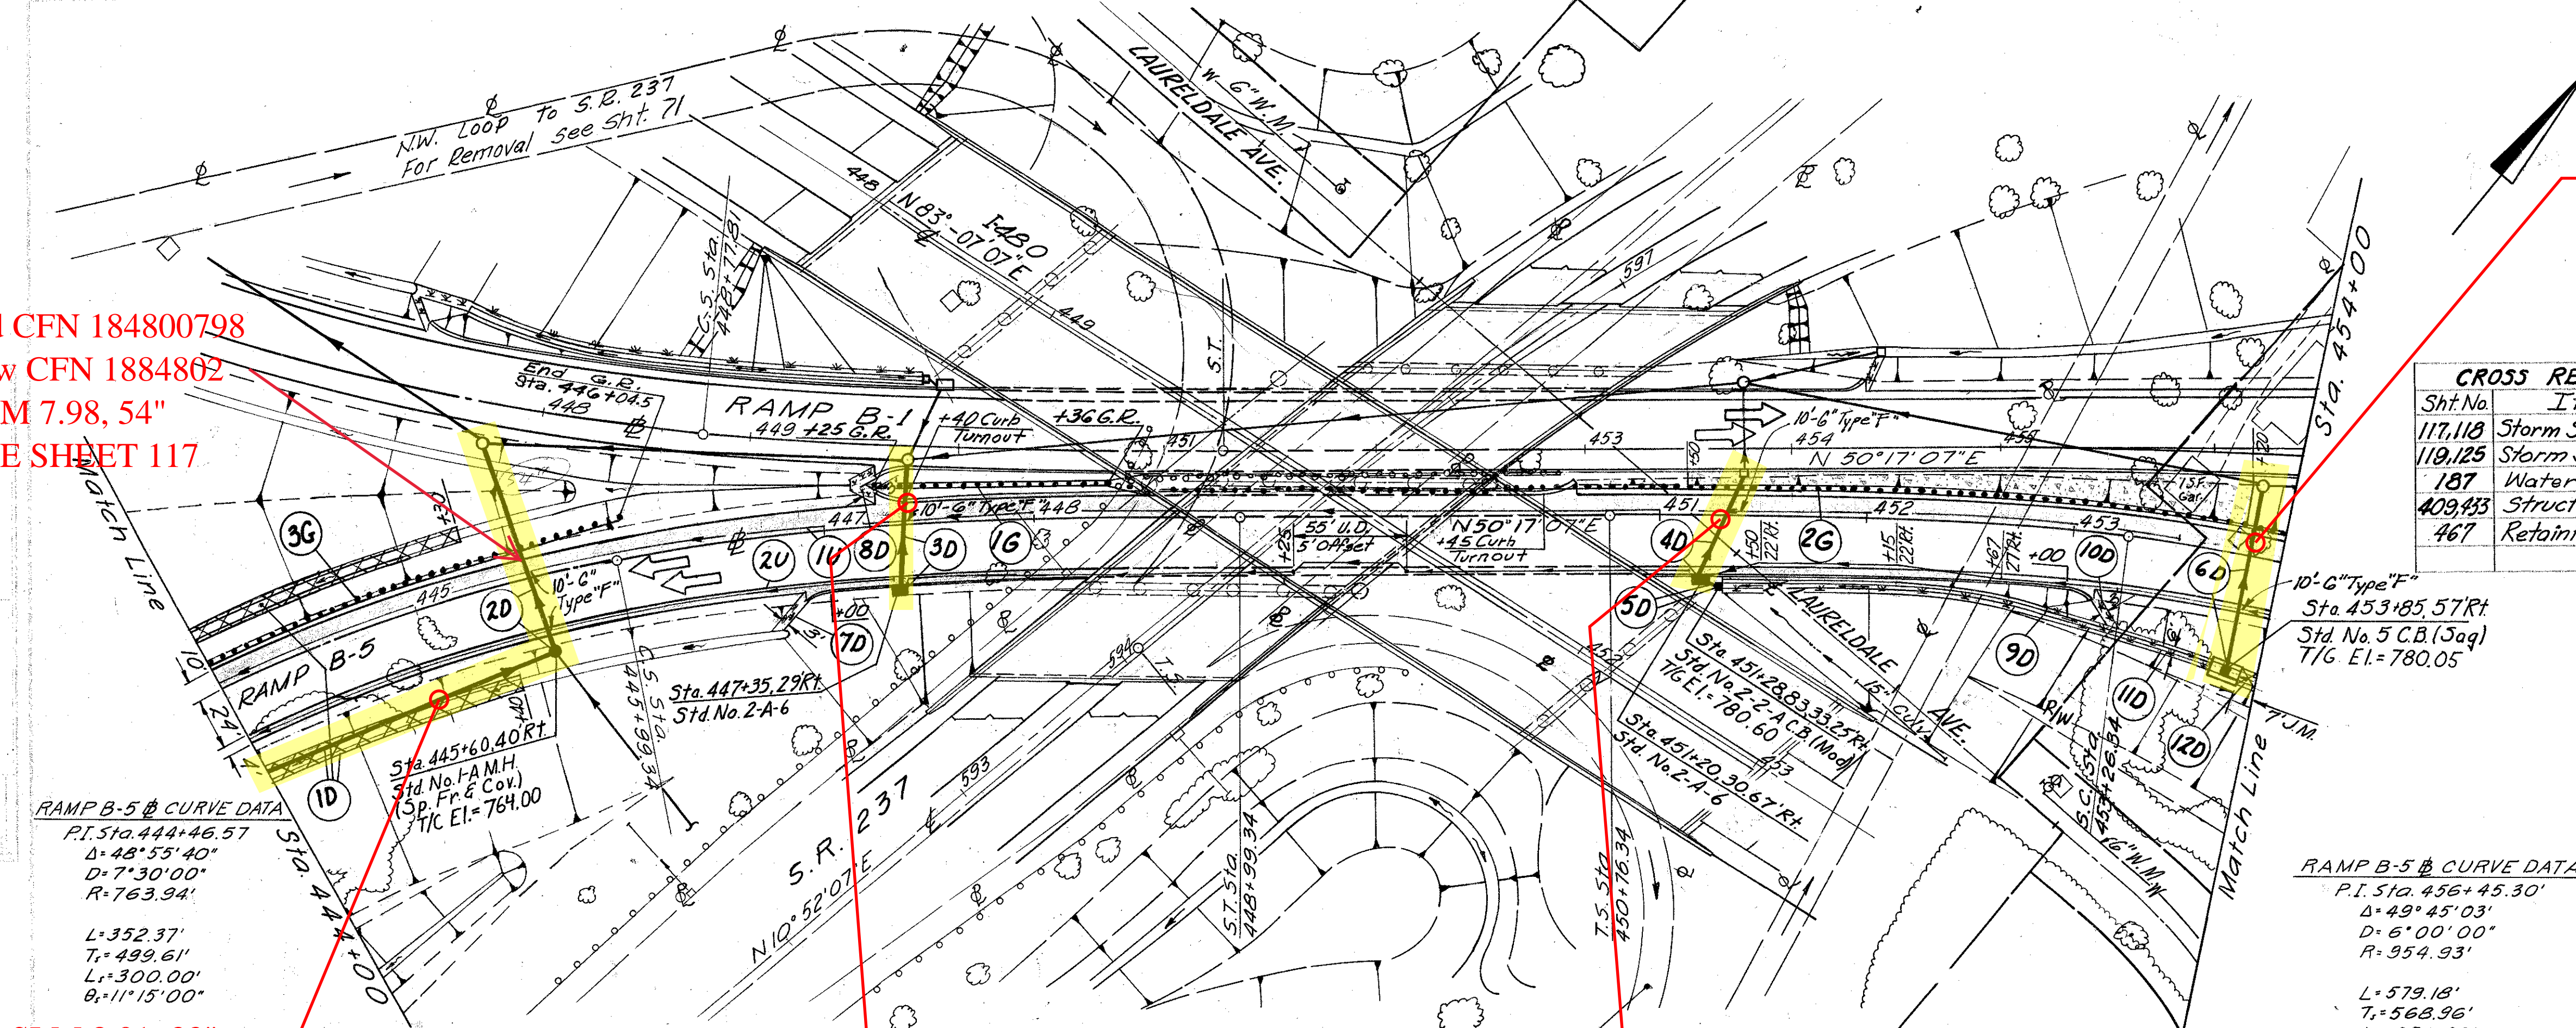


CROSS REFERENCE	
Sht No	Item
117,118	Storm Sewer Profiles
119,125	Storm Sewer Profiles
187	Water Line Work
409,433	Structures (Stack)
467	Retaining Wall (B-5)

ROADWAY	Anchor Assembly		Barrier Design		Anchor Assembly	
	L.F.	Ea	L.F.	Ea	L.F.	Ea
Estimated Quantities	Location					
	Total					

SLM 8.01, 33"
SEE SHEET 119

SLM 8.02, 15"
SEE SHEET 125

SLM 8.07, 15"
SEE SHEET 125

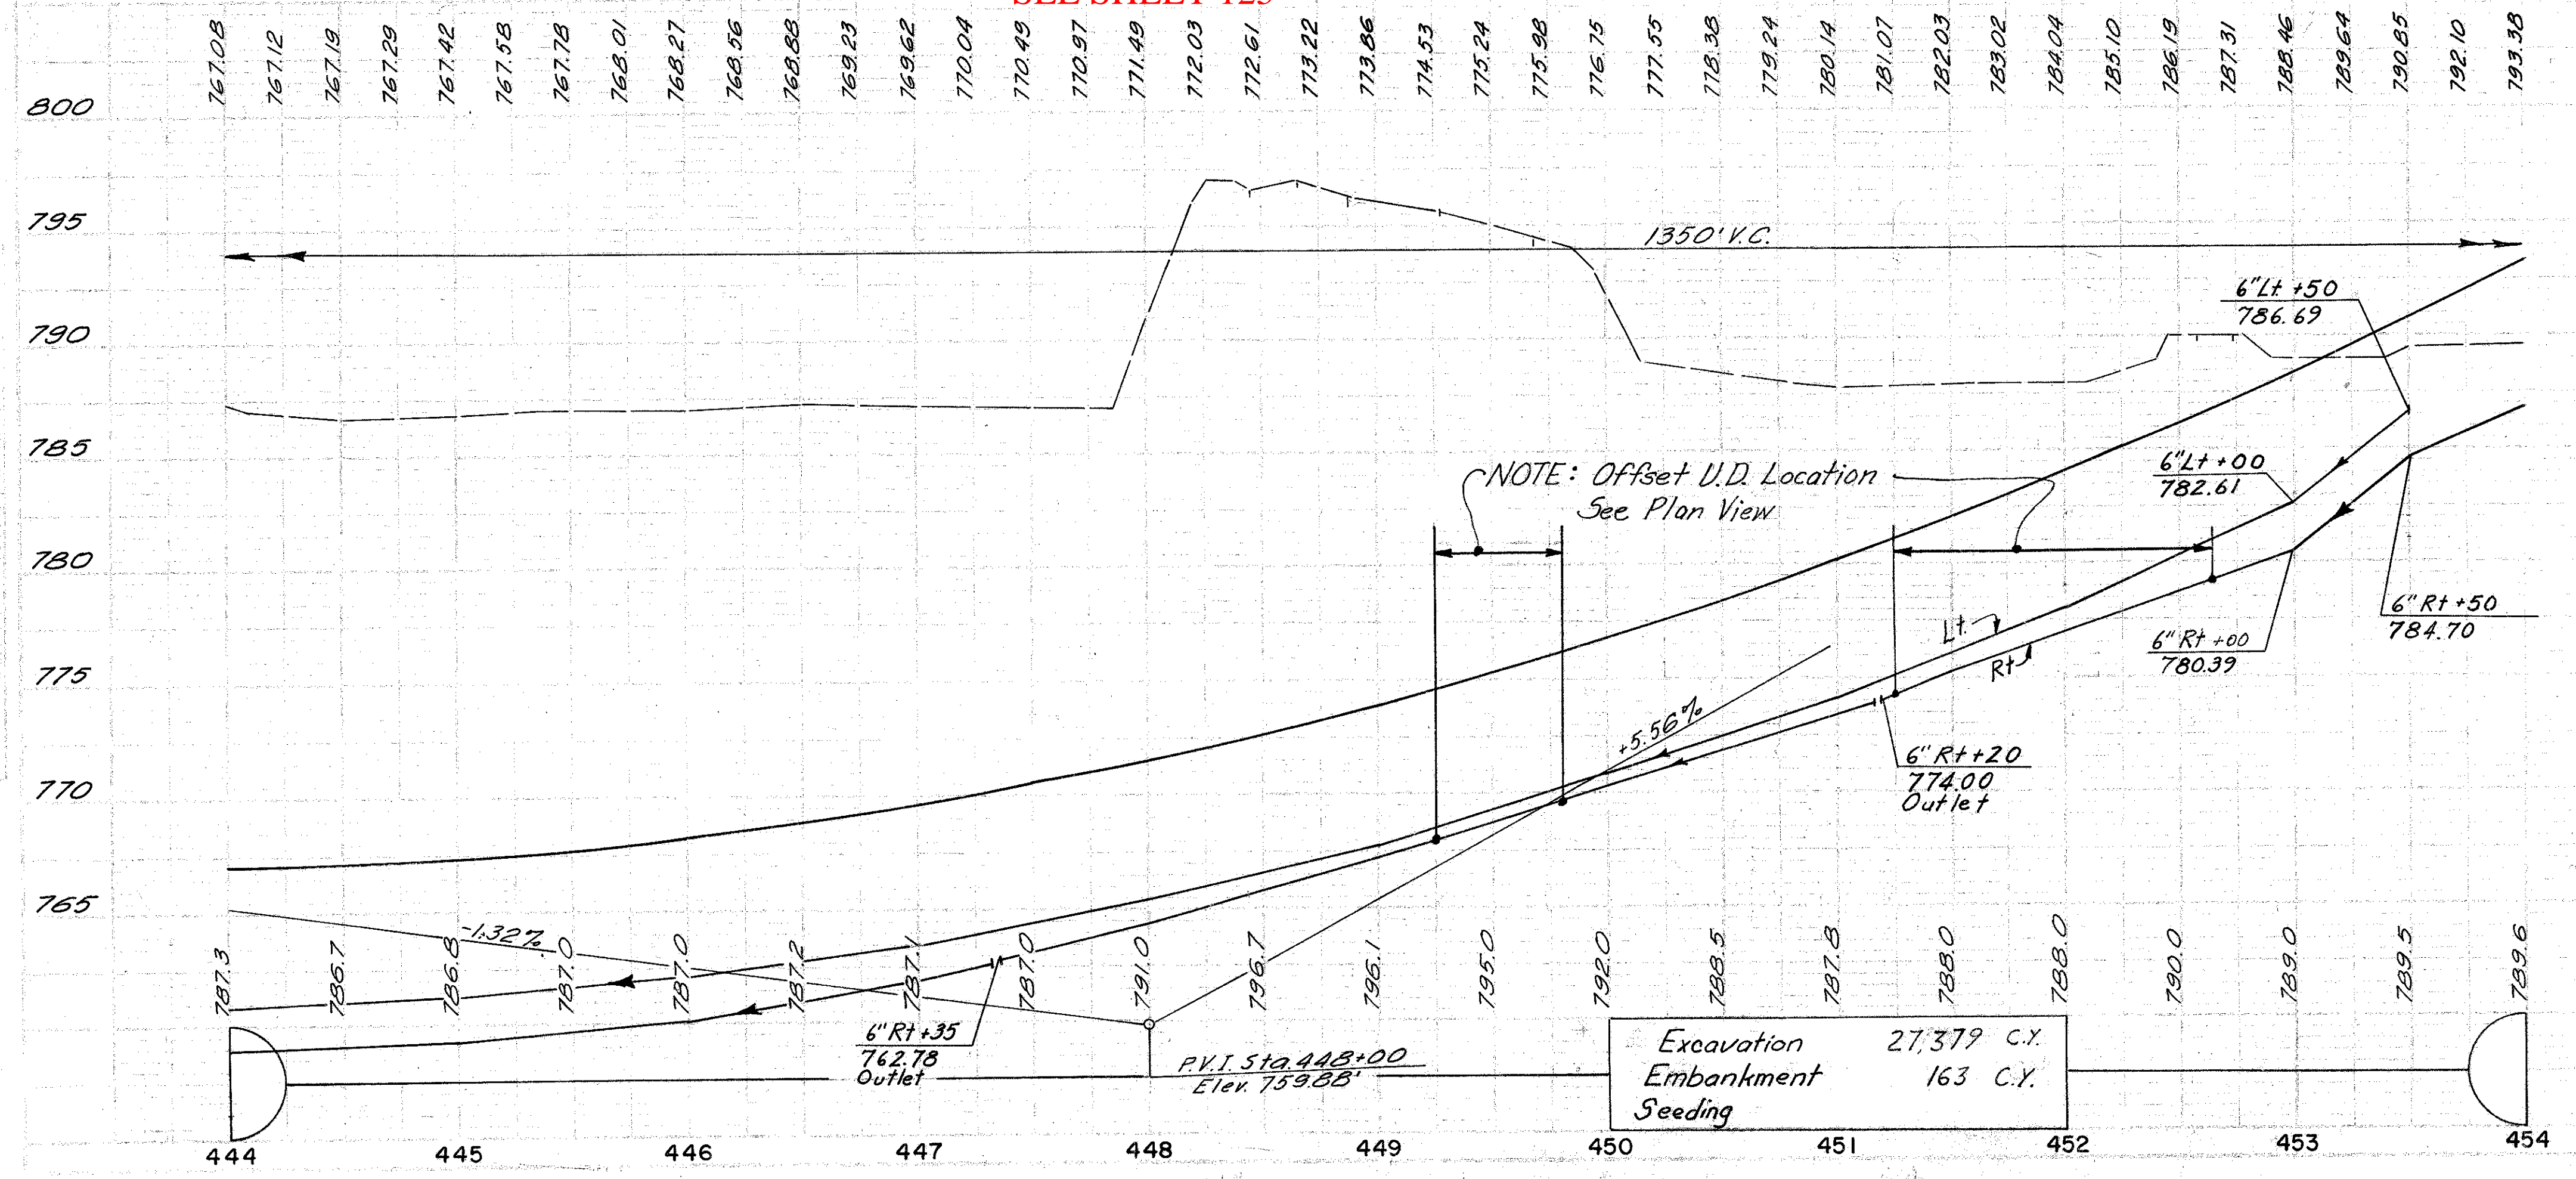

660	Seeding and Jute Matting	S.Y.	220						105	227	
605	Sodding	S.Y.	220	9	5	24	7	60			
				50	50	4					
604	Unclassified	L.F.	L.F.						50	50	
							870	867	50	50	
603	Type "B" Bedding	L.F.	L.F.	L.F.	L.F.						
604	No. 5 C.B.	Ea	Ea								
605	No. 2-2-A.C.B.	Ea	Ea								
606	No. 2-A-6	Ea	Ea								
607	No. 1-A M.H. (Sp. Fr. & Cov)	Ea	Ea								
608	Type "B"	L.F.	L.F.	L.F.	L.F.	59	54	90			
609	Type "C"	L.F.	L.F.	L.F.	L.F.	9					
610	Type "F"	L.F.	L.F.	L.F.	L.F.						
611	Estimated Quantities	Location	L.F.	L.F.	L.F.	444+00 to 445+60					
						445+60 to 447+35					
612	Estimated Quantities	Location	L.F.	L.F.	L.F.	447+35 to 448+00					
						448+00 to 449+20					
613	Estimated Quantities	Location	L.F.	L.F.	L.F.	449+20 to 451+288					
						451+288 to 453+85					
614	Estimated Quantities	Location	L.F.	L.F.	L.F.	453+85 to 446+87					
						446+87 to 447+25					
615	Estimated Quantities	Location	L.F.	L.F.	L.F.	447+25 to 453+26					
						453+26 to 453+78					
616	Estimated Quantities	Location	L.F.	L.F.	L.F.	453+78 to 454+00					
						454+00 to 454+50					
617	Estimated Quantities	Location	L.F.	L.F.	L.F.	454+50 to 454+00	30				
						454+00 to 454+00					
618	TOTAL	L.F.	L.F.	L.F.	L.F.	70	9	113	90	147	110

*20 - 50.0% Interstate, 40.0% Urban