


FED. RD. DIVISION	STATE	PROJECT
2	OHIO	

CUYAHOGA COUNTY  
CUY-480-19.43

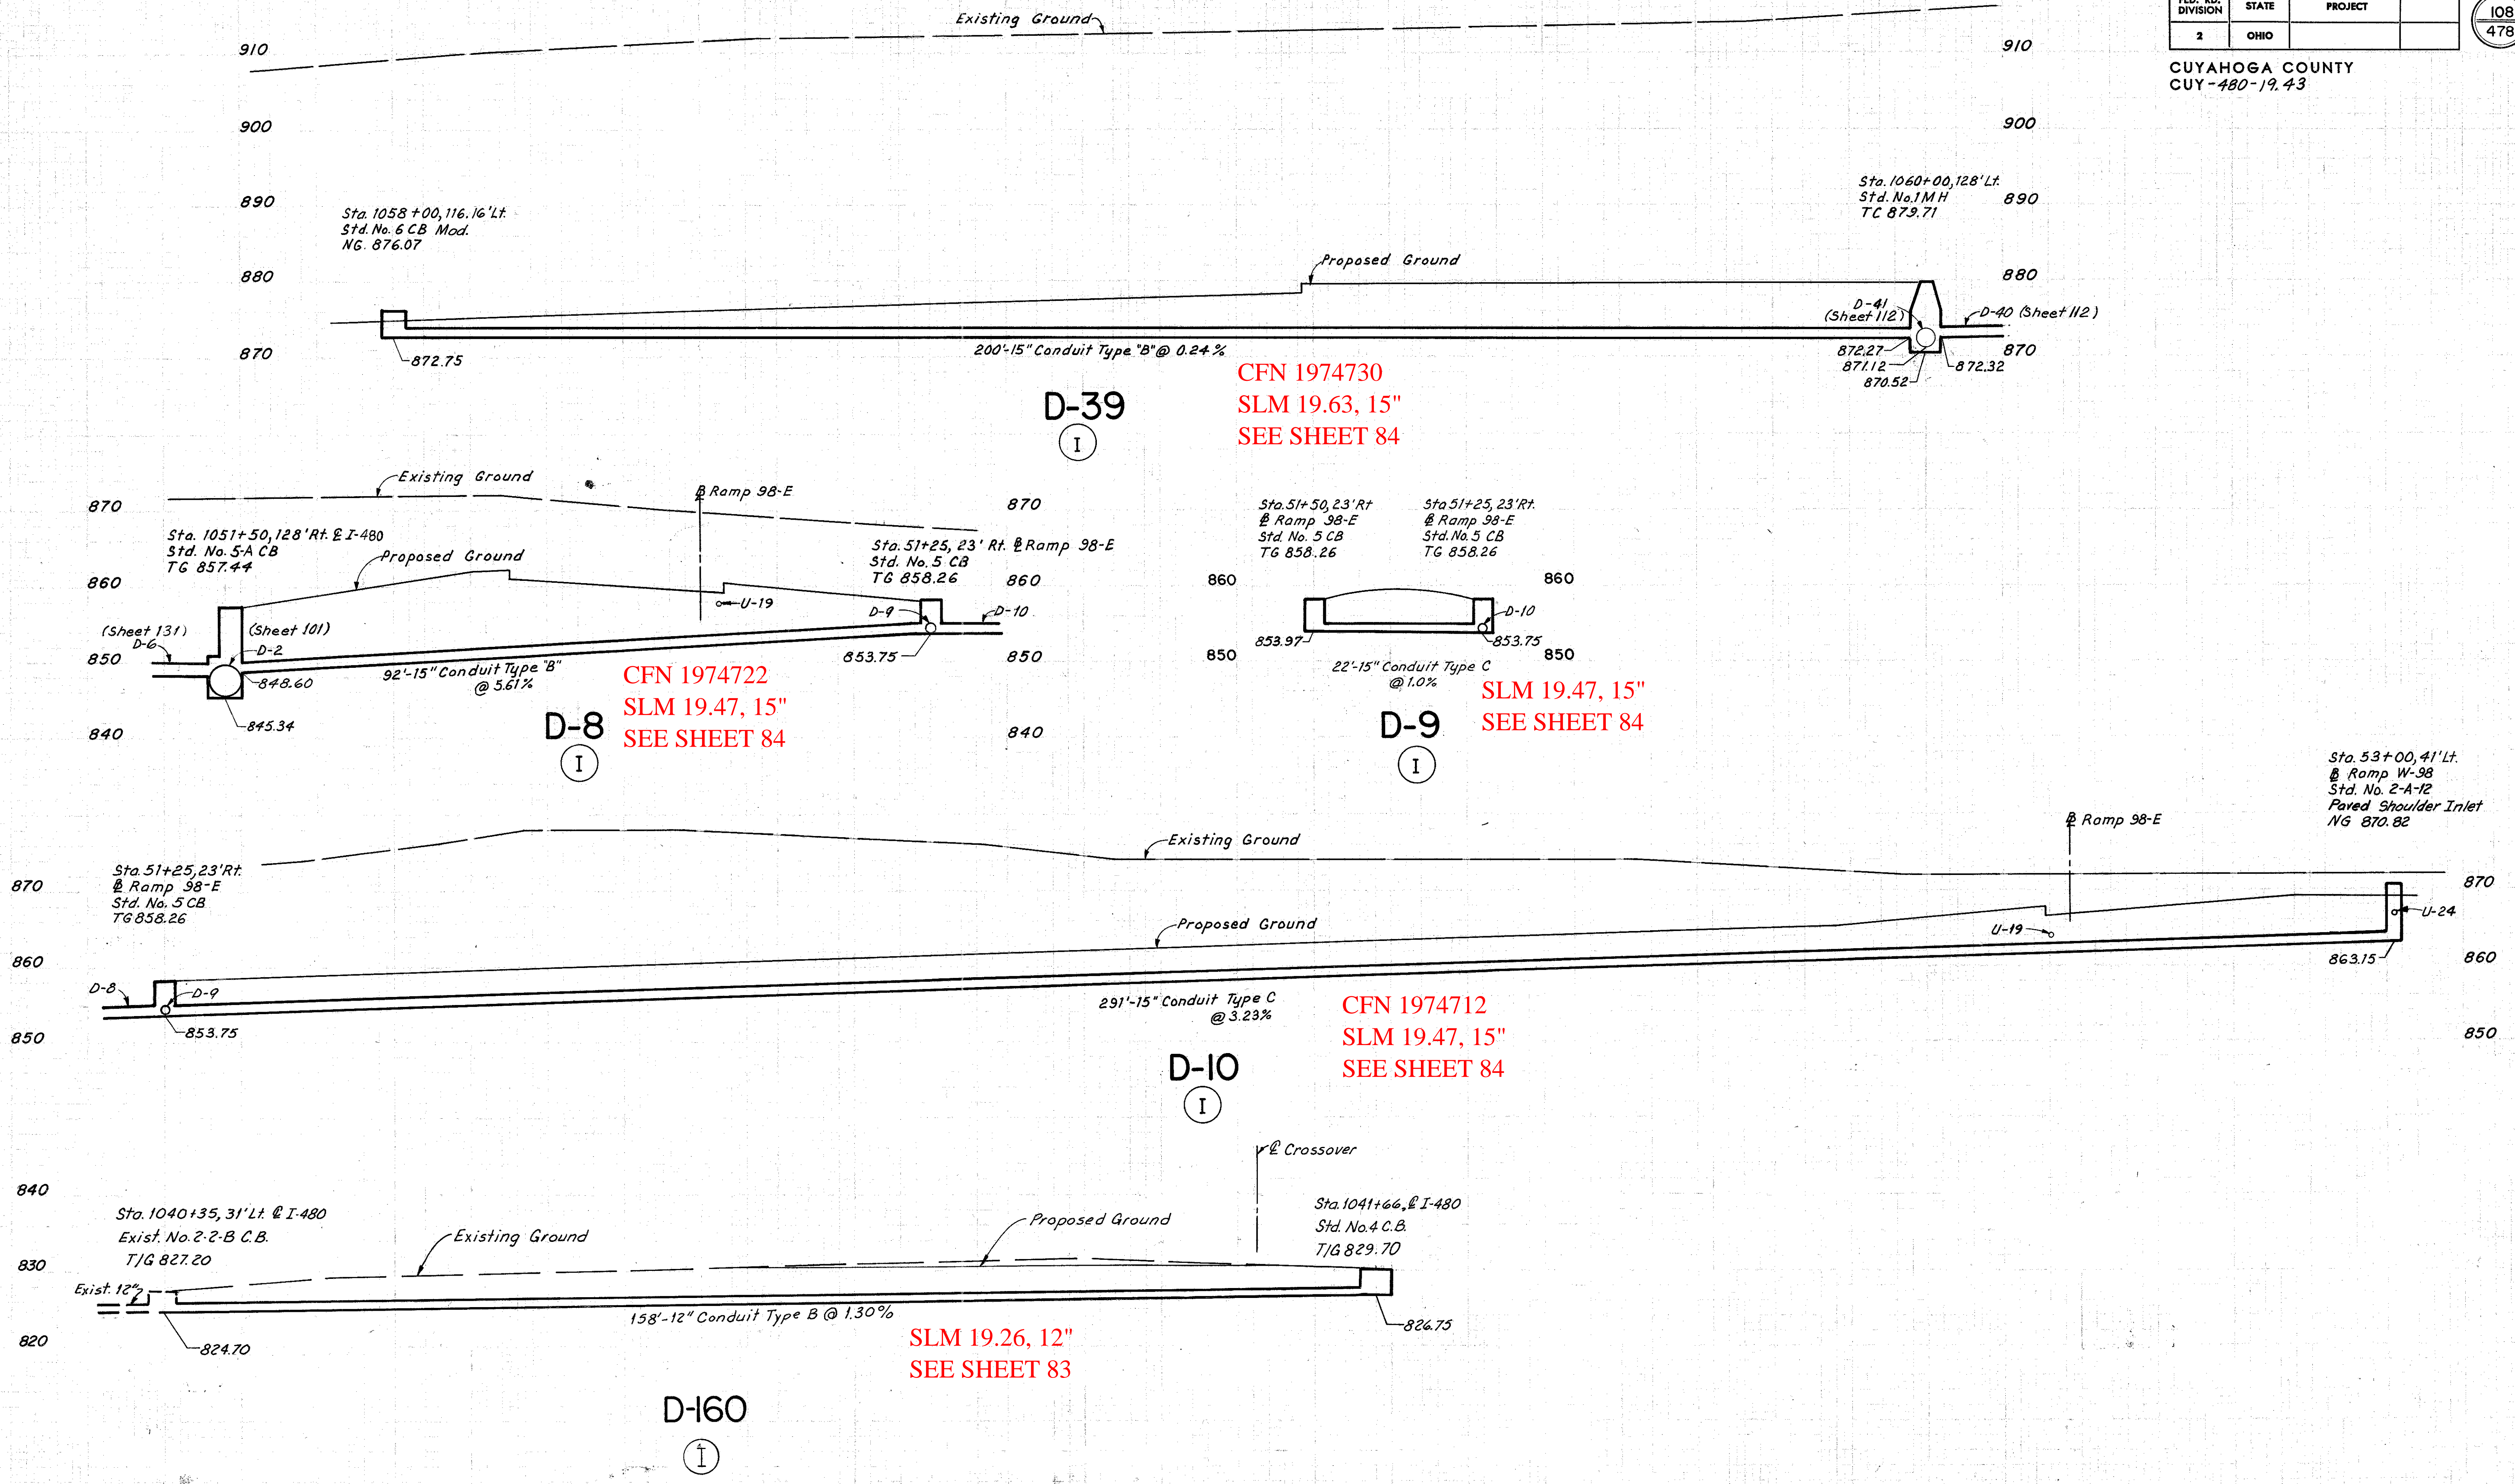

CFN 1974730  
SLM 19.63, 15"  
SEE SHEET 84

CFN 1974722  
SLM 19.47, 15"  
SEE SHEET 84

SLM 19.47, 15"  
SEE SHEET 84

CFN 1974712  
SLM 19.47, 15"  
SEE SHEET 84

SLM 19.26, 12"  
SEE SHEET 83

Checked  
E.R.A.  
6-15-70