


FED. RD. DIVISION	STATE	PROJECT
2	OHIO	

CUYAHOGA COUNTY
CUI-480-19.43

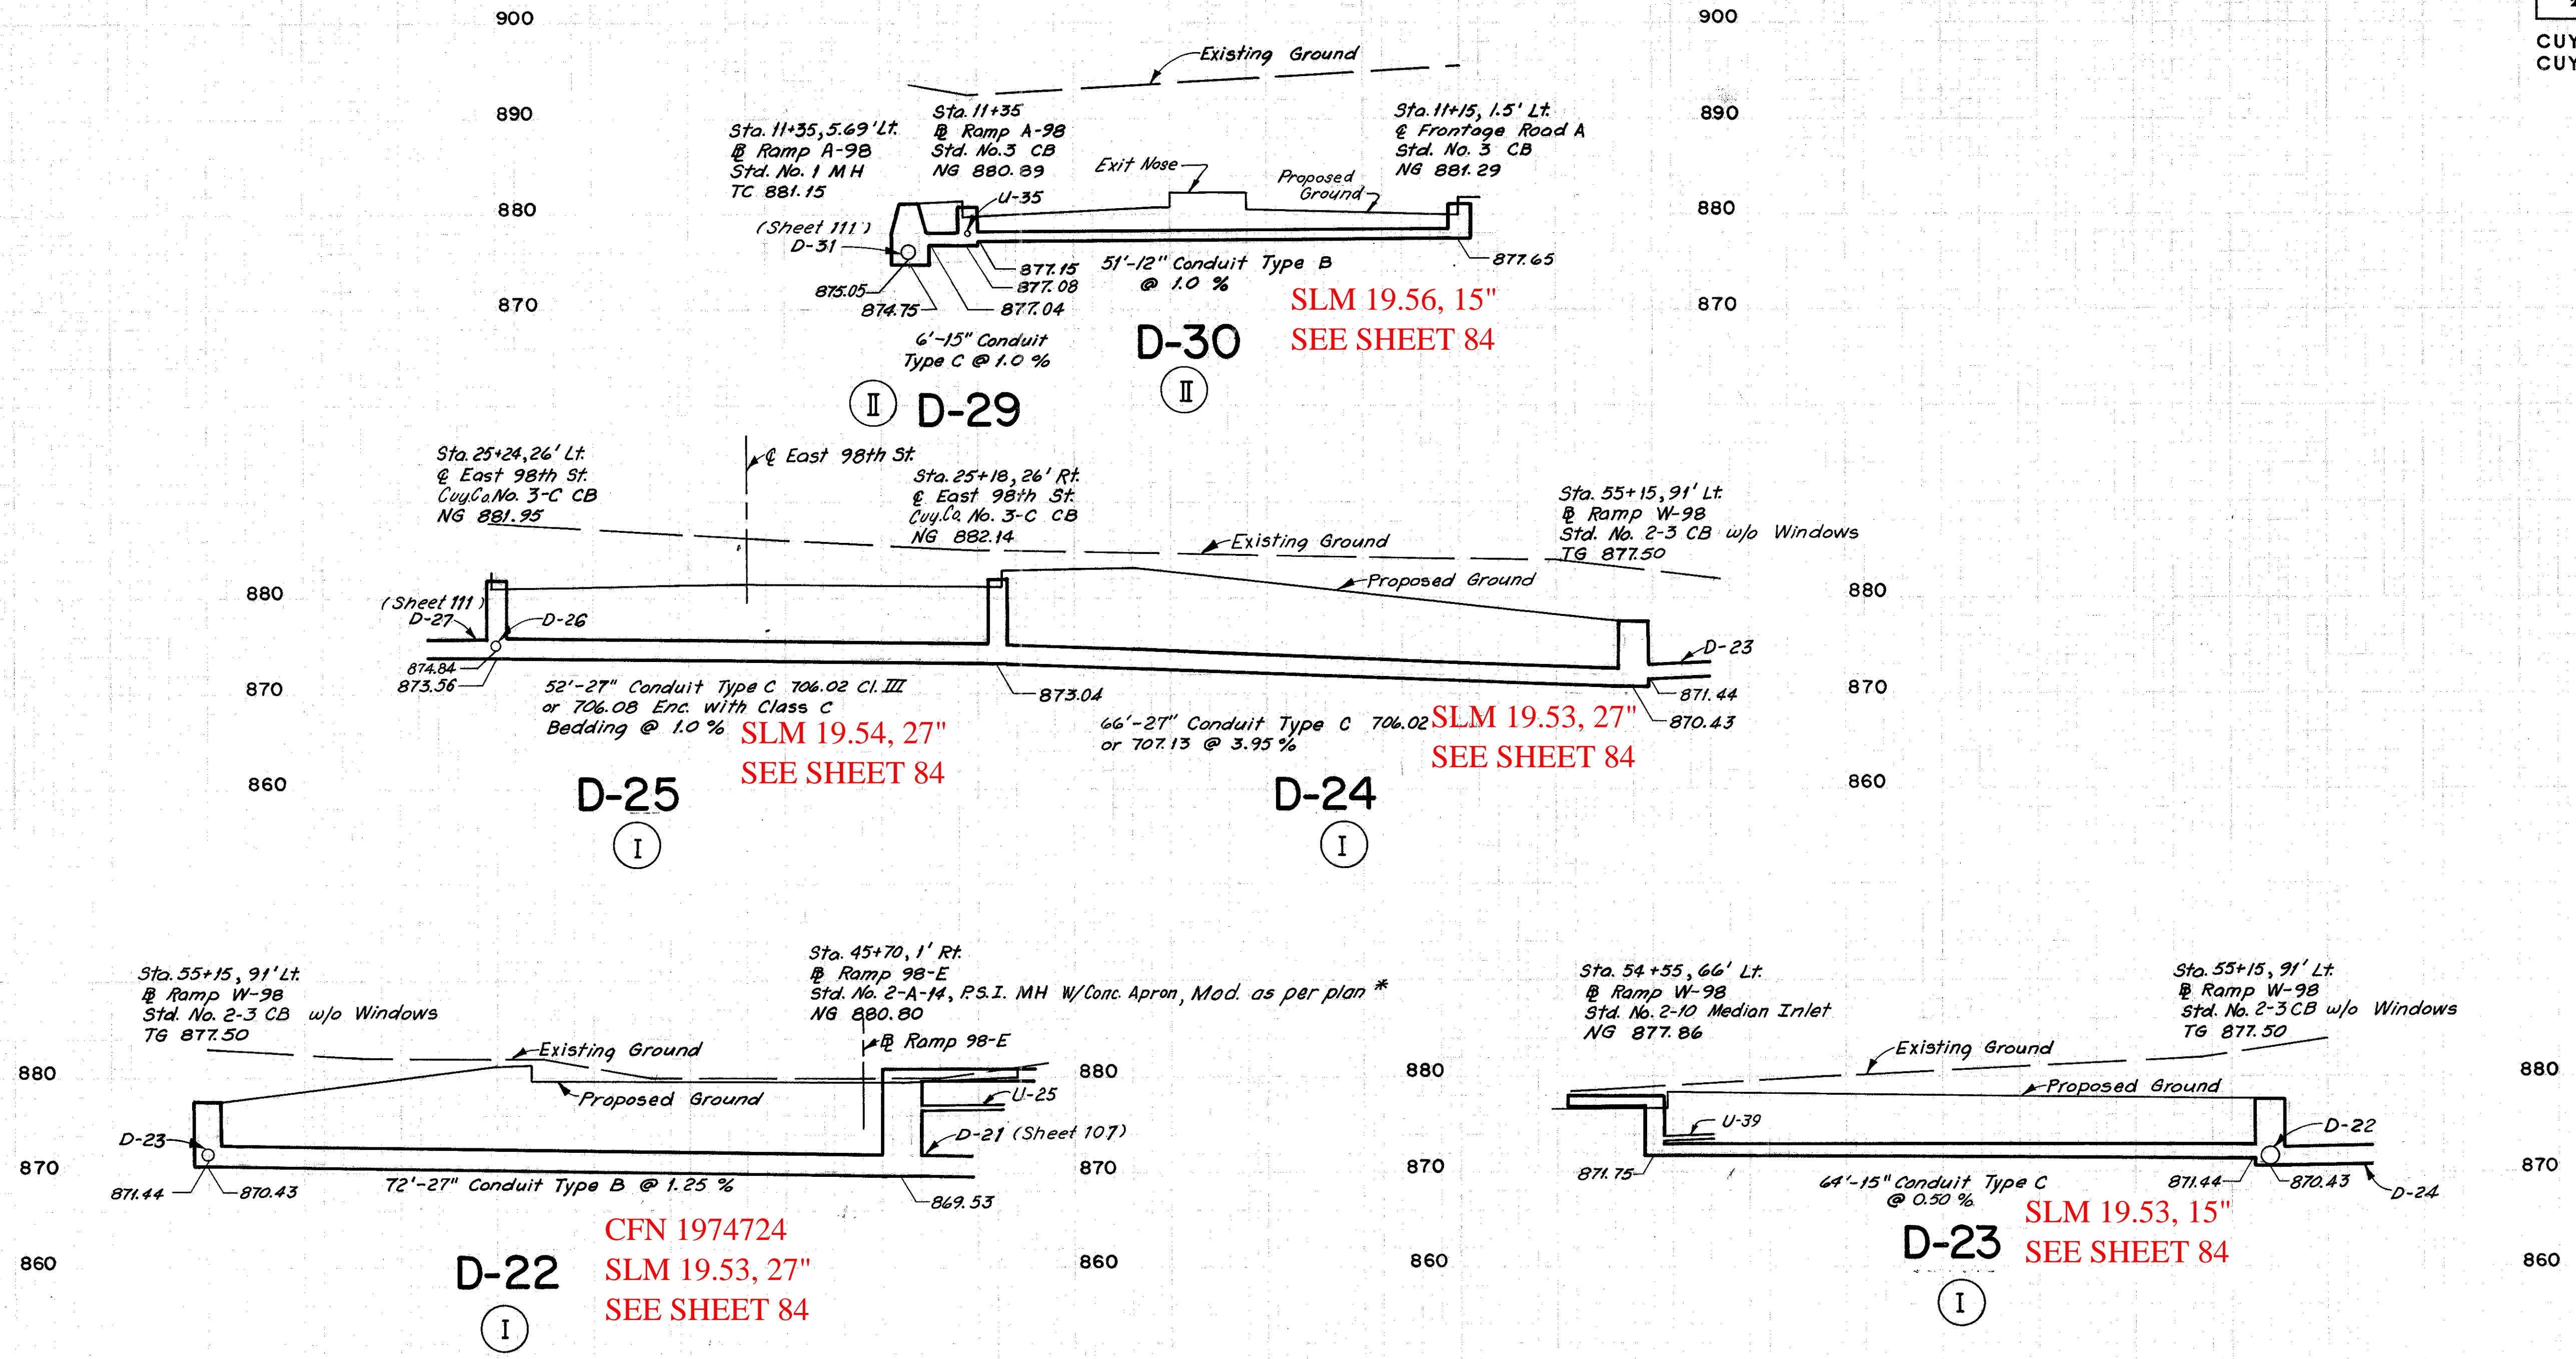

2-8-71
 2-11-71
 R.E.M.
 K.A.W.
 Made
 Checked