


16" Valve

30"

Abandon


11-13

Rm-

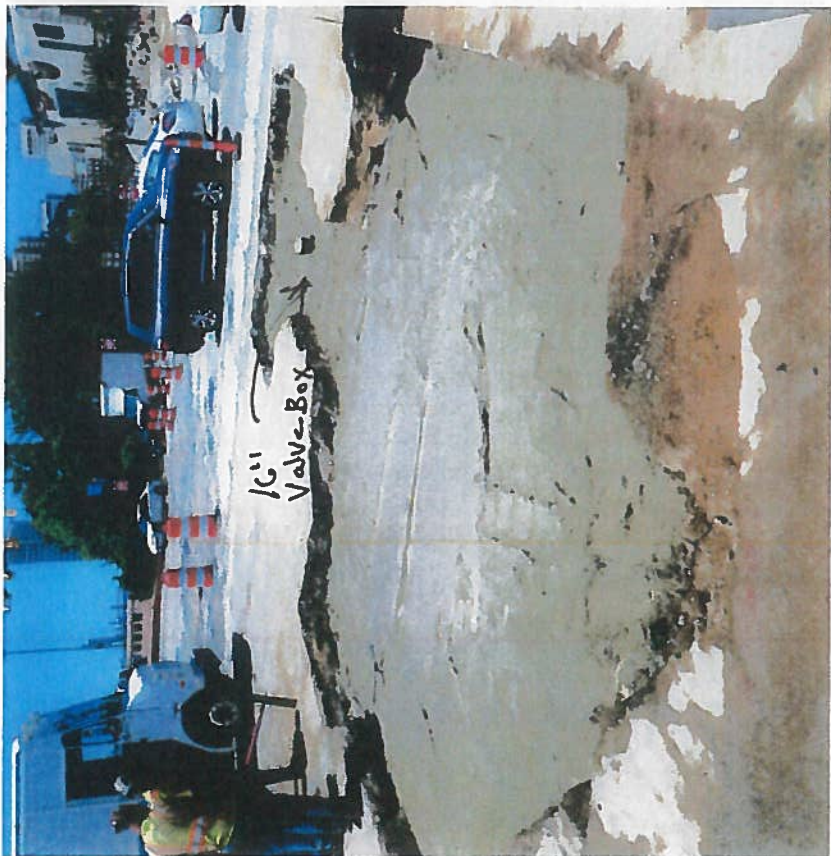

13-13

Rm

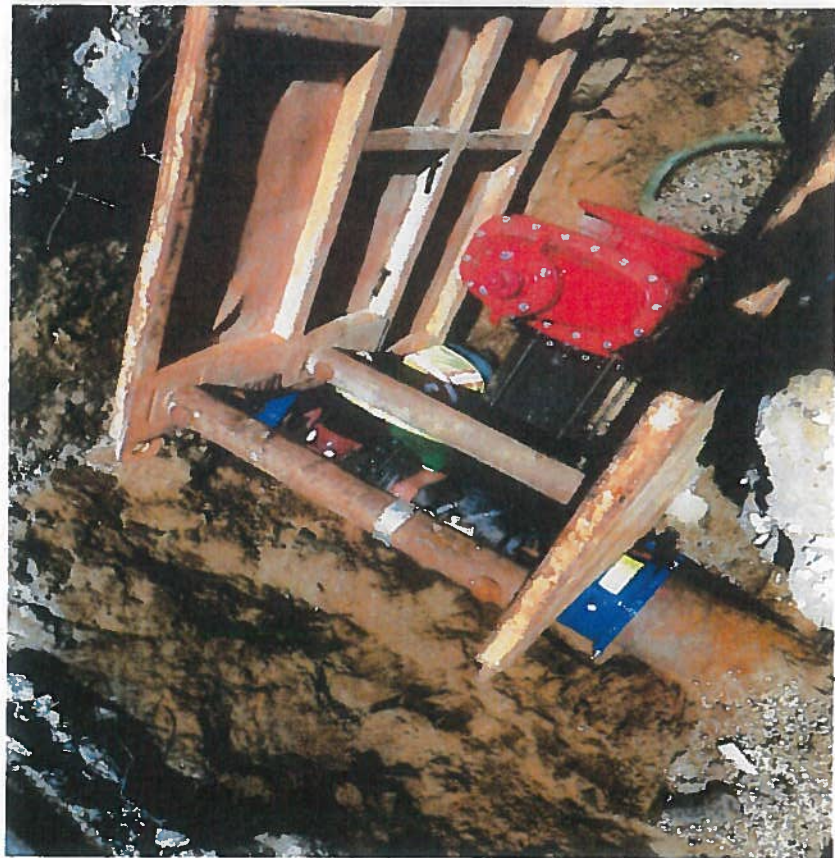

Line  
16"

10-13

Rm

MATERIALS

1/2" DIA K<sup>2</sup> STEEL

FE 16" 30"

1/4" SS 30"

VALUE 22'

30" T - 42"

2- 16" SOLID STEELS

2- 16" MEALS

2- SOLID STEELS

3- PLATE

2- TUB

REMOVE EXISTING 30" VALUE

CCWP - INSTRUCTED TO REMOVE










VALUE DRAIN FROM PIT TO HALL

REWORKING ADDITIONAL WORK TO

IN 16 C.O. PAVED BOX OVER 30

1/2" SS

30" TUB

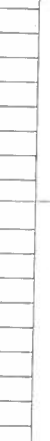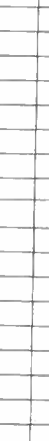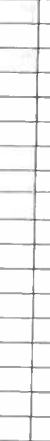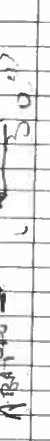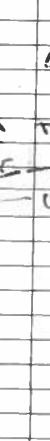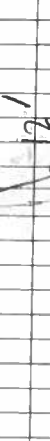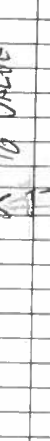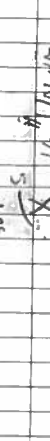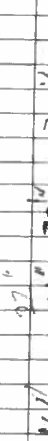

bill

G. HARRIS 2/25/3172

GRANDS