

CUY-90-14.90

Project Number 133000

PID 82119


Bridge #34 – Removal Plan

Prepared by:

Trumbull-Great Lakes-Ruhlin
a joint venture

Plan checked by:

Paul J. Wischt, P.E.
URS Corporation
564 White Pond Drive
Akron, Ohio 44320

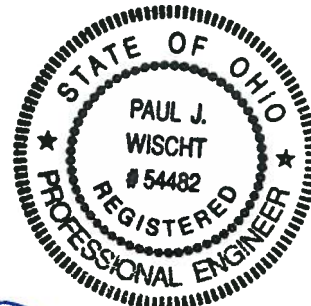

PJ Wischt 3/26/14

Paul J. Wischt, P.E.

Date

Plan Reviewed by:

Tom E. Stora, P.E.
URS Corporation
564 White Pond Drive
Akron, Ohio 44320



T E Stora 3/26/14

Tom E. Stora, P.E.

Date

Demolition Plan for Br. 34 CUY-77-1575 On Ramp to I-77 SB over E. 14th St.

Use ODOT approved overnight closures of E. 14th St., with detours.
All work at night, or during daytime short term single lane closure times.
No traffic adjacent to or under the bridge during demolition.

Use Komatsu 360 size excavator with hoe ram or UP30 universal processor to remove deck and parapets.
Cross braces will be removed from the top, as deck removal progresses, by laborers using torches or by processor.
One set of cross braces near each abutment and pier will be left in place for stability. Also, the maximum spacing between x-frames removed will be 40-feet.
Hoe ram approach slabs and remove. Hoe ram abutment back walls and excavate to seat elevations.

All concrete debris will be loaded out to a recycling center off site.


Structural Steel removal:

A hydraulic excavator will be attached to the abutment ends of each successive beam line using shackles. The remaining cross braces will be cut using torches, and then the beam line will be cut at the rear side of Pier 2 bearing point. Connection to the P2 bearing will be removed.
The beams will be pulled by the excavators away from mid-span, onto the remaining ramp pavement. There they will be processed and hauled to an off-site recycling center. The process will be repeated for each beam line.

Concrete abutments, piers, and slope protection will be removed using hoe rams or processor.
All concrete debris will be hauled to a recycling center off site.
All resteel will be hauled to a steel recycling center off site.


21-0

CUYAHOGA COUNTY
CITY OF CLEVELAND
CITY-21-15.32
CITY-42-18.42

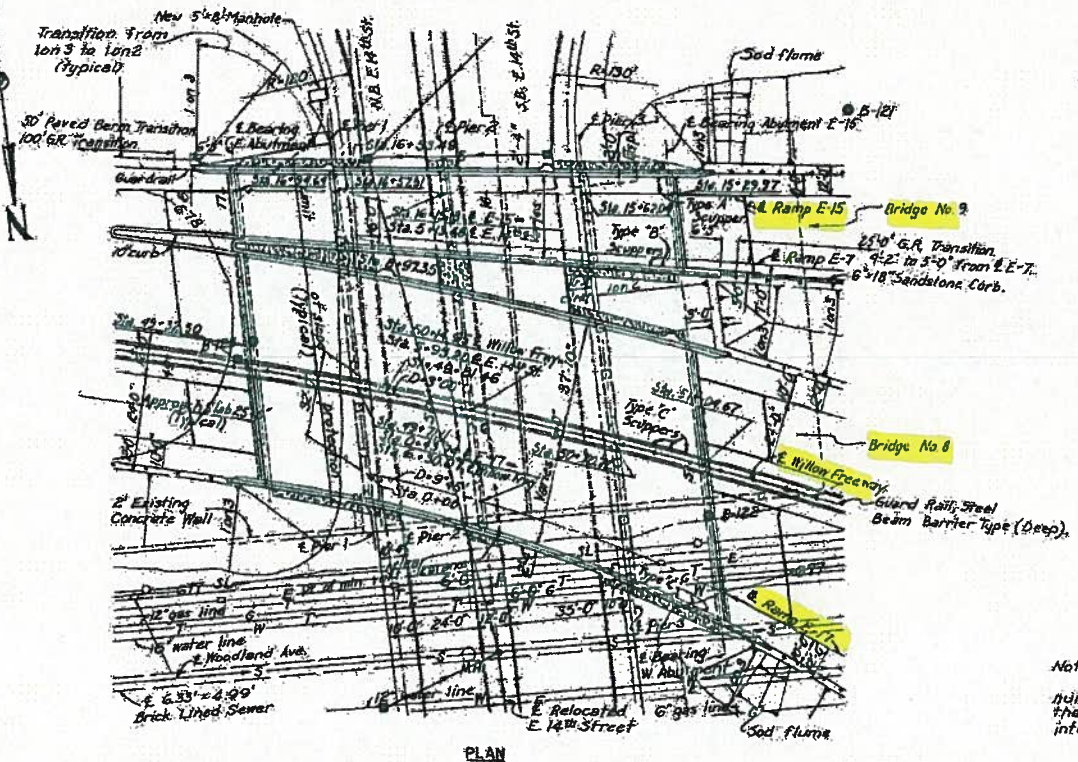

CURVE DATA


E Willow Freeway	& Ramp E-17
$\Delta = 23^{\circ}06'48''$	$\Delta = 80^{\circ}33'40''$
$D = 3^{\circ}08'00''$	$D = 0^{\circ}45'00''$
$R = 1909.26'$	$R = 547.65'$
$T = 390.54'$	$T = 343.13'$
$L = 770.50'$	$L = 621.14'$

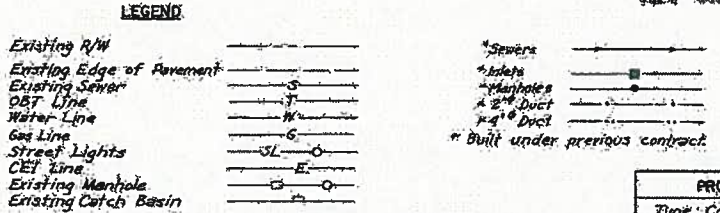

BORING 121

Vertical Scale: 1"=20'
Sta. 14+63.8 Ramp E-15 33' RT.

17	673.1	Brown Sand
20	663.1	Brown Silty Sand
43	652.1	Brown Silt
48	653.1	Brown Silty Gravelly Sand
84	643.1	Grayish-Brown Sandy Silt
13	643.1	Gray Silty Sand
57	633.1	Gray Silty Sand
62		
35		
75		
96		
26		
15		
35	592.1	Gray Silt

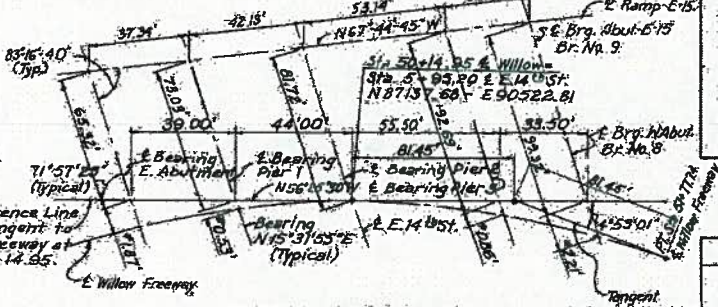





PROPOSED STRUCTURE BR. NO. 8

Type: Continuous steel beam with reinforced concrete deck and substructure.
Spans: 36'-10", 43'-0", 55'-0", 153'-11" along E Willow Freeway.
Roadway: 64'-0" (nominal) face to face parapets.
Loading: C-2000 Adequate for A.A.H.S.O. alternate loading.
Skew: Varies.
Surface: Crushed Aggregate Concrete.
Alignment: 3'-00" RT.
Approach Slabs: 45'-1-54 (25' Long)
Super-elevation: .05 ft/ft.

PROPOSED STRUCTURE BR. NO. 9

Type: Continuous steel beam with reinforced concrete deck and substructure.
Spans: 37'-4", 42'-11", 55'-11", 32'-0" along E-15.
Roadway: Varies.
Loading: C-2000 Adequate for A.A.H.S.O. alternate loading.
Skew: 643' 20".
Surface: Crushed Aggregate Concrete.
Alignment: Tapered.
Approach Slabs: 45'-1-54 (25' Long)
Super-elevation: Varies.

Notes:
The figures to the left indicate the number of hammer blows required to drive the sampling spoon 1 ft. They are given at 5' intervals starting at elev. 670.1.

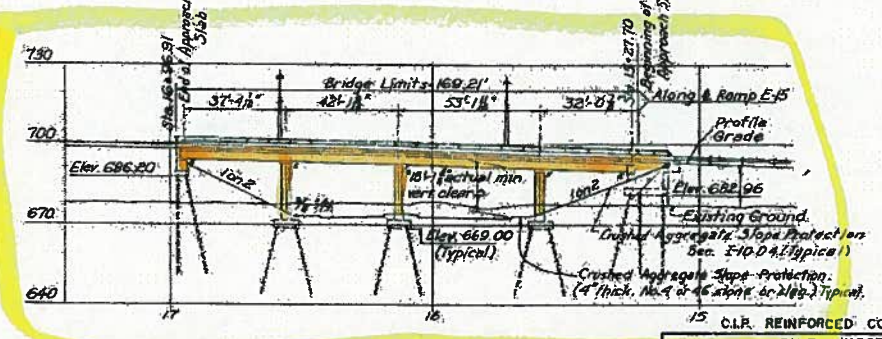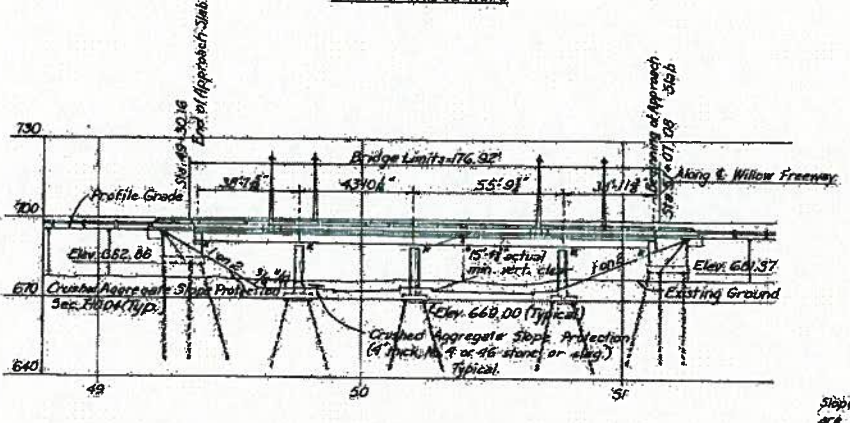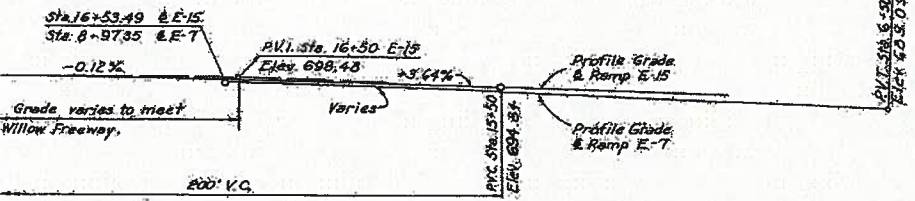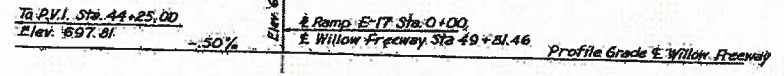

PILE INFORMATION

Location	Diameter	Number	Estimated ave. length
Bridge 8			
West Abutment	12"	36	35 ft
Piers 1, 2, & 3	14"	25	27 ft
Bridge No. 9			
Abutment E-15	12"	34	35 ft
Piers 1, 2, & 3	14"	36	27 ft
Bridge No. 8 (West)	12"	40	37 ft

NOTES:
Not soundings only were taken at location. Bore hole B-103. The core drilling mark at B-103 is plotted.
Pile lengths are based on boring data and are approximate only. The Contractor shall assume full responsibility for length of piling selected for driving.
The following items are not included in the bridge plans (See Roadway Plans for details):
Approach grading, curbs, and slabs.
Bearing, Guard Rail, Sod Flumes.
For details of slope protection see S&T Plan.
For details of pier plans & drain pipe locations of piers see Sta. 171-181-174-175.


Notes:
Piers for Bridges 8 & 9 are included in Foot 6.

H.N.T.B. BR. NO. 8 AND 9 PART 7A
HOWARD, NEEDLES, TAMMEN & BERENDORFF
CONSULTING ENGINEERS
CLEVELAND OHIO

SITE PLAN
WILLOW FREEWAY & RAMP E-15 OVER E. 14TH STREET
STA. 49+30.16 STA. 91+07.08 (WILLOW FREEWAY)
STA. 15+27.70 STA. 16+96.91 (RAMP E-15)
BR. NO. CUY-21-1573.14 @ Scale: 1" = 30'
WILLOW-INNER BELT FREEWAY
CLEVELAND CUYAHOGA COUNTY OHIO


RAILROAD 34 RAMP ONLY

Bridge # 9

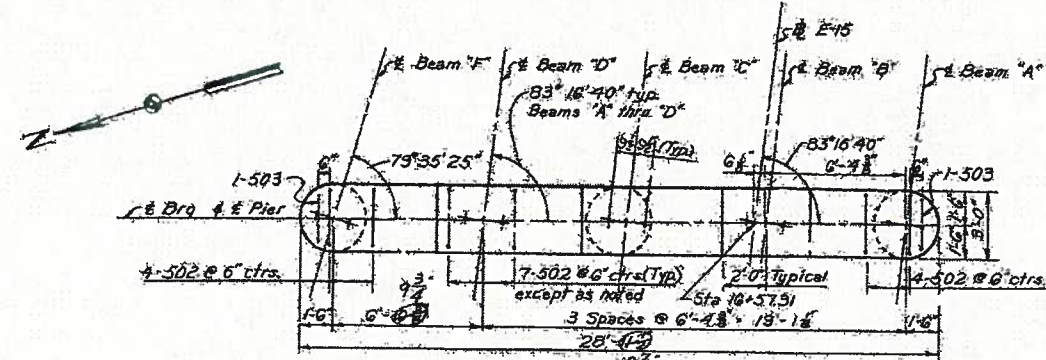


PLAN

Note: Special care shall be taken when placing reinforcing steel so as not to interfere with anchor bar setting. Anchor bars to be furnished and set under X tie contact.

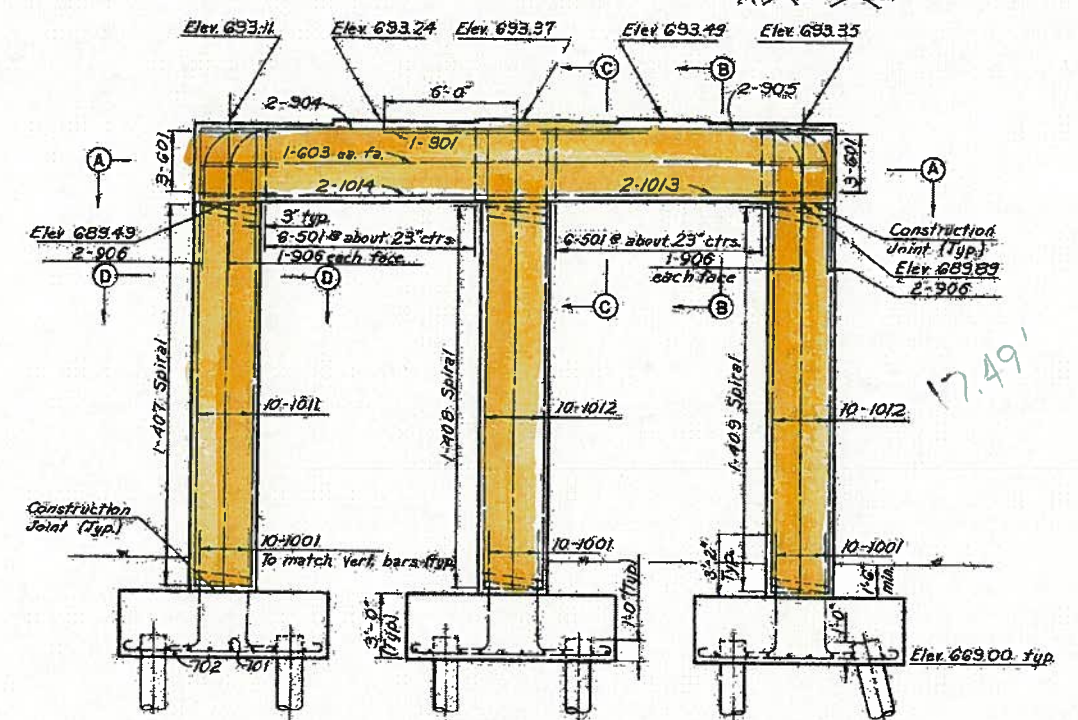


ELEVATION

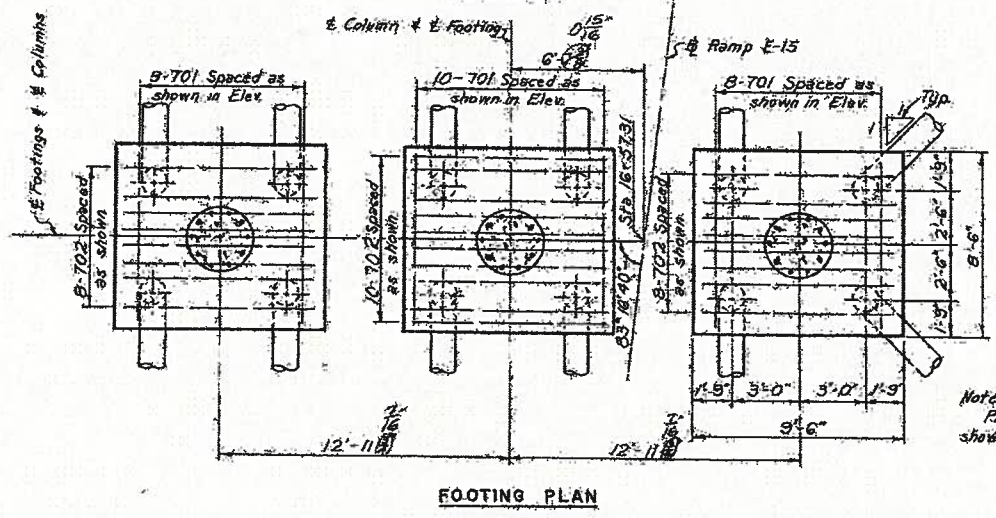


FOOTING PLAN


PIER 1

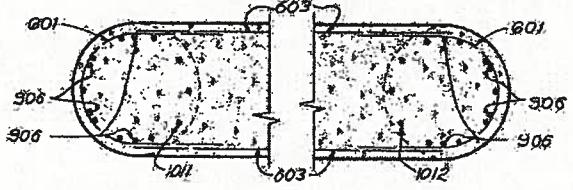


SECTION AA

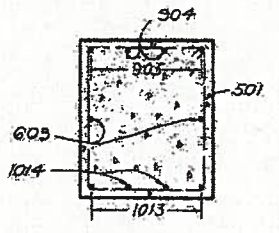

SECTION BB

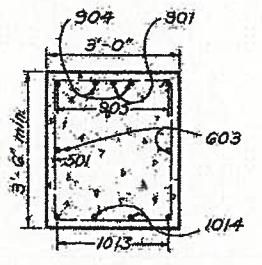


SECTION CC

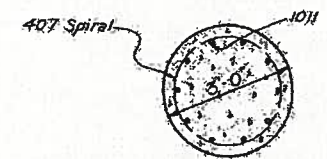

SECTION DD

Typ. for all columns except for bar marks. Scale for sections: 1/2"=1'-0"

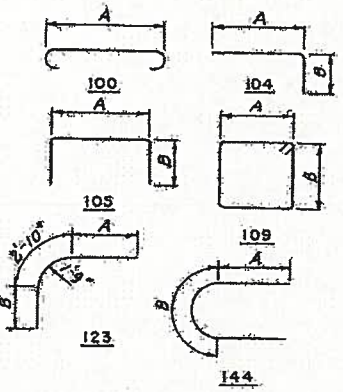

BAR BENDING DIAGRAMS

Note: Prefix "PD" shall be assigned to all bar marks.

REINFORCEMENT SCHEDULE FOR PIERS 1, 2 & 3										
MARK	NO.	LENGTH	TYPE	DIMENSIONS				SERIES INCREMENT	WEIGHT (POUNDS)	
				A	B	C	D			
501	42	12'-1"	109	2'-8"	3'-2"				530	
502	101	3'-9"	105	2'-8"	0'-8"				996	
503	6	3'-7"	105	2'-6"	0'-8"				22	
801	18	6'-9"	144	1'-4"	4'-1"				183	
802	4	15'-8"	Str.						33	
603	2	14'-0"	Str.						42	
604	7	17'-0"	Str.						102	
701	52	9'-10"	100	8'-2"					1045	
702	108	70'-10"	100	9'-2"					2331	
901	2	12'-0"	Str.						82	
902	2	31'-3"	Str.						213	
903	2	28'-3"	Str.						193	
904	2	28'-8"	Str.						194	
905	2	28'-0"	Str.						177	
906	16	11'-8"	123	4'-5"	4'-5"				635	
1001	90	6'-11"	104	5'-9"	1'-5"				2680	
1002	10	18'-0"	Str.						775	
1003	10	18'-3"	Str.						785	
1004	10	18'-6"	Str.						796	
1005	2	34'-6"	Str.						298	
1006	2	32'-0"	Str.						273	
1007	10	19'-9"	Str.						850	
1008	10	20'-0"	Str.						801	
1009	10	20'-3"	Str.						871	
1010	8	17'-2"	Str.						591	
1011	10	20'-3"	Str.						893	
1012	20	21'-0"	Str.						1807	
1013	2	28'-0"	Str.						224	
1014	2	28'-4"	Str.						244	
1015	8	12'-4"	123	4'-9"	4'-9"				425	
1101	8	17'-9"	Str.						754	
Total									19,428	

SPIRAL REINFORCEMENT SCHEDULE						
MARK	NO.	CORE DIA.	LENGTH	PITCH	NO. OF TURNS	WEIGHT (POUNDS)
A01	1	2'-8"	15'-0"	4'-5"	43	237
A02	1	2'-8"	15'-2"	4'-5"	43	237
A03	1	2'-8"	15'-5"	4'-5"	44	243
A04	1	2'-8"	16'-7"	4'-5"	47	259
A05	1	2'-8"	16'-9"	4'-5"	48	265
A06	1	2'-8"	16'-11"	4'-5"	48	265
A07	1	2'-8"	17'-6"	4'-5"	50	276
A08	1	2'-8"	17'-8"	4'-5"	50	276
A09	1	2'-8"	17'-10"	4'-5"	51	282
Total						2340

NOTES:
 Reinforcement bars shall be 3" clear from face of concrete at bottom of footings and 2" elsewhere.
 File spacings are given along bottom of footings.
 All piles shall be 14" C.I.P. reinforced concrete.
 All battered piles to be battered 3 in 12 in direction shown.
 All bar dimensions are given out to out.
 For meshing plate details, see sh. 156-G for replacement steel schedule, see sh. 58-G.

NOTES FOR SPIRAL REINFORCING BARS:

The "Length" shown in the reinforcement schedule for the spiral bars is the distance from the top of the footing to the bottom of the pier cap.
 The "No. of turns" shown in the reinforcement schedule for the spiral bars is the "Length" divided by the pitch, plus 3 turns (total number of closed coils), expressed as the nearest whole number. 1/2" closed coils shall be provided at the ends of each spiral unit.
 Four steel channels, flat or angle spacers, weighing approximately 0.68 lb. per lin. ft. of spacer shall be provided for each spiral unit. They shall be equally spaced along the periphery of the coil. The number of pounds of these spacers, based on 0.68 lb. per lin. ft. will be paid for as reinforcing steel and is included in the tabulated quantity of spiral bars.
 Spiral reinforcing bars shall not have deformations but shall in other respects conform to item 8-4.


H.N.T.B. BR. NO. 9 PART 6

HOWARD, NEEDLES, TAMMEN & BERGENDOFF
 CONSULTING ENGINEERS
 CLEVELAND, OHIO
 NEW YORK
 PIER 1
 RAMP E-15 OVER EAST 14th ST.
 BR. NO. CUY-21-1573B STA. 15+27.70
 Scale: 1/4"=1'-0" Except as noted.
 STA. 16+96.91
 WILLOW-INNER BELT FREEWAY
 CLEVELAND, OHIO
 CUYAHOGA COUNTY
 DRAWN BY: TRACID CHECKED BY: REW/MLD REVISED 9-24-60
 DATE: 7-4-61 DATE: 4-18-61 DATE: 12-5-61 SHEET 48


MICROFILMED
JUL 9 1985

FED. ROAD DIST. NO.	STATE	FED. AID PROJ. NO.	149
2	OHIO		175

CUYAHOGA COUNTY
CITY OF CLEVELAND
CUY-42-18-29

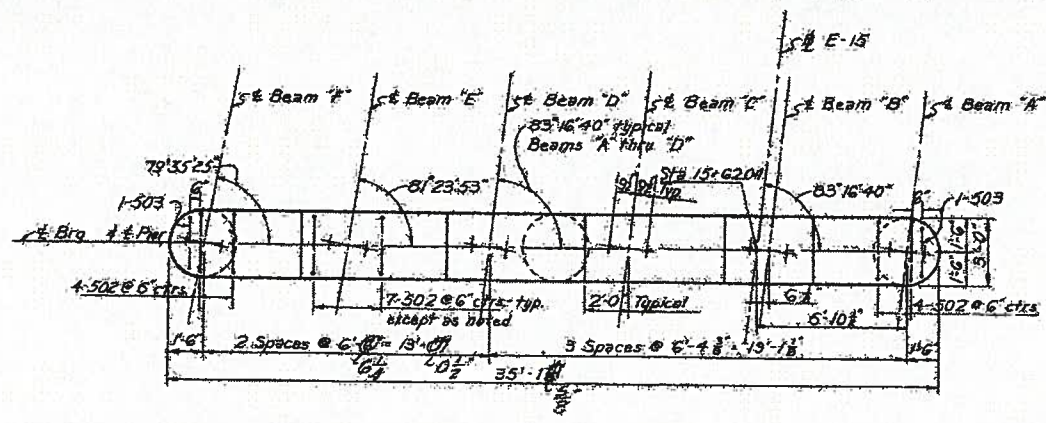

PLAN

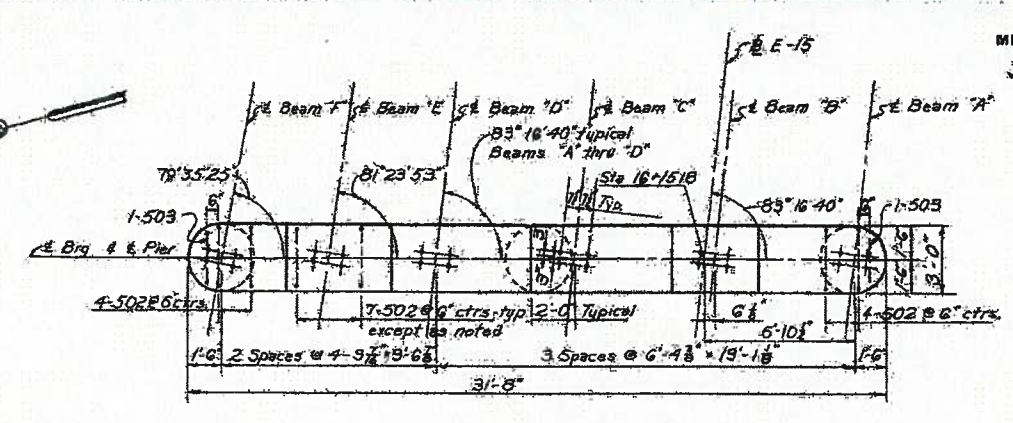


PLAN


Note: Special care shall be taken when placing reinforcing steel so as not to interfere with anchor bar setting.
Anchor bars to be furnished and set under X-tie contract.

Note: Provide electrical ground wire in outside columns of Pier 2. See notes on Sh 57A-G.
Special care shall be taken in placing of electrical ground so as not to interfere with shoe base plate.

Note: Prefix "P.R." shall be assigned to all bar marks.

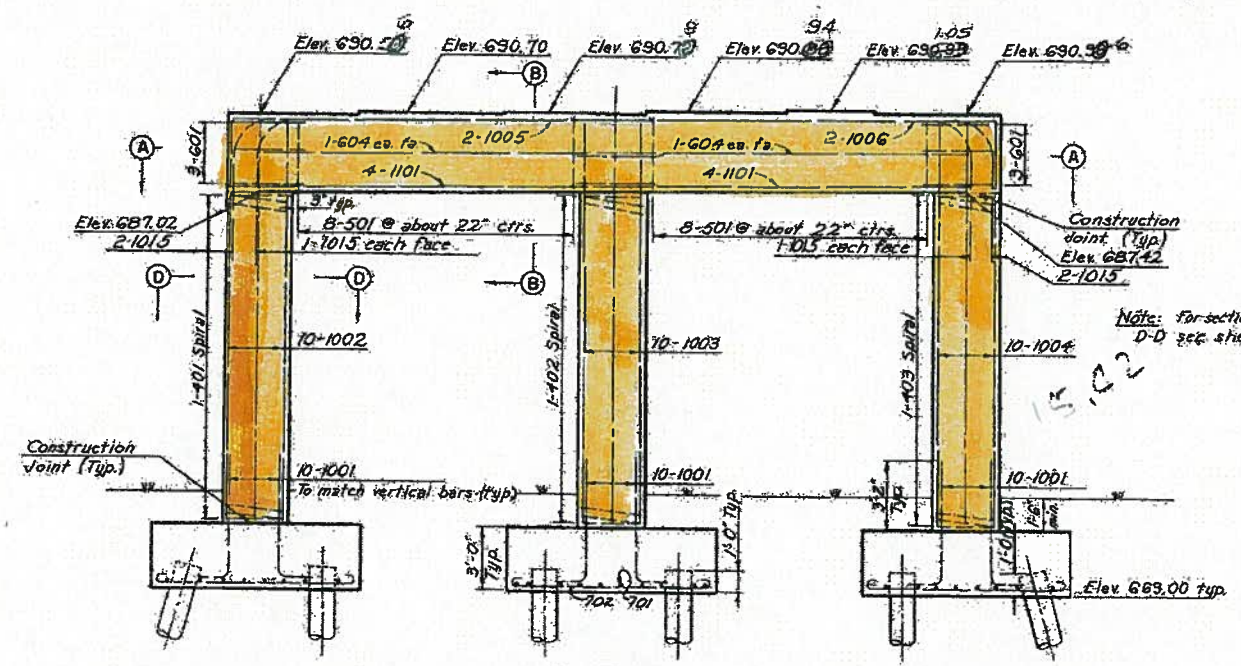


ELEVATION

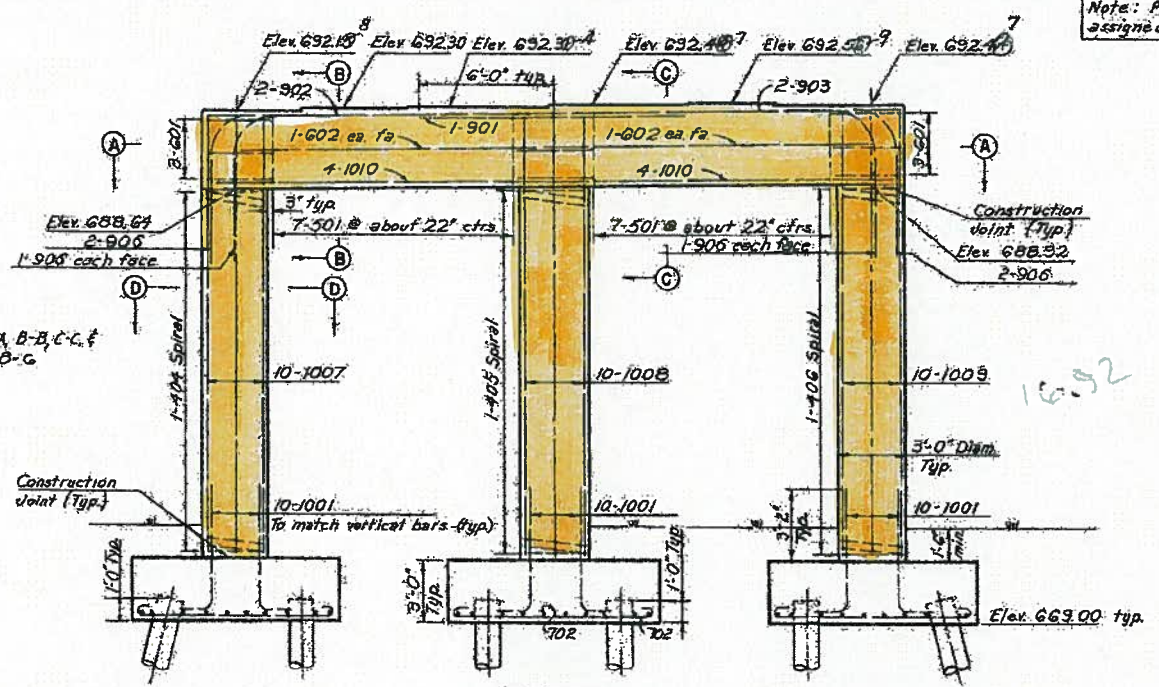


ELEVATION

Note: For sections A-A, B-B, C-C & D-D see sheet 148-G.

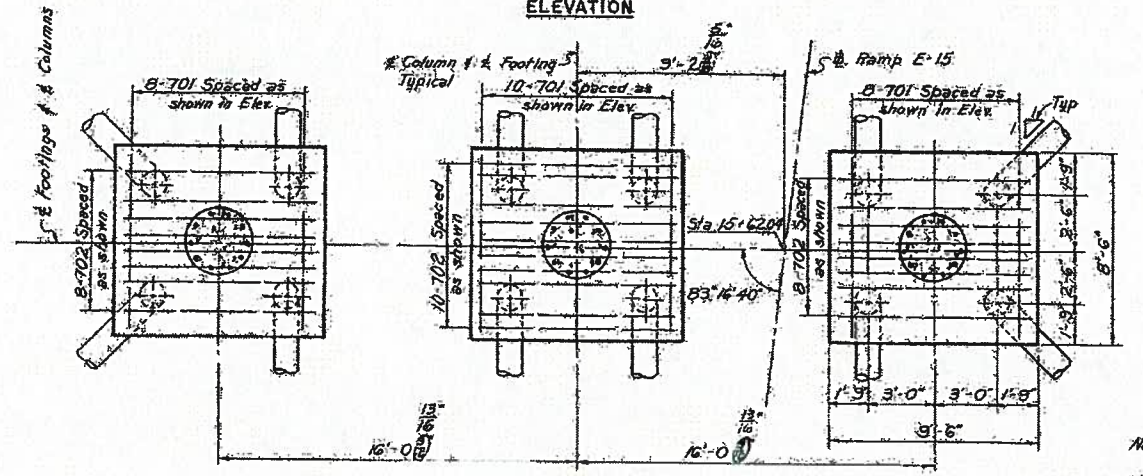

FOOTING PLAN

PIER 3

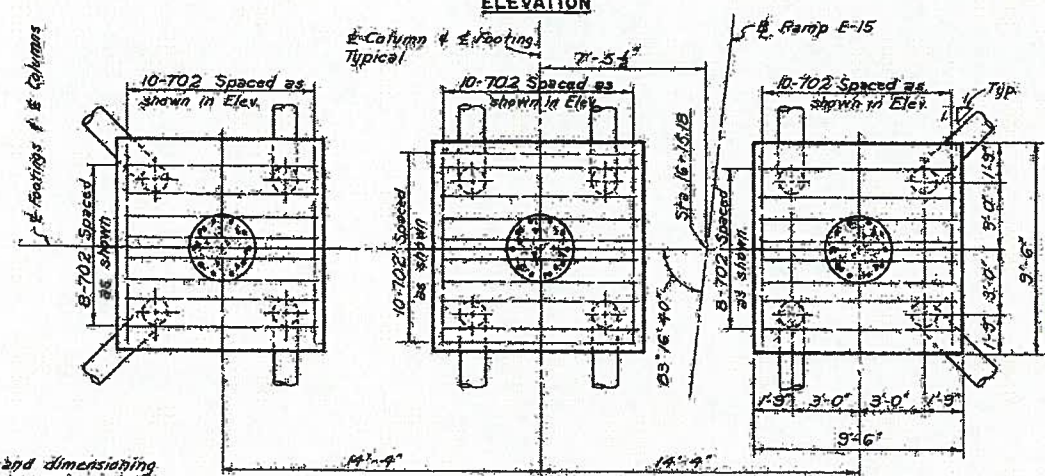

FOOTING PLAN

PIER 2

Note: Pile spacing and dimensioning shown for each pier is typical for all footings.

NOTE: For Reinforcement Schedule and Notes see sheet 148-G.

H.N.T.B. BR. NO. 9 PART 6

HOWARD, NEEDLES, TAMMEN & BERGENDOFF
CONSULTING ENGINEERS
CLEVELAND, OHIO


PIERS 2 & 3
RAMP E-15 OVER EAST 14TH ST.
BR. NO. CUY-21-1573B STA. 15+27.70
Scale: 1/4" = 1'-0" STA. 16+98.91

WILLOW-INNER BELT FREEWAY
CLEVELAND CUYAHOGA COUNTY OHIO




DATE 7-21-60	DATE 7-21-60	DATE 7-21-60	DATE 7-21-60
DATE 7-21-60	DATE 7-21-60	DATE 7-21-60	DATE 7-21-60

Revised 7-21-60.




CUYAHOGA COUNTY
 CITY OF CLEVELAND
 CUY-21-15.82
 CUY-42-18.42

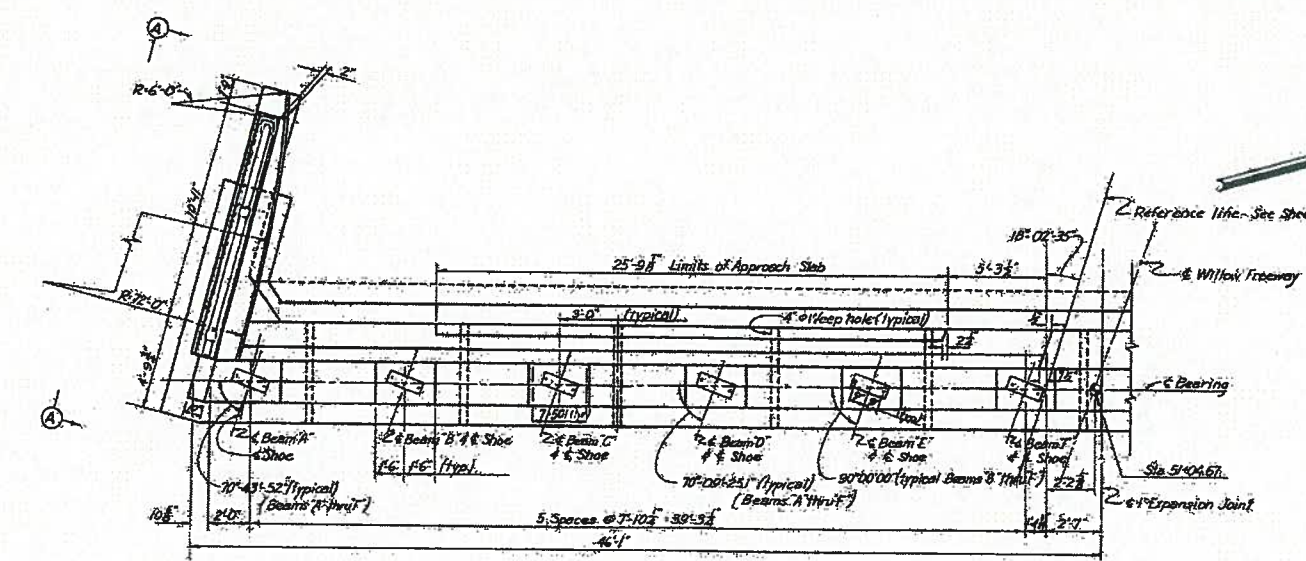


Note:
 Ends of railing parapet shall
 be vertical to top of safety curb.

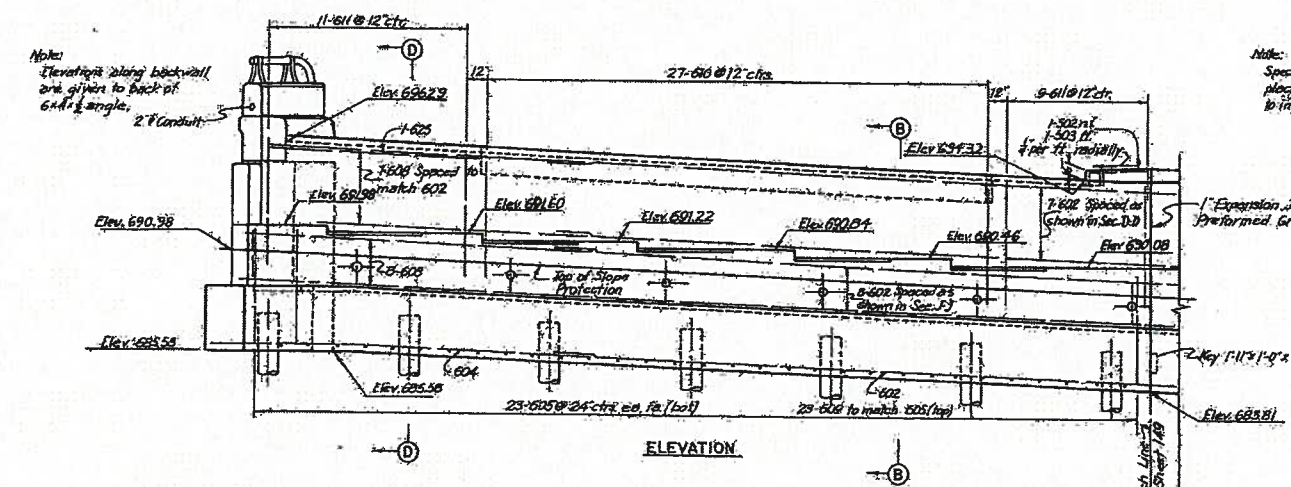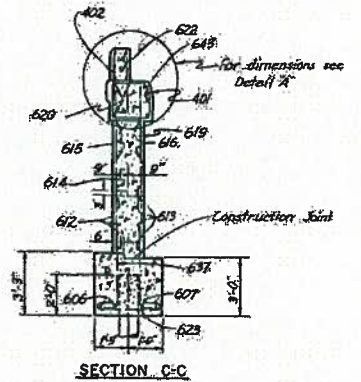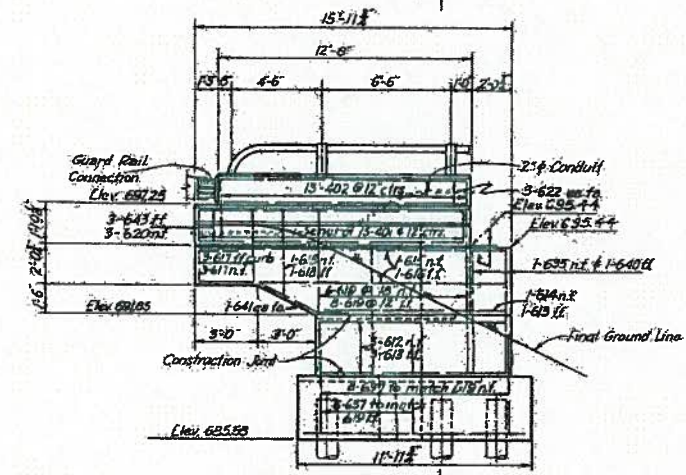

Note:
 Special care shall be taken when
 placing reinforcing steel so as not
 to interfere with anchor bolt setting.

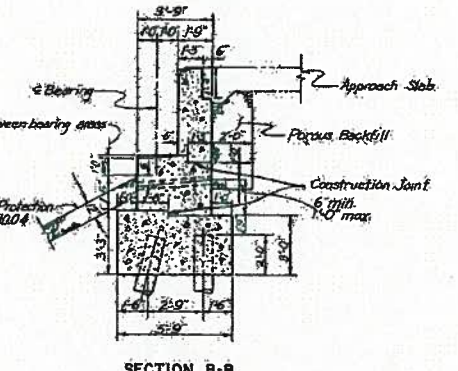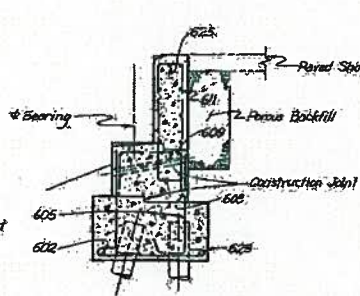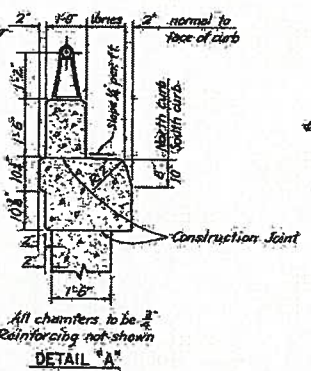

NOTES:
 All piles shall be 12" dia. reinforced concrete.
 All battered piles shall be battered 3 in 12 in direction shown.
 Pile spacings are given along bottom of footing.
 For additional notes see sheet 148-7A.

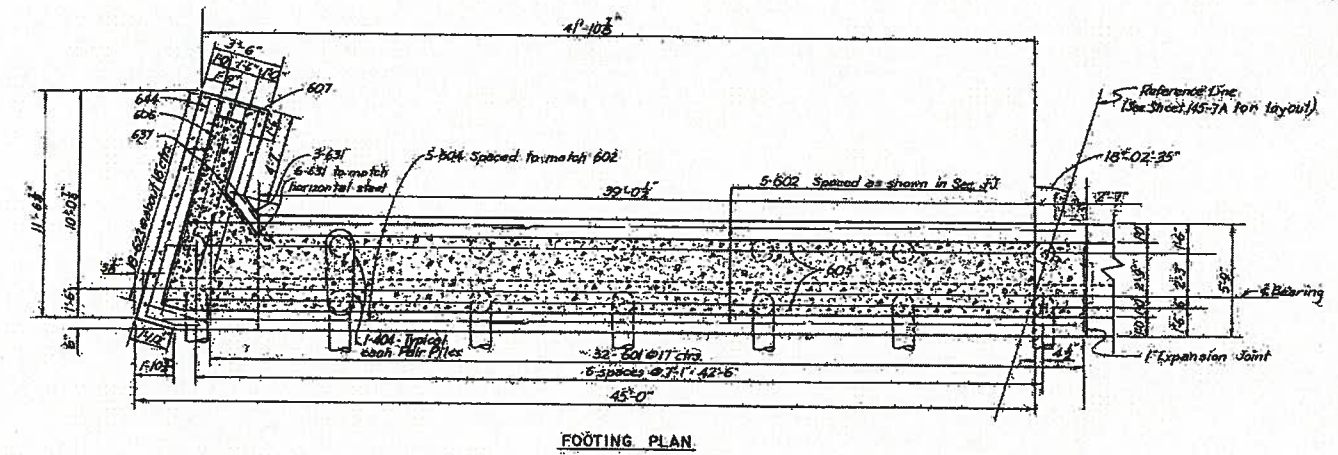


Note: Precast "AB" shall be
 assigned to all bar marks.

DATE	BY	CHECKED	REVIEWED	NOTED
DATE 2/15/00	DATE 9/9/00	DATE 2/23/00	DATE 2/23/00	DATE 2/23/00


WEST ABUTMENT-SOUTH HALF
 WILLOW FREEWAY OVER EAST 14TH ST.
 BR. NO. CUY-21-1573A STA. 49+30.16
 Scale: 1/4"=1'-0" Except as noted STA. 51+07.08
 WILLOW-INNER BELT FREEWAY
 CLEVELAND CUYAHOGA COUNTY OHIO

CUYAHOGA COUNTY
CITY OF CLEVELAND
CUT-21-1532
CUT-42-18.42

PROJECT NUMBER
JUL 8 1935

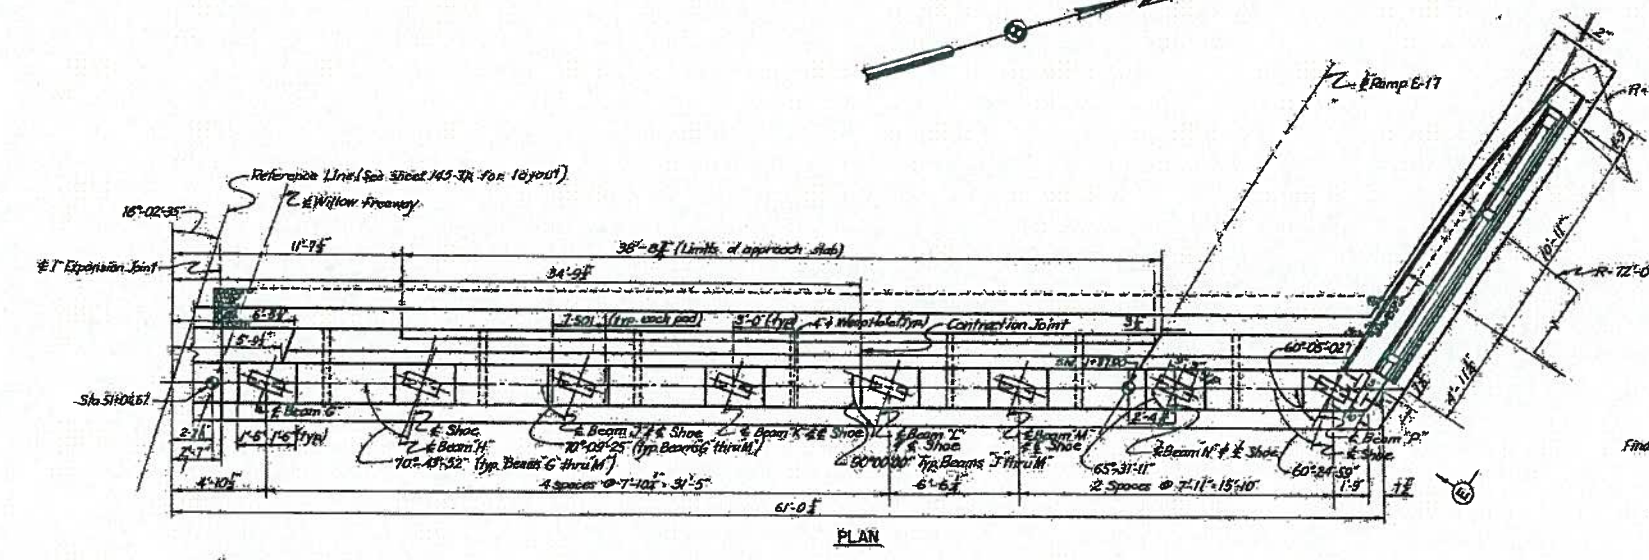


PLAN

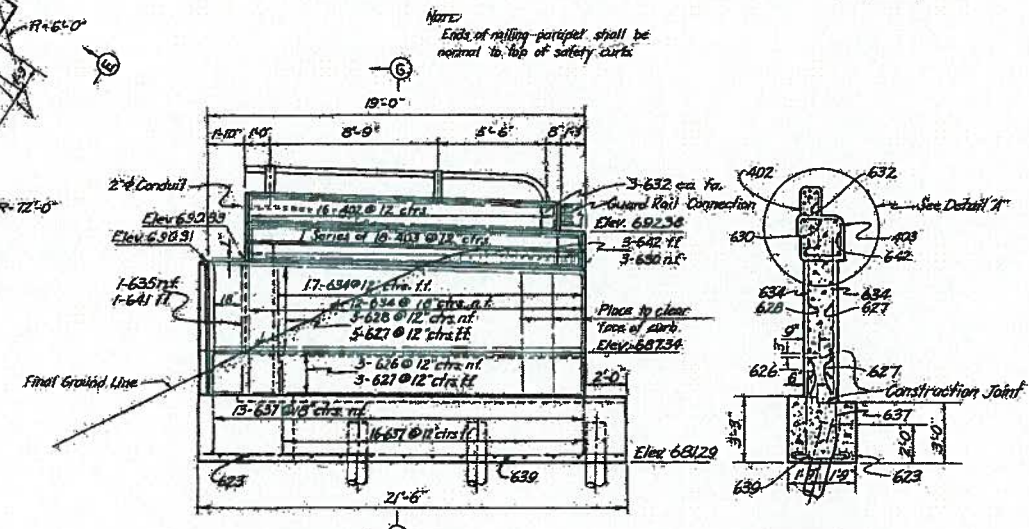


ELEVATION E-E

SECTION G-G

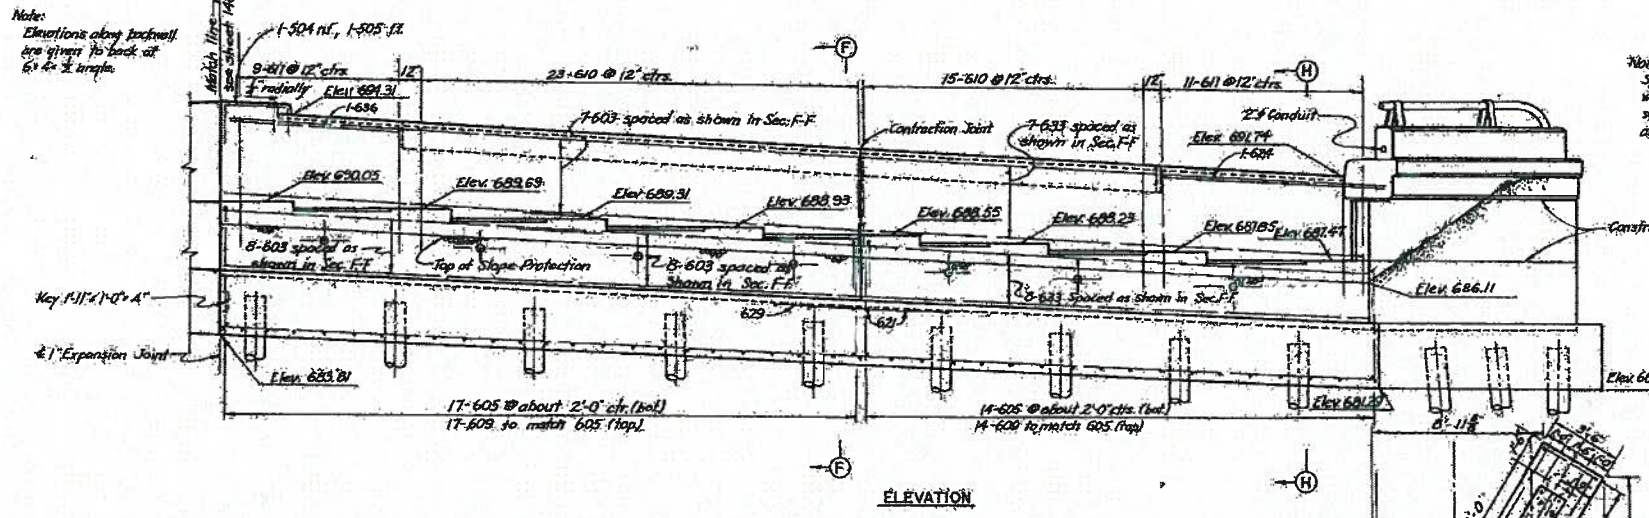


ELEVATION

Notes:
Special care shall be taken when placing reinforcing steel so as not to interfere with anchor bar setting.

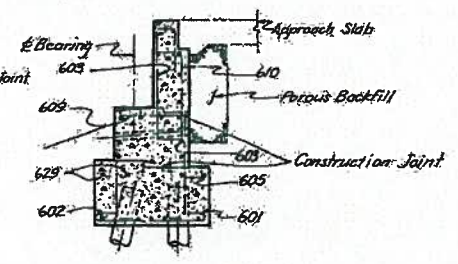


SECTION F-F (shown)
SECTION J-J (similar)

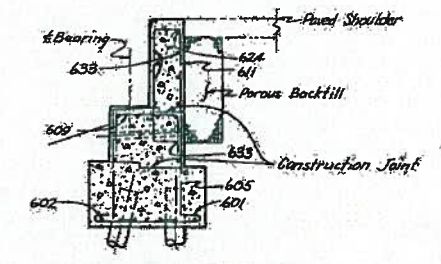

SECTION H-H

For dimensions and details not shown in view, see section B-B sheet






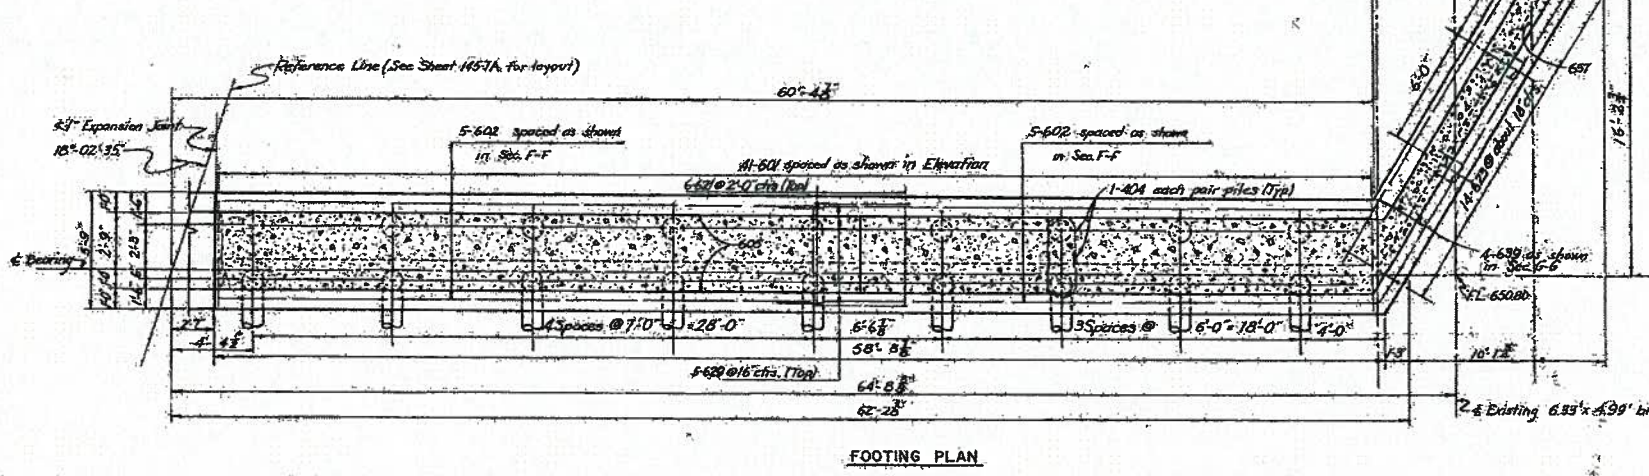


FOOTING PLAN

Note: Profile '48' shall be assigned to all bar marks.

For additional notes see sheet 146-7A

H.N.T.B. BR. NO. 8		PART 7A	
HOWARD, NEEDLES, TAMMEN & BERGENDOFF CIVIL ENGINEERS CLEVELAND, OHIO			
WEST ABUTMENT-NORTH HALF			
WILLOW FREEWAY OVER EAST 14TH ST.		BR. NO. CUY-21-1575A STA. 49+30.16	
Scale: 1/4" = 1'-0"		STA. 51+07.08	
WILLOW-INNER BELT FREEWAY CLEVELAND CUYAHOGA COUNTY OHIO			
DESIGNED BY	CHECKED BY	REVIEWED BY	DATE
DATE	DATE	DATE	DATE
			SHEET 149

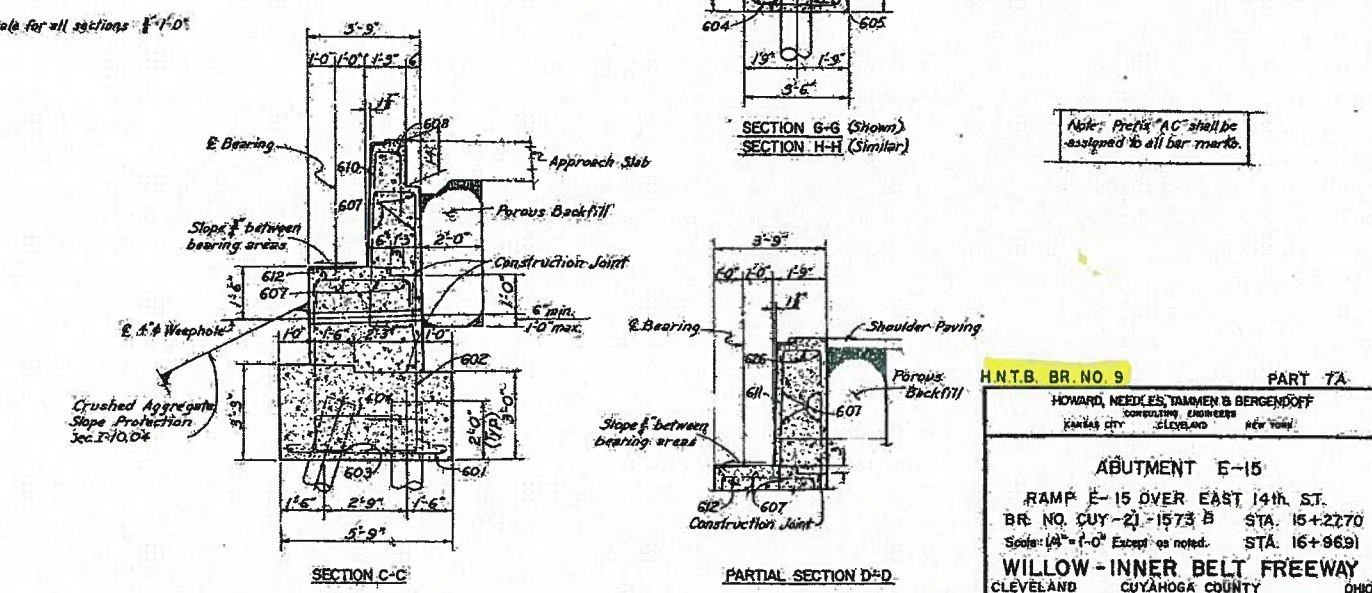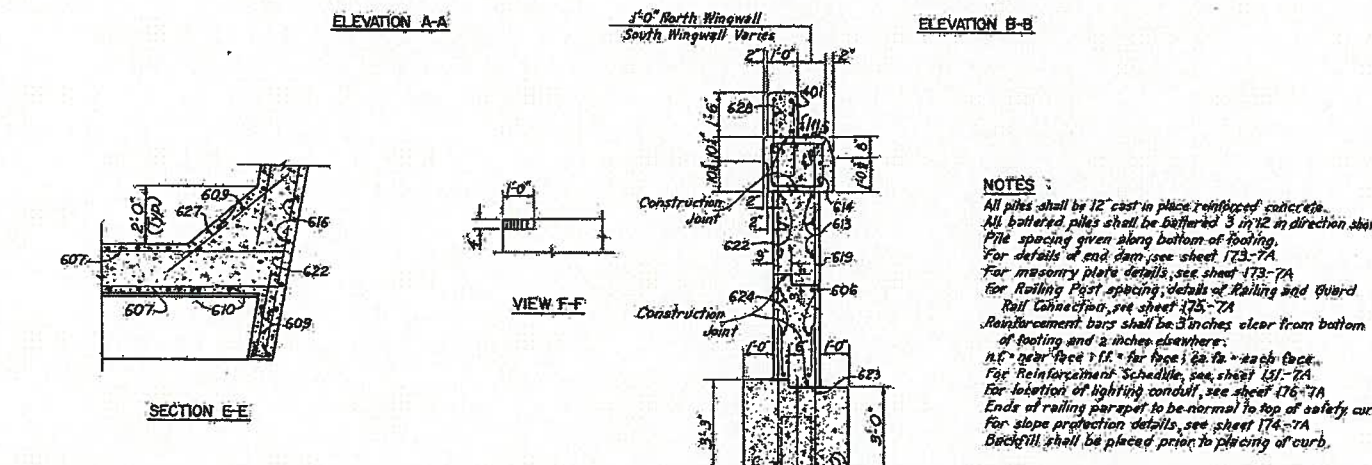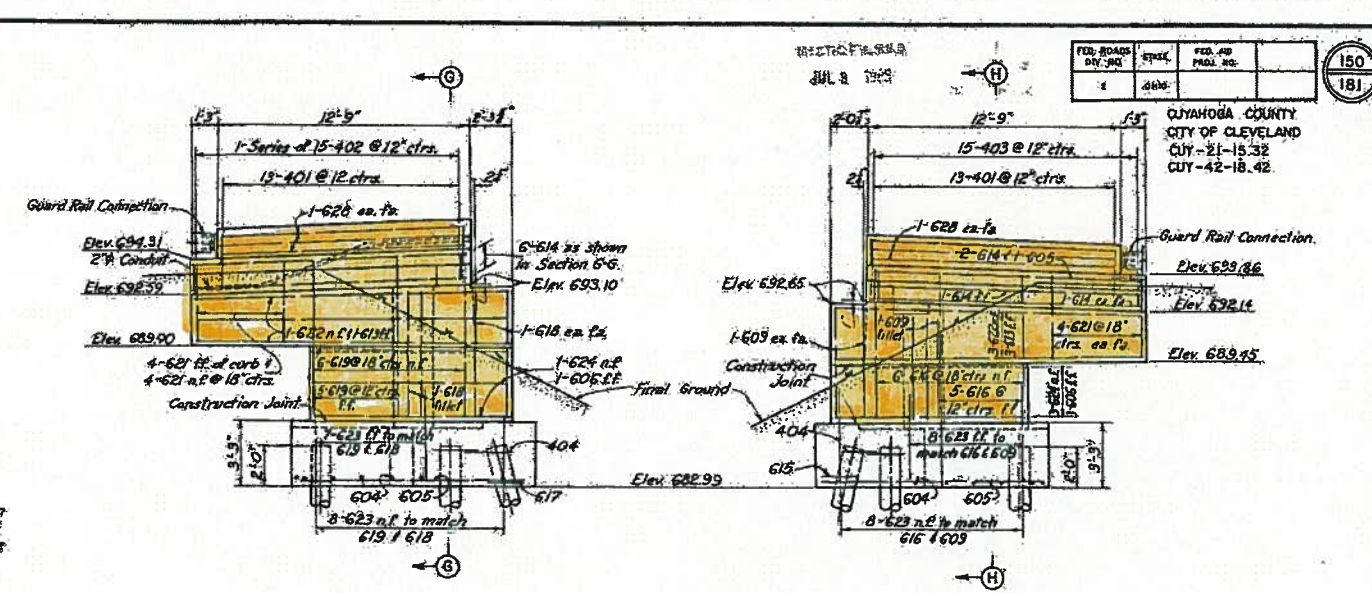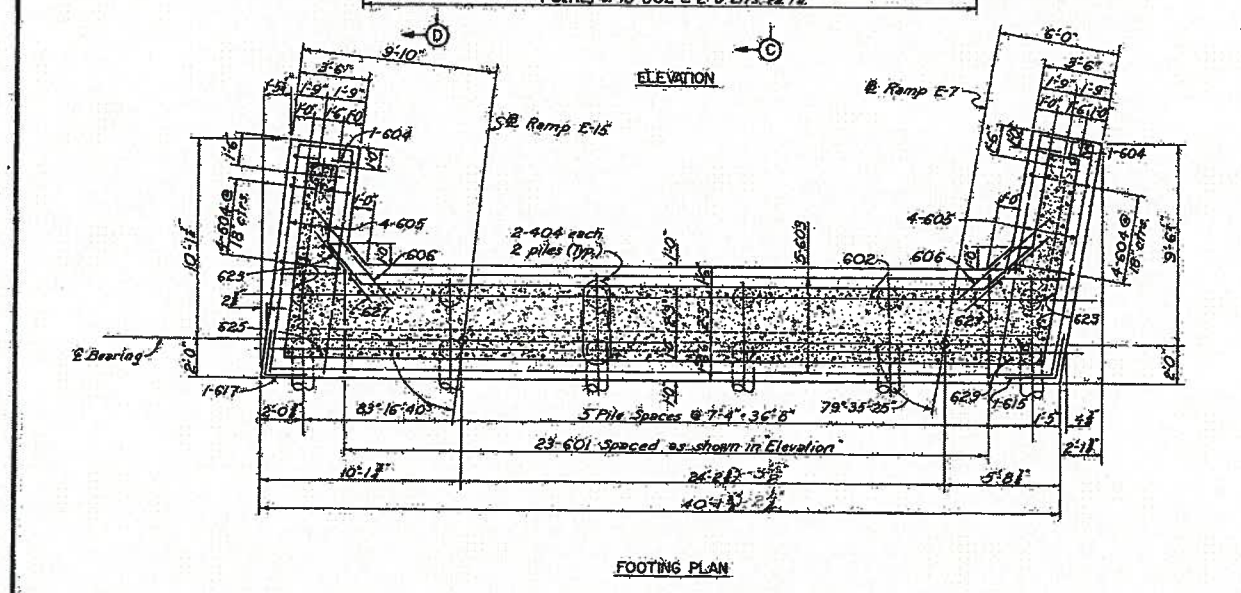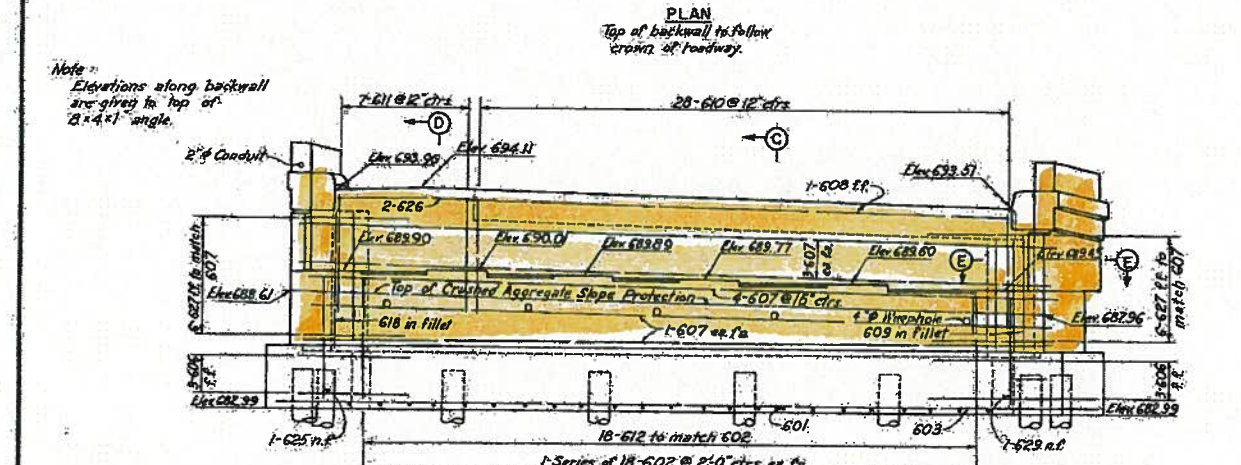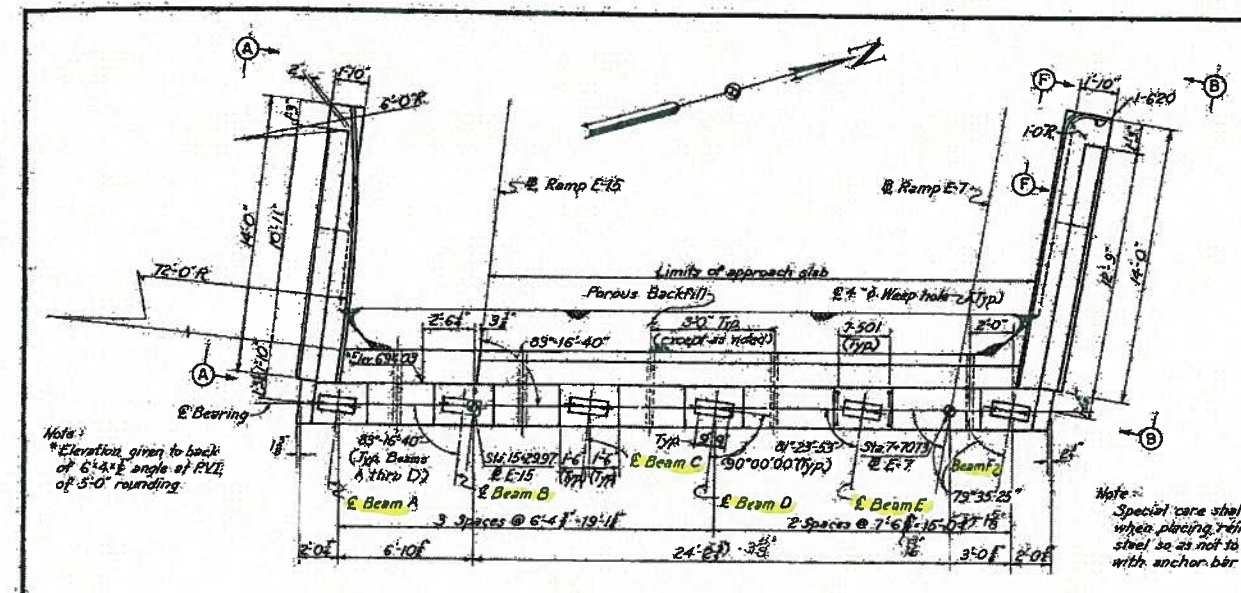

FED. ROAD DIST. NO.	150
DATE	181

CUYAHOGA COUNTY
CITY OF CLEVELAND
CITY-21-15.32
CITY-42-18.42




NOTES:

- All piles shall be 12" cast in place reinforced concrete.
- All battered piles shall be battered 3 in 12 in direction shown.
- Pile spacing given along bottom of footing.
- For details of end dam, see sheet 173-7A.
- For Rolling Post spacing, details of Rolling and Guard Rail Connections, see sheet 175-7A.
- Reinforcement bars shall be 3 inches clear from bottom of footing and 2 inches elsewhere.
- NC = near face 1/2" for face; 2" for back.
- For Reinforcement Schedule, see sheet 151-7A.
- For location of lighting conduit, see sheet 176-7A.
- Ends of railing parapet to be normal to top of safety curb.
- For slope protection details, see sheet 174-7A.
- Backfill shall be placed prior to placing of curb.

Note: Profile "AC" shall be assigned to all bar marks.

H.N.T.B. BR. NO. 9		PART 7A	
HOWARD, NEEDLES TAMMEN & BERGENDOFF CONSULTING ENGINEERS CLEVELAND, OHIO			
ABUTMENT E-15			
RAMP E-15 OVER EAST 14th ST.			
BR. NO. CUY-21-1573 B STA. 15+22.70			
Scale: (A) = 1'-0" Except as noted. STA. 15+86.91			
WILLOW - INNER BELT FREEWAY			
CLEVELAND CUYAHOGA COUNTY OHIO			
DESIGNED BY	CHECKED BY	APPROVED BY	REVISION
DATE: 5-20-59	DATE: 2-25-59	DATE: 3-2-59	NO. 1
			REVISION 7-21-60
			SHEET 150

CUYAHOGA COUNTY
CITY OF CLEVELAND
CLY-21-15.32
CLY-42-18.42

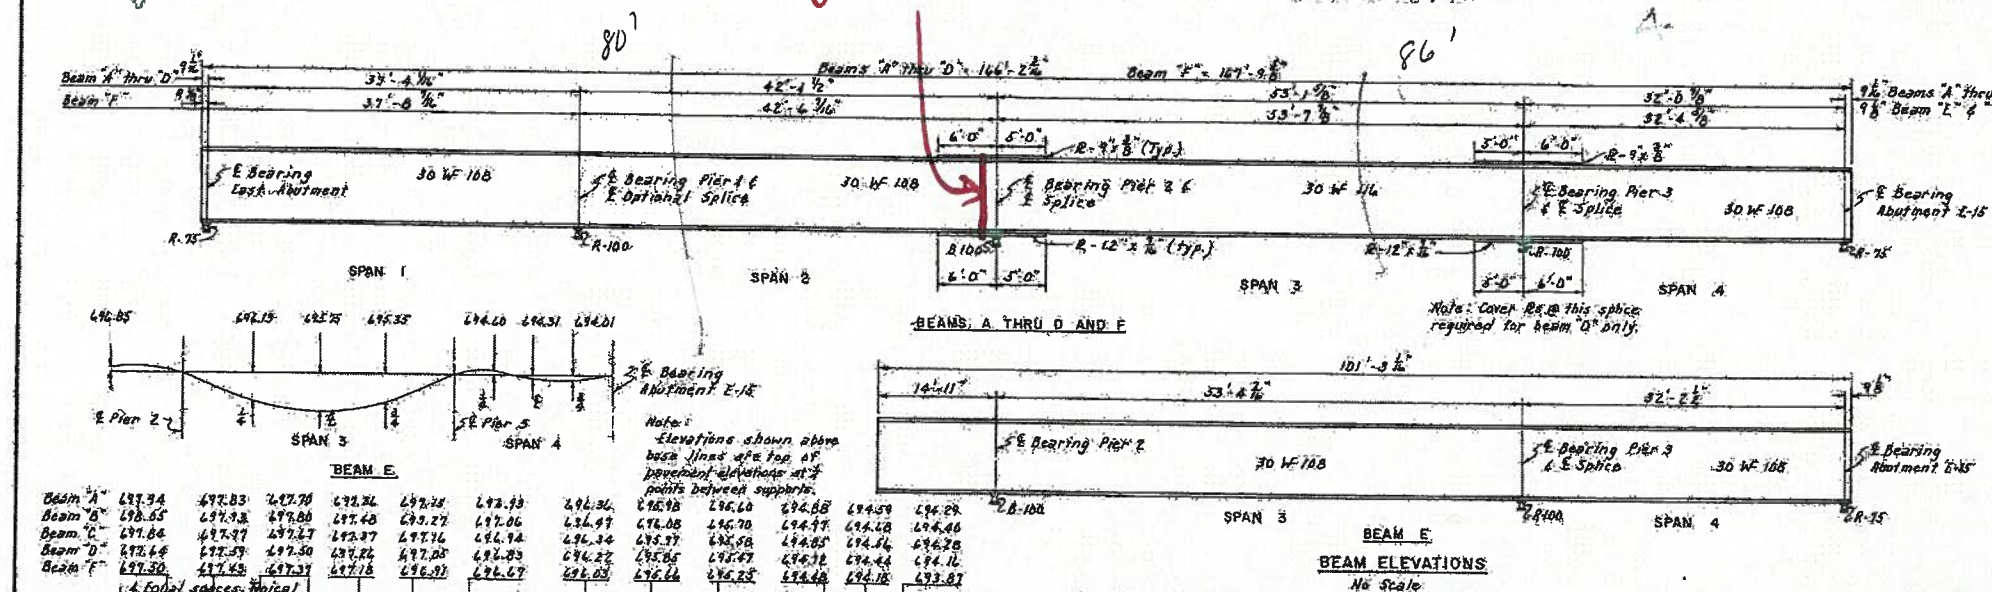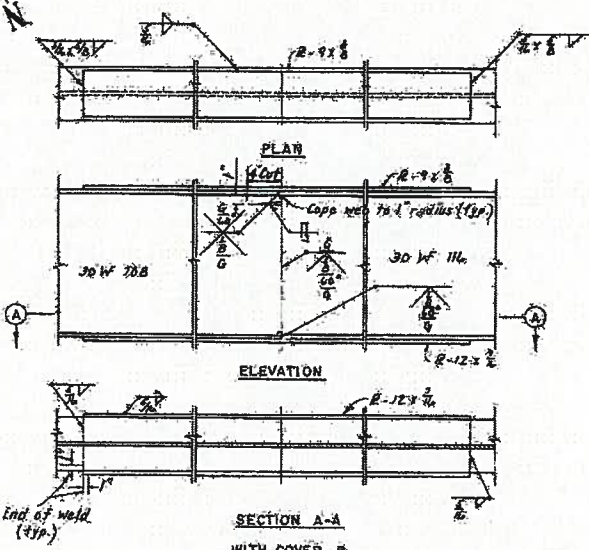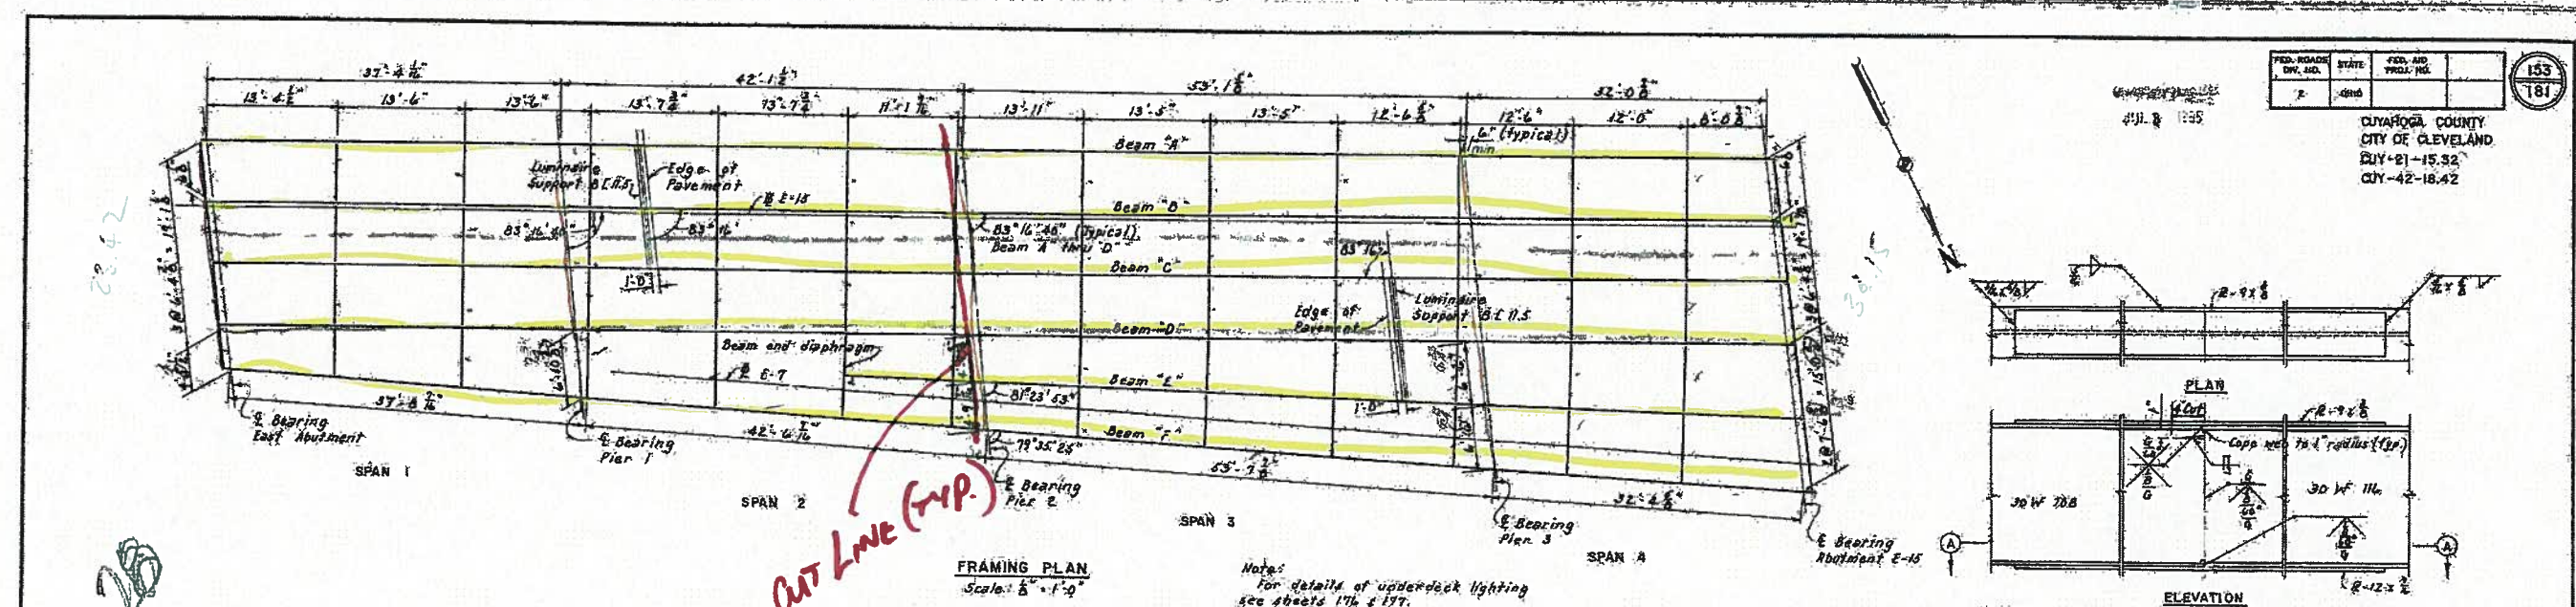

BEAM ELEVATIONS

Beam	1/4	1/8	3/8	1/2	5/8	3/4	7/8	End of Beam
Beam A	697.94	697.83	697.70	697.56	697.43	697.30	697.17	697.04
Beam B	698.05	697.93	697.80	697.67	697.54	697.41	697.28	697.15
Beam C	697.84	697.72	697.60	697.47	697.34	697.21	697.08	696.95
Beam D	697.64	697.52	697.40	697.27	697.14	697.01	696.88	696.75
Beam E	697.30	697.18	697.06	696.93	696.80	696.67	696.54	696.41

BEAM DEFLECTION DIAGRAMS

ELEVATIONS AND DEFLECTIONS

BEAM	EAST ABUTMENT		SPAN 1			PIER NO. 1			SPAN 2			PIER NO. 2			SPAN 3			PIER NO. 3			SPAN 4			ABUTMENT E-15	
	TOP OF BEAM ELEVATION	TOP OF PVMT. ELEVATION	D.L. CON.	D.L. DEF.	D.L. DEF.	TOP OF BEAM ELEVATION	TOP OF PVMT. ELEVATION	D.L. CON.	D.L. DEF.	D.L. DEF.	TOP OF BEAM ELEVATION	TOP OF PVMT. ELEVATION	D.L. CON.	D.L. DEF.	D.L. DEF.	TOP OF BEAM ELEVATION	TOP OF PVMT. ELEVATION	D.L. CON.	D.L. DEF.	D.L. DEF.	TOP OF BEAM ELEVATION	TOP OF PVMT. ELEVATION	TOP OF BEAM ELEVATION	TOP OF PVMT. ELEVATION	
A	697.25	698.05	3/8	3/8	3/8	696.93	697.23	0	0	0	695.90	696.70	3/8	3/8	3/8	694.30	695.10	0	0	0	693.20	694.00	693.20	694.00	
B	697.30	698.15	3/8	3/8	3/8	696.87	697.67	0	0	0	695.82	696.62	3/8	3/8	3/8	694.34	695.14	0	0	0	693.20	694.00	693.20	694.00	
C	697.18	697.99	3/8	3/8	3/8	696.75	697.55	0	0	0	695.77	696.57	3/8	3/8	3/8	694.22	695.02	0	0	0	693.09	693.89	693.09	693.89	
D	696.88	697.68	3/8	3/8	3/8	696.62	697.42	0	0	0	695.77	696.57	3/8	3/8	3/8	694.22	695.02	0	0	0	693.09	693.89	693.09	693.89	
E	696.74	697.54	3/8	3/8	3/8	696.49	697.29	0	0	0	695.62	696.41	3/8	3/8	3/8	694.08	694.88	0	0	0	692.95	693.75	692.95	693.55	

NOTES:

Top of beam elevations are exclusive of cover plates.
For details of end dams, see sheet 173-74.
For cross frame details, see sheet 173-74.
For Drainage Details, see sheet 174-75.
For details of rocker/masonry plates, see sheet 173-74.
For other rocker and bolster details, see Ohio Standard Drawing RB-1-32.
Elevations shown in table are located at intersections of E bearing and E beams.

BEAM SPLICE WELDING PROCEDURE

1. Splice ends of beams A thru D and E at Pier 2.
2. Butt-weld the beam flanges and web at Pier 2 using the following sequence: make two passes on each flange then two on the web, repeat using one pass at each location, until welds are completed.
3. Weld the top and bottom cover plates.
4. Lower the beam ends at Pier 2 to final position.
5. Repeat step 2 and 3 at the face of beam D at Pier 3. No welding of beam ends @ Abutment E-15 required. (The above procedure assumes that no splice is made at Pier 1. If the beams are spliced at Pier 1, only step 2 is required.)

NOTES:

The beams in Span 3 shall be cambered as follows:
Where the span of the deflections and convexity is 1/2" to 1"
The required camber will be 1/2" and if greater than 1/2", the required camber will be the same as the span.
Beams in Span 1, 2 & 4 do not require camber, but shall be fabricated so that any curved beam will be placed with the convex flange up.
Deflections are given of the quarter points and are measured to the nearest 1/16".
In Elevation and Deflection Table, the following abbreviations are used:
(D.L. DEF.) denotes dead load deflections. (TOT) refers to total deflections from dead load of steel and concrete.
(CON) denotes deflections for concrete.
Convexity denotes corrections required for the vertical curvature of the roadway gradient.
(PVMT) denotes pavement.

NOTES:

The beams in Span 3 shall be cambered as follows:
Where the span of the deflections and convexity is 1/2" to 1"
The required camber will be 1/2" and if greater than 1/2", the required camber will be the same as the span.
Beams in Span 1, 2 & 4 do not require camber, but shall be fabricated so that any curved beam will be placed with the convex flange up.
Deflections are given of the quarter points and are measured to the nearest 1/16".
In Elevation and Deflection Table, the following abbreviations are used:
(D.L. DEF.) denotes dead load deflections. (TOT) refers to total deflections from dead load of steel and concrete.
(CON) denotes deflections for concrete.
Convexity denotes corrections required for the vertical curvature of the roadway gradient.
(PVMT) denotes pavement.

H.N.T.B. BR. NO. 9 PART 7A

HOWARD, NEEDLES TAMMEN & BERGENDOFF
CONSULTING ENGINEERS
CLEVELAND, OHIO

FRAMING PLAN

RAMP E-15 OVER EAST 14TH ST.
BR. NO. CLY-21-1573 B STA. 15+27.70
Scale: As noted STA. 16+96.91

WILLOW-INNER BELT FREEWAY
CLEVELAND, CUYAHOGA COUNTY, OHIO

DATE: 8-8-58 DATE: 8-15-58 DATE: 8-15-58 DATE: 8-15-58
DRAWN BY: TRAGEDY CHECKED BY: MCHENRY
DATE: 8-8-58 DATE: 8-15-58 DATE: 8-15-58 DATE: 8-15-58

SPECIFICATIONS



ENGINE

Model.....Komatsu SAA6D114E-5*
 Type.....Water-cooled, 4-cycle, direct Injection
 Aspiration..... Turbocharged, aftercooled, cooled EGR
 Number of cylinders..... 6
 Bore..... 114 mm **4.49"**
 Stroke..... 144.5 mm **5.69"**
 Piston displacement..... 8.85 ltr **540 in³**
 Horsepower:
 SAE J1995.....Gross 202 kW **271 HP**
 ISO 9249 / SAE J1349..... Net 192 kW **257 HP**
 Rated rpm..... 1950
 Fan drive method for radiator cooling..... Mechanical
 Governor..... All-speed control, electronic
 *EPA Tier 4 Interim and EU stage 3B emissions certified



HYDRAULICS

Type.....HydrauMind (Hydraulic Mechanical Intelligence New Design) system, closed-center system with load sensing valves and pressure compensated valves
 Number of selectable working modes..... 6
 Main pump:
 Type.....Variable displacement piston type
 Pumps for.....Boom, arm, bucket, swing, and travel circuits
 Maximum flow..... 535 ltr/min **141.3 gal/min**
 Supply for control circuit..... Self-reducing valve
 Hydraulic motors:
 Travel..... 2 x axial piston motors with parking brake
 Swing..... 1 x axial piston motor with swing holding brake
 Relief valve setting:
 Implement circuits..... 37.3 MPa 380 kg/cm² **5,400 psi**
 Travel circuit..... 37.3 MPa 380 kg/cm² **5,400 psi**
 Swing circuit..... 27.9 MPa 285 kg/cm² **4,050 psi**
 Pilot circuit..... 3.2 MPa 33 kg/cm² **470 psi**

Hydraulic cylinders:
 (Number of cylinders – bore x stroke x rod diameter)
 Boom 2-140 mm x 1480 mm x 100 mm **5.5" x 58.3" x 3.9"**
 Arm 1-160 mm x 1825 mm x 110 mm **6.3" x 71.9" x 4.3"**
 Bucket..... for 3.2 m **10'5"** and 4.0 m **13'2"** Arms
 1-140 mm x 1285 mm x 100 mm **5.5" x 50.6" x 3.9"**
 for 2.54 m **8'4"** Arm
 1-150 mm x 1285 mm x 110 mm **5.9" x 50.6" x 4.3"**



DRIVES AND BRAKES

Steering control.....Two levers with pedals
 Drive method..... Hydrostatic
 Maximum drawbar pull..... 290 kN 29570 kg **65,191 lb**
 Gradeability..... 70%, 35%
 Maximum travel speed: High..... 5.5 km/h **3.4 mph**
 (Auto-Shift) Mid..... 4.5 km/h **2.8 mph**
 (Auto-Shift) Low..... 3.2 km/h **2.0 mph**
 Service brake..... Hydraulic lock
 Parking brake..... Mechanical disc brake



SWING SYSTEM

Drive method..... Hydrostatic
 Swing reduction..... Planetary gear
 Swing circle lubrication..... Grease-bathed
 Service brake..... Hydraulic lock
 Holding brake/Swing lock..... Mechanical disc brake
 Swing speed..... 9.5 rpm
 Swing torque..... 11386 kg•m **82,313 ft lbs**



UNDERCARRIAGE

Center frame.....X-frame
 Track frame.....Box-section
 Seal of track.....Sealed track
 Track adjuster.....Hydraulic
 Number of shoes (each side)..... 48
 Number of carrier rollers (each side)..... 2
 Number of track rollers (each side)..... 8



COOLANT & LUBRICANT CAPACITY (REFILLING)

Fuel tank..... 605 ltr **159.8 U.S. gal**
 Coolant..... 37 ltr **9.7 U.S. gal**
 Engine.....35 ltr **9.2 U.S. gal**
 Final drive, each side.....9.0 ltr **2.4 U.S. gal**
 Swing drive..... 13.7 ltr **3.6 U.S. gal**
 Hydraulic tank..... 188 ltr **49.7 U.S. gal**
 Hydraulic system..... 365 ltr **96.4 U.S. gal**



OPERATING WEIGHT (APPROXIMATE)

Operating weight includes 6500 mm **21'3"** one-piece HD boom, 3185 mm **10'5"** arm, SAE heaped 1.96 m³ **2.56 yd³** bucket, rated capacity of lubricants, coolant, full fuel tank, operator, and standard equipment.

Triple-Grouser Shoes	Operating Weight	Ground Pressure
700 mm	35,496 kg	0.59 kg/cm ²
28"	78,255 lb	8.31 psi
800 mm	35876 kg	0.52 kg/cm ²
31.5"	79,093 lb	7.40 psi
850 mm	36255 kg	0.50 kg/cm ²
33.5"	79,930 lb	7.00 psi

Component Weights



Arm including bucket cylinder and linkage
 3185 mm **10'5"** arm assembly..... 1761 kg **3,882 lb**
 4020 mm **13'2"** arm assembly..... 1988 kg **4,383 lb**
 One piece HD boom including arm cylinder
 6500 mm **21'3"** boom assembly..... 3135 kg **6,912 lb**
 Boom cylinders x 2..... 259 kg **571 lb**
 Counterweight..... 7090 kg **15,631 lb**
 1.96 m³ **2.56 yd³** bucket - 54" width..... 1554 kg **3,425 lb**

SPECIFICATIONS



DIMENSIONS

Arm Length	2540 mm	8'4"	3185 mm	10'6"	4020 mm	13'2"
A Overall length	11180 mm	36'8"	11145 mm	36'7"	11170 mm	36'8"
B Length on ground (transport)	6760 mm	22'2"	5935 mm	19'6"	5475 mm	18'0"
C Overall height (to top of boom)*	3410 mm	11'2"	3285 mm	10'9"	3760 mm	12'4"
D Overall width	3440 mm	11'3"				
E Overall height (to top of cab)*	3160 mm	10'4"				
F Overall height (to top of handrail)*	3255 mm	10'8"				
G Ground clearance, counterweight	1185 mm	3'11"				
H Ground clearance, minimum	498 mm	1'8"				
I Tail swing radius	3445 mm	11'4"				
J Track length on ground	4030 mm	13'3"				
K Track length	4955 mm	16'3"				
L Track gauge	2590 mm	8'6"				
M Width of crawler	3440 mm	11'3"				
N Shoe width	850 mm	33.5"				
O Grouser height	36 mm	1.4"				
P Machine cab height	2750 mm	9'0"				
Q Machine cab width **	3145 mm	10'4"				
R Distance, swing center to rear end	3405 mm	11'2"				

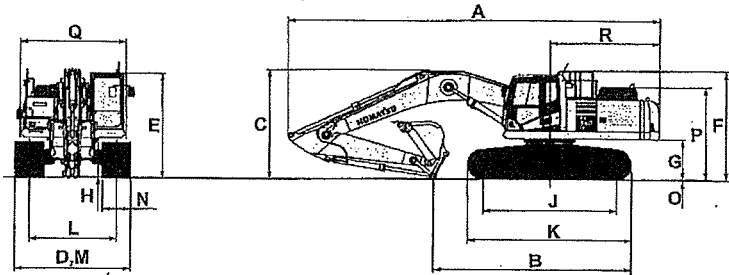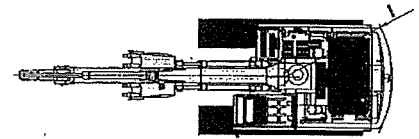

* : Including grouser height

** : Including handrail



BACKHOE BUCKET, ARM AND BOOM COMBINATION

Bucket Type	Bucket				6.5 m (21'3") Boom				
	Capacity		Width	Weight	2.6 m (8'4")	3.2 m (10'6")	4.0 m (13'2")		
Komatsu TL	0.93 m³	1.21 yd³	762 mm	30"	1097 kg	2418 lb	V	V	V
	1.18 m³	1.54 yd³	914 mm	36"	1198 kg	2641 lb	V	V	V
	1.44 m³	1.88 yd³	1067 mm	42"	1325 kg	2921 lb	V	V	V
	1.70 m³	2.22 yd³	1219 mm	48"	1426 kg	3144 lb	V	V	W
	1.96 m³	2.56 yd³	1372 mm	54"	1554 kg	3425 lb	W	W	X
Komatsu HP	0.68 m³	0.89 yd³	610 mm	24"	1022 kg	2254 lb	V	V	V
	0.93 m³	1.21 yd³	762 mm	30"	1178 kg	2598 lb	V	V	V
	1.18 m³	1.54 yd³	914 mm	36"	1358 kg	2993 lb	V	V	V
	1.44 m³	1.88 yd³	1067 mm	42"	1439 kg	3173 lb	V	V	V
	1.70 m³	2.22 yd³	1219 mm	48"	1555 kg	3429 lb	V	V	X
Komatsu HPS	1.96 m³	2.56 yd³	1372 mm	54"	1701 kg	3750 lb	W	X	Y
	0.68 m³	0.89 yd³	610 mm	24"	1112 kg	2451 lb	V	V	V
	0.93 m³	1.21 yd³	762 mm	30"	1294 kg	2853 lb	V	V	V
	1.18 m³	1.54 yd³	914 mm	36"	1437 kg	3167 lb	V	V	V
	1.44 m³	1.88 yd³	1067 mm	42"	1607 kg	3543 lb	V	V	W
Komatsu HPX	1.70 m³	2.22 yd³	1219 mm	48"	1750 kg	3857 lb	V	W	X
	1.96 m³	2.56 yd³	1372 mm	54"	1921 kg	4236 lb	W	X	Y
	0.68 m³	0.89 yd³	610 mm	24"	1239 kg	2731 lb	V	V	V
	0.93 m³	1.21 yd³	762 mm	30"	1421 kg	3133 lb	V	V	V
	1.18 m³	1.54 yd³	914 mm	36"	1564 kg	3447 lb	V	V	V
Komatsu HPX	1.44 m³	1.88 yd³	1067 mm	42"	1734 kg	3823 lb	V	V	W
	1.70 m³	2.22 yd³	1219 mm	48"	1877 kg	4137 lb	V	W	X
	1.96 m³	2.56 yd³	1372 mm	54"	2048 kg	4516 lb	X	X	Y

V - Used with material weights up to 3,500 lb/yd³
 W - Used with material weights up to 3,000 lb/yd³

X - Used with material weights up to 2,500 lb/yd³
 Y - Used with material weights up to 2,000 lb/yd³

Z - Not useable

PC360LC-10