

FED. RD. DIVISION	STATE	PROJECT	
2	OHIO		

306
313

LAK-2-16.49
 R/W PLAN
 LIMITED ACCESS

14
21

ALBERT E. & EMMA J. ORIS

17 WL Cont. 0.52 Ac. ±
 17 WA

JOSEPH F. & RUTH N. TANKOVICH

18 WL Cont. 0.73 Ac. ±
 18 WA

LENA CARDINA

25 WL Cont. 0.18 Ac. ±
 P.R.O. = 0.05 Ac. ±
 25 WD Cont. 0.44 Ac. ±
 P.R.O. = 0.05 Ac. ±

LOUIS COLAVECCHIO

28 WL Cont. 1.80 Ac. ±
 28 WD Cont. 0.46 Ac. ±

ROYAL E. & MARY JANE FRIES


19 WL Cont. 0.67 Ac. ±
 P.R.O. = 0.05 Ac. ±

TRACT 2
 LOT 7

E-10 REMOVAL OF BUILDINGS	
Parcel 19 WD	1 Sty. Frame Dwelling
" 20 WD	1 Sty. Frame Dwellings
" 25 WL	2 Sty. Frame Dwellings

I-26	FENCE CHAIN LINK
I-25	FENCE TYPE 39
REF. NO.	FROM TO
I-R 1817+00	1830+00
L.T.	L.F.
I.020	.555

R ROADWAY

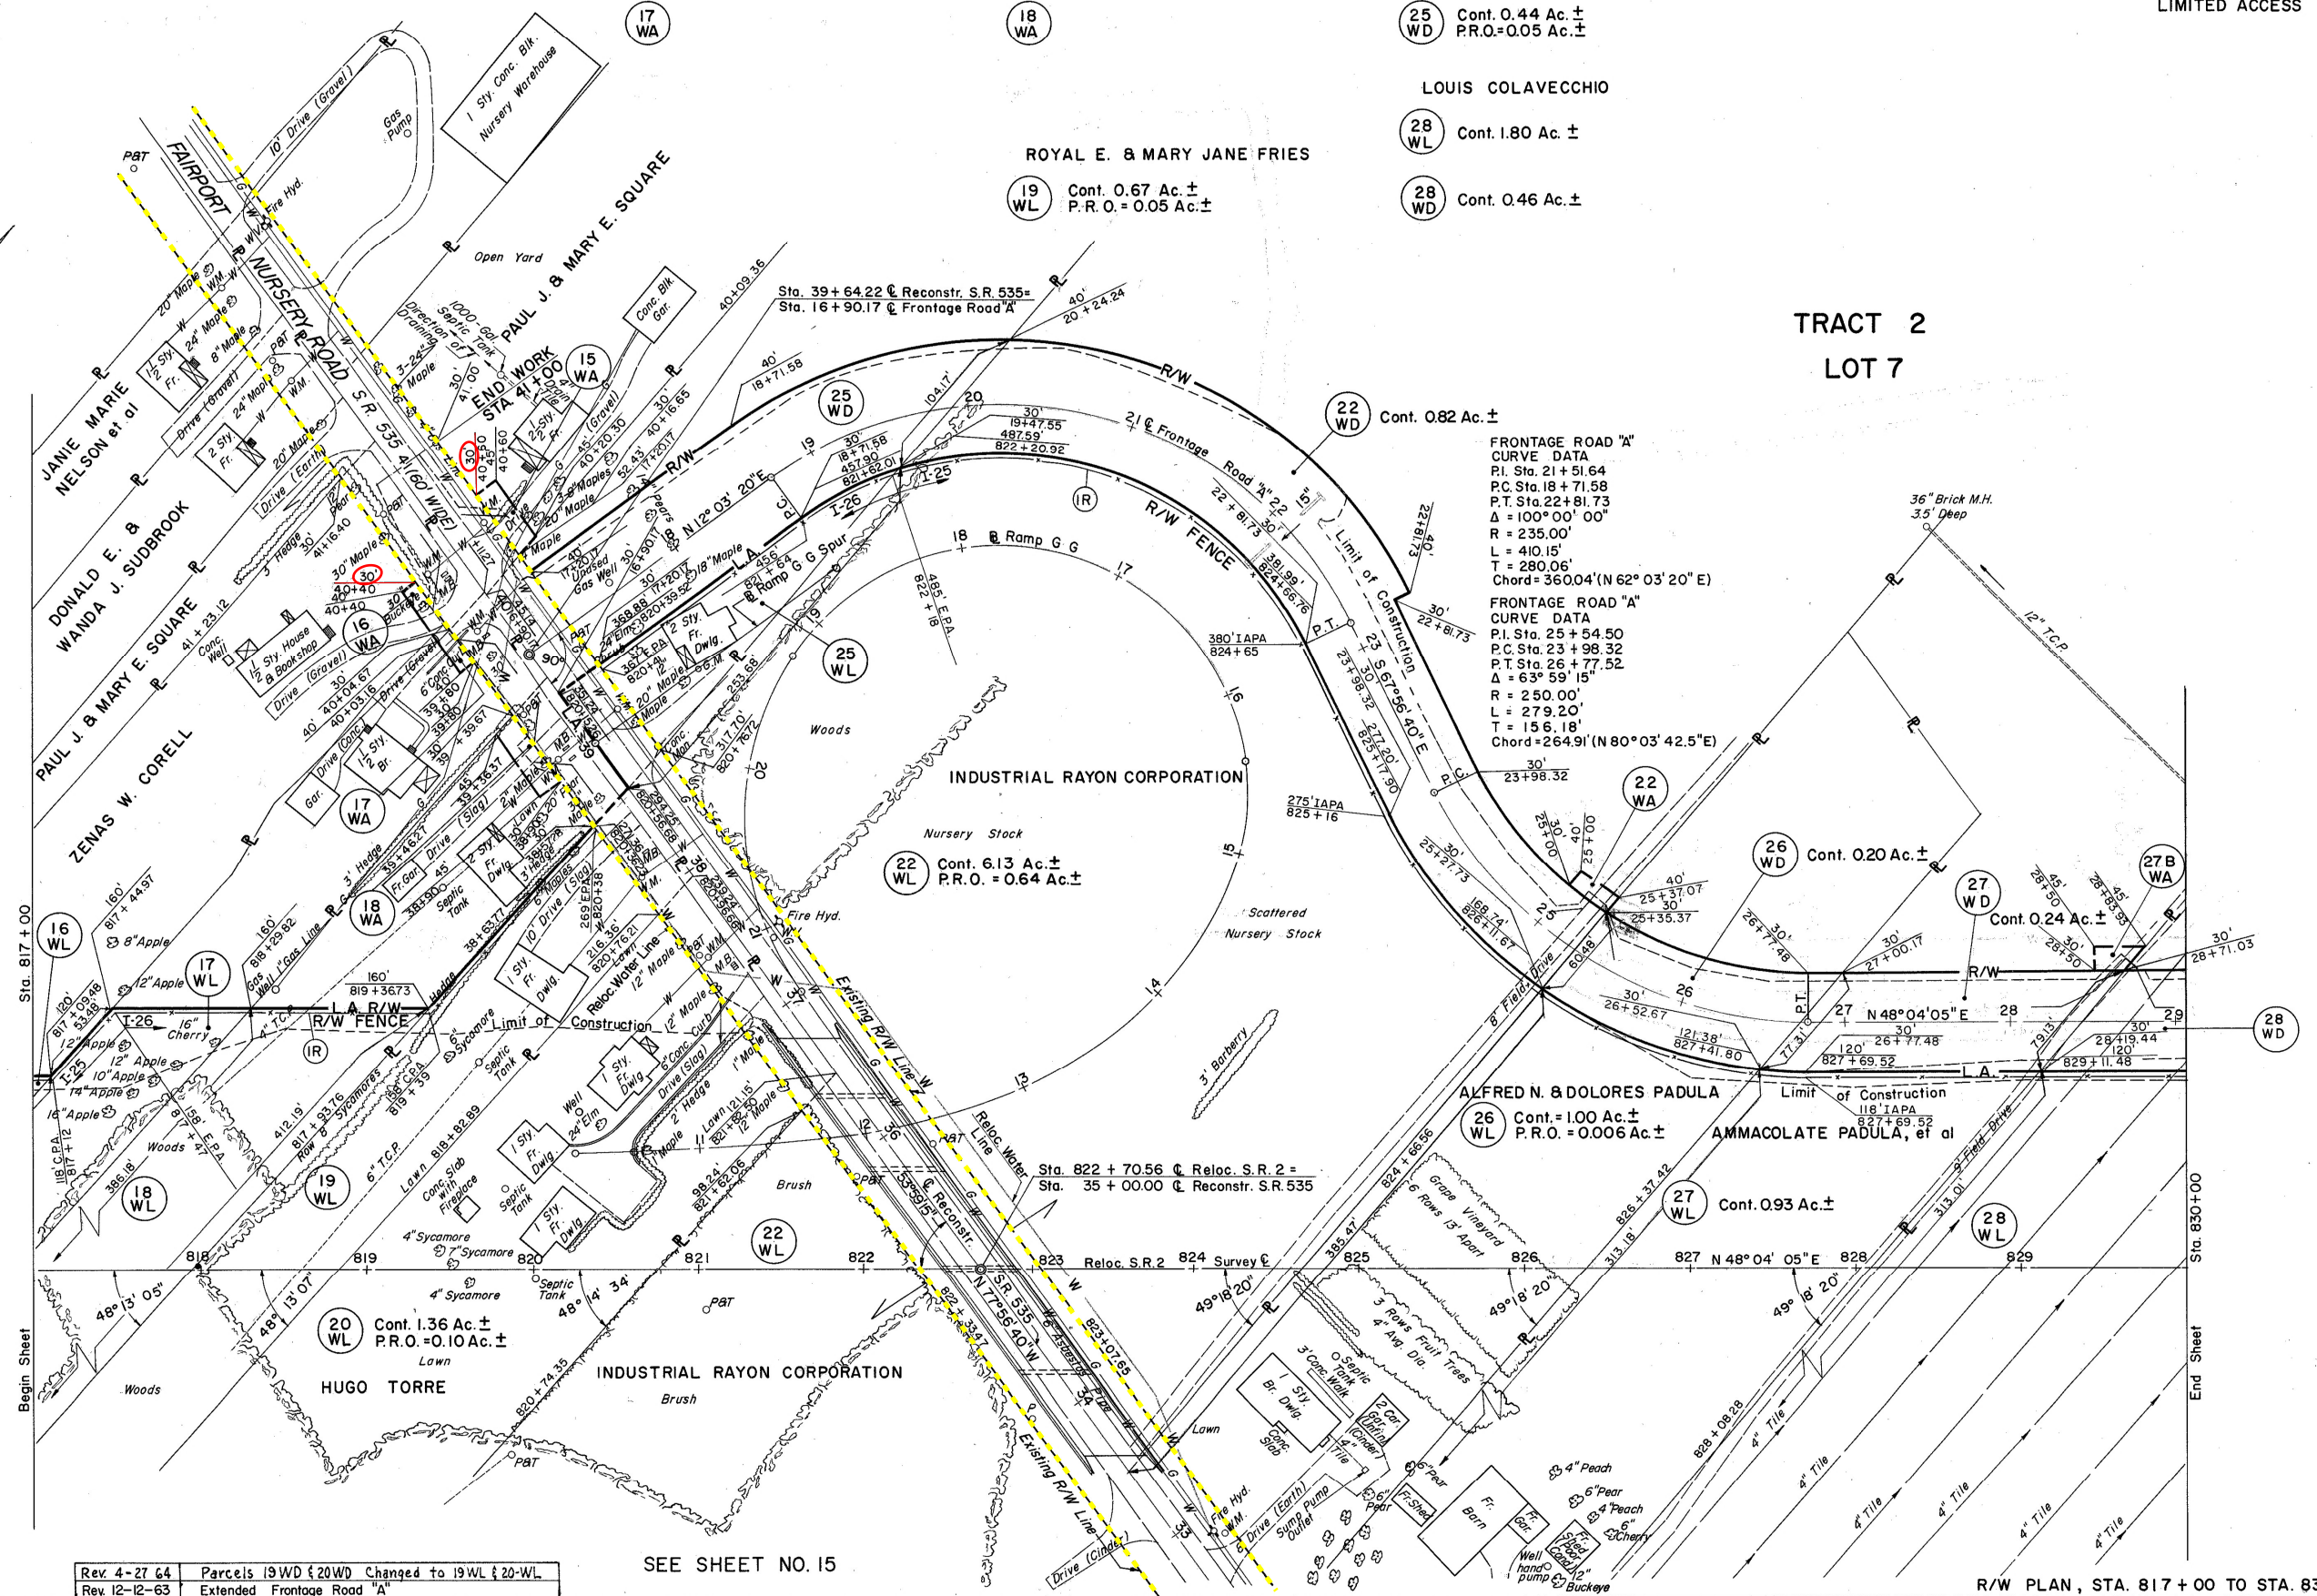

FRONTAGE ROAD "A"
 CURVE DATA
 P.I. Sta. 21 + 51.64
 P.C. Sta. 18 + 71.58
 P.T. Sta. 22 + 81.73
 $\Delta = 100^{\circ} 00' 00''$
 R = 235.00'
 L = 410.15'
 T = 280.06'
 Chord = 360.04' (N 62° 03' 20" E)

FRONTAGE ROAD "A"
 CURVE DATA
 P.I. Sta. 25 + 54.50
 P.C. Sta. 23 + 98.32
 P.T. Sta. 26 + 77.52
 $\Delta = 63^{\circ} 59' 15''$
 R = 250.00'
 L = 279.20'
 T = 156.18'
 Chord = 264.91' (N 80° 03' 42.5" E)

Rev. 4-27-64 Parcels 19WD & 20WD Changed to 19WL & 20WL
 Rev. 12-12-63 Extended Frontage Road "A"

SEE SHEET NO. 15