



STA. 184+50

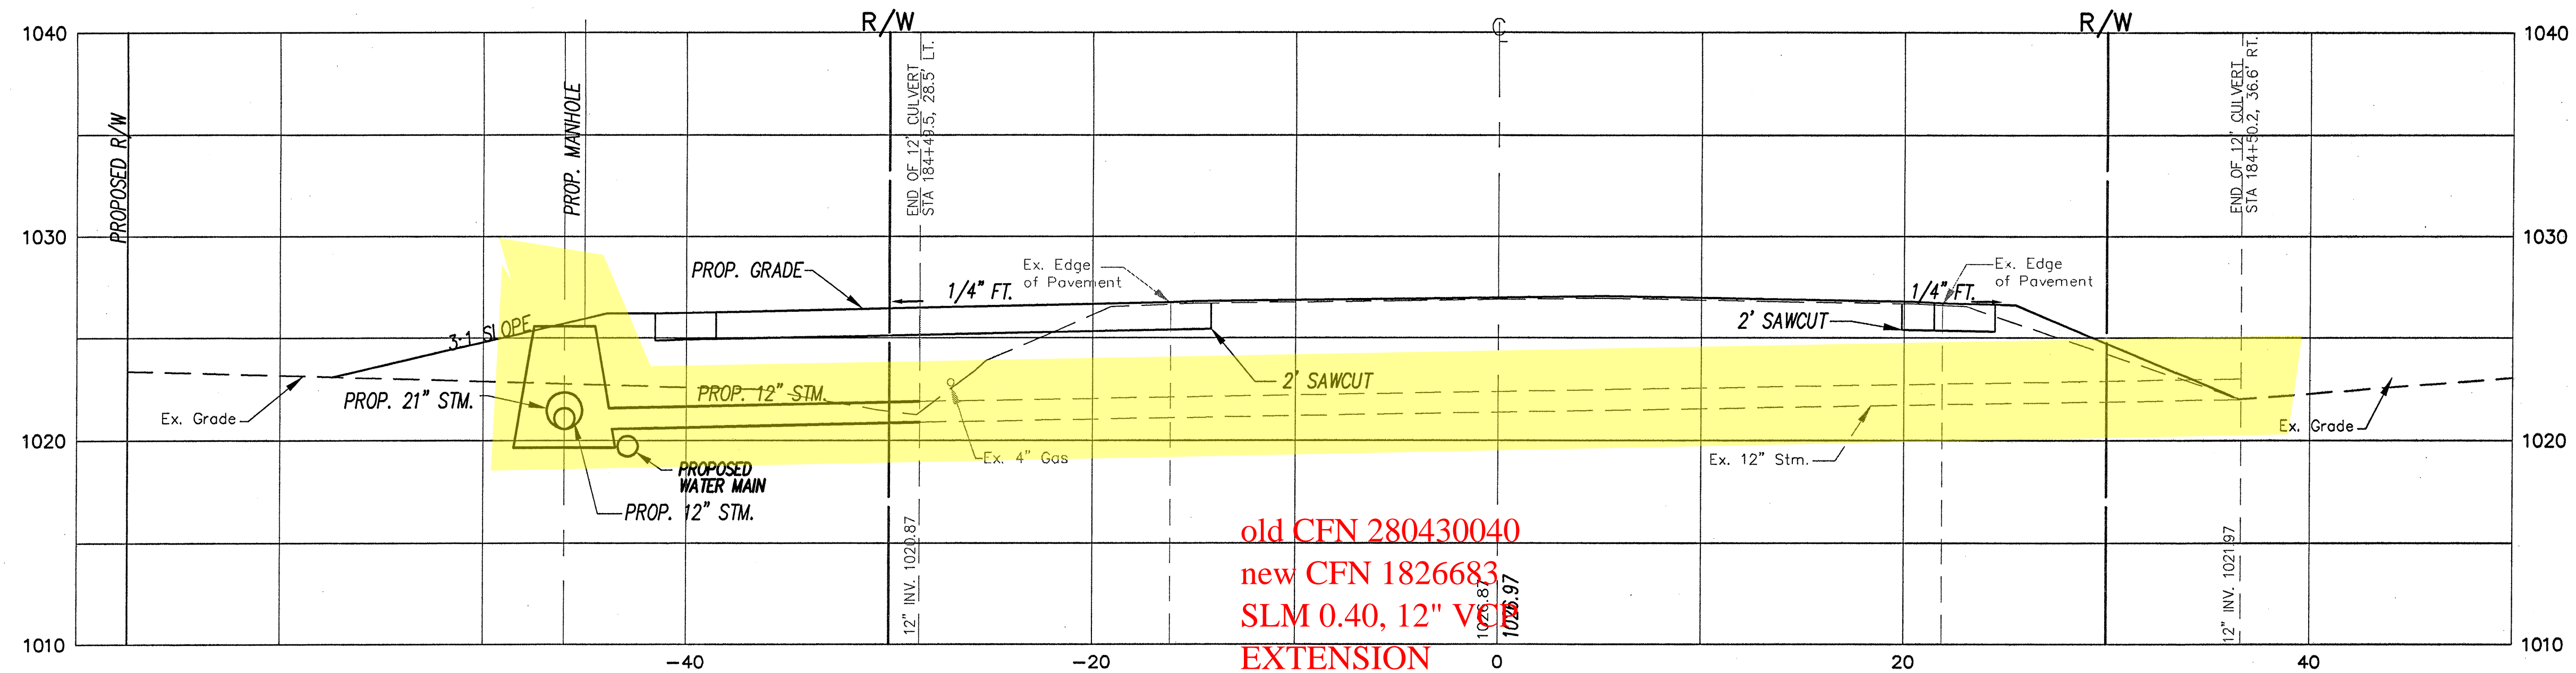


old CFN 280430040  
 new CFN 1826683  
 SLM 0.40, 12" V  
 EXTENSION  
 SEE SHEET 3


STA. 184+00

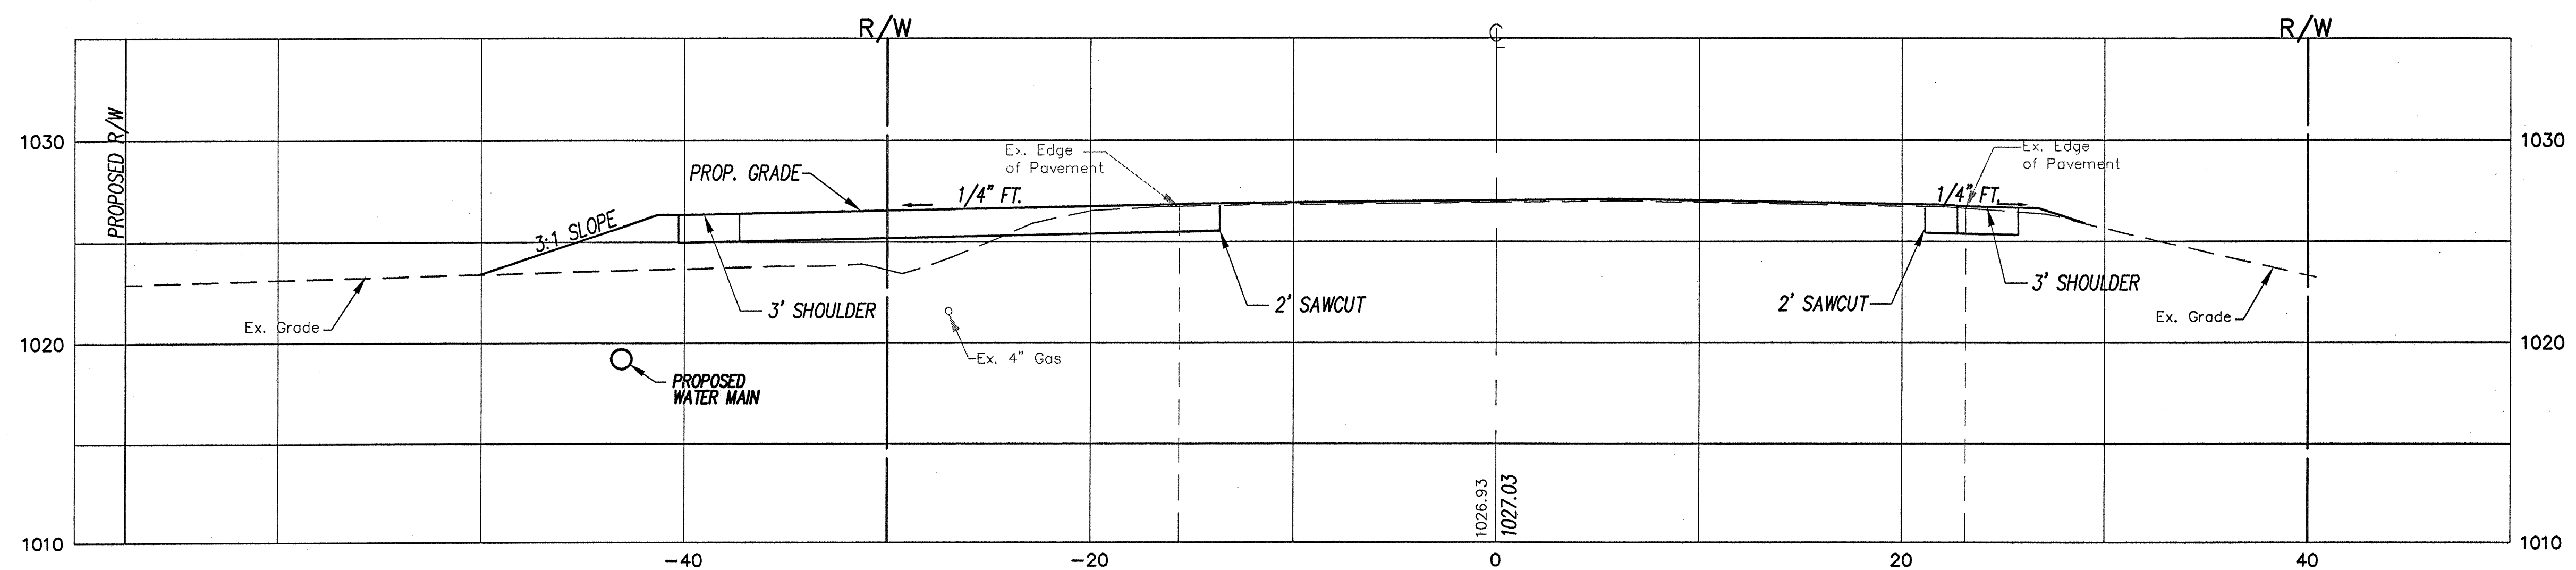

STA. 183+50

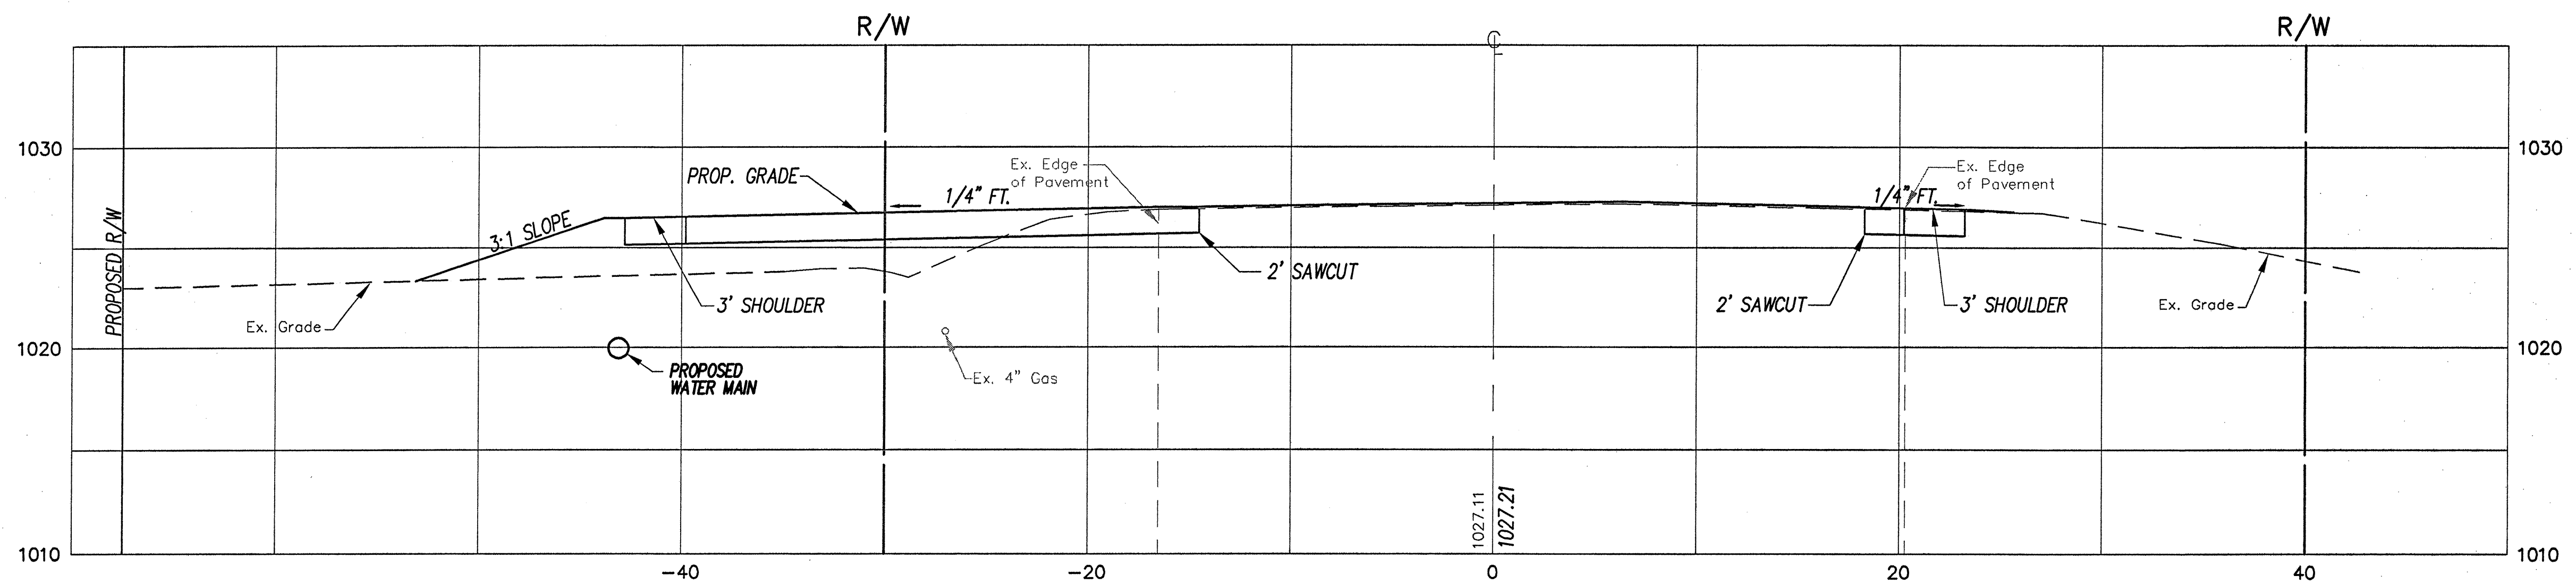

**CHAGRIN VALLEY  
 ENGINEERING, LTD.**  
 24850 AURORA ROAD, UNIT A  
 CLEVELAND, OHIO 44146  
 PHN: (440) 439-1999  
 FAX: (440) 439-1969

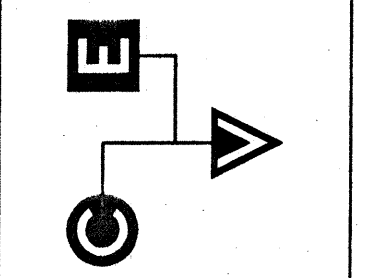

REVISIONS  
 1. REVISIONS AS PER OHIO DEPT. OF TRANSPORTATION 2-08-02  
 2. REVISIONS AS PER OHIO DEPT. OF TRANSPORTATION 2-28-02

CROSS SECTIONS  
**STATE ROUTE 43 WIDENING**  
 BAINBRIDGE TOWNSHIP, OHIO

DESIGNED BY: D.P.B.  
 DRAWN BY: L.M.B.  
 CHECKED BY:  
 DATE: 05/14/01  
 SCALE: 1" = 5'  
 SCALE: 1" = 5'

PROJECT NUMBER  
**01030**  
 Drawing Name  
 01030sec.dwg

SHEET: **8**  
 TOTAL SHEETS: **23**