

FED RD DIVISION	STATE	PROJECT	FISCAL YEAR
	OHIO		


340
353

CUYAHOGA COUNTY
CUY. -71-5.72

13
26

ITEM E-9 REMOVAL OF TREES & STUMPS	
SIZE	NO. OF TREES
12"-18"	131
18"-24"	31
24"-30"	17
30"-36"	4
36"-42"	1
OVER 42"	1
TOTAL	185

I-26 CHAIN LINK FENCE
1428 FT.

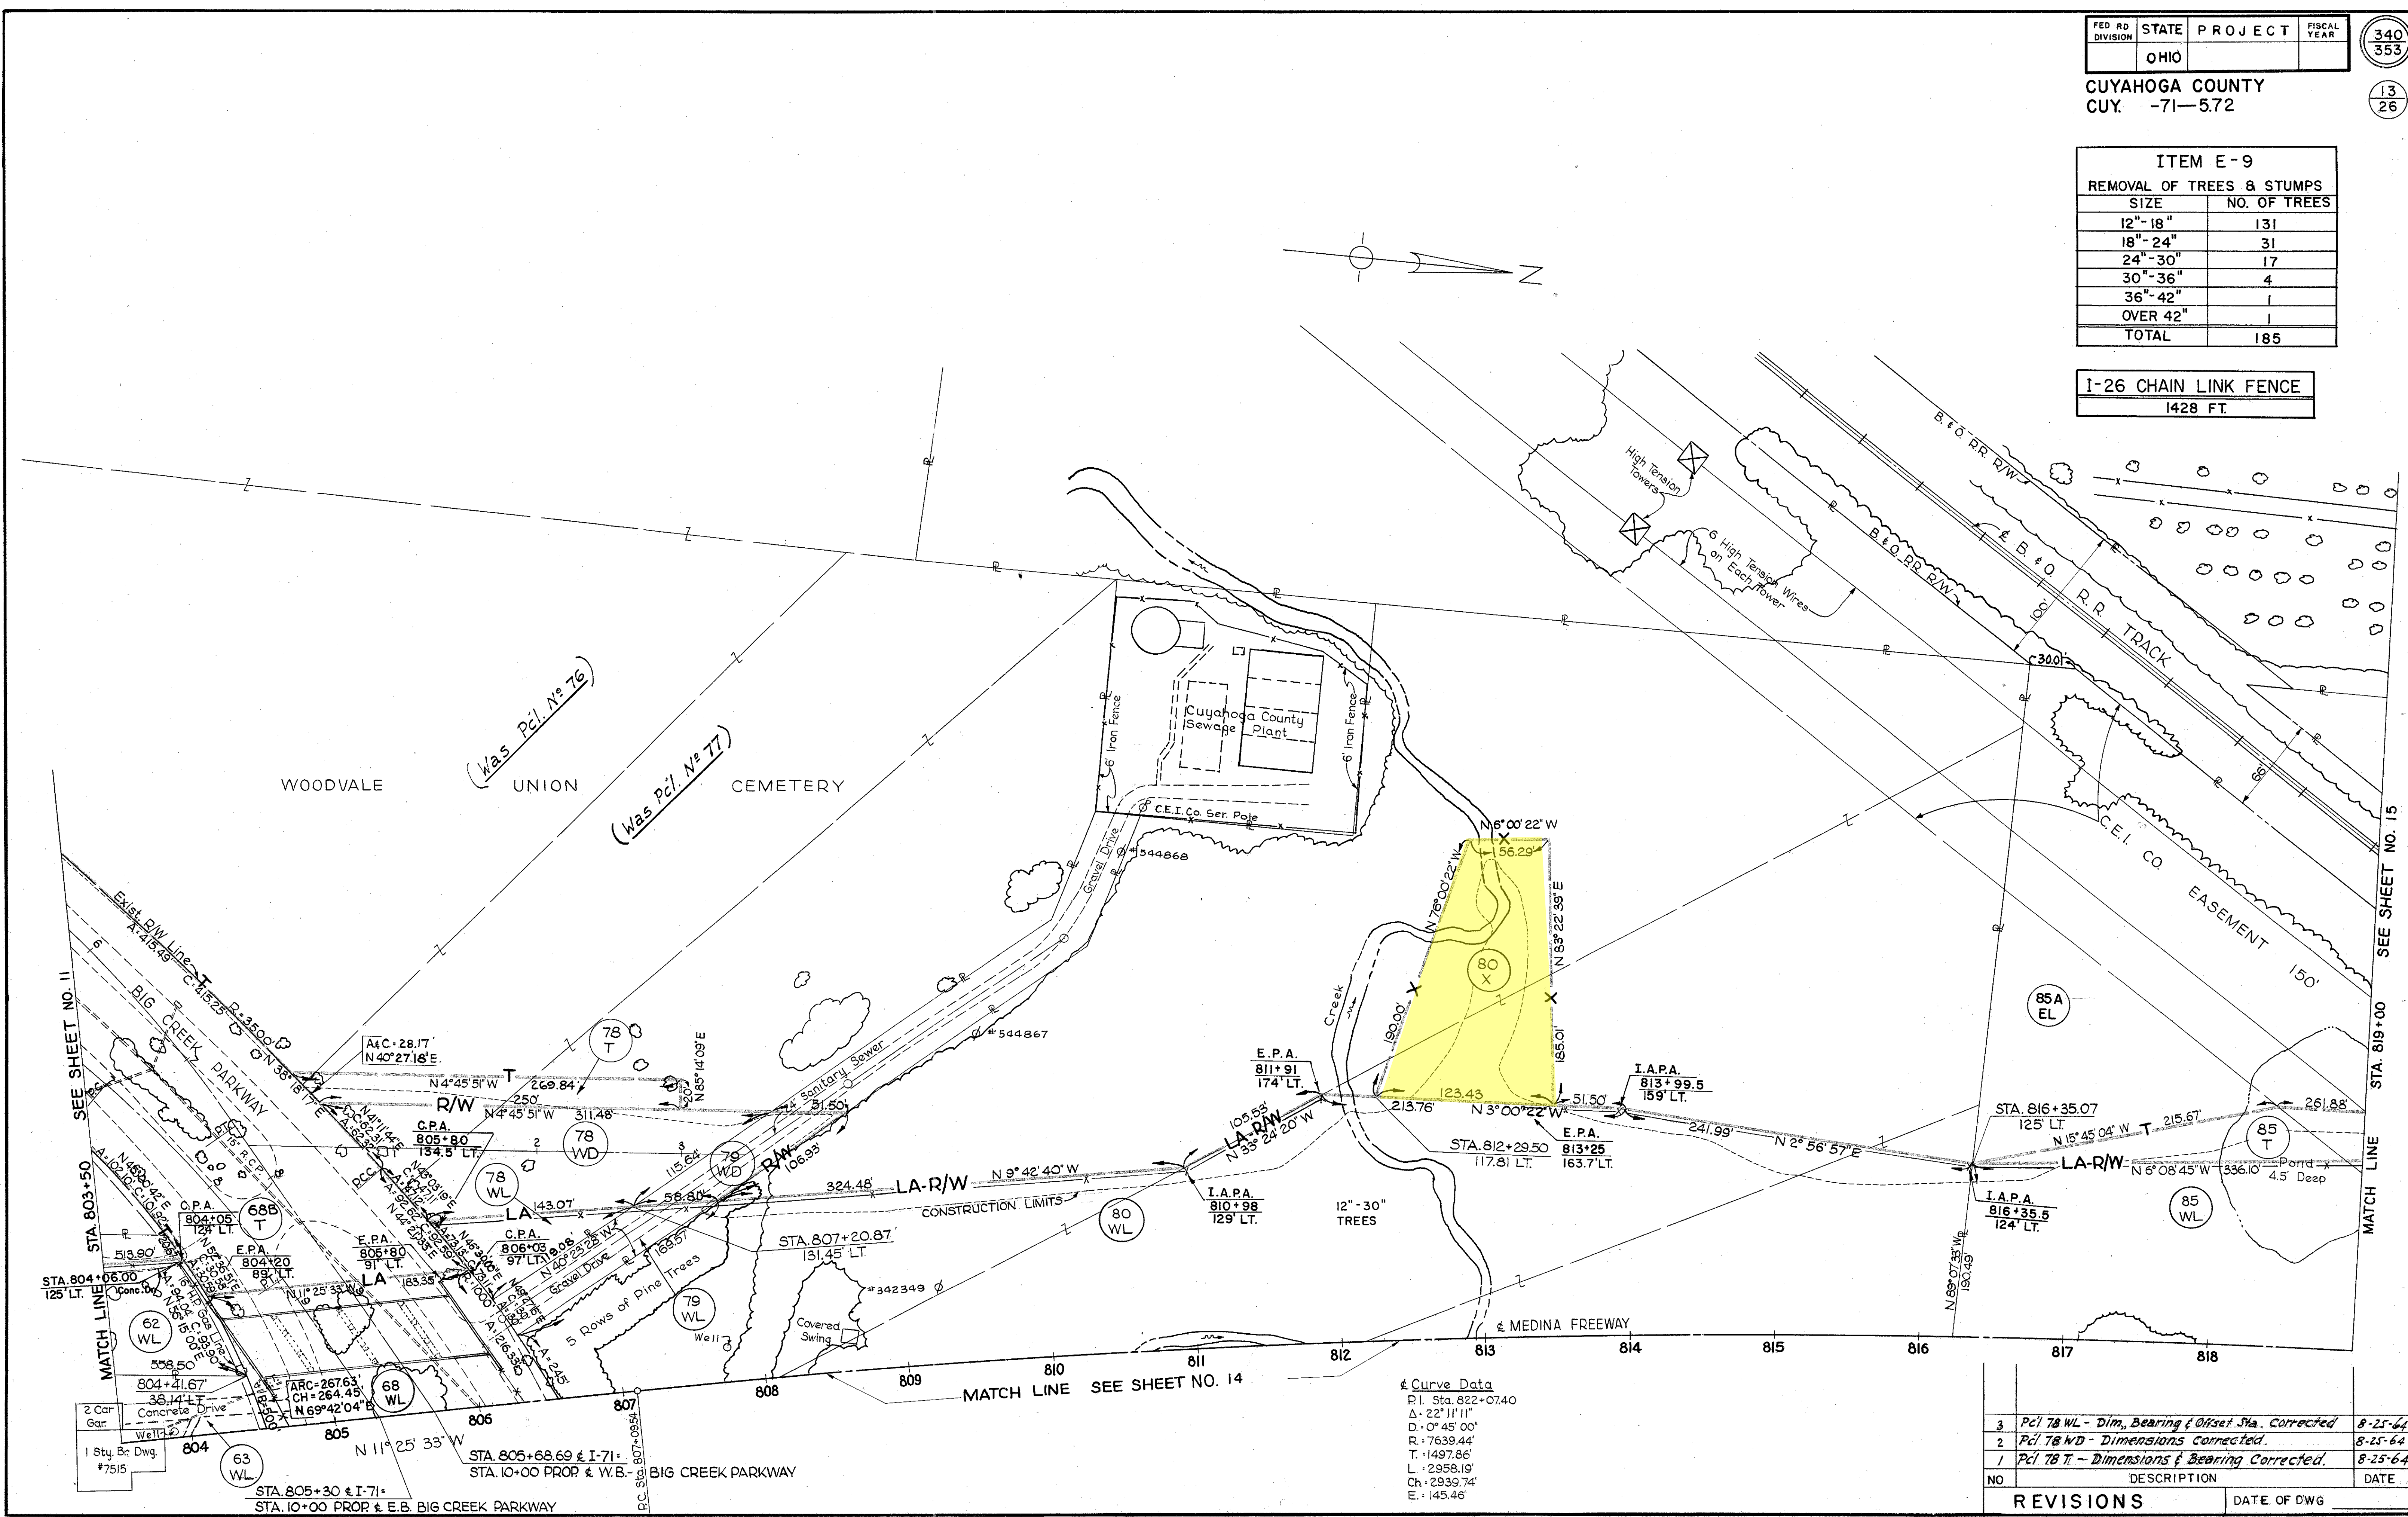

Curve Data
P.I. Sta. 822+07.40
Δ: 22°11'11"
D: 0°45'00"
R: 7639.44'
T: 1497.86'
L: 2958.19'
Ch: 2939.74'
E: 145.46'

NO	DESCRIPTION	DATE
3	Pcl 78 WL - Dim, Bearing & Offset Sta. Corrected	8-25-64
2	Pcl 78 WD - Dimensions Corrected	8-25-64
1	Pcl 78 T - Dimensions & Bearing Corrected	8-25-64

REVISIONS DATE OF DWG