

SLM 6.12, 12"  
SEE SHEET 184

CFN 180710620  
SLM 6.20, 30"  
SEE SHEET 200

SLM 6.25, 12"  
SEE SHEET 184

BRIDGE  
SFN 1804172  
SEE SHEET 199

SLM 6.17, 12"  
SEE SHEET 184

FOR DETAILS ON CULVERT D-1  
SEE SHEET 199

FOR PAVEMENT DETAILS  
SEE SHEET 165

FOR DETAILS ON CULVERT D-1  
SEE SHEET 200

ROADWAY

REF. NO.	STATION		SIDE	STEEL BEAM (DEEP)	
	FROM	TO		STANDARD	BARRIER
GR-15	809+00	819+00	RT.	991	-
GR-9	809+00	819+00	LT.	1009	-
GR-10	817+00	819+00	M	-	200
TOTAL				2000	200

FOR PROFILE OF STORM SEWER D-14, D-10, D-13  
SEE SHEET 184



FED. RD. DIVISION	STATE	PROJECT	FISCAL YEAR
2	OHIO		26 353

CUYAHOGA COUNTY  
CUY-71-572

DRAINAGE

REF. NO.	STATION	SIDE	I-1		I-5		I-8		I-2		I-10		L-10		L-120		I-8	
			6" PIPE CLASS I-3	6" PIPE CLASS F-4	12" PIPE CLASS J-1	12" PIPE CLASS F-4	6"x90" BENDS I-3	12"x25" BENDS F-4	STD-8 CATCH BASIN EACH	MASONRY MASONRY C.Y.	DUMPED ROCK C.Y.	SODDING S.Y.	JUTE MATTING S.Y.	STD-2-A-8 PAVED SHLD. EACH	INLET			
D-3	809+00	810+80	CL															
D-4	809+24	DITCH	LT	80	28			2		0.23								
D-5	809+90	811+10	RT.															
D-6	811+50	812+10	LT															
D-7	813+17	815+10	LT															
D-8	813+72	815+10	RT.															
D-9	816+00		CL															
D-10	816+00	DITCH	RT.			71	31			0.23		3.2						
D-11	809+00	819+00	LT.	1000	20													
D-12	809+00	819+00	RT.	1000	20													
D-13	812+00	DITCH	RT.			80	43			0.23		3.2						
TOTAL				2000	40	231	102			2		6						

REF. NO.	STATION	SIDE	I-1		I-10		E-3		I-2		L-10	
			30" PIPE CLASS A-1	10" PIPE CLASS M-6.4(d)	10" PIPE CLASS M-6.4(d)	RIP-RAP 6" R.C. SLAB	DUMPED ROCK	CHANNEL EXC.	MASONRY	SOD		
D-1	809+23	812+51.5	LT&RT	436		70	74		590	22	35	
D-2	813+19	814+65	LT&RT	317					81	7.6	4	
TOTAL				317	436	70	74		671	29.6	39	

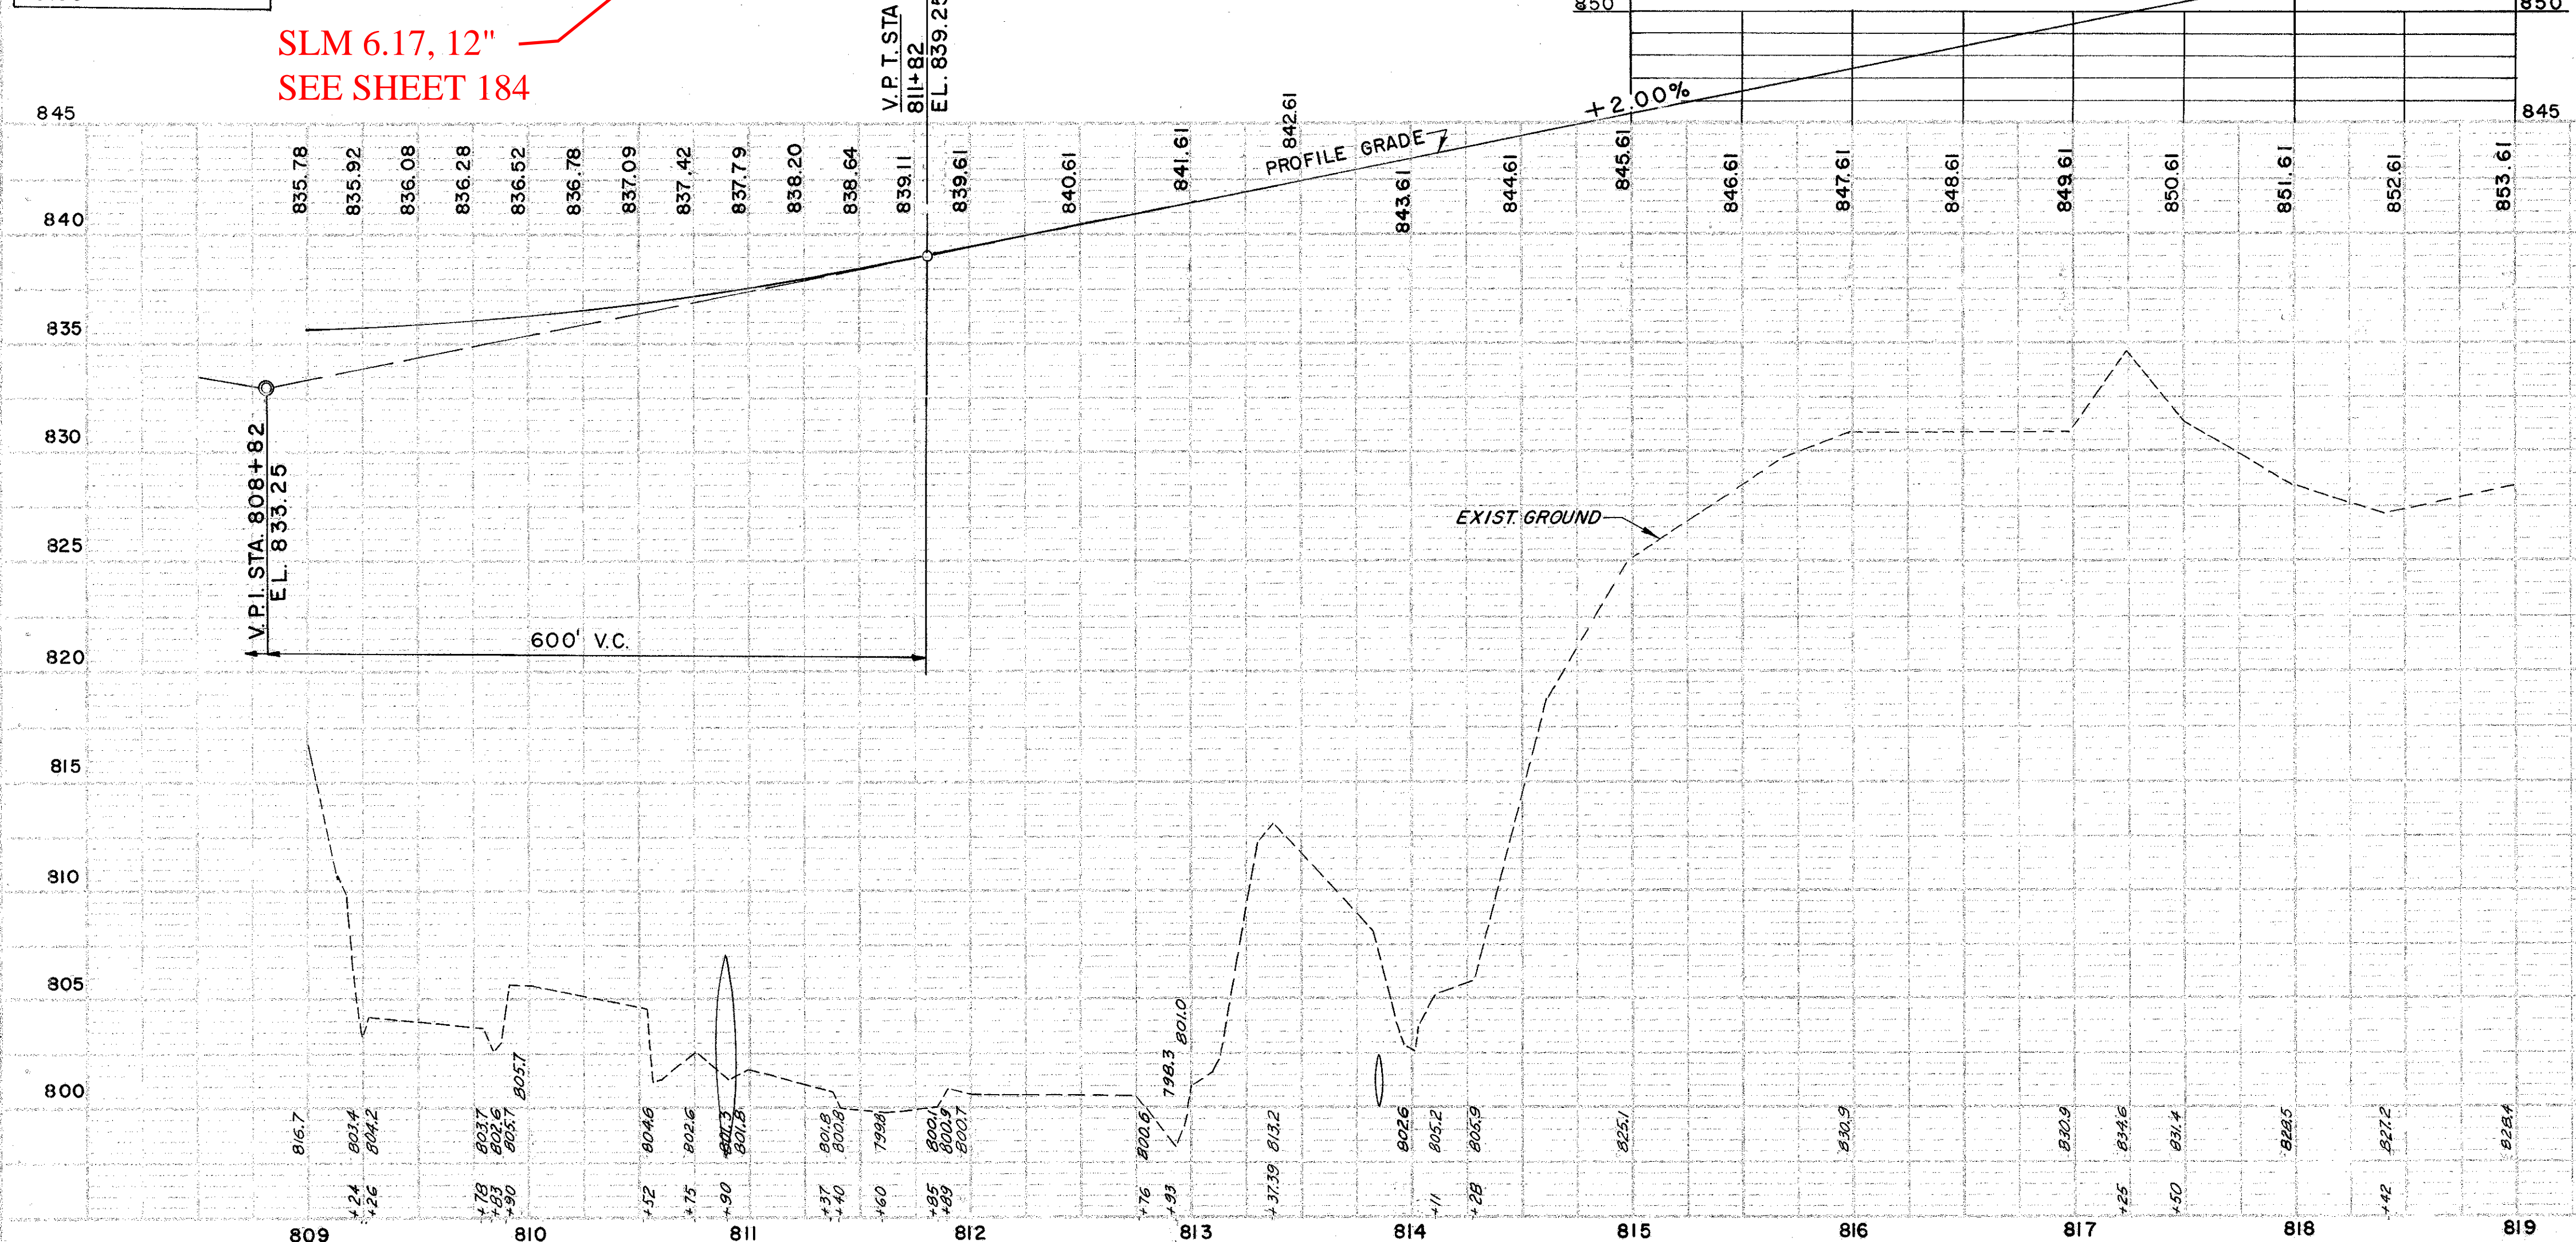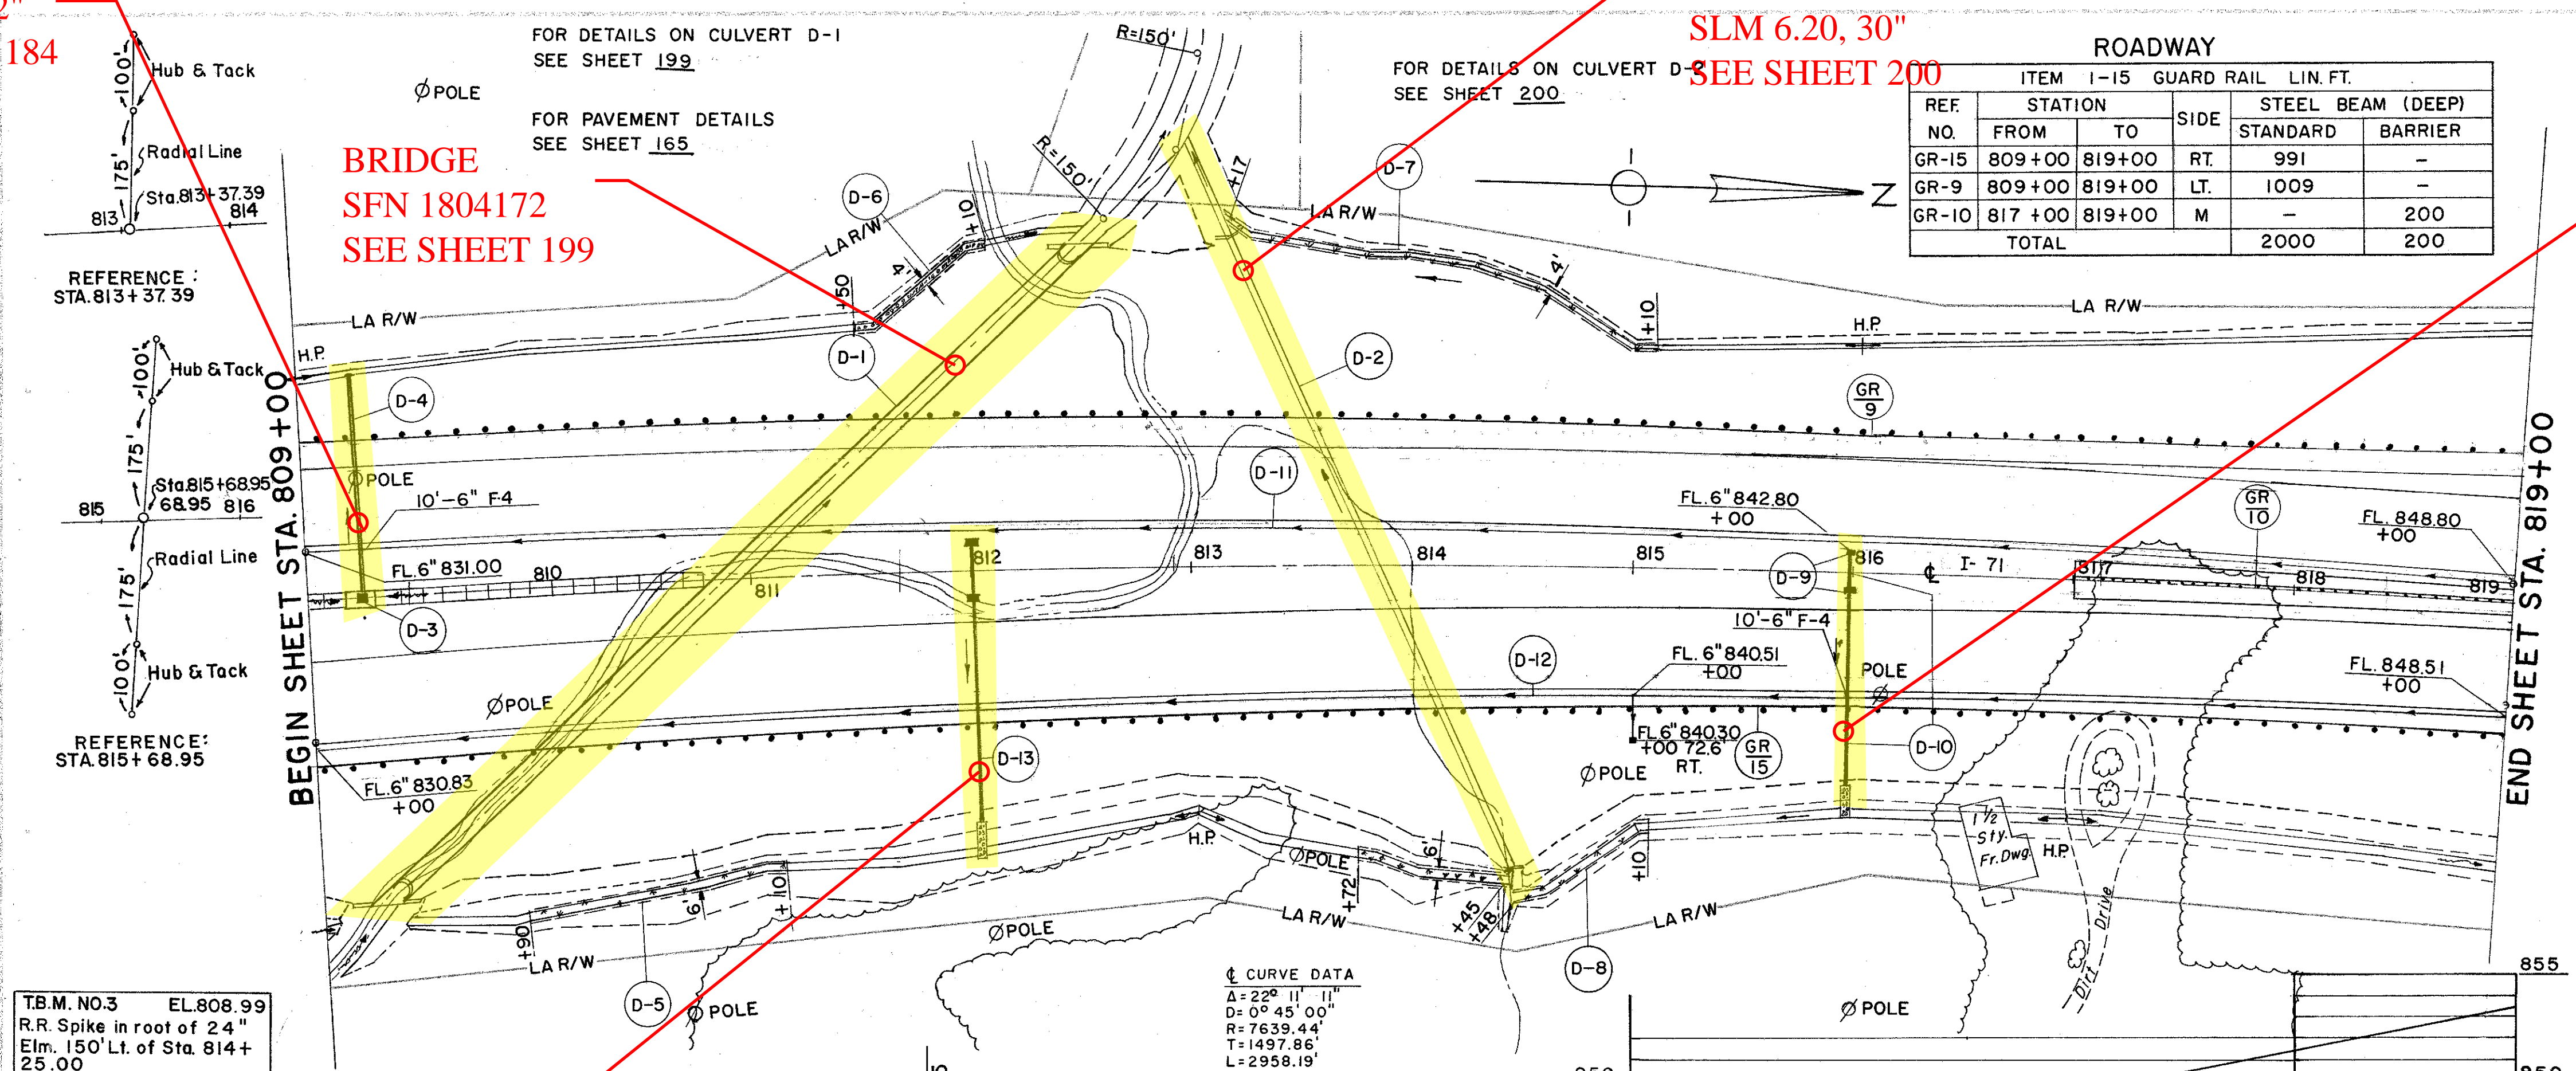

PLAN & PROFILE- STA. 809+00 TO STA. 819+00