


SLM 7.08, 12"
SEE SHEET 185

CFN 180710714
SLM 7.14, 48"
SEE SHEET 203

SLM 7.19, 12"
SEE SHEET 185

SLM 7.24, 12"
SEE SHEET 185

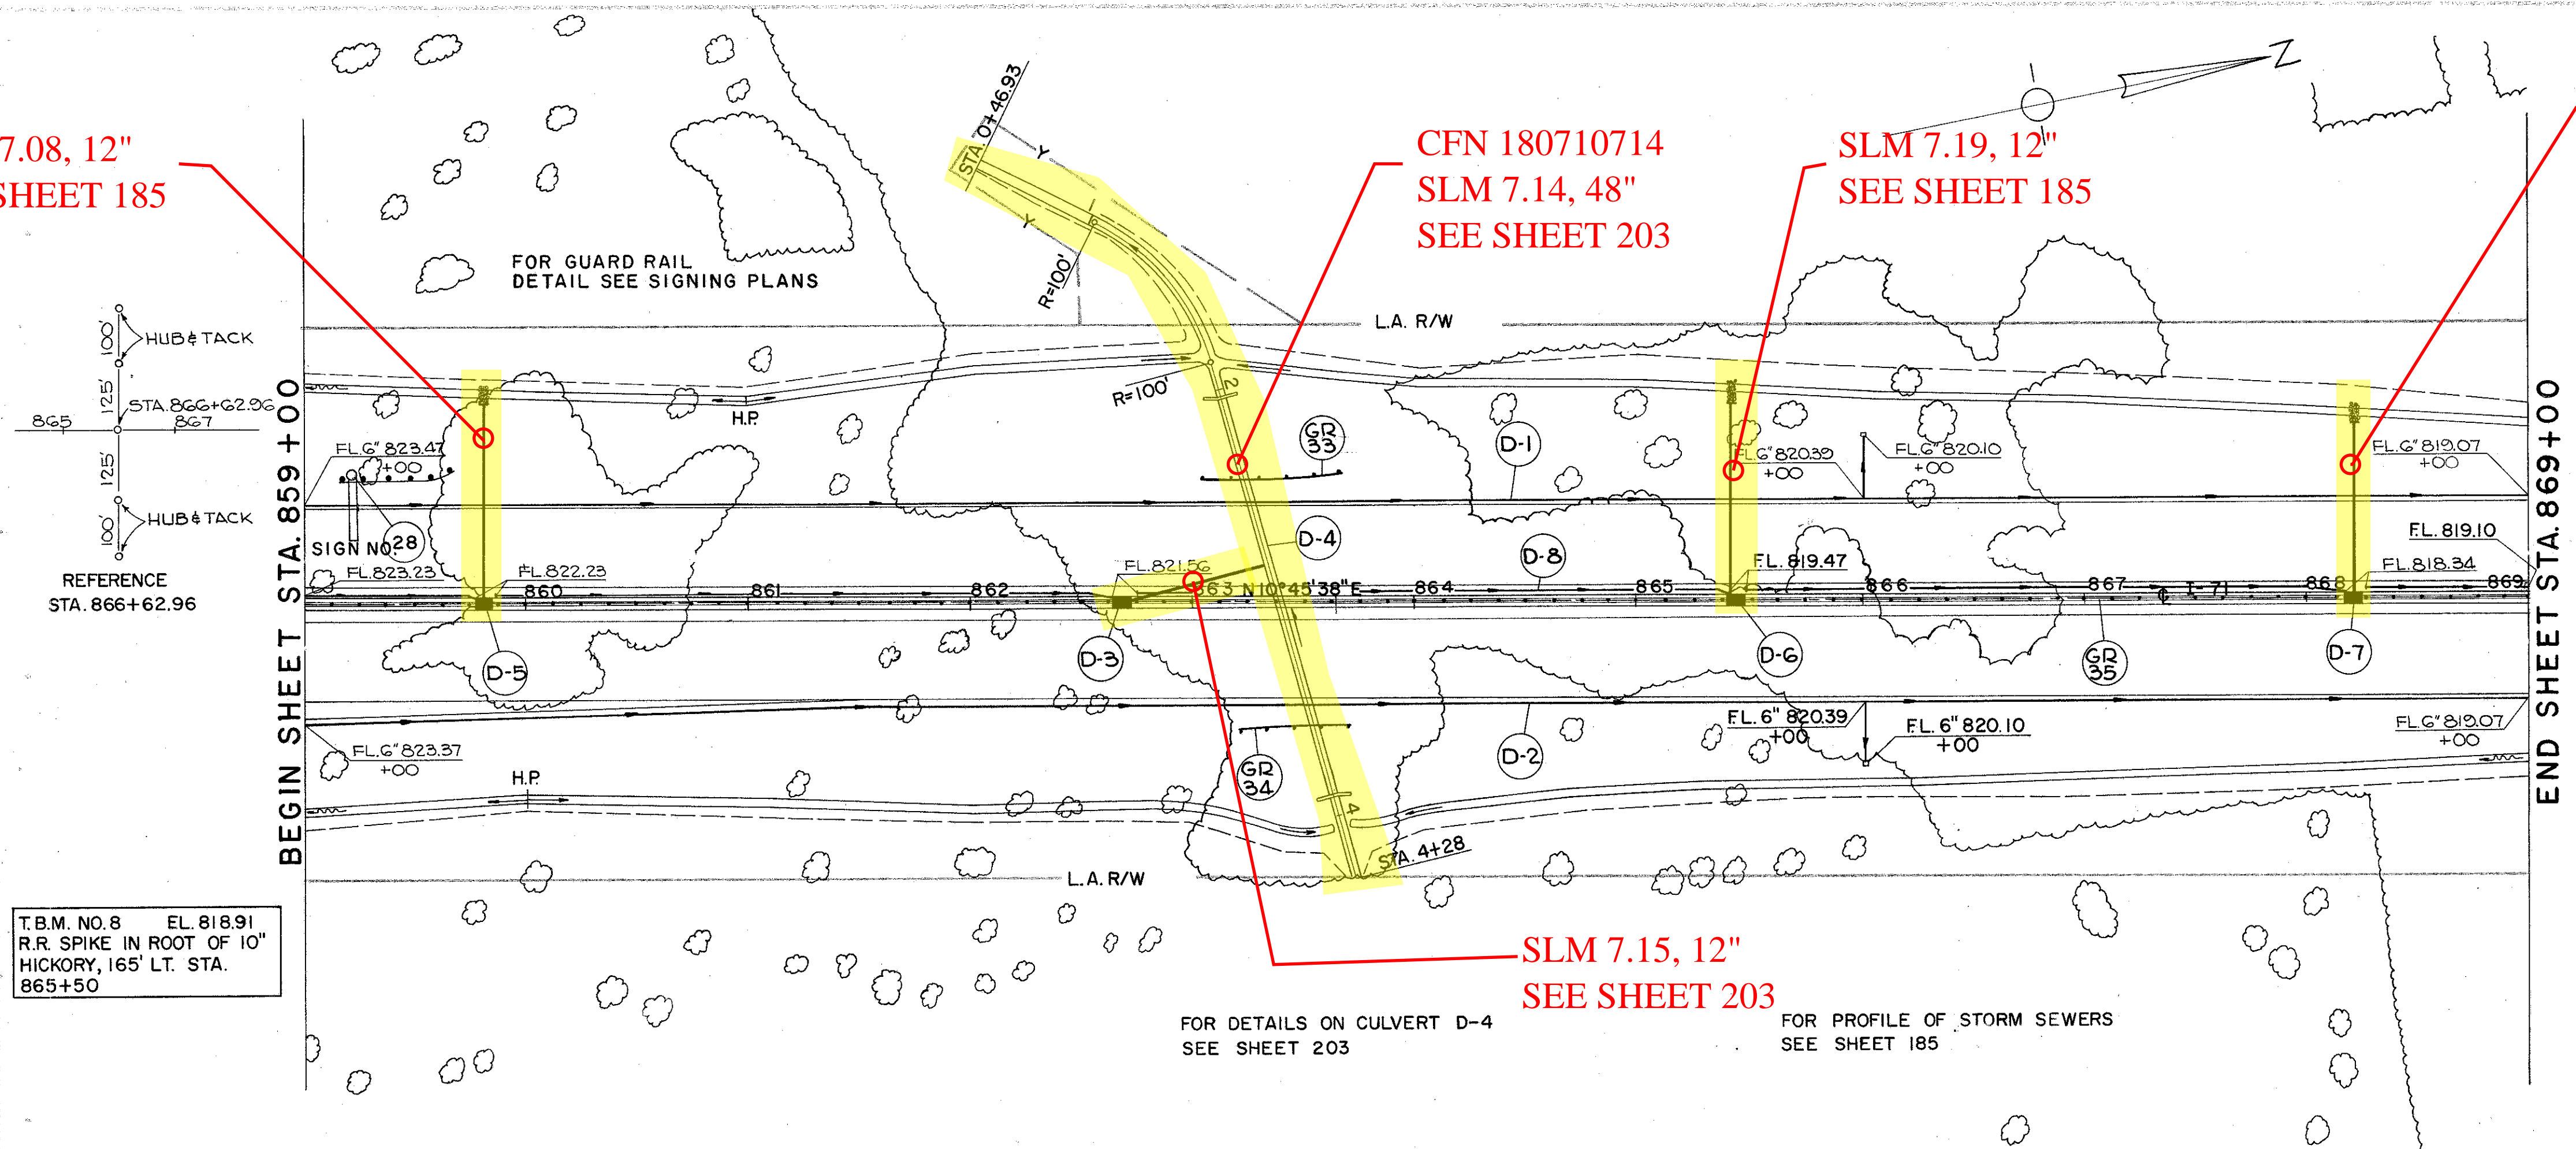

(D) DRAINAGE

REF. NO.	STATION	M-D-S	DRAINAGE												
			6" PIPE CLASS I-3 SHALLOW	6" PIPE CLASS F-4 SHALLOW	12" PIPE CLASS J-1	48" PIPE CLASS A-1 (SEC. 116-66(b))	MASONRY	6" x 90° BEND CLASS I-3	48" x 12" TEE CLASS A-1 (SEC. 116-66(b))	MOD. 24" A-6 INLET	PIP-RAP	6" x 6" LAB DUMPED ROCK CHNL. PROT.	SODDING	CHANNEL EXC.	
FROM	TO		LIN. FT.				C.Y.	EACH	EACH	S.Y.	C.Y.	S.Y.	C.Y.		
D-1	859+00	869+00	LT	1018	50										
D-2	859+00	869+00	RT	1018	10										
D-3	862+70	863+35	C		64										
D-4	863+38					188	174								
D-5	859+80	DITCH	LT.		92		0.23								
D-6	865+45	DITCH	LT.		90		0.23								
D-7	868+20	DITCH	LT.		80		0.23								
D-8	859+00	869+00	M	976											
TOTAL				3012	60	326	188	18.09	2	1	4	22	13.9	36	62

ROADWAY


REF. NO.	ITEM	STATION	SIDE	GUARD RAIL		LIN. FT.	
				STEEL BEAM (DEEP)	STANDARD	PLUM	BARRIER
GR 33	I-15	863+04	863+665	LT	62.5		
GR 34	I-15	863+085	863+71	RT	62.5		
GR 35	I-15	859+00	869+00	M			1000
GR 36	I-15	859+20	859+70	L		50	
TOTAL					125	50	1000

T.B.M. NO. 8 EL. 818.91
R.R. SPIKE IN ROOT OF 10"
HICKORY, 165' LT. STA.
865+50

FOR DETAILS ON CULVERT D-4
SEE SHEET 203

FOR PROFILE OF STORM SEWERS
SEE SHEET 185

FOR SIGN PLAN SEE SHEET 244

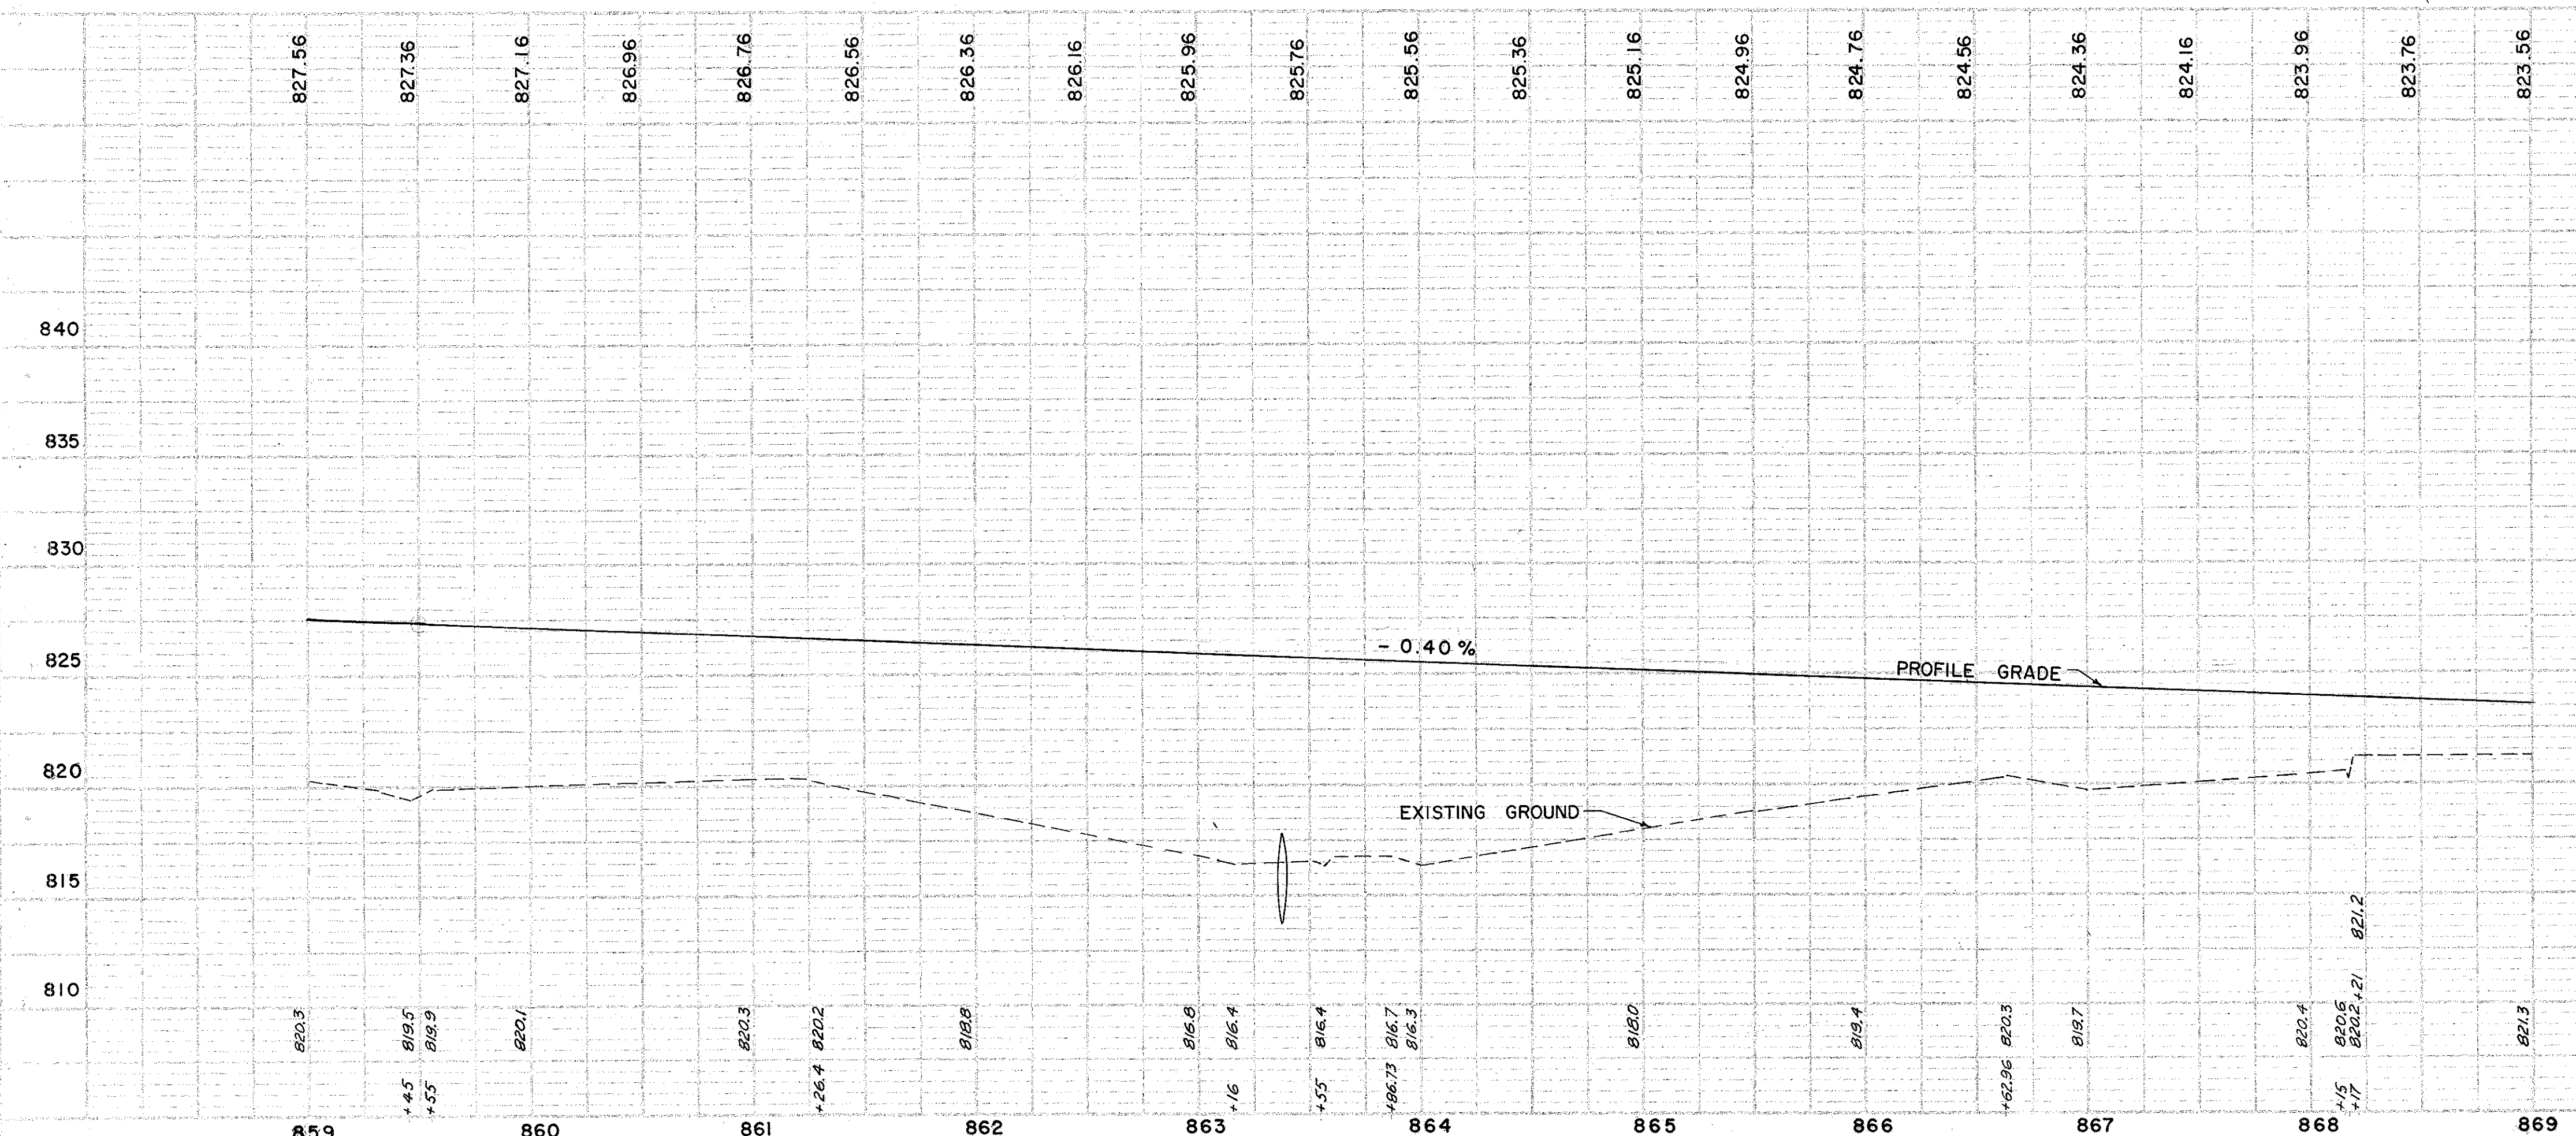

PLAN & PROFILE - STA. 859+00 TO STA. 869+00