

SLM 7.27, 12"
SEE SHEET 186

SLM 7.29, 12"
SEE SHEET 186

SLM 7.31, 12"
SEE SHEET 186

SLM 7.39, 12"
SEE SHEET 186

SLM 7.44, 12"
SEE SHEET 186

CFN 180710731
SLM 7.31, 24"
SEE SHEET 204


CUYAHOGA COUNTY
CUY-71-5.72

D DRAINAGE

REF. NO.	STATION	SIDE	SHALLOW		I-1		I-5		I-8		I-10		E-3	
			6" PIPE CLASS I-3	6" PIPE CLASS I-4	12" PIPE CLASS J-1	12" PIPE CLASS E-1	24" PIPE CLASS A-1	6" x 6" TEE CLASS I-3	24" x 12" TEE CLASS A-1	MOD. 2-A-G PAVED SHULDR INLET	MASONRY	SODDING	DUMPED ROCK CHANNEL PROTECT	CHANNEL EXCAVATION
D-1	869+00 TO 879+00	LT.	1018	40				2						
D-2	869+00 TO 879+00	CL	940	60										
D-3	869+00 TO 879+00	RT.	1044	40				3						
D-4	871+00	CL-LT			76				1	0.23	2			
D-5	872+17.65	CL-LT			85				1	0.23	2	2		
D-6	873+00	LT-RT					148		1	6.6	7		65	
D-7	873+00 TO 873+61	CL				61								
D-8	876+23	CL-RT			71				1	0.23	2			
D-9	878+85	CL-RT			76				1	0.23	2	2		
TOTAL			3002	140	308	61	148	5	1	5	7.52	15	4	65

ROADWAY


REF. NO.	STATION	SIDE	ITEM I-15 GUARD RAIL LIN. FT.	
			STEEL BEAM (DEEP) AS PER PLAN	BARRIER
GR-34	869+00 TO 879+00	CL		1000
GR-35	872+53 TO 873+03	RT.	50	
TOTAL			50	1000

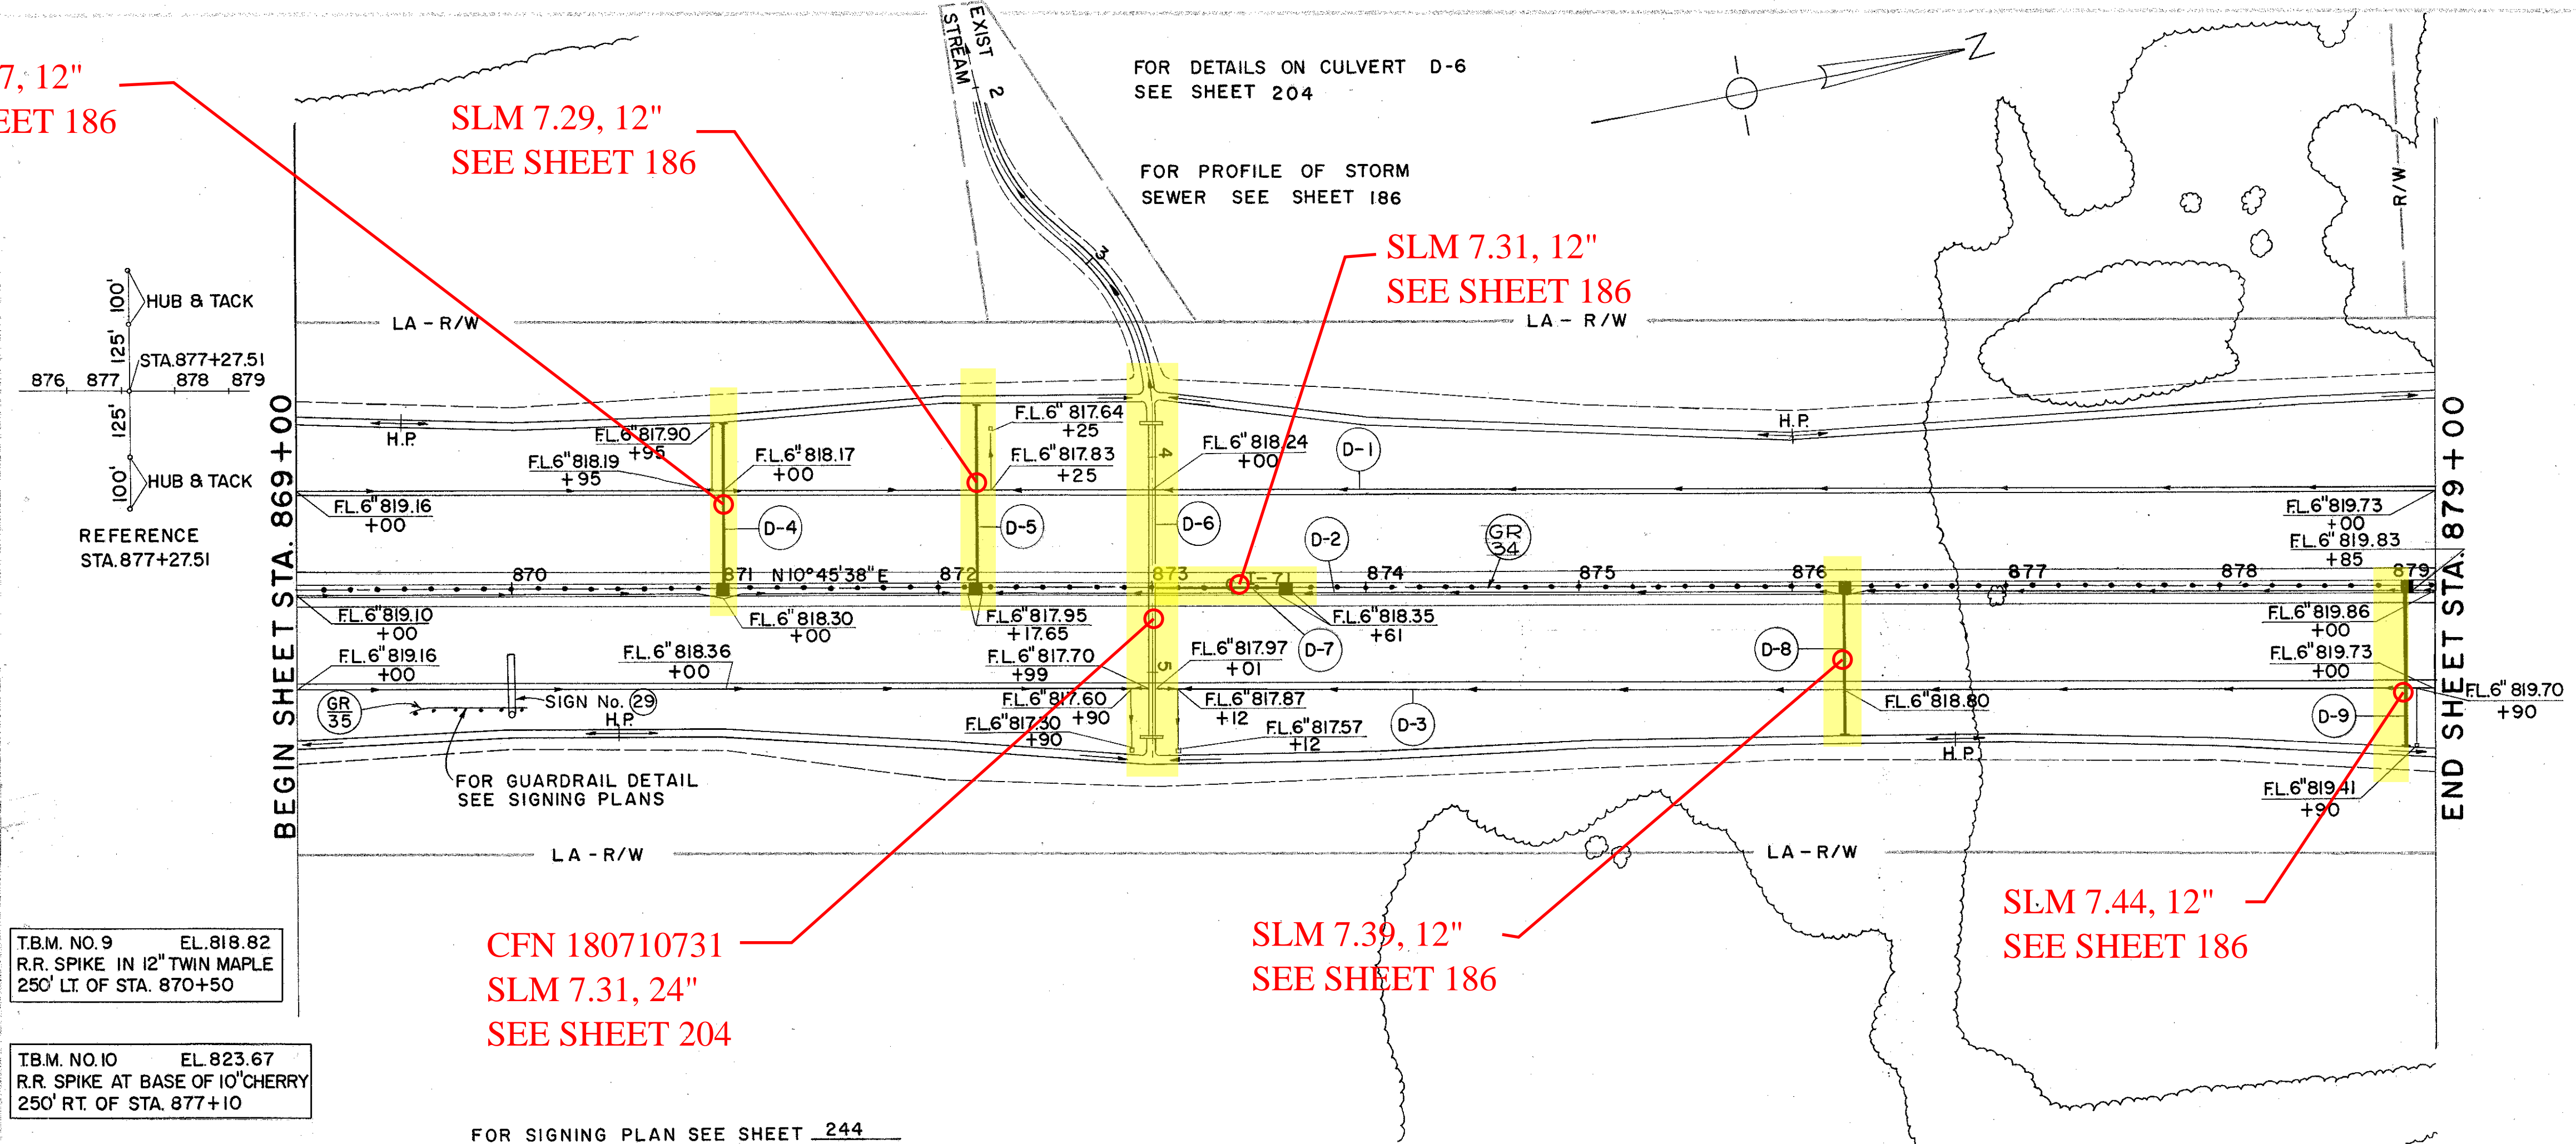

T.B.M. NO. 9 EL. 818.82
R.R. SPIKE IN 12" TWIN MAPLE
250' LT. OF STA. 870+50

T.B.M. NO. 10 EL. 823.67
R.R. SPIKE AT BASE OF 10" CHERRY
250' RT. OF STA. 877+10

FOR SIGNING PLAN SEE SHEET 244

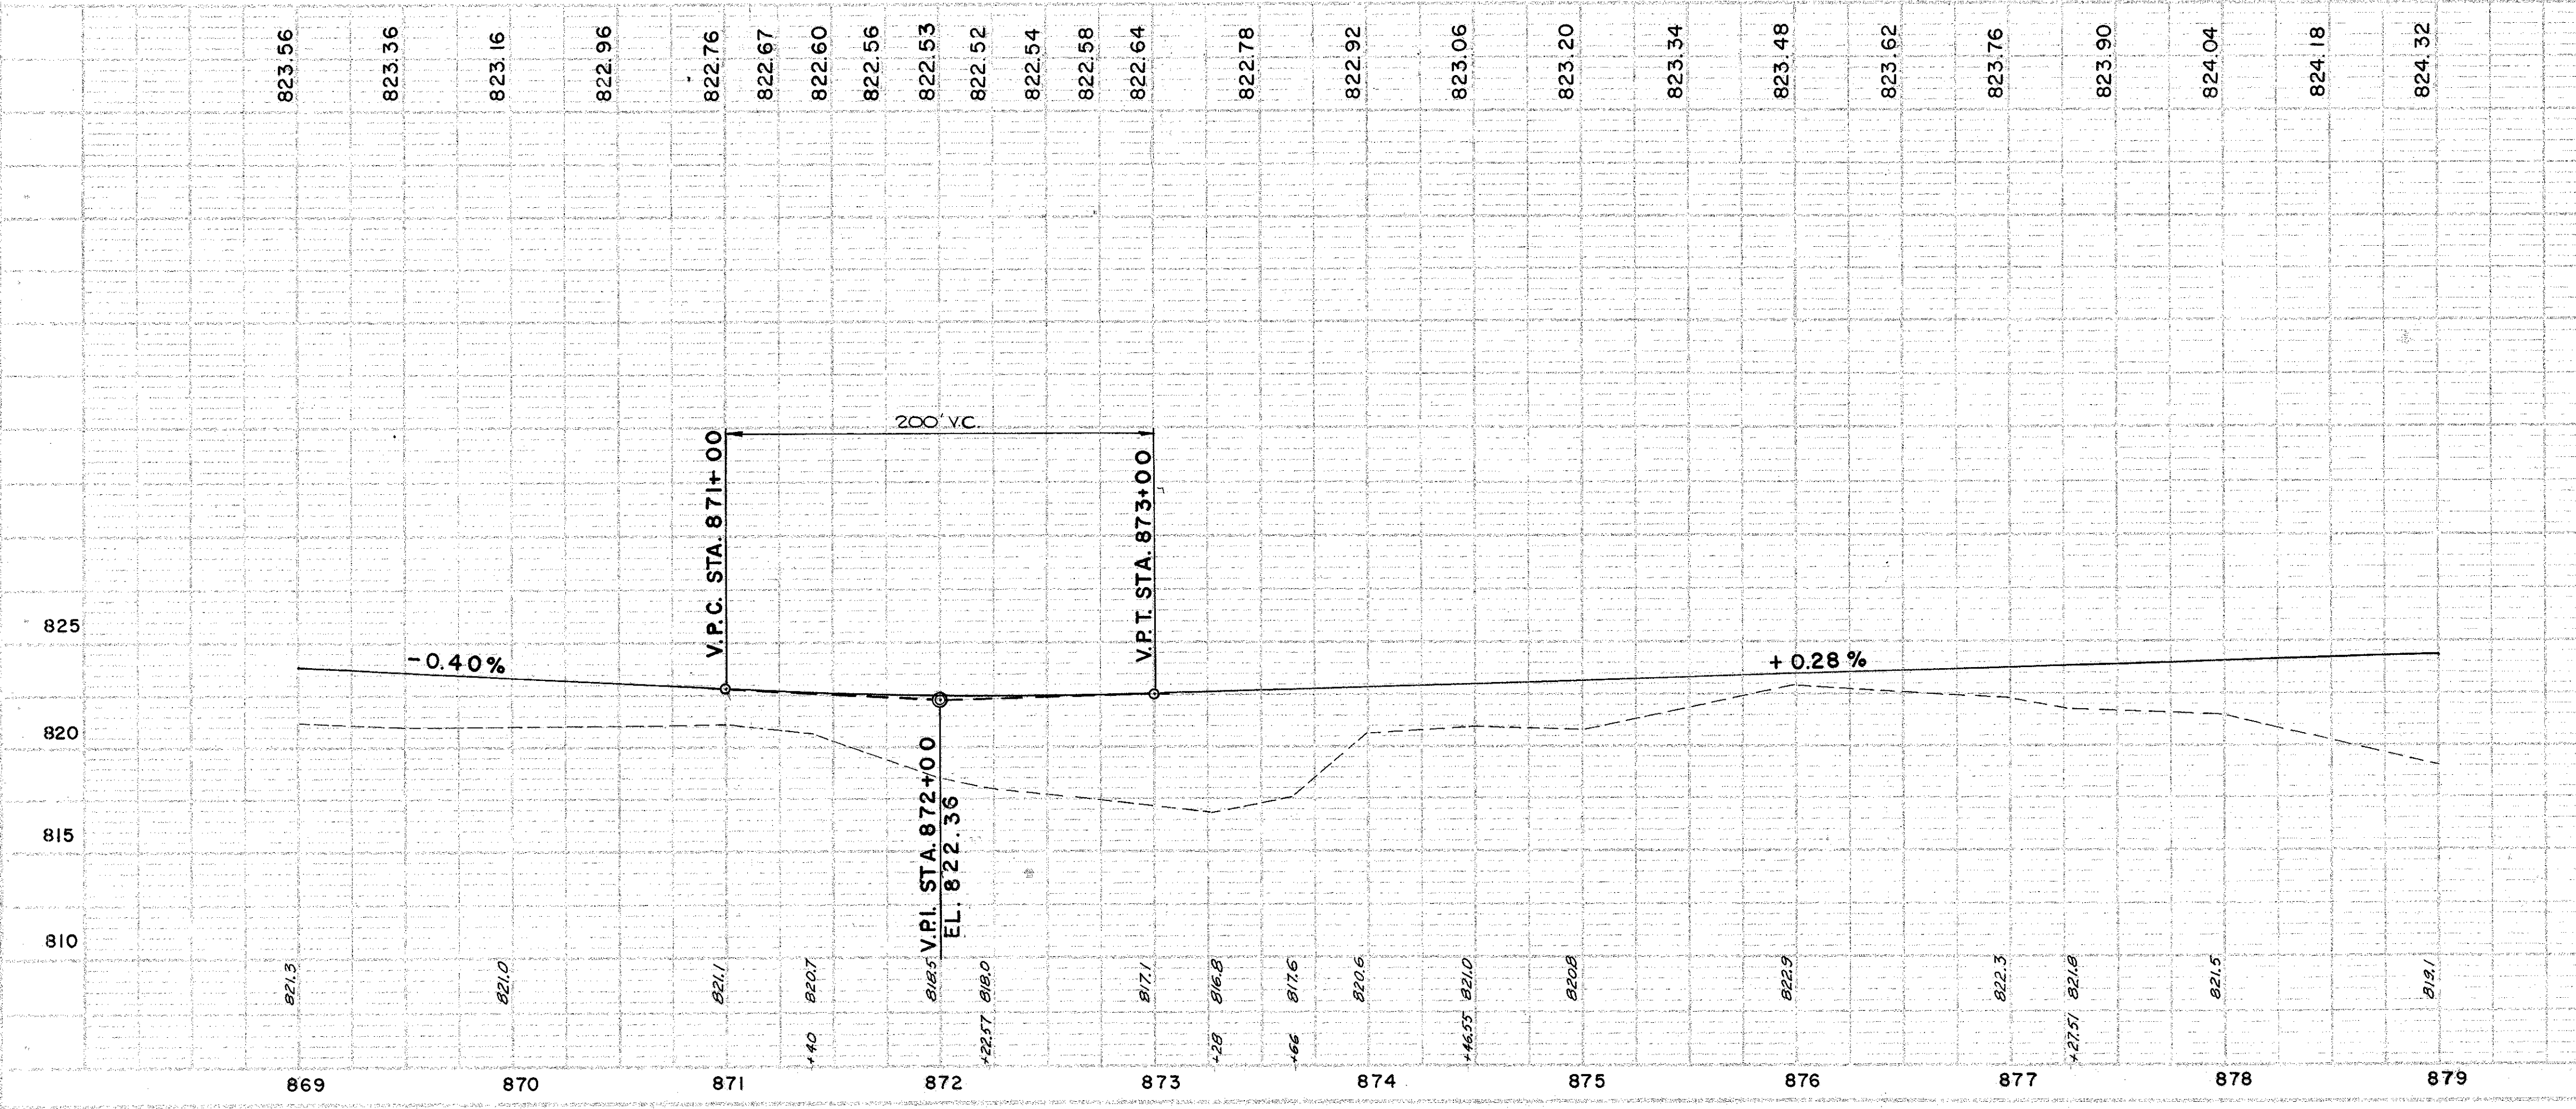

PLAN & PROFILE - STA. 869+00 TO STA. 879+00