

CFN 180710742
 SLM 7.42, 66"
 SEE SHEET 205

FOR DETAILS ON CULVERT D-4
 SEE SHEET 205

SLM 7.49, 12"
 SEE SHEET 186


SLM 7.54, 12"
 SEE SHEET 186

SLM 7.59, 12"
 SEE SHEET 186

FED. RD. DIVISION	STATE	PROJECT	FISCAL YEAR
2	OHIO		

33
353

CUYAHOGA COUNTY
 CUY-71-5.72

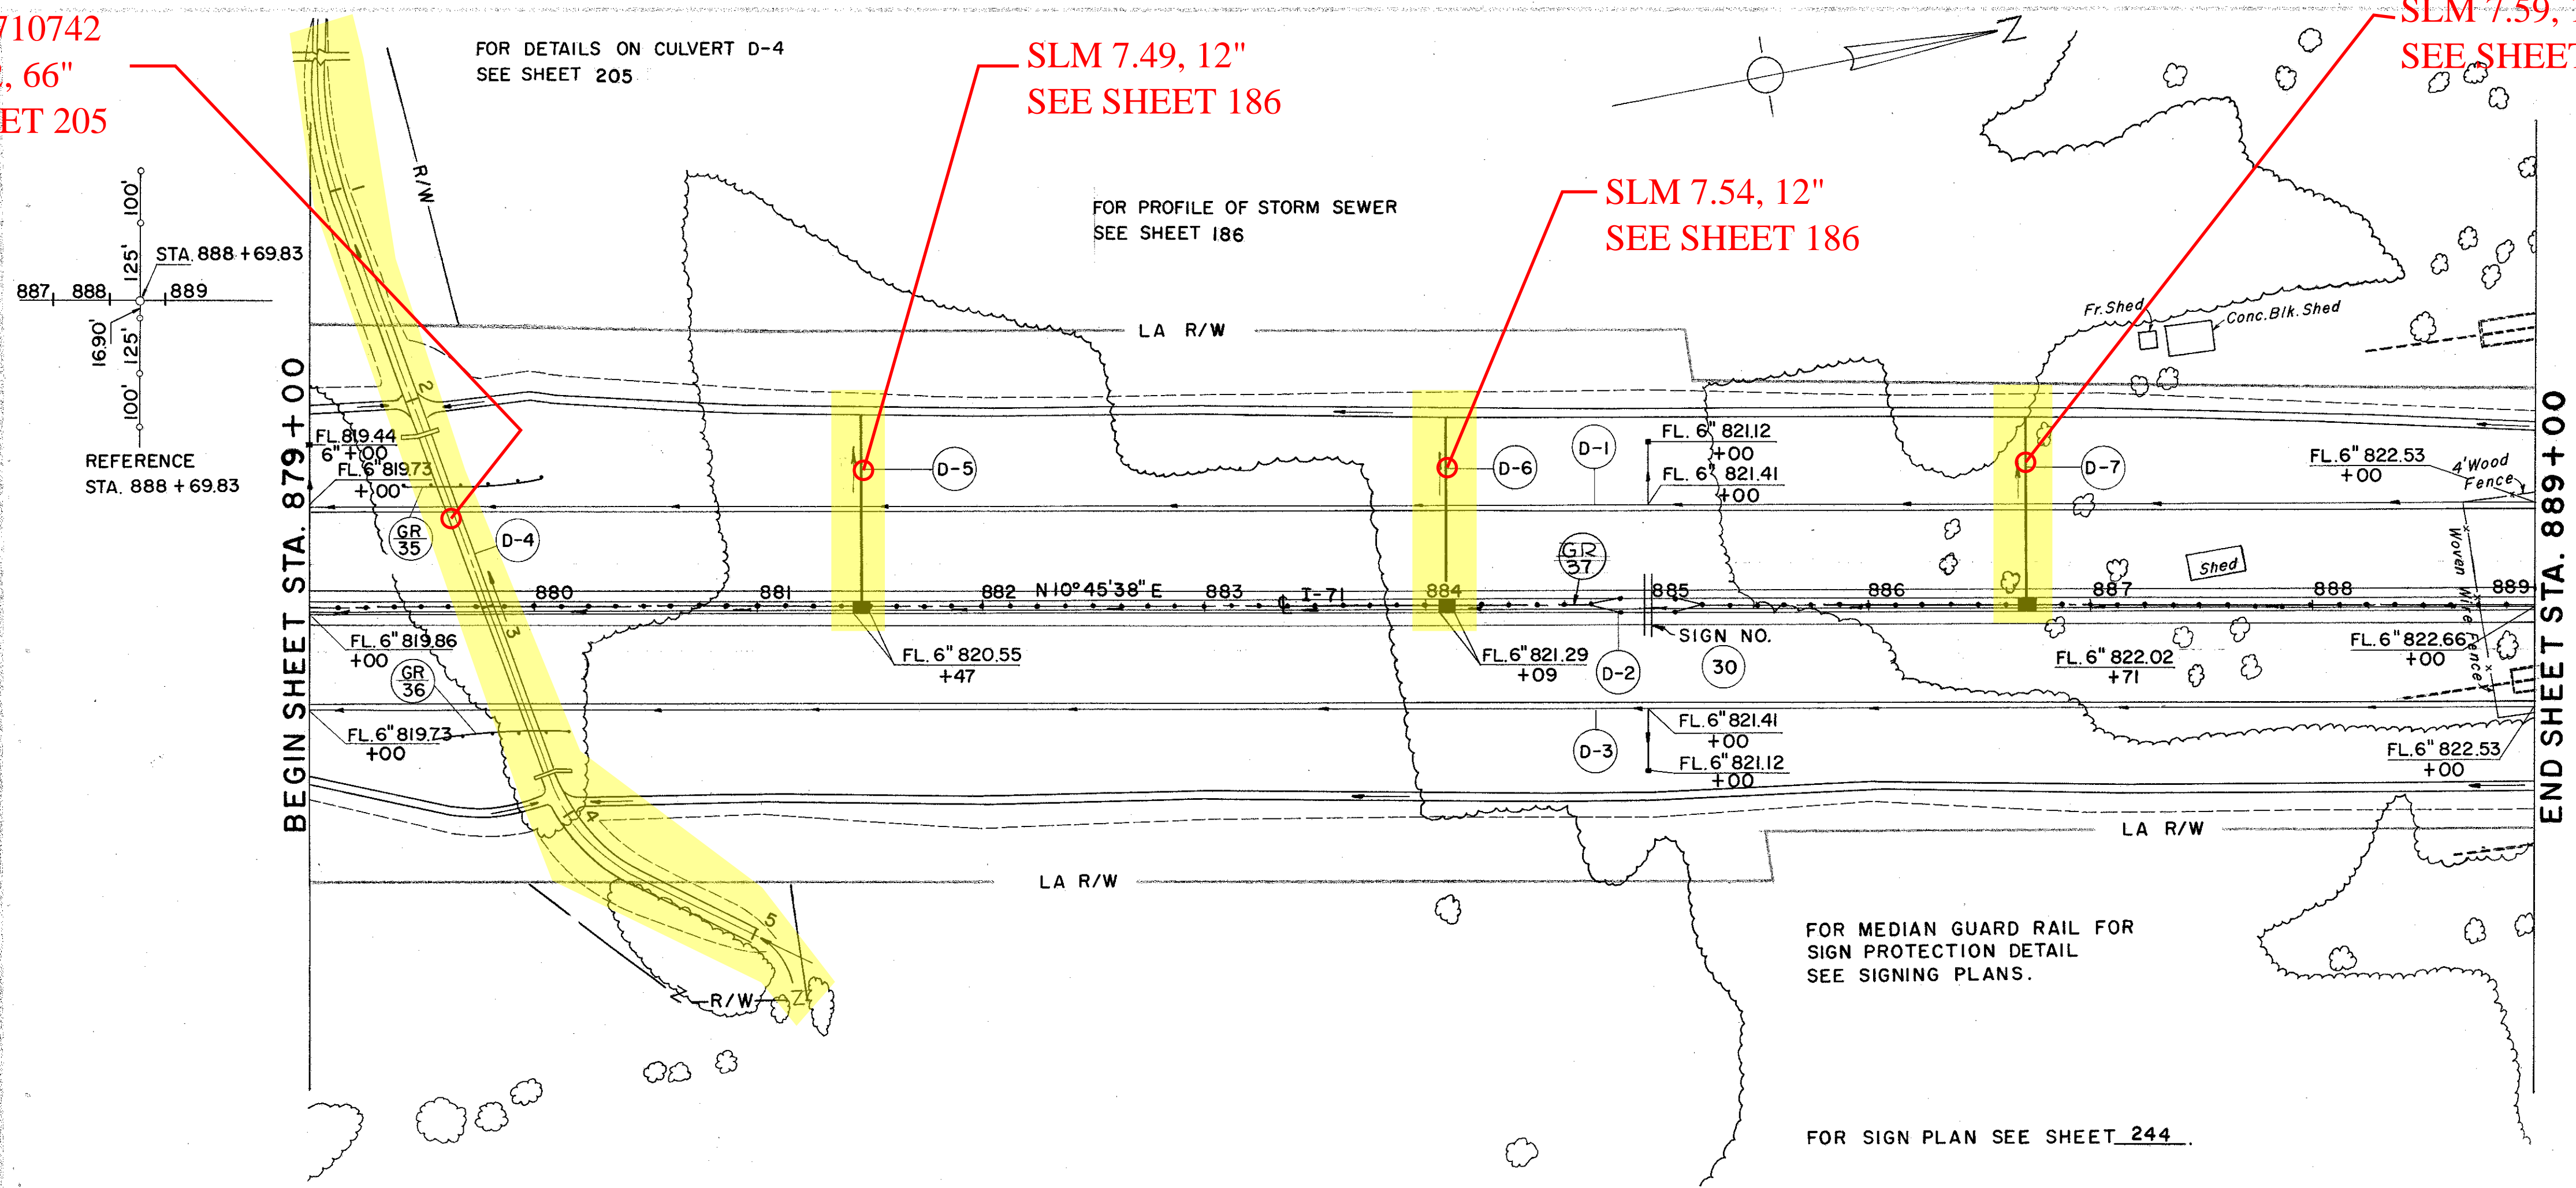


D DRAINAGE

REF. NO.	STATION		SIDE	I-1				I-5	I-8	I-2	I-10	L-10	E-3
	FROM	TO		U.D. SHALLOW	6\"/>								
D-1	879+00	889+00	LT.	996	60			2					
D-2	879+00	889+00	CL	960	40								
D-3	879+00	889+00	RT.	1008	20			1					
D-4	879+80		LT.-RT.					166					203
D-5	881+47		CL-LT.			87			1	0.23	2	2	
D-6	884+09		CL-LT.			86			1	0.23	2	2	
D-7	886+71		CL-LT.			85			1	0.23	2	2	
TOTAL				2964	120	258	166	3	3	30.69	26	21	203

ROADWAY

REF. NO.	STATION		SIDE	GUARD RAIL		LIN. FT.	
	FROM	TO		STEEL BEAM (DEEP)			
GR-35	879+42.5	880+05	LT.	62.5	-		
GR-36	879+56	880+18.5	RT.	62.5	-		
GR-37	879+00	889+00	CL	-	1000		
TOTAL						12.5	1000

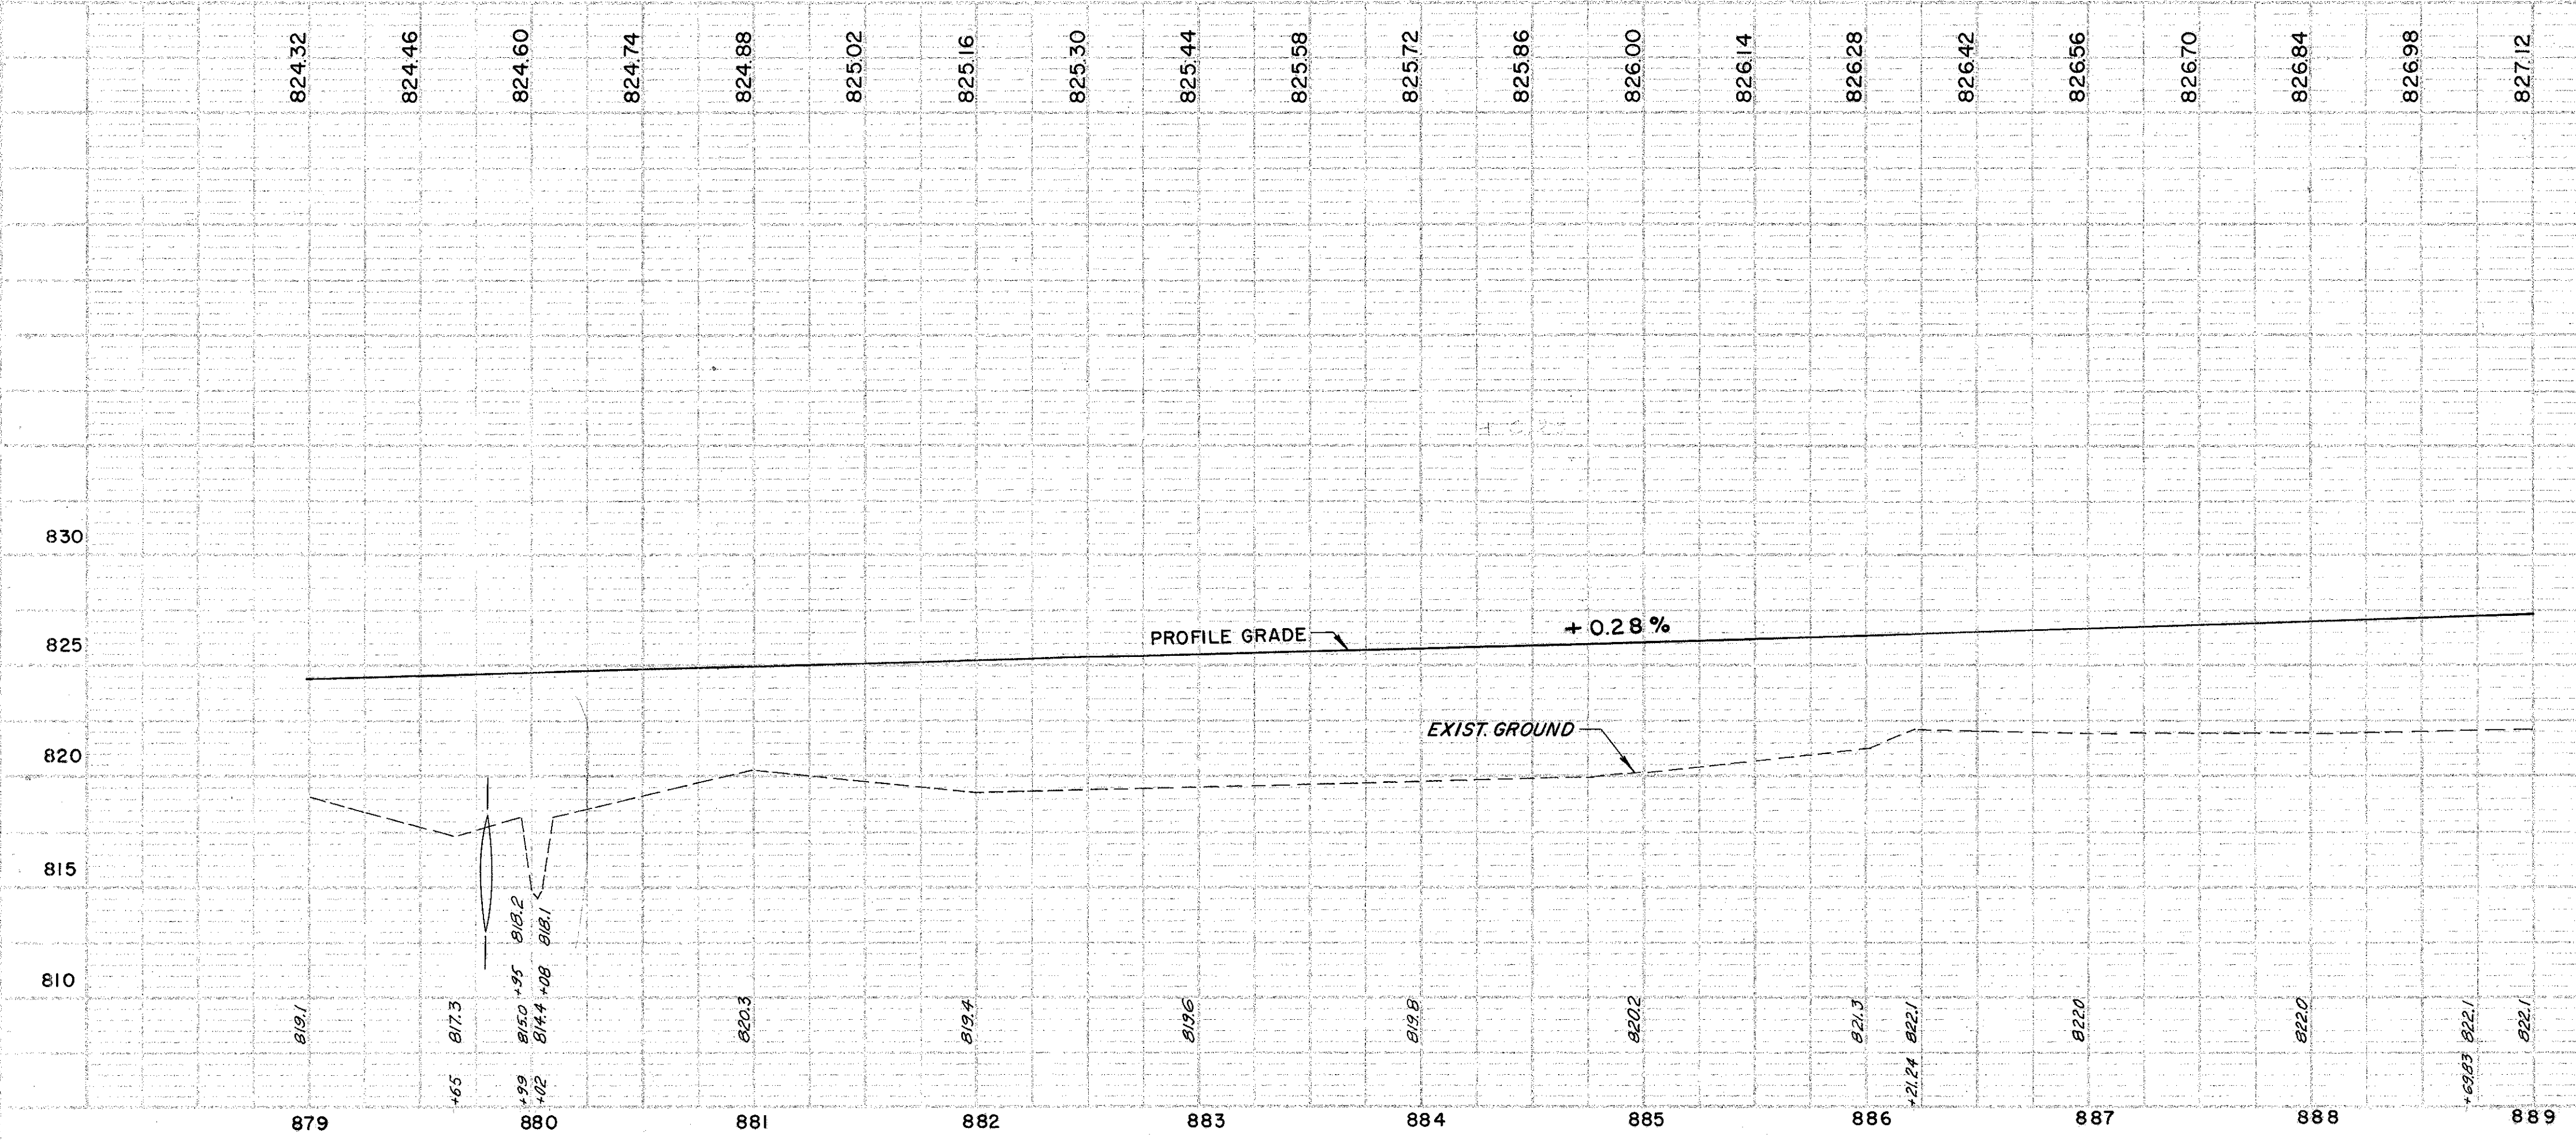

PLAN & PROFILE- STA. 879+00 TO STA. 889+00