

SLM 7.86, 12"
SEE SHEET 186

SHELDON ROAD
SLM 7.87=MM 236.58

SLM 7.83, 12"
SEE SHEET 186

SLM 7.98, 12"
SEE SHEET 187

SLM 8.06, 12"
SEE SHEET 187

FED. RD. DISTRICT	STATE	PROJECT	FISCAL YEAR
2	OHIO		

35
353


CUYAHOGA COUNTY
CUY-71-5.72

D DRAINAGE

REF. NO.	STATION		SIDE	I-1				I-5		I-8		I-16		L-120		
	FROM	TO		CLASS	SEC.	DIAM.	LENGTH	CLASS	DIAM.	STD. MH NO.	STD. CB NO.	MOD. 2'-A'-8" PAVED SHULR INLET	MH ADJUSTED TO GRADE		CB	ABANDONED
D-1	899+00	909+00	LT.	1008	36	30		2								
D-2	899+00	909+00	CL	960		40										
D-3	899+00	909+00	RT.	1008	36			2								
D-4	899+00	900+35	CL					135								
D-5	900+46	902+10	LT.					6								125
D-6	900+35	902+20	CL					185								
D-7	900+76	902+33	RT.													125
D-8	904+55	908+75	CL					420								
D-9	908+75	909+00	CL					25								
D-10	SANDHURST DR. 8+28	8+51	LT. & RT.										2	2		
TOTAL				2976	72	70	771	4	1	2	3	2	2	2	250	

ROADWAY

REF. NO.	STATION		SIDE	STEEL BEAM (DEEP)	
	FROM	TO		STANDARD	BARRIER
GR-37	902+57.5	903+57.5	LT.	100	
GR-38	902+15	903+15	RT.	100	
GR-39	899+00	909+00	M		1000
TOTAL				200	1000

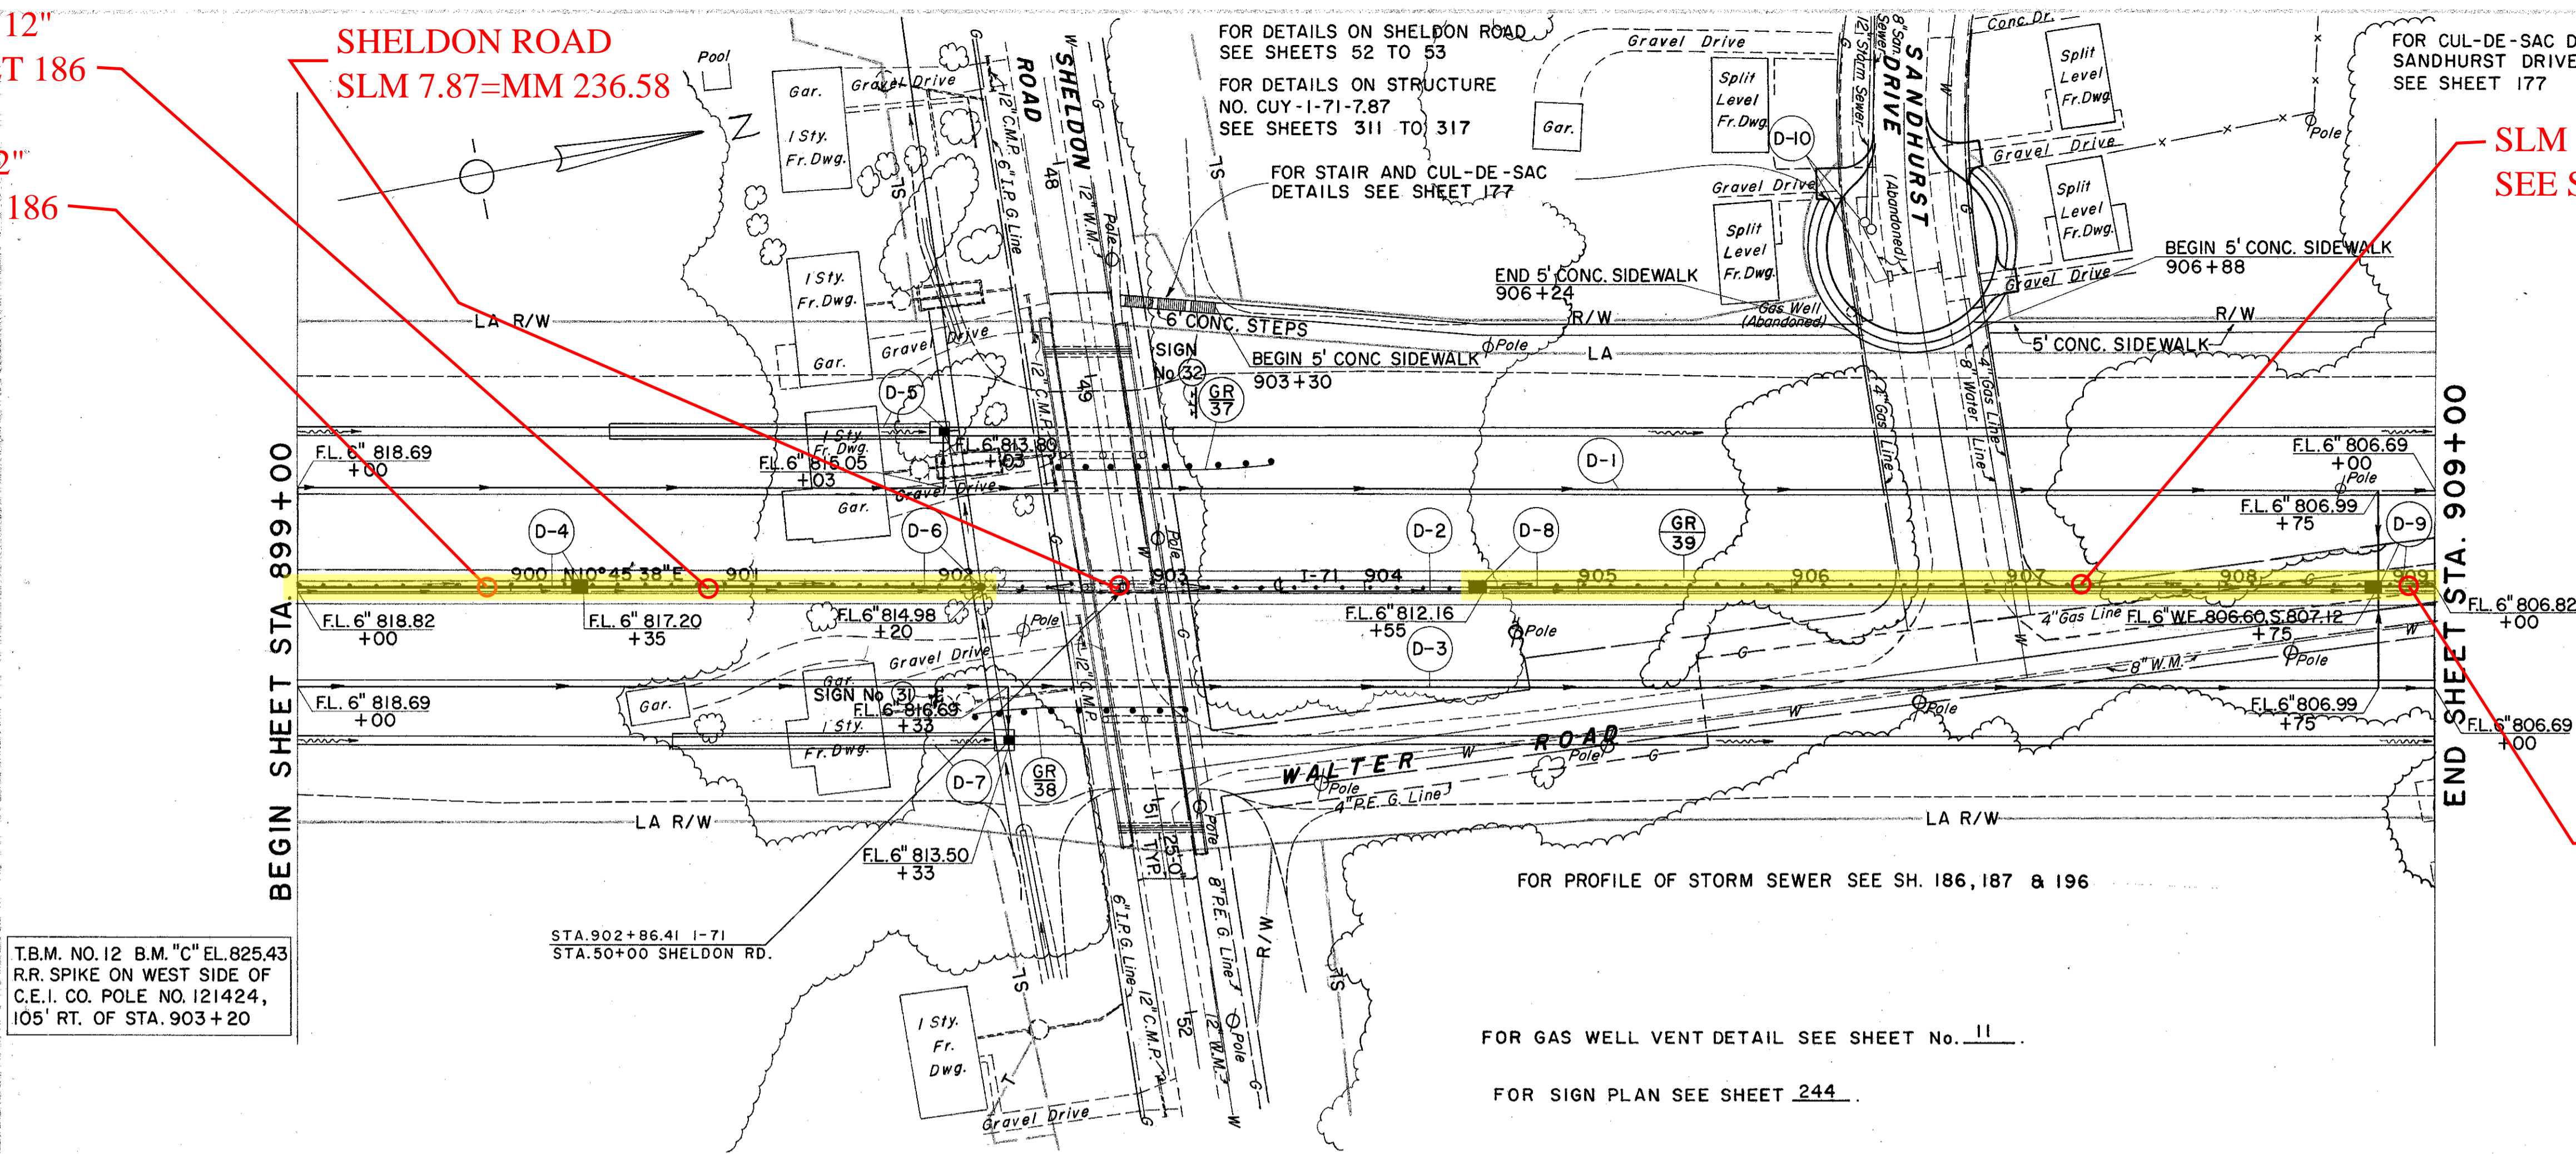


T.B.M. NO. 12 B.M. "C" EL. 825.43
R.R. SPIKE ON WEST SIDE OF
C.E.I. CO. POLE NO. 121424,
105' RT. OF STA. 903+20

STA. 902+86.41 I-71
STA. 50+00 SHELDON RD.

FOR PROFILE OF STORM SEWER SEE SH. 186, 187 & 196

FOR GAS WELL VENT DETAIL SEE SHEET No. 11

FOR SIGN PLAN SEE SHEET 244

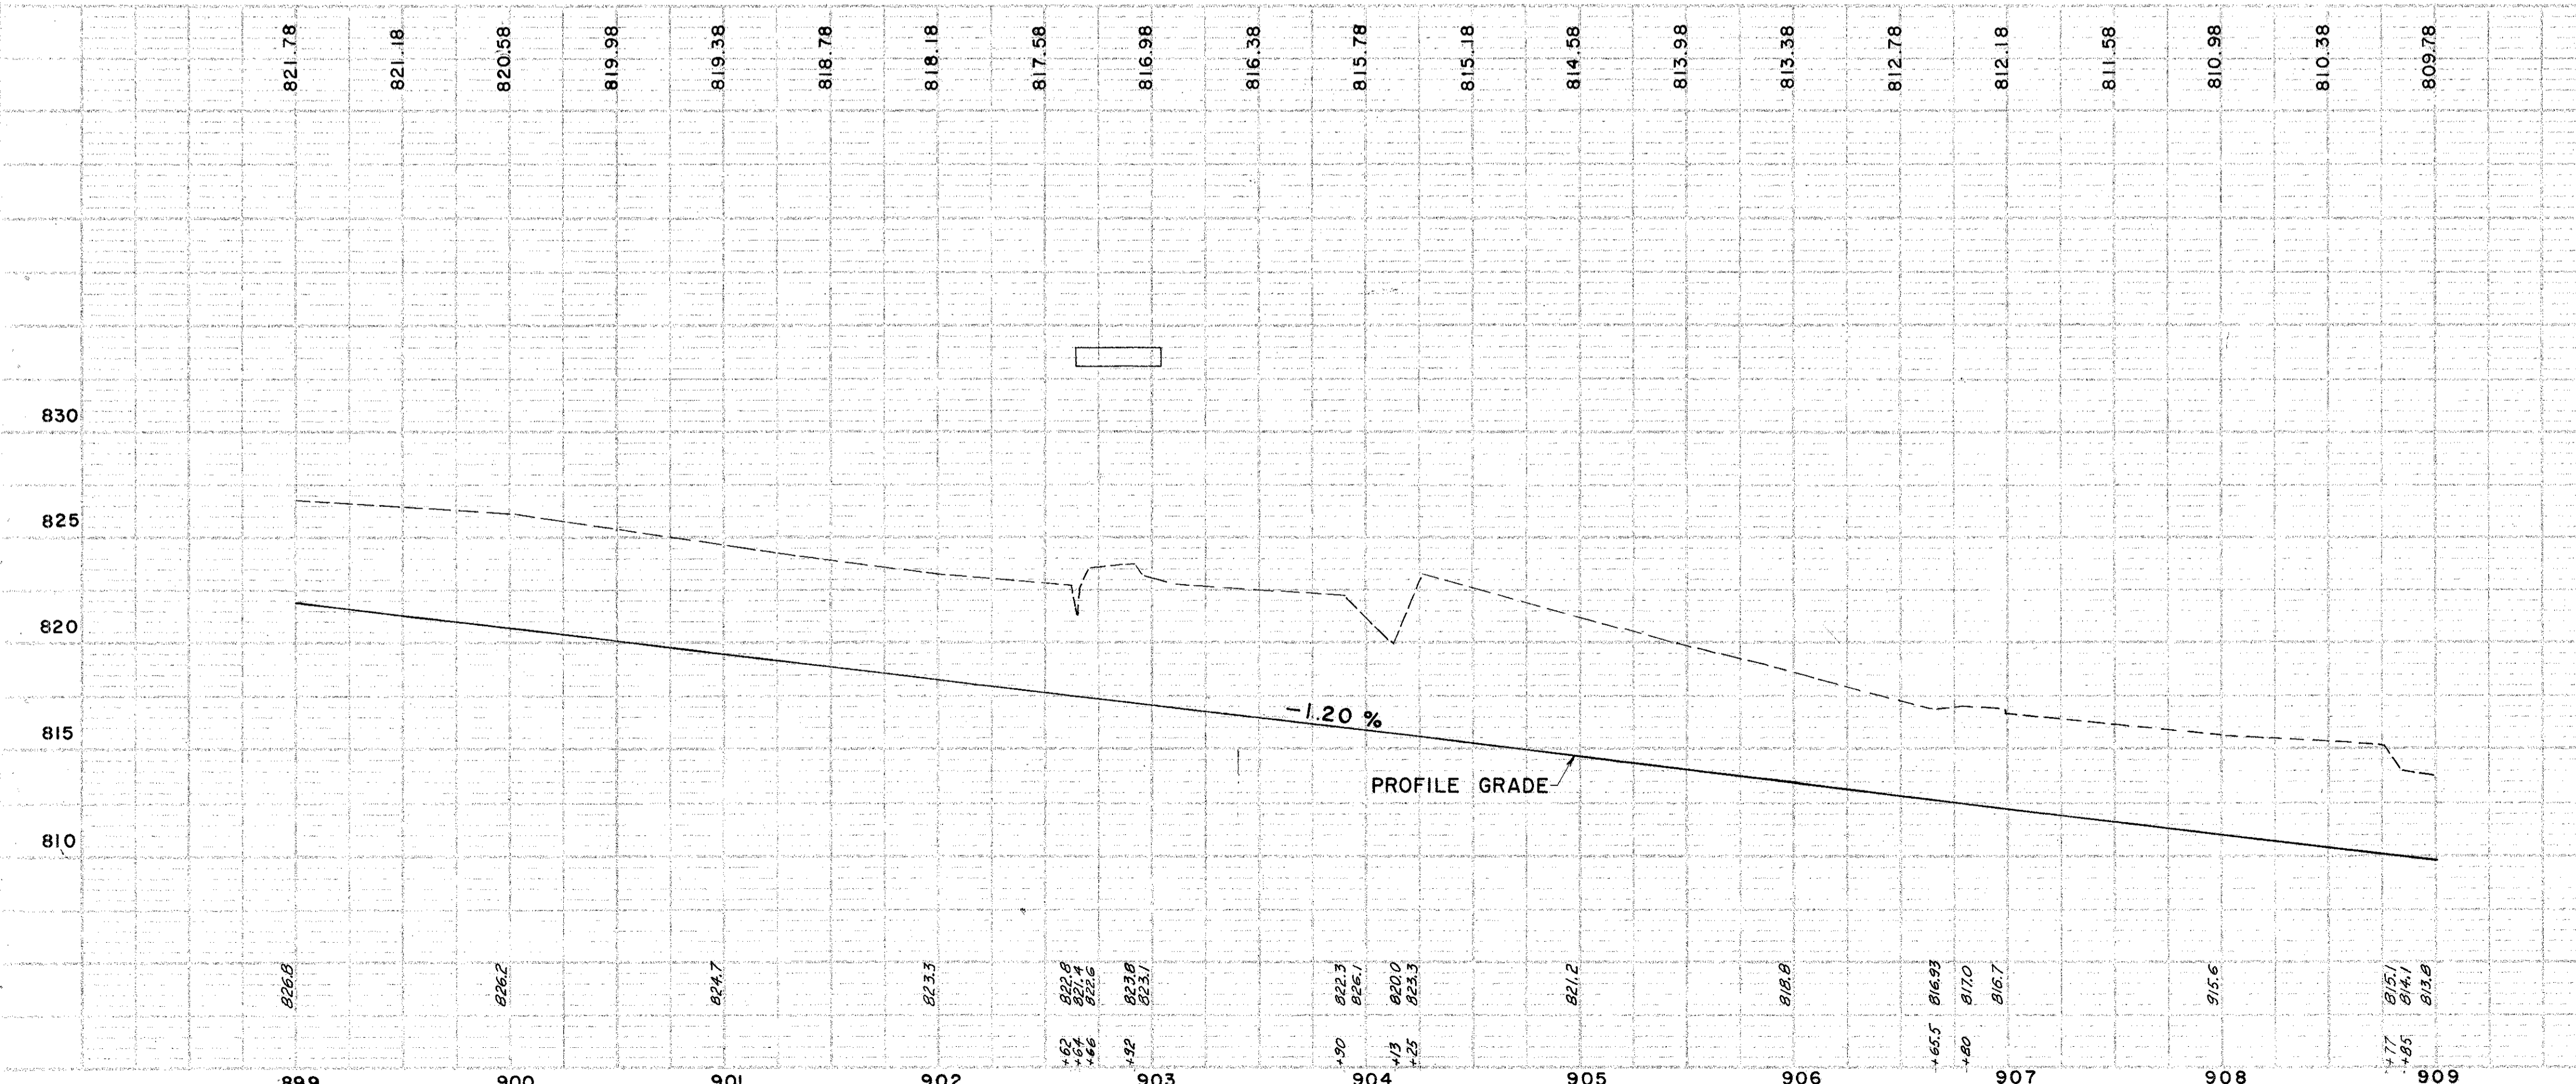

STRUCTURE NO. CUY-71-0787
 TYPE: CONTINUOUS STEEL BEAM WITH
 REINFORCED CONCRETE DECK
 AND SUBSTRUCTURE
 SPANS: 50'-0" - 62'-6" - 62'-6" - 50'-0" C/C BRGS.
 ROADWAY: 28'-0" F.F. 5'-0" SIDEWALKS
 LOAD FREQUENCY: CF=400
 SKEW: 8°57'07"
 WEARING SURFACE: 1" MONOLITHIC CONCRETE
 APPROACH SLAB: 25' LONG
 ALIGNMENT: TANGENT

PLAN & PROFILE - STA. 899+00 TO STA. 909+00