


D.A. = 500 Ac.
Q₅₀ = 440 cfs

CFN 180711606
SLM 16.06, 96"
SEE SHEETS
35 AND 151

ESTIMATED QUANTITIES

I-1 96" PIPE CLASS A-1 SEC. M-6.4 (g)	~ 522 LIN. FT.
I-1 GAGE	
I-2 MASONRY	~ 10.2 CU. YDS.
L-10 SODDING	~ 8 SQ. YDS.
I-1 96" PIPE CLASS A-1, SEC. M-6.4 (g)	84 LIN. FT.
I-1 GAGE, AS PER PLAN	

FOR SP-53 END WALLS
DETAILS SEE SHEET No. 249

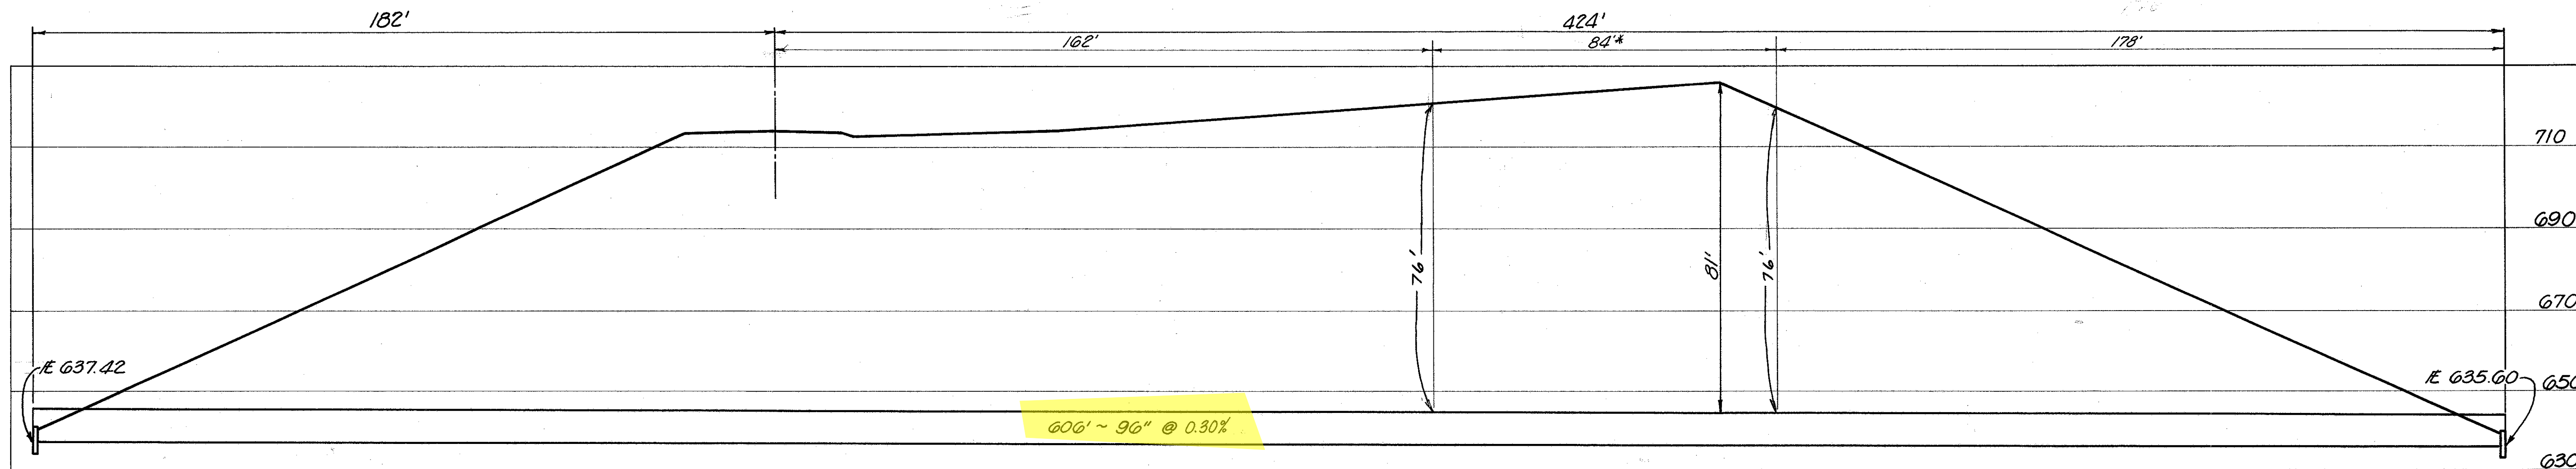

NOTE: 96" PIPE CLASS A-1 AS PER PLAN
USE 6 BOLTS PER FT. OF LONGITUDINAL
SEAM IN LIEU OF 4 BOLTS PER FT.