
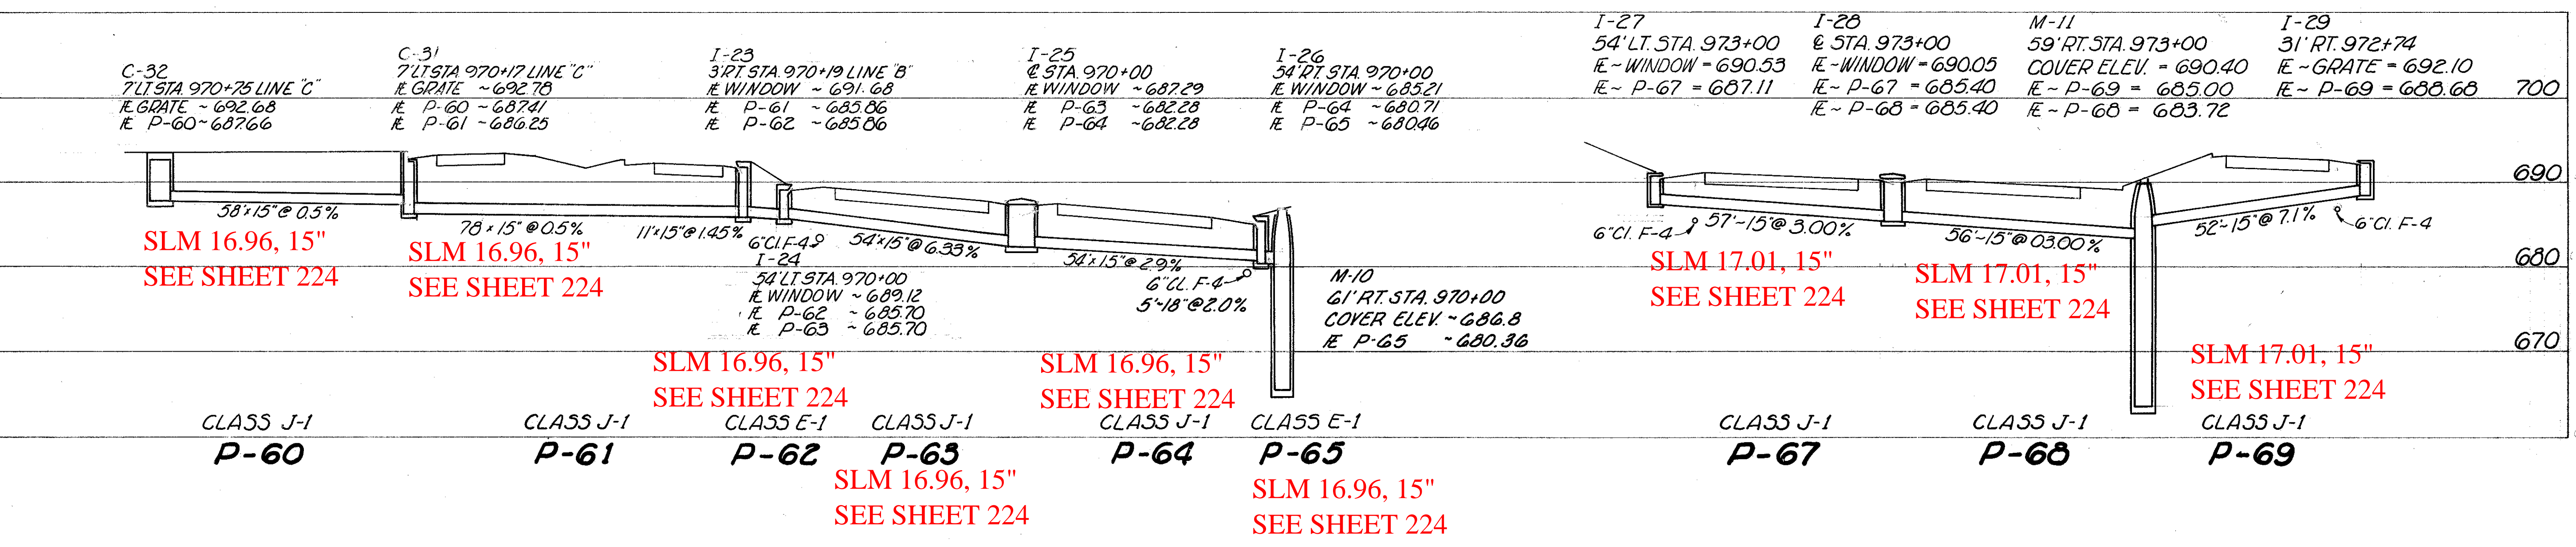


CUYAHOGA COUNTY
CUI-71 15.06

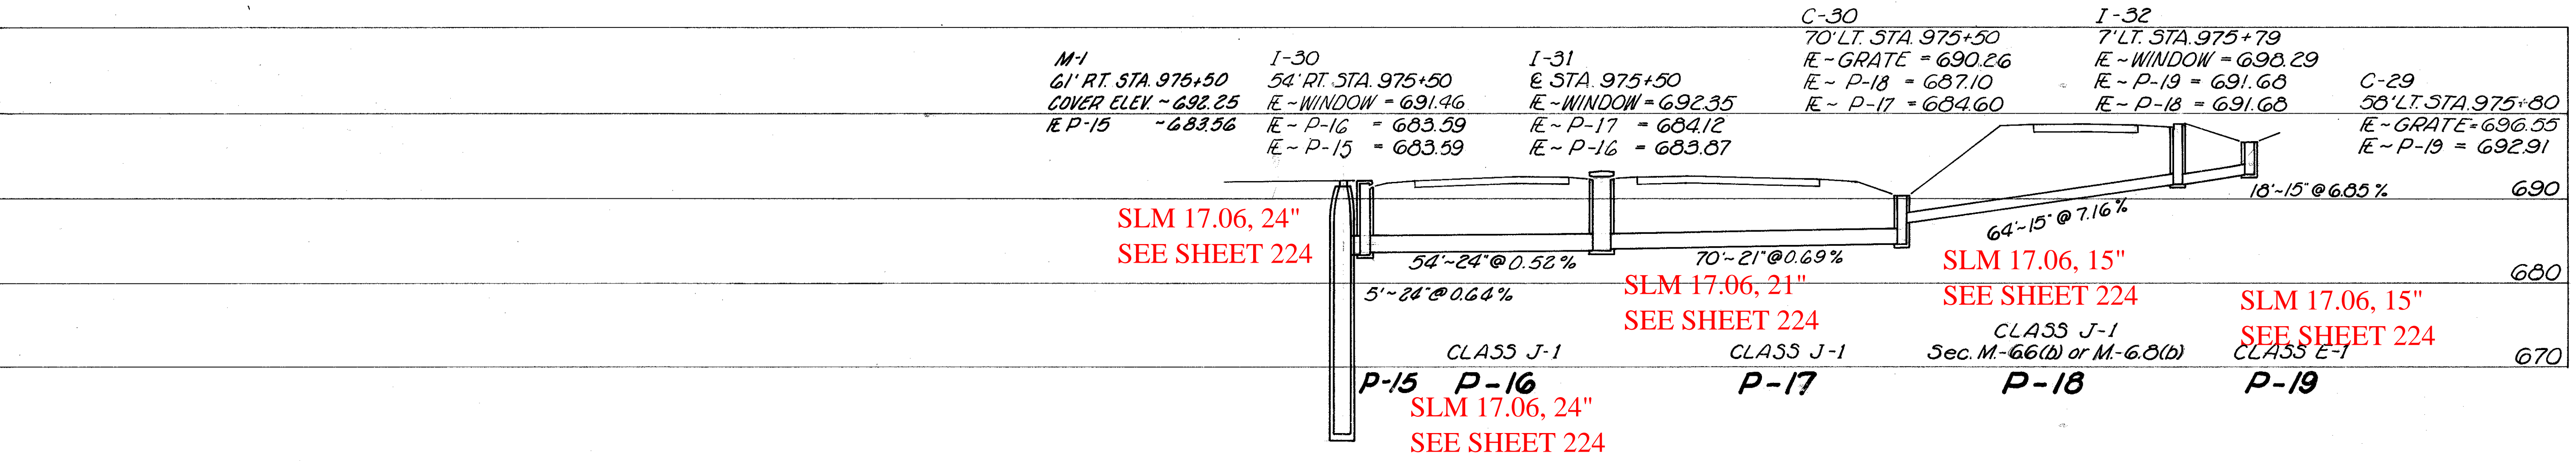

NOTE: P-66 OMITTED

ESTIMATED QUANTITIES																
PIPE REFERENCE	STRUCTURES INCLUDED	L-120 JUTE MATTING SQ. YDS.	CLASS E-1		3cc. M-66(b) or M-68(b) 15"	I-1 CLASS J-1			STANDARD CATCH BASINS		I-8 STANDARD INLETS				STD. INLET Nº 2-8 EACH as per plan	SEE SHEET NO.
			15"	18"		15"	21"	24"	Nº 3	Nº 5	Nº 2A-6	Nº 2A-8	Nº 2A-10	Nº 2A-12		
			LIN. FT.			LIN. FT.			EACH		EACH					
P-15	I-30							5								224
P-16	I-31							54								224
P-17	C-30	125					70			1						224
P-18	I-32					64										224
P-19	C-29	125														224
P-60	C-32			18						1						224
P-61	C-31						58									224
P-62	I-23						78			1						224
P-63	I-24						54									224
P-64	I-25						54									224
P-65	I-26															224
P-67	I-27			5												224
P-68	I-28						57									224
P-69	I-29						56									224
							52									224
TOTALS		250		29	5	64	409	70	59	2	2	3	1	2	1	3