



CUYAHOGA COUNTY
CUI-71-15.06

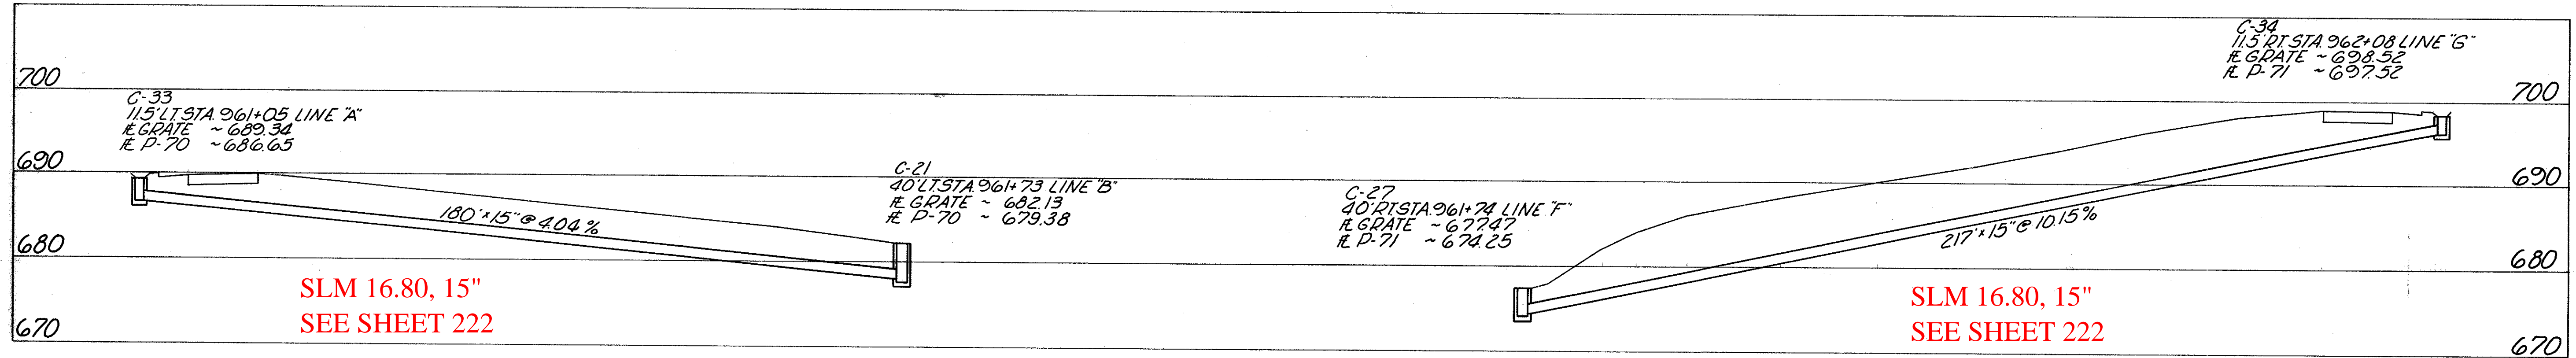

P-70

P-71

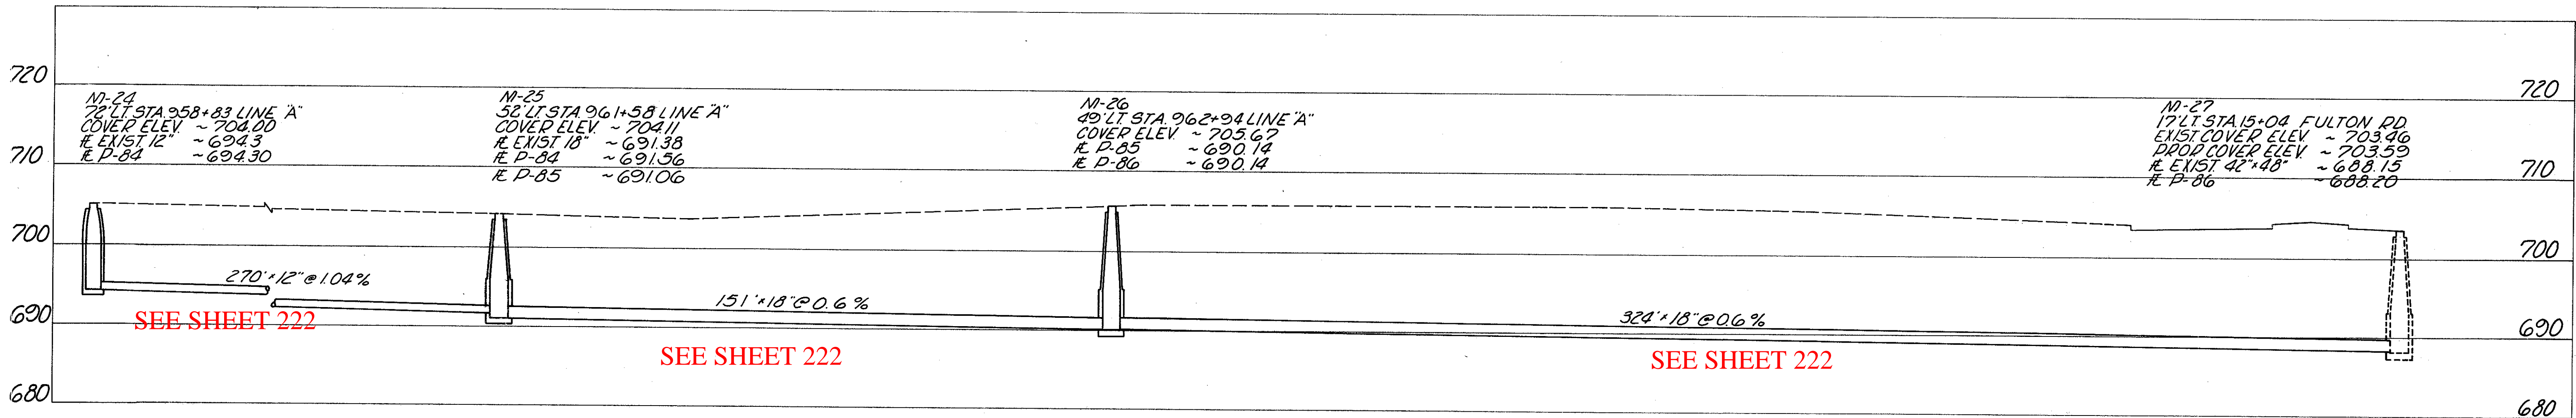

P-84

P-85

P-86

CODE Y060 * WITH COMPRESSION JOINTS

| ESTIMATED QUANTITIES | | | | | | | | | | SEE SHEET NO. |
|----------------------|------------------------|--|----------|----------|---------------------------------|--|-----------------------------|---------------------------------------|----------|---------------------|
| PIPE REFERENCE | STRUCTURES INCLUDED | I-1 | | | I-8 | | | | | |
| | | SANITARY SEWER # CLASS B-1 SEC. M- 6.8(b)* | CL. J-1 | | MANHOLE ADJUSTED TO GRADE | STANDARD No 2 M.H. WOODROP PIPE | STANDARD No 1 MANHOLE | STANDARD No 2-2B CATCH BASIN | | |
| | | | 12" | 18" | | | | | 15" | |
| | | | LIN. FT. | LIN. FT. | | | | | LIN. FT. | |
| P-70 | C-33 | | | 180 | | | | 1 | | |
| P-71 | C-34 | | | 217 | | | | 1 | | |
| P-84 | M-24 | 270 | | | | | 1 # | | 222 | |
| P-85 | M-25 | | 151 | | | 1 # | | | 222 | |
| P-86 | M-26 | | 324 | | 1 # | 1 # | | | 222 | |
| | M-27 | | | | | | | | 222 | |
| TOTALS | | 270 | 475 | 397 | 1 # | 2 # | 1 # | 2 | | |