
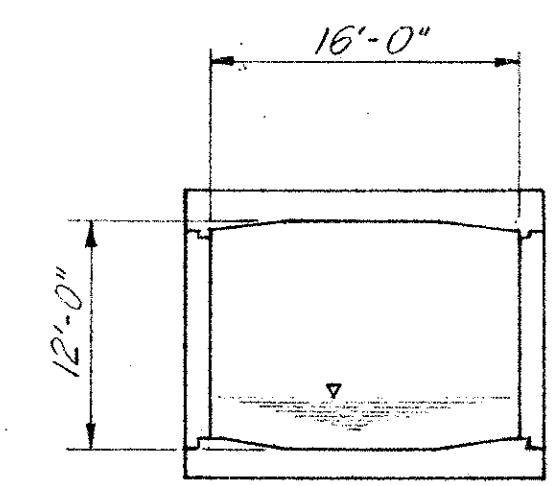
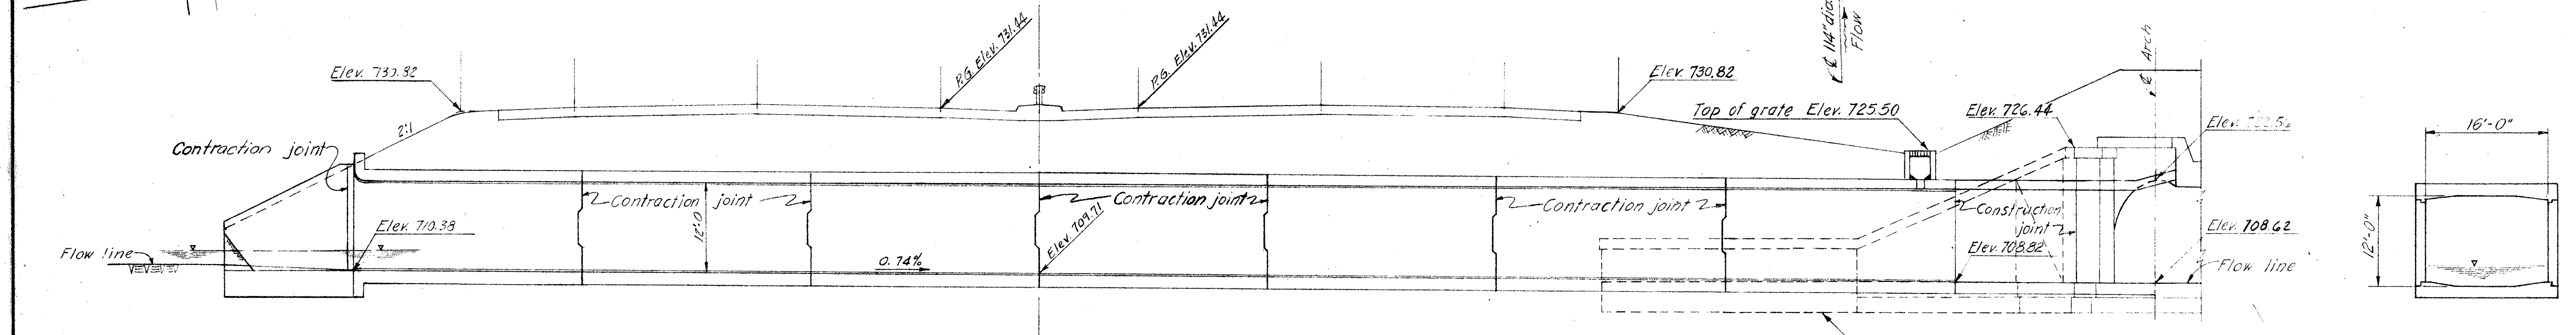


FED. RD. DIVISION	STATE	PROJECT	TYPE FUNDS
2	OHIO		

CUYAHOGA COUNTY
CUY-71-13.68

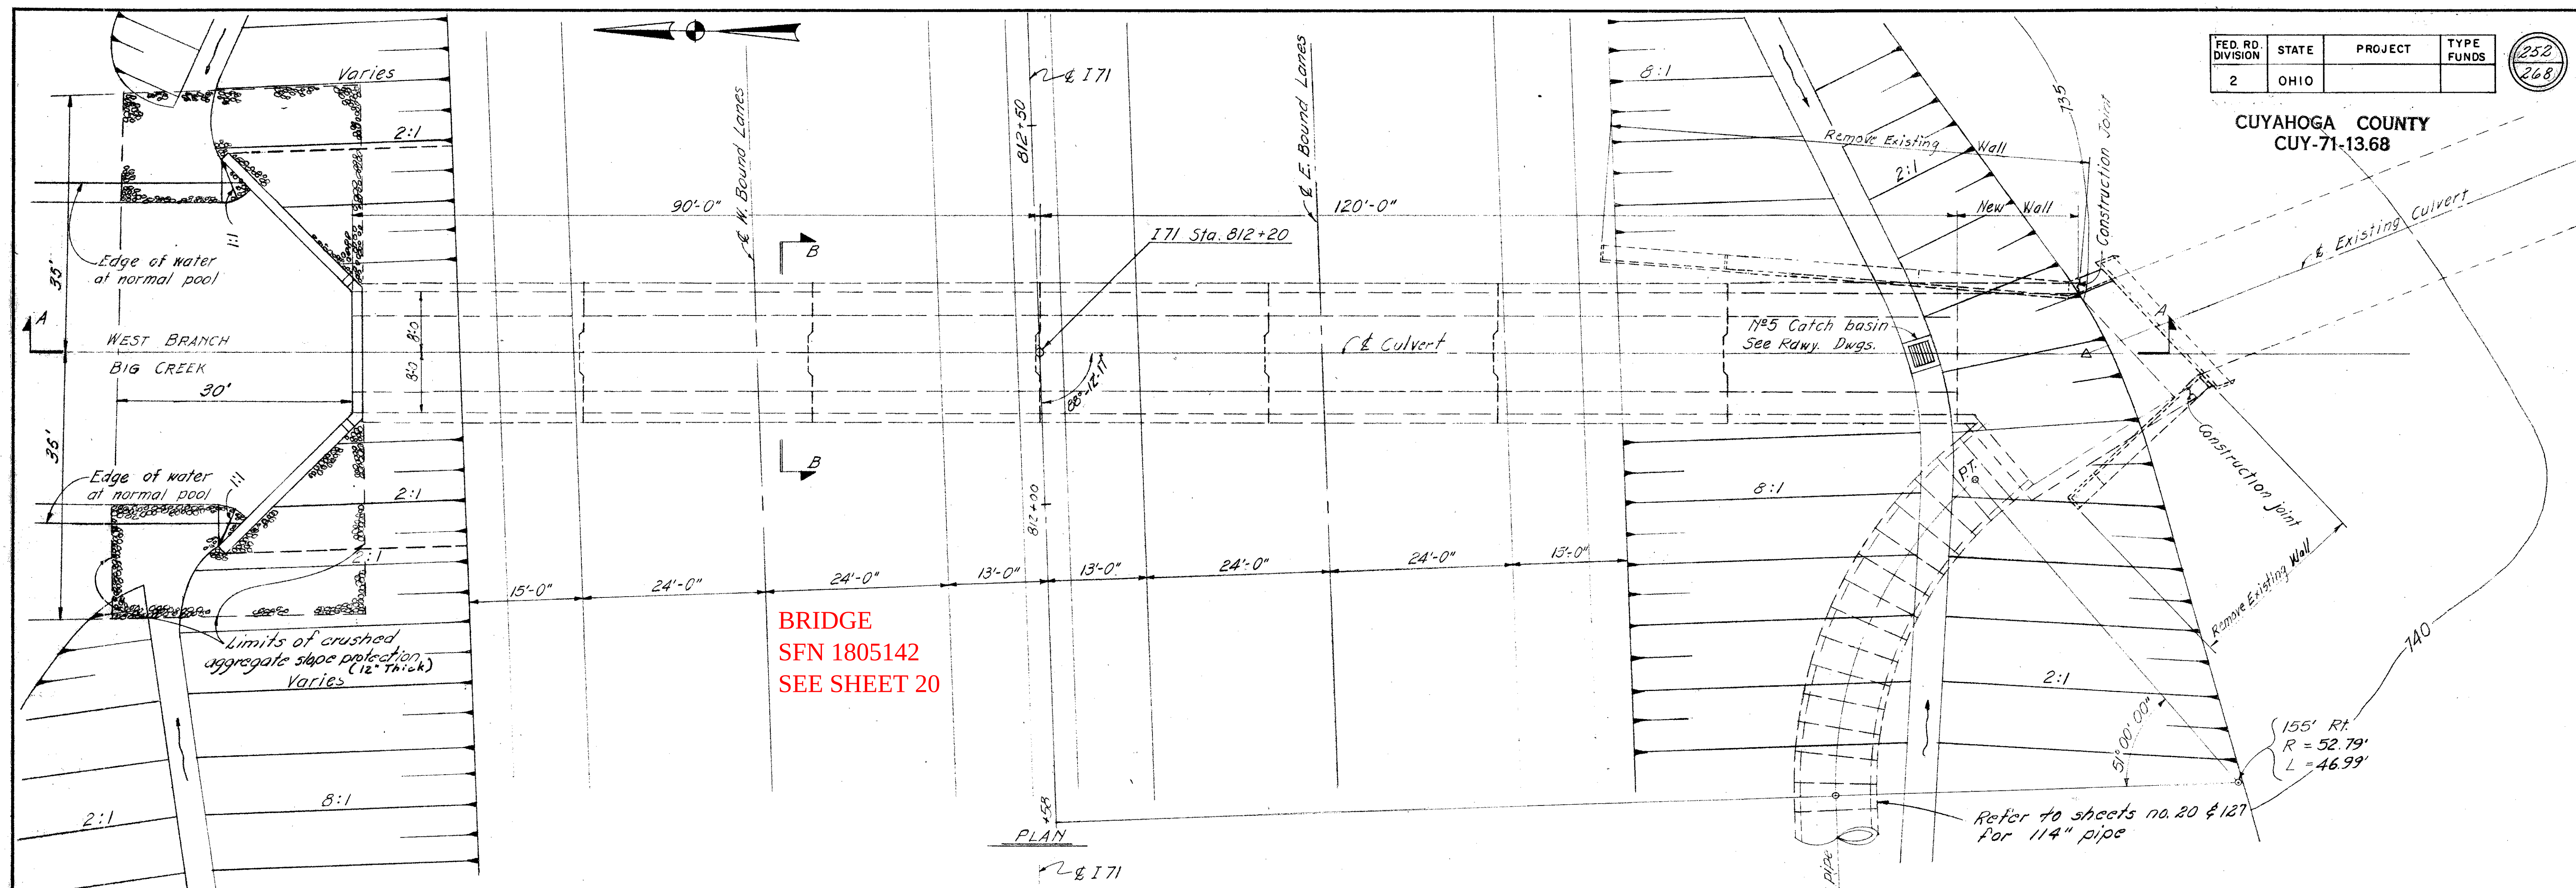

SECTION A-A ALONG $\frac{1}{2}$ CULVERT

SECTION B-B

RACKOFF ASSOCIATES ENGINEERS COLUMBUS, OHIO						
SITE PLAN CULVERT UNDER I 71						
CUYAHOGA COUNTY STA. 812+20						
Designed	Drawn	Traced	Checked	Reviewed	Date	Revised
W.F.	W.F.	E.D.A.	L.L.	llb	10-28-64	