

CUYAHOGA COUNTY  
CITY OF CLEVELAND  
MEDINA-CLARK INTERCHANGE  
CUY- 71-18.54  
CUY- 90-13.81

SLM 0.15, 84"  
SEE SHEET 80  
82 AND BELOW

SLM 0.17, 84"  
SEE SHEET 80  
AND BELOW

SLM 0.18, 90"  
SEE SHEET 80  
AND BELOW

CFN 184900000  
SLM 0.24, 90"  
SEE SHEET 80  
AND BELOW

SLM 0.26, 90"  
SEE SHEET 80  
AND BELOW

SLM 0.29, 90"  
SEE SHEET 80  
AND BELOW

SLM 0.33, 90"  
SEE SHEET 80  
AND BELOW

ESTIMATED QUANTITIES

CODE	LOCATION	Inlet M.H. 2-A-6	Inlet M.H. 2-A-12	M.H. No. 2
121	940+00 Clark Freeway	54' LT.		
122	941+38 Clark Freeway	54' LT.		
123	942+12 Clark Freeway	54' LT.		
124	942+87 Clark Freeway	54' LT.		
125	946+00 Clark Freeway	54' LT.		
126	947+00 Clark Freeway	58' LT.		
179	948+71 Clark Freeway	82' LT.		
TOTALS		2	3	2

CODE	ROADWAY	INLET CODE	I-1 PIPE								
			CLASS E-1		CLASS B-1		CLASS E-1		CLASS E-1		
			FROM	TO	84"	90"	90" R75	90"	Sec. M-6.6(b) 90"	Sec. M-106.6(c) 90" R75	Sec. M-106.6(d) 90"
P-121	Clark Freeway	121	122	138' ✓							
P-122	Clark Freeway	122	123	73' ✓							
P-123	Clark Freeway	123	124				74' ✓				
P-124	Clark Freeway	124	125		123' ✓	200' ✓					
P-125	Clark Freeway	125	126				99' ✓				
P-126	Clark Freeway	126	179					93' ✓	79' ✓		
P-179	Clark Freeway	179	178						79' ✓	97' ✓	
TOTALS				211' ✓	123' ✓	200' ✓	173' ✓	93' ✓	158' ✓	97' ✓	

**CURVE NO. 5**  
P.I. Sta. = 14+14.03  
P.I. Coord. = N 659,609.85 E 221,088.87  
Δ = 38°00'47"  
D = 76°23'40"  
R = 75.00'  
L = 49.76'  
T = 25.83'

**CURVE NO. 6**  
P.I. Sta. = 14+93.79  
P.I. Coord. = N 659,582.84 E 221,132.92  
Δ = 38°00'47"  
D = 76°23'40"  
R = 75.00'  
L = 49.76'  
T = 25.83'

**CURVE NO. 7**  
P.I. Sta. = 16+41.24  
P.I. Coord. = N 659,602.66 E 221,306.98  
Δ = 38°00'48"  
D = 76°23'40"  
R = 75.00'  
L = 49.76'  
T = 25.83'

**CURVE NO. 8**  
P.I. Sta. = 16+91.00  
P.I. Coord. = N 659,638.88 E 221,343.83  
Δ = 38°00'48"  
D = 76°23'40"  
R = 75.00'  
L = 49.76'  
T = 25.83'

**CURVE NO. 13**  
P.I. Sta. = 0+16.32  
P.I. Coord. = N 659,298.02 E 221,683.45  
Δ = 50°00'00"  
D = 163°42'08"  
R = 35.00'  
L = 30.54'  
T = 16.32'

**CURVE NO. 9**  
P.I. Sta. = 19+52.63  
P.I. Coord. = N 659,683.20 E 221,577.19  
Δ = 30°06'01"  
D = 76°23'40"  
R = 75.00'  
L = 39.40'  
T = 20.17'


**CURVE NO. 10**  
P.I. Sta. = 19+92.03  
P.I. Coord. = N 659,710.66 E 221,606.74  
Δ = 30°06'01"  
D = 76°23'40"  
R = 75.00'  
L = 39.40'  
T = 20.17'

**CURVE NO. 11**  
P.I. Sta. = 21+28.54  
P.I. Coord. = N 659,741.09 E 221,740.77  
Δ = 30°06'01"  
D = 76°23'40"  
R = 75.00'  
L = 39.40'  
T = 20.17'

**CURVE NO. 12**  
P.I. Sta. = 21+67.94  
P.I. Coord. = N 659,729.09 E 221,779.28  
Δ = 30°06'01"  
D = 76°23'40"  
R = 75.00'  
L = 39.40'  
T = 20.17'

**CURVE NO. 14**  
P.I. Sta. = 1+61.73  
P.I. Coord. = N 659,395.02 E 221,794.61  
Δ = 50°00'00"  
D = 163°42'08"  
R = 35.00'  
L = 30.54'  
T = 16.32'

**CURVE NO. 15**  
P.I. Sta. = 4+72.82  
P.I. Coord. = N 659,697.14 E 221,788.50  
Δ = 30°47'12"  
D = 143°14'22"  
R = 40.00'  
L = 21.49'  
T = 11.01'

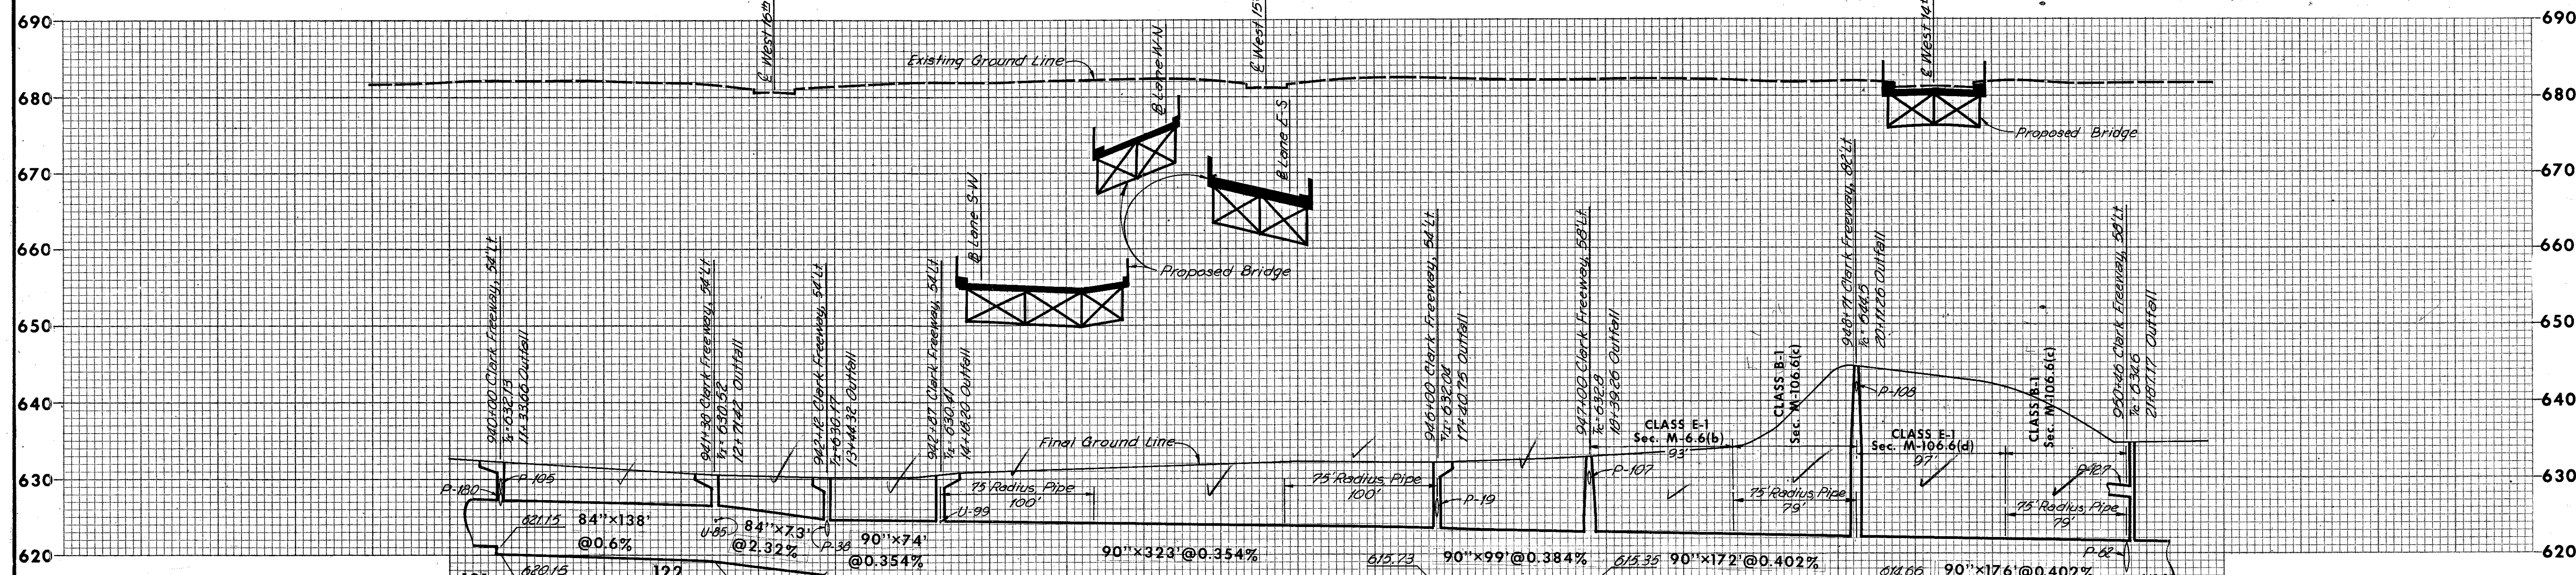

SCALE 1"=10' Vert. 1"=50' H  
HOWARD, NEEDLES, TAMMEN & BERGENDOFF  
CONSULTING ENGINEERS  
CLEVELAND NEW YORK

OUTFALL SEWER  
PLAN AND PROFILE