
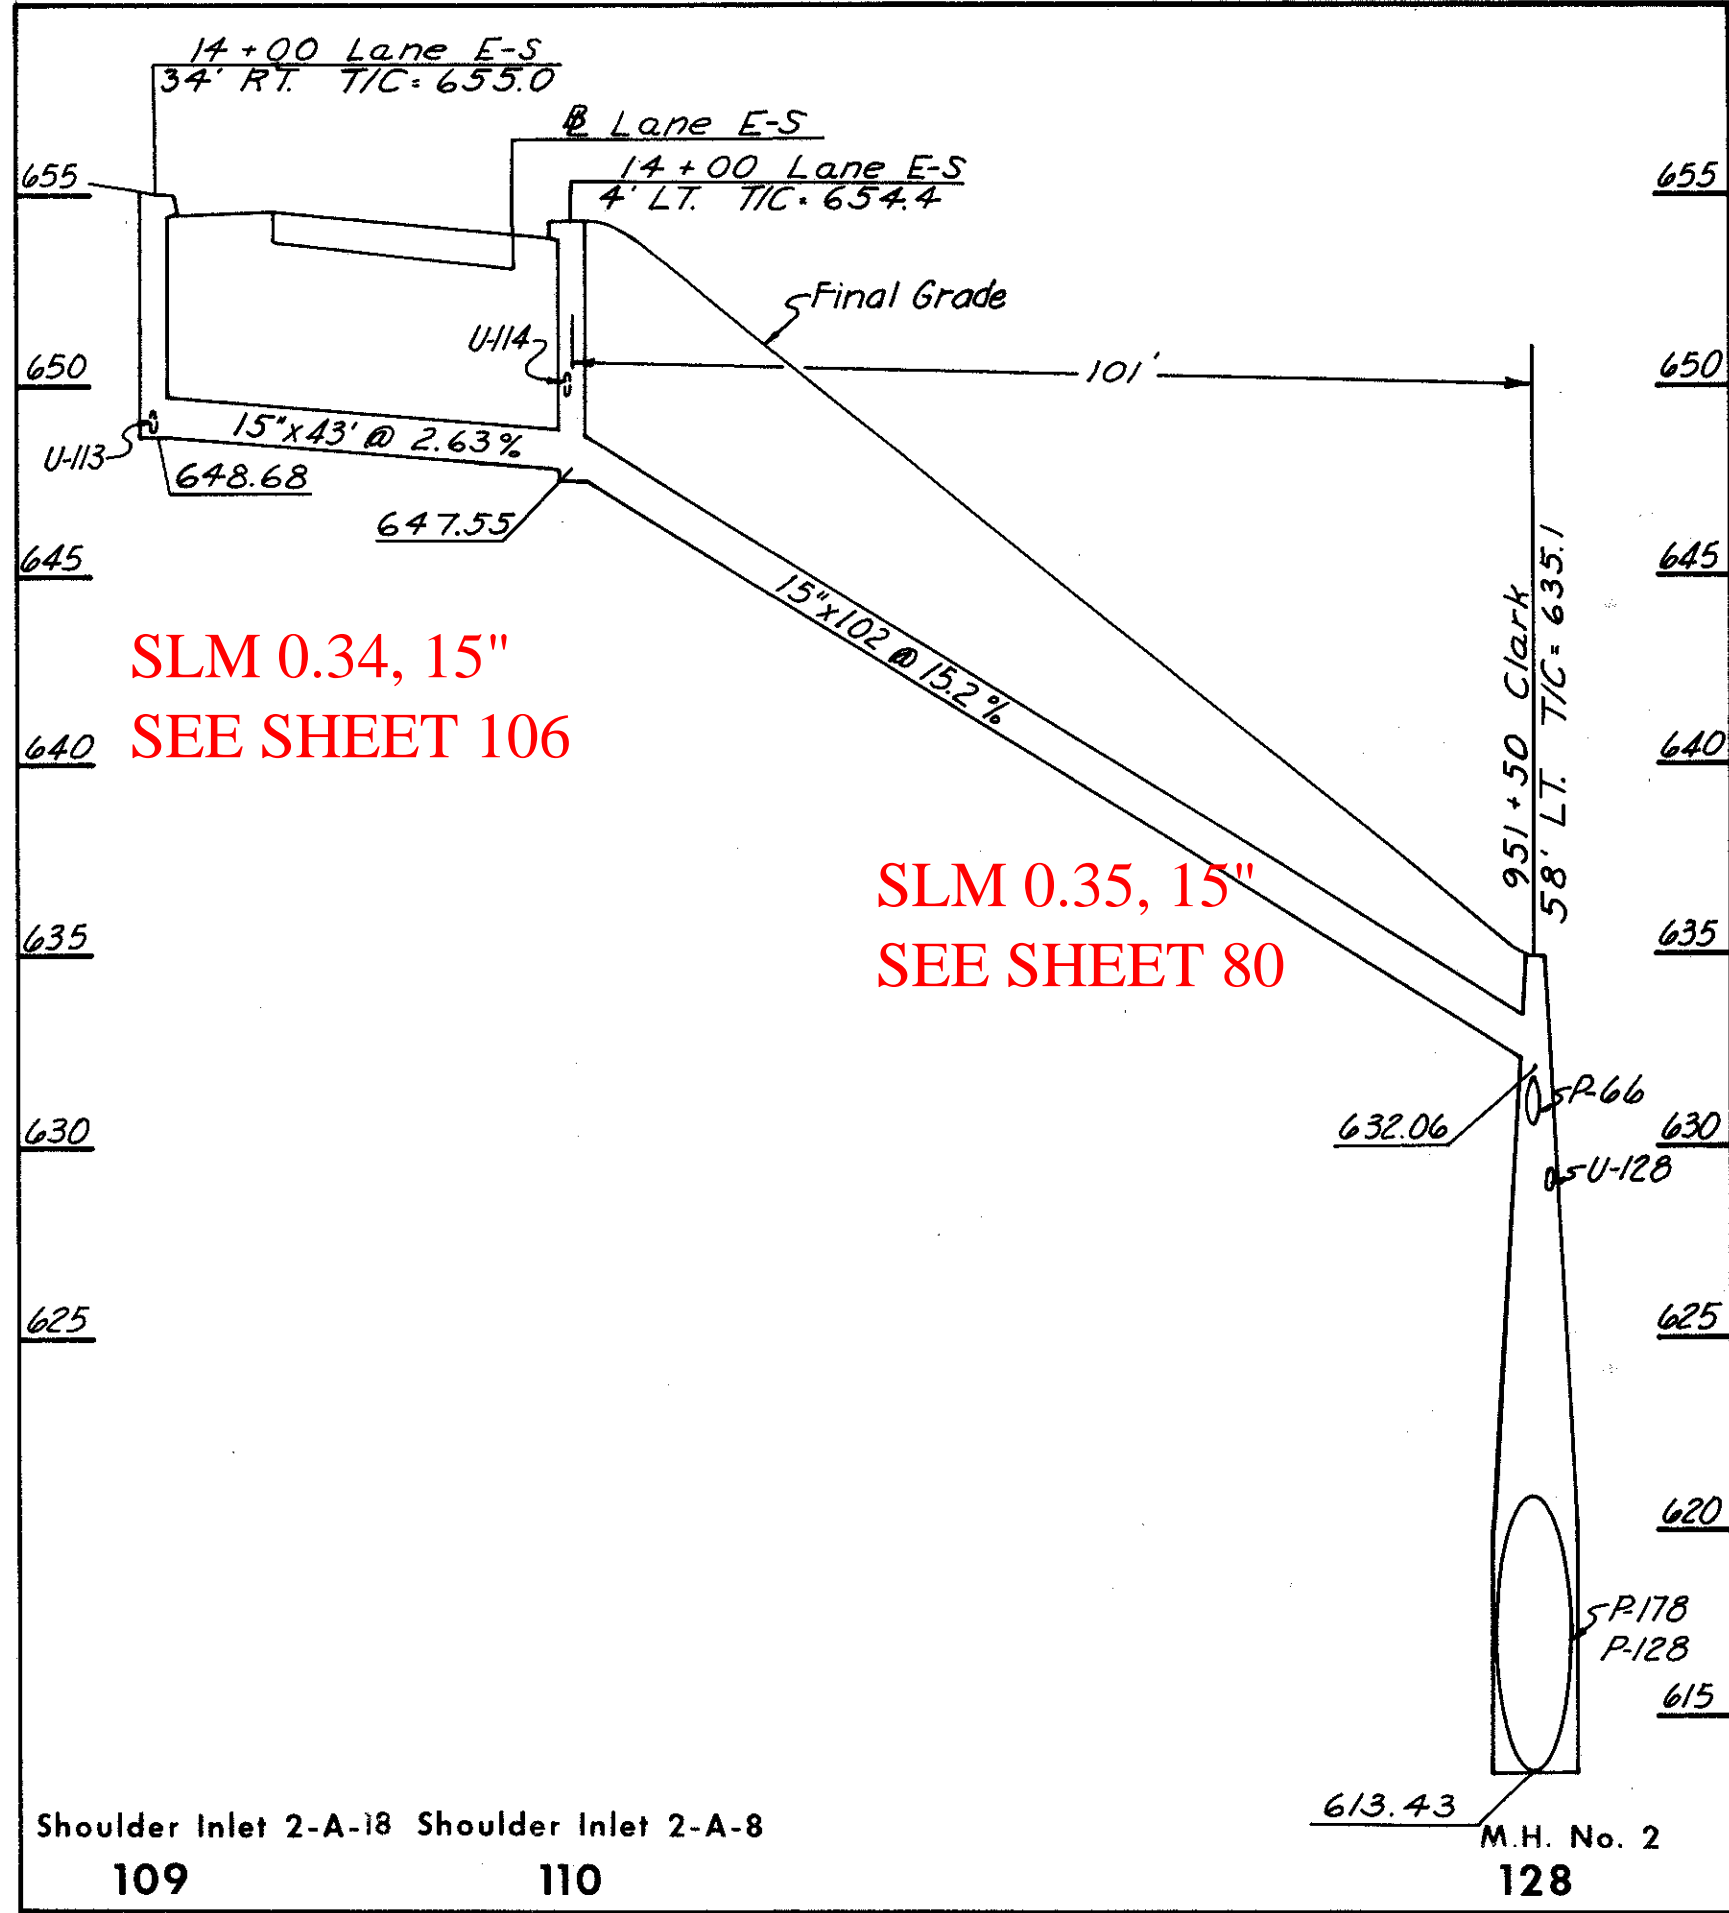


CUYAHOGA COUNTY
CITY OF CLEVELAND
MEDINA-CLARK INTERCHANGE
CUY-71-18.54
CUY-90-13.81

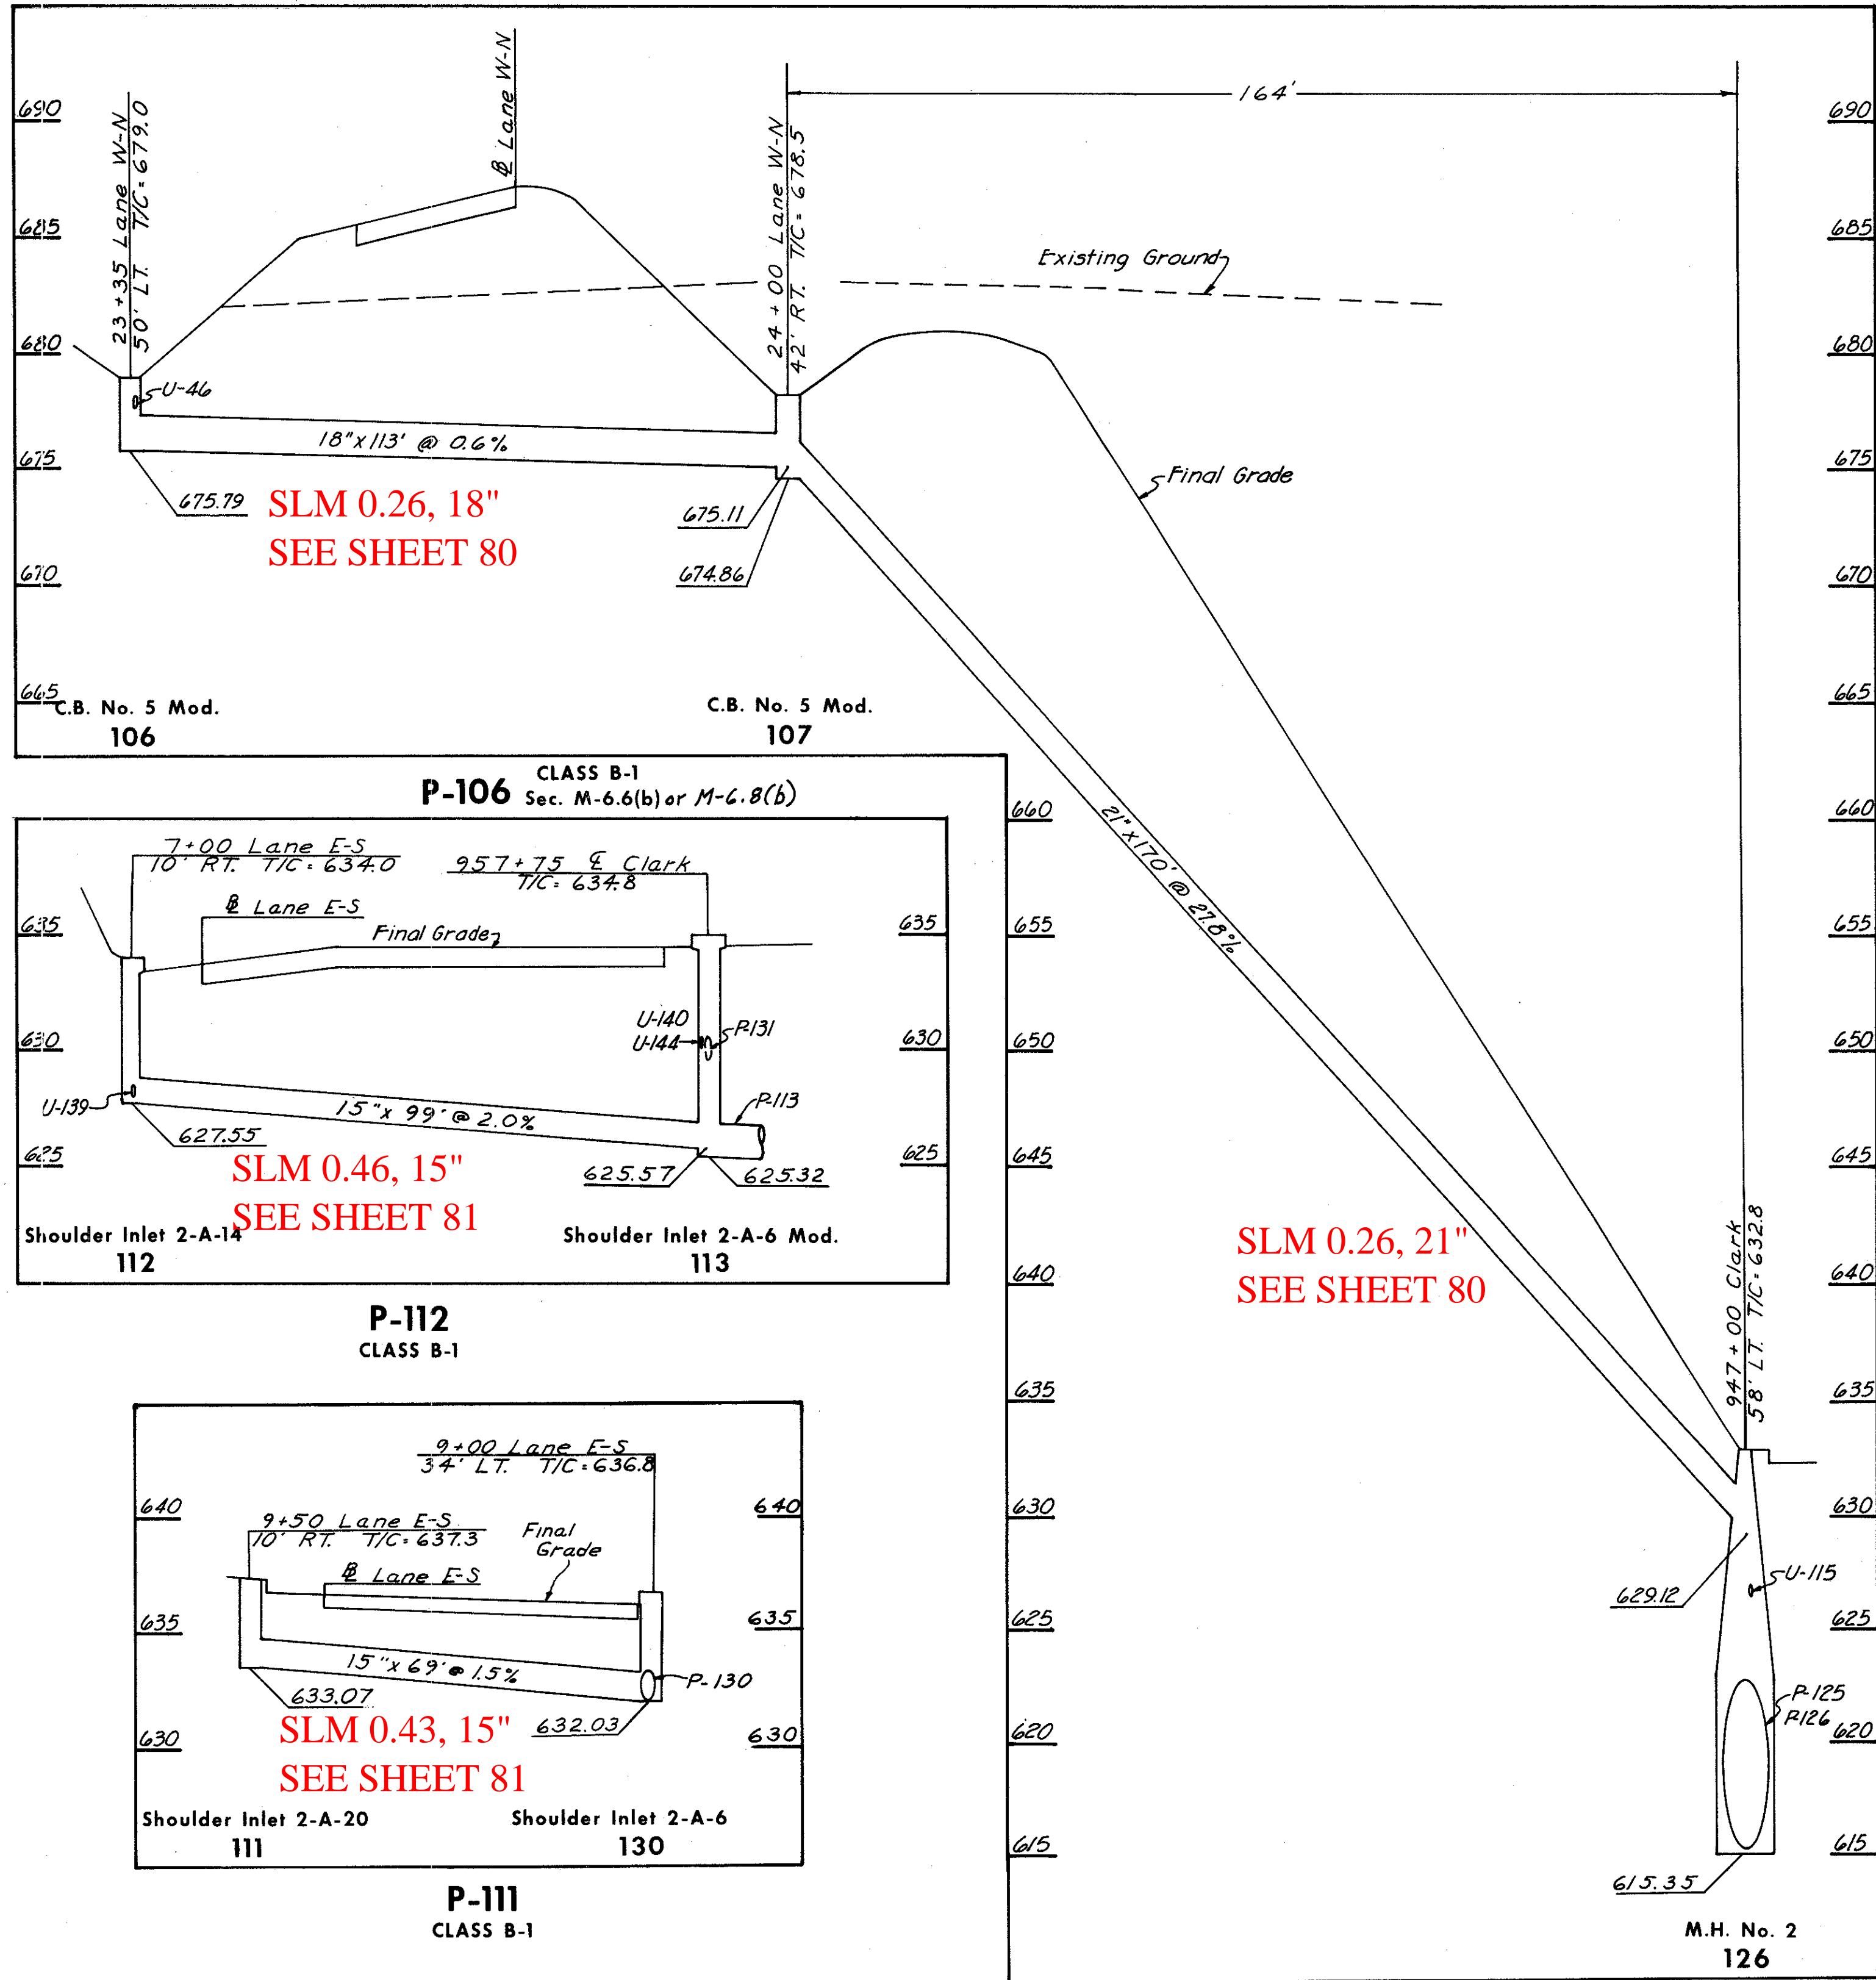

SLM 0.34, 15"
SEE SHEET 106

SLM 0.35, 15"
SEE SHEET 80

SLM 0.26, 21"
SEE SHEET 80

SLM 0.26, 18"
SEE SHEET 80

SLM 0.46, 15"
SEE SHEET 81

SLM 0.43, 15"
SEE SHEET 81

P-109 CLASS B-1 **P-110** CLASS E-1 **ESTIMATED QUANTITIES**

I-B STRUCTURES								
CODE	LOCATION	Shoulder Inlet 2-A-6	Shoulder Inlet 2-A-6 Mod.	Shoulder Inlet 2-A-8	Shoulder Inlet 2-A-14	Shoulder Inlet 2-A-18	Shoulder Inlet 2-A-20	C.B. 5 Mod.
106	23+35 Lane W-N 50' LT. *							1 *
107	24+00 Lane W-N 42' RT. *							1 *
109	14+00 Lane E-S 34' RT.					1		
110	14+00 Lane E-S 4' LT.			1				
111	9+50 Lane E-S 10' RT.						1	
112	7+00 Lane E-S 10' RT.				1			
113	957+75 Clark Freeway		1					
130	9+00 Lane E-S 34' LT.	1						
CUY-71-18.54 TOTALS		1	1	1	1	1	1	
CUY-90-13.81 TOTALS								2 *

I-1 PIPE #								
CODE	ROADWAY	INLET CODE		CLASS B-1	CLASS B-1 Sec. M-6.8(b) V.C.P.	CLASS B-1 Sec. M-6.8(b) Encased	CLASS E-1	CLASS B-1 Sec. M-6.8(b) V.C.P.
		FROM	TO	12"	12"	V.C.P. 12"	12"	15"
P-202	Wade Avenue	202	203	25" ✓	12" ✓			
P-203	Wade Avenue	203	204				12" ✓	
P-204	Wade Avenue	204	205				56" ✓	
P-205	Scranton Road	205	192	36" ✓				
P-206	Scranton Road	206	192	36" ✓				
P-217	Lane W-S	217	218	15" ✓				
P-218	Lane W-S	218	219					428" ✓
P-219	Lane W-S	219	210					65" ✓
P-222	Lane W-N *	222	81		223" ✓	191" ✓		
CUY-71-18.54 TOTALS				112" ✓			68" ✓	493" ✓
CUY-90-13.81 TOTALS					223" ✓	191" ✓		

* This Table shall be used with Pipe Items on sheet No. 109

P-106, P-107,
P-109 thru P-112
SEWER PROFILES