



CUYAHOGA COUNTY
CITY OF CLEVELAND
MEDINA-CLARK INTERCHANGE
CUY-71-18.54
CUY-90-13.81

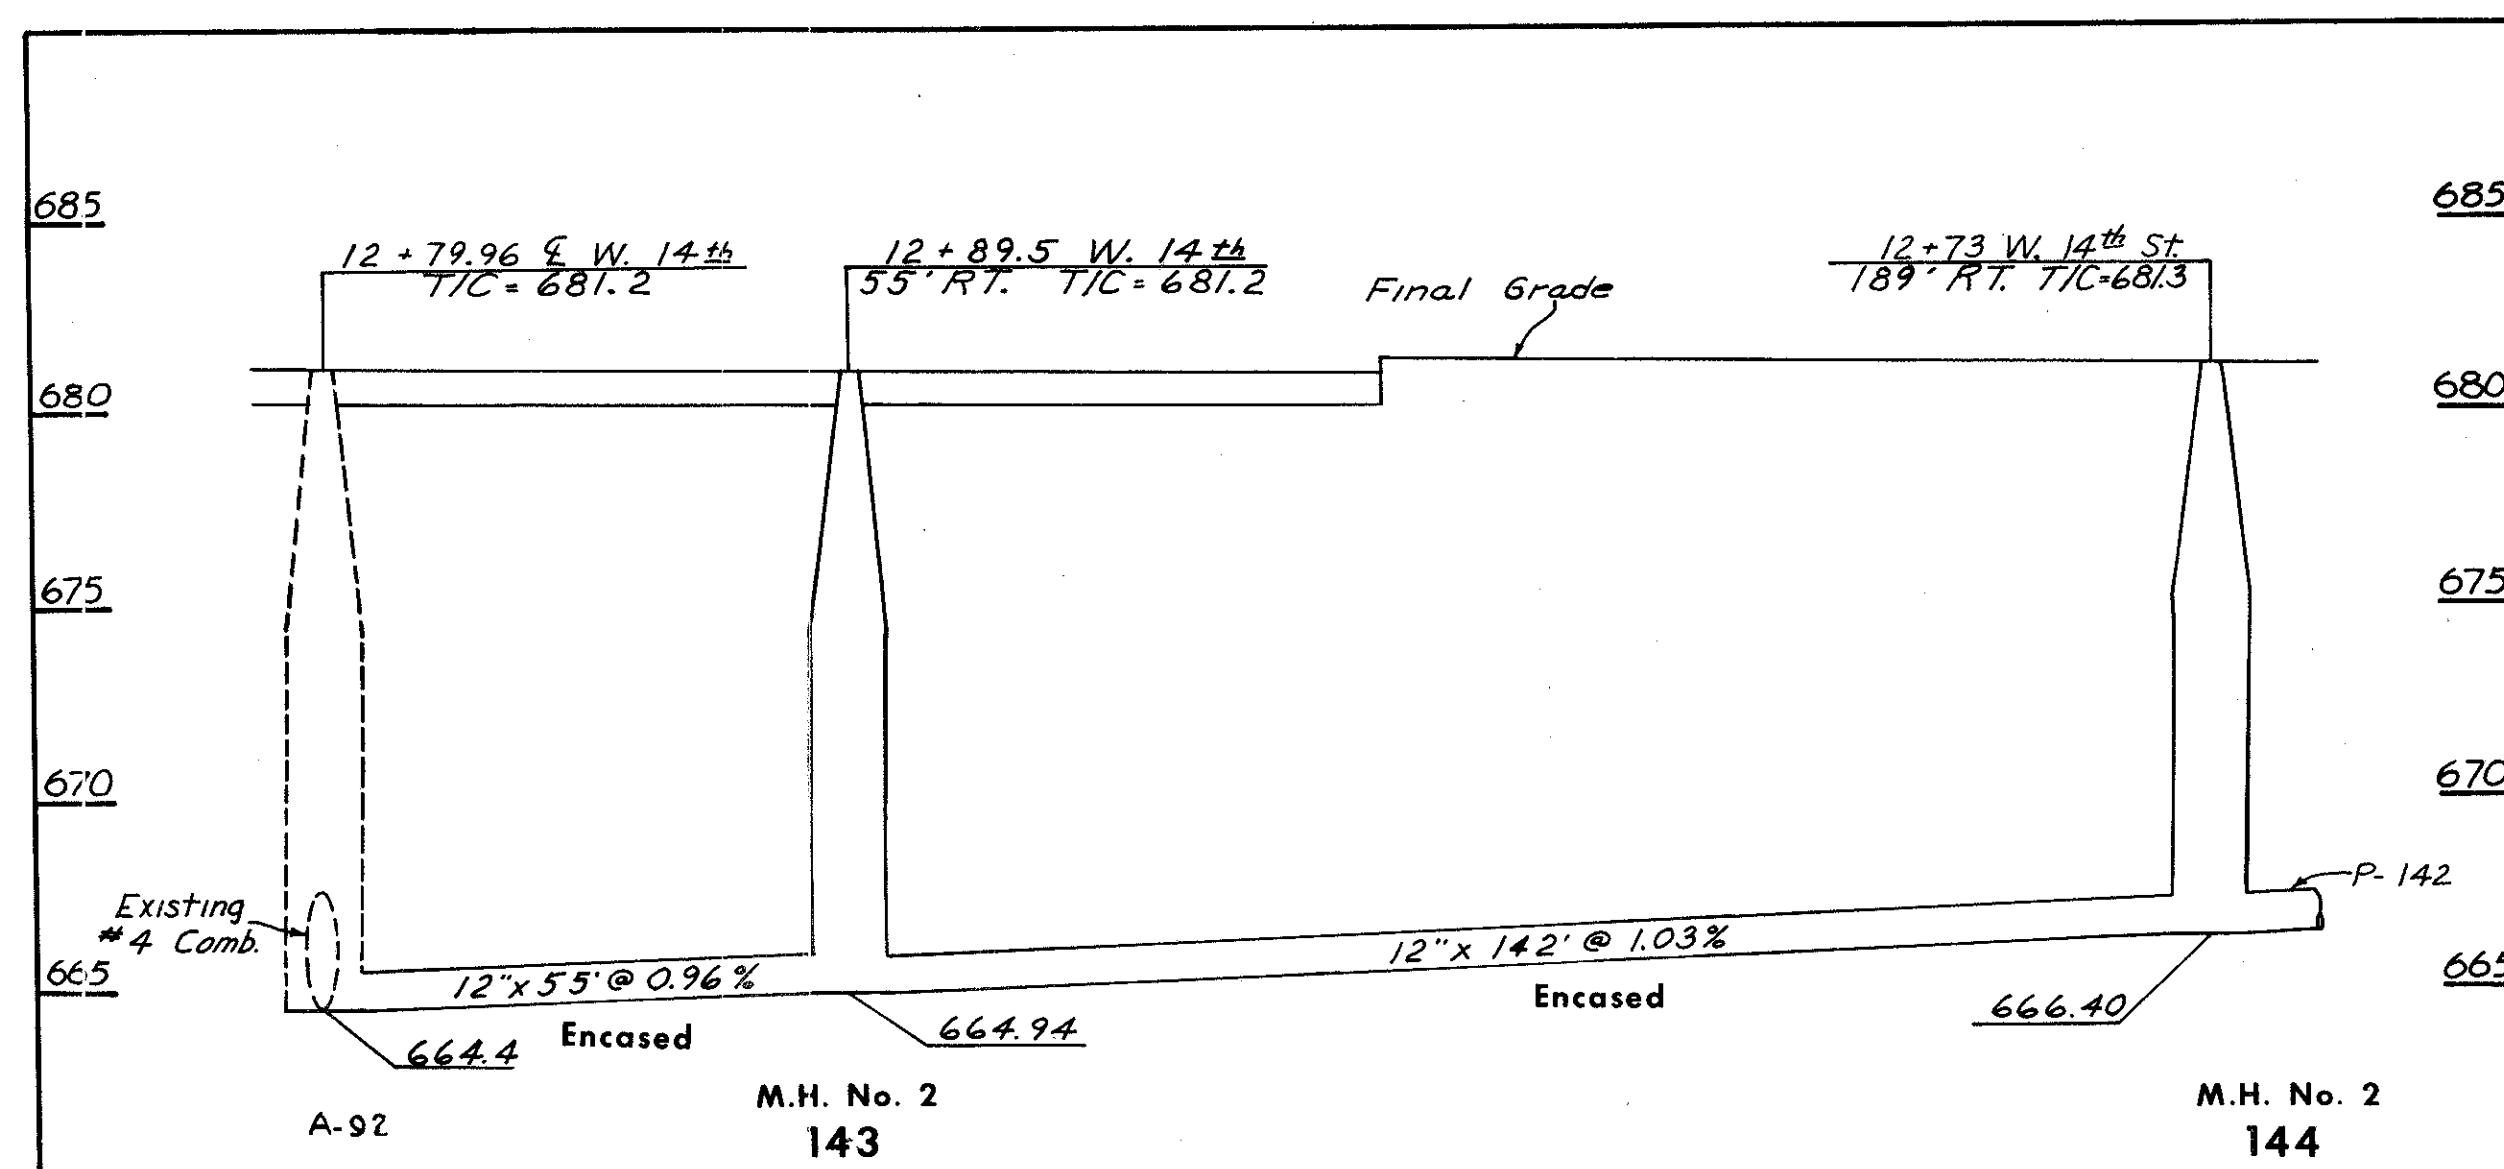


P-143
CLASS B-1
Sec. M-6.8 (b)

P-144
CLASS B-1
Sec. M-6.8 (b)

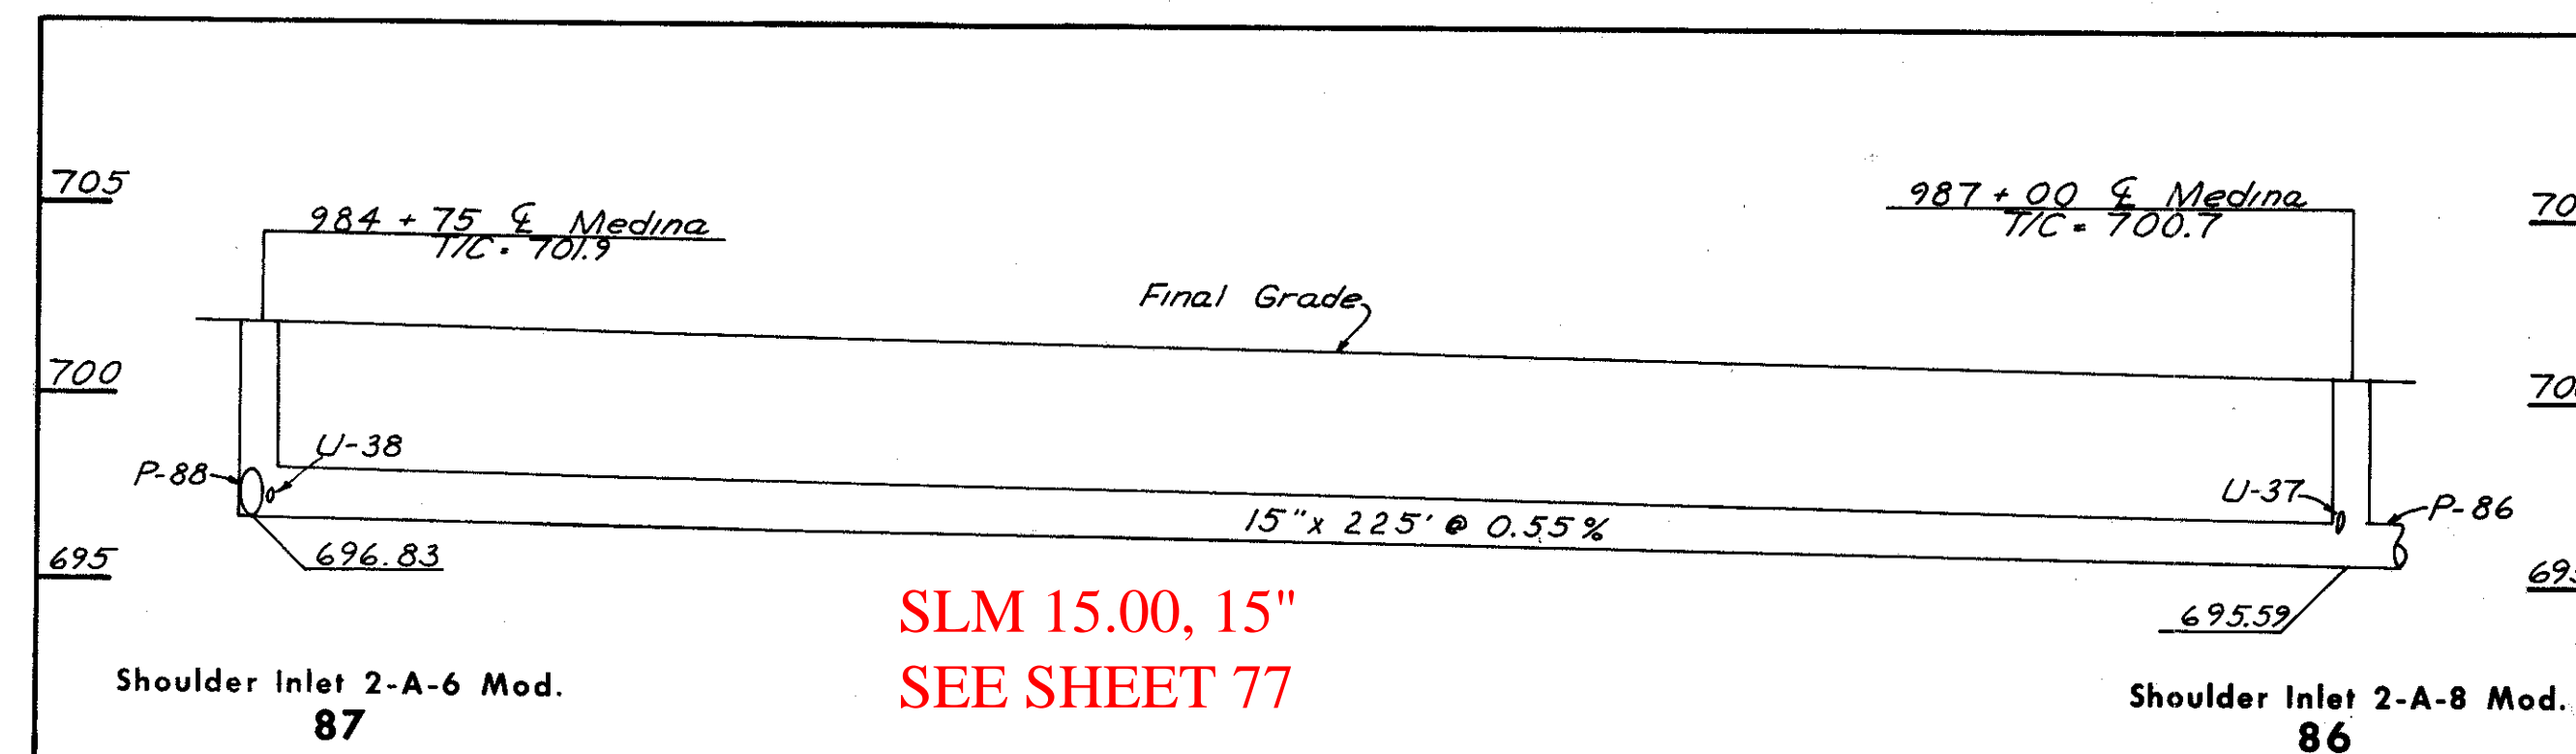


SLM 15.00, 15"
SEE SHEET 77

P-87
CLASS E-1

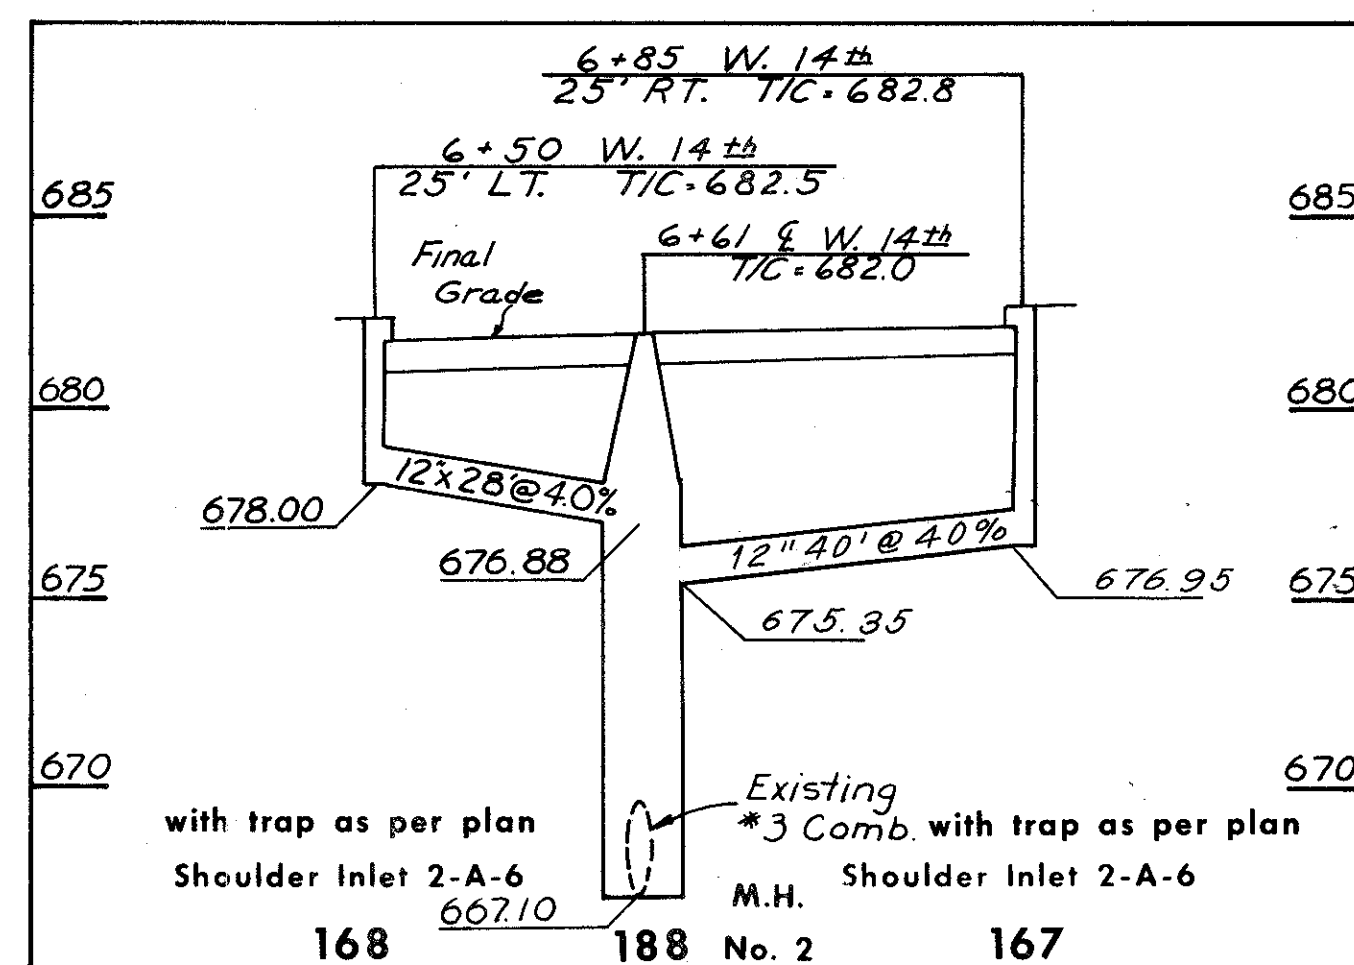

P-168
CLASS B-1

P-167
CLASS B-1

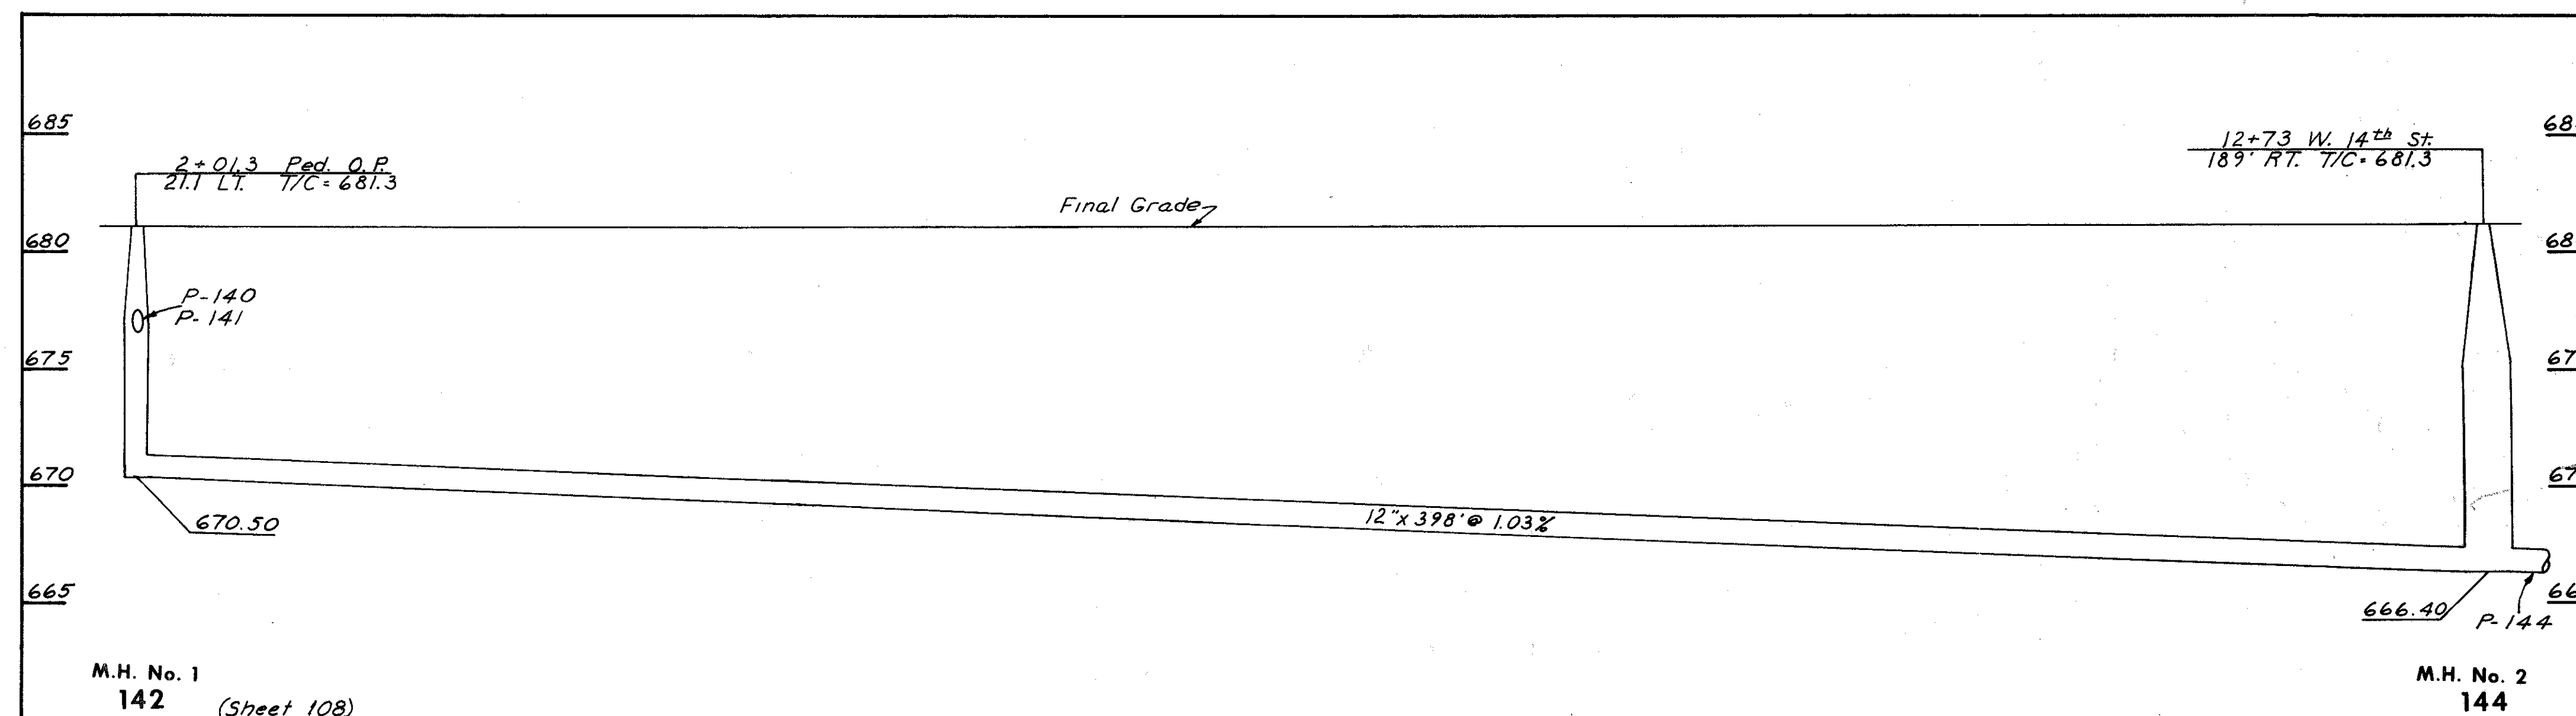

M.H. No. 1
142
(Sheet 108)

M.H. No. 2
144

ESTIMATED QUANTITIES

P-142
CLASS B-1
Sec. M-6.8 (b)

I-B STRUCTURES				
CODE	LOCATION	Shoulder	Shoulder	W/O Drop Pipe M.H. No. 2
		Inlet 2-A-6	Inlet 2-A-6 Mod.	
87	984+75 Medina Freeway	1 *	1 *	
143	12+89.5 W. 14th Street			1
144	12+73 W. 14th Street			1
167	6+85 W. 14th Street	1		
168	6+50 W. 14th Street	1		
CUY-71-18.54 TOTALS		2		2
CUY-90-13.81 TOTALS			1 *	

CODE	ROADWAY	INLET CODE		I-1 PIPE		
		FROM	TO	CLASS B-1 12"	CLASS B-1 Sec. M-6.8(b) V.C.P. 12"	CLASS E-1 Sec. M-6.8 (b) Encased V.C.P. - 12"
P-87	Medina Freeway *	87	86			225' *
P-142	W. 11th Street	142	144		398' ✓	
P-143	W. 14th Street	143	213			55' ✓
P-144	W. 14th Street	144	143			142' ✓
P-167	W. 14th Street	167	188	40' ✓		
P-168	W. 14th Street	168	188	28' ✓		
CUY-71-18.54 TOTALS				68' ✓	398' ✓	197' ✓
CUY-90-13.81 TOTALS						225' *

P-87,
P-142 thru P-144,
P-167 and P-168
SEWER PROFILES