
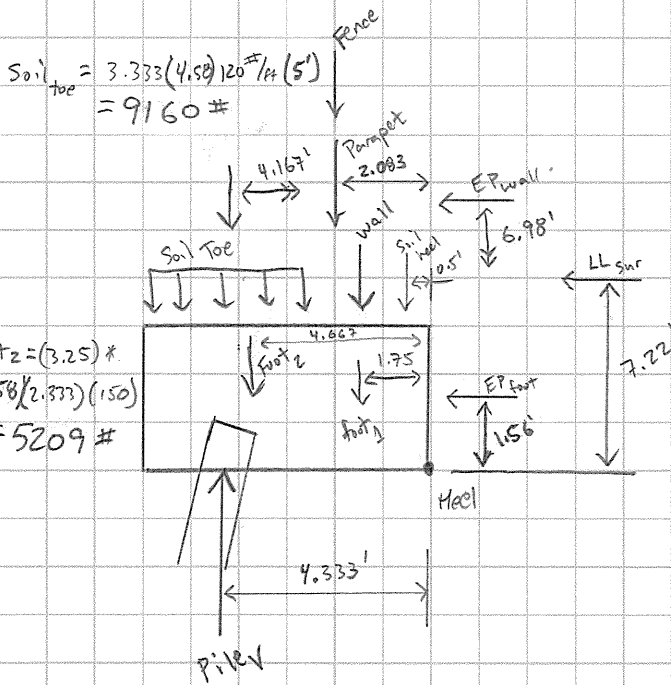


RFI 104


Reference RFI 95 calls for loading

Wing wall Pile # 19 was Driven out of Tolerance Enlarge Footing to Encompass Pile

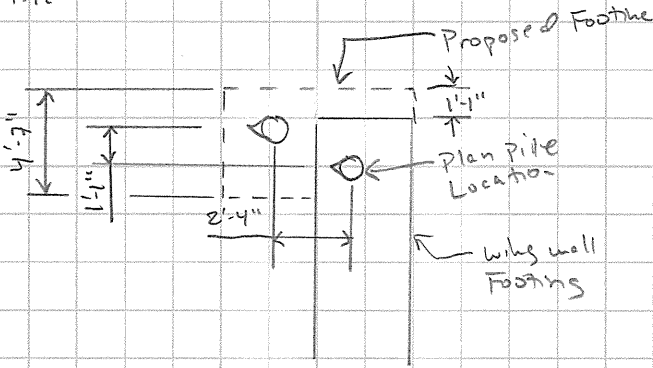

Punching Shear

(5.13.3.6.3)

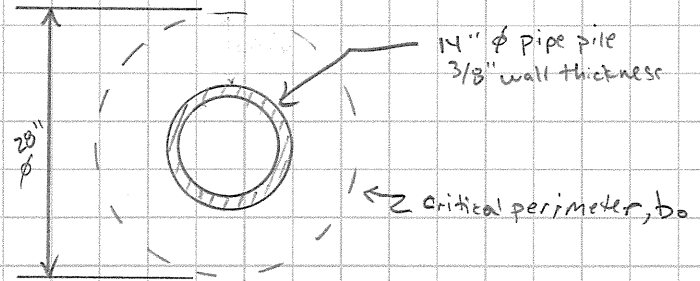

$$b_o = 11(28'') = 88''$$

$$d_v = 3.25' - 1' = 2.25' = 27''$$

$$\beta_c = 1.0$$

$$V_n = \left(0.063 + \frac{0.126}{\beta_c}\right) \sqrt{f'_c} b_o d_v \leq 0.126 \sqrt{f'_c} b_o d_v$$

$$V_n = \left(0.063 + \frac{0.126}{\beta_c}\right) \sqrt{f'_c} b_o d_v = \left(0.063 + \frac{0.126}{1}\right) \sqrt{4}(88)(27)$$

$$= 898 \text{ k}$$

$$\leq$$

$$V_n = 0.126 \sqrt{4}(88)(27) = 599 \text{ k} \leftarrow \text{controls}$$

$$\phi V_n = 0.9(599) = 539 \text{ k}$$

$$\text{Max pile load} = 125 \text{ k} \div \cos(14)$$

$$= 129 \text{ k}$$

$$129 < 539 \therefore \text{OK}$$



UNFACTORED FOOTING LOAD COMPONENTS

	Horiz. (kips)	Vert. (kips)	arm (ft)	Moment (kip-ft)
Dead Load				
Footing1		10.66	1.75	18.7
Footing2		5.21	4.67	24.3
Wall		24.01	1.75	42.0
Parapet		6.19	2.08	12.9
Fence		1.33	2.08	2.8
Sum Abut. D.L. =		47.4		100.6
Earth Loads				
DL Earth (toe)		9.16	4.17	38.2
DL Earth (heel)		8.39	0.50	4.2
Sum Vert. Earth =		17.6		42.4
Horiz. Earth Footing	10.41		1.56	16.2
Horiz. Earth Wall	19.51		6.98	136.2
LL Surcharge	10.16		7.22	73.4

Factored Load Summary

Load Factors

CASE	Horiz. (kip)	Vert. (kip)	Arm (ft)	Moment (kip-ft)	Limit State	DC	EH	EV	LS
1	29.92	64.95	4.55	295.4	Service 1	1.00	1.00	1.00	0.00
2	40.08	64.95	5.68	368.8	Service 1	1.00	1.00	1.00	1.00
3	26.93	82.94	3.86	320.2	Strength 1	1.25	0.90	1.35	0.00
4	44.71	82.94	5.41	448.6	Strength 1	1.25	0.90	1.35	1.75
5	62.66	60.21	8.14	489.9	Strength 1	0.90	1.50	1.00	1.75
6	62.66	82.94	6.51	540.0	Strength 1	1.25	1.50	1.35	1.75

Sum Moments about the Heel to find the Pile Vertical Demand

CASE	e (ft)	P _{vert} (kip)
1	4.33	68.18
2	4.33	85.11
3	4.33	73.89
4	4.33	103.52
5	4.33	113.07
6	4.33	124.63

<< Controls

4 to 1 Pile batter = 14°

UBV = 124.63 / cos(14°) / 0.7 = 183.49 kips

Pile 19 was driven to the plan UBV of 322 k therefore OK



Made	KDG	Date	9/10/2011	Job Number	49633
Checked	BTA	Date	9/12/2011		
Backchk'd	KDG	Date	9/13/2011	Sheet No.	

For **Cleveland Innerbelt**

Reinforcing Design for Walls & Footing

Basic Equations for Flexure

Factored Flexural Resistance,

$$M_r = \phi M_n \quad 5.7.3.2.1-1$$

where ϕ is 0.90 for flexure in R.C. 5.5.4.2.1

For rectangular section with mild reinforcing only,

$$M_n = A_s f_y (d_s - a/2) \quad 5.7.3.2.2-1$$

for which

$$a = \beta_1 c$$

c = distance between neutral axis and compression face

β_1 = stress block factor

a = depth of equiv. stress block

for $f'_c = 4.0$ ksi, $\beta_1 = 0.85$

For rectangular section with tension reinforcing only,

$$c = A_s f_y / 0.85 f'_c \beta_1 b \quad 5.7.3.1.2-4$$

Basic Eqtns for Shear

Factored Flexural Resistance,

$$V_r = \phi V_n \quad 5.8.2.1-2$$

where ϕ is 0.90 for shear & torsion in R.C. 5.5.4.2.1

For rectangular section with mild reinforcing only,

$$V_n = V_c + V_s \quad 5.8.3.3-1$$

but not greater than: $0.25 f'_c b_v d_v$ 5.8.3.3-2

(Note: for walls and footings, it is preferred to proportion the concrete section to have adequate shear resistance without shear reinforcing.)

$$V_c = 0.0316 \times \beta (f'_c)^{0.5} b_v d_v \quad 5.8.3.3-3$$

for which

$$\beta = 2.0 \quad 5.8.3.4.1$$

b_v = effective width of concrete

d_v = effective shear depth

Reinforcement Design

Try → **10** # **6** bars

$$A_{s,prov'd} = 4.40 \text{ in.}^2$$

$$d_s = 31.00 \text{ in.}$$

(3 in. bottom clear with #5 & #8 stirrup)

$$b = 48.00 \text{ in.}$$

$$c = 1.90 \text{ in.} \quad 5.7.3.1.2-4$$

$$a = 1.62 \text{ in.}$$

$$M_r = 597.8 \text{ ft-kips} \quad 5.7.3.2.1-1$$

598 > 540 **O.K.**

$$V_c = 188.1 \text{ kips} \quad 5.8.3.3-3$$

$$\text{Max } V_n = 1488.0 \text{ kips} \quad 5.8.3.3-2$$

$$V_r = 169.3 \text{ kips} \quad 5.8.3.3-1$$

169 > 125/cos(14) **O.K.**

USE: 10 - #6 bars horizontally in top & btm. of footing
#5 stirrups at 12"

Shrinkage & Temperature Steel - Footing


$$A_{s(min.)} = 0.23 \text{ in.}^2 / \text{ft} \quad 5.10.8.1$$

Use # **5** bars @ **12.00** in.



$$A_{s,prov'd} = 0.31 \text{ in.}^2 / \text{ft}$$

O.K.

USE: #5 bars @12 inches in faces of footing

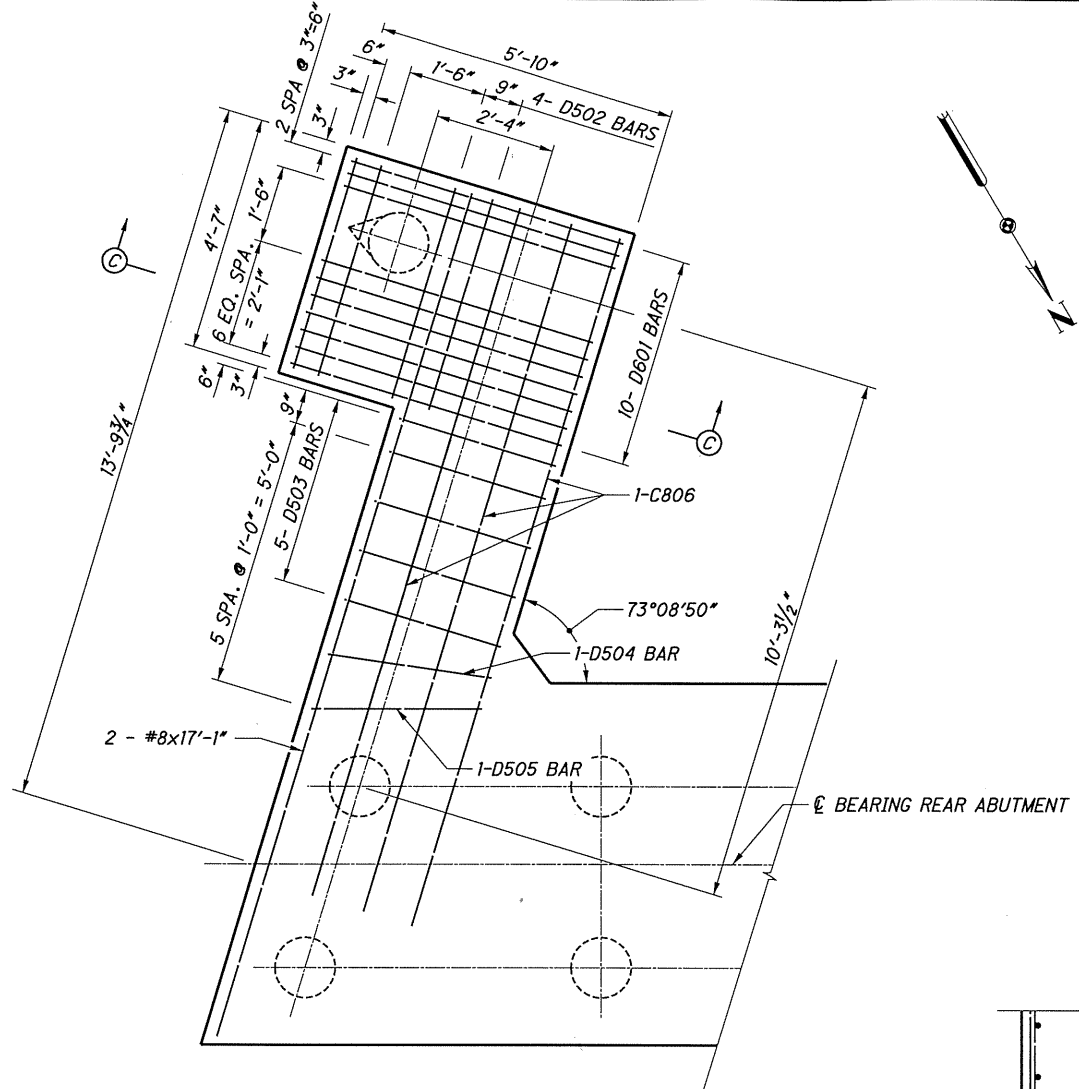



PART PLAN BRIDGE 13 REAR ABUTMENT
RIGHT WINGWALL FOOTING

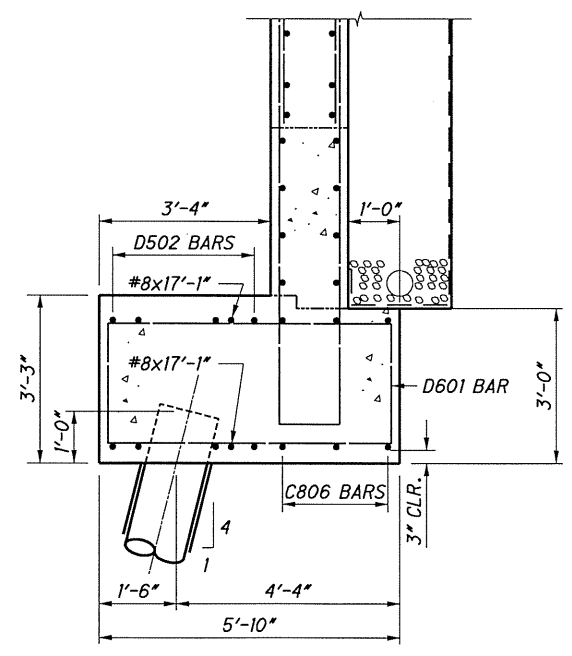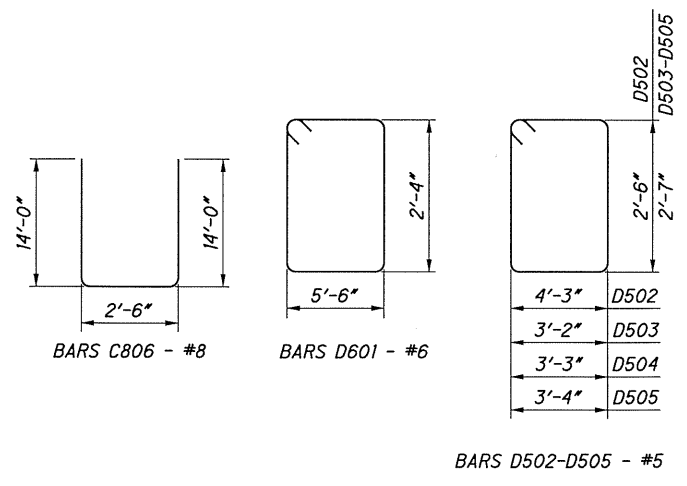

SECTION C-C

For Bridge 13 Wingwall Pile	Job no. 49633	Sheet no. 1
Made by ED Graust	Checked by BTA	Backchecked by
Date 9-1-11	Date 9/2/11	Date

Assume Everything from half way between the Abut. and wingwall pile to the end of the wing wall Acts on the wing wall pile.

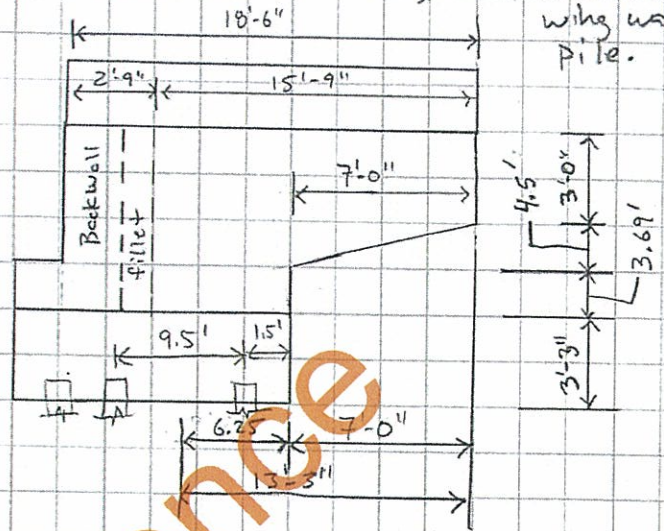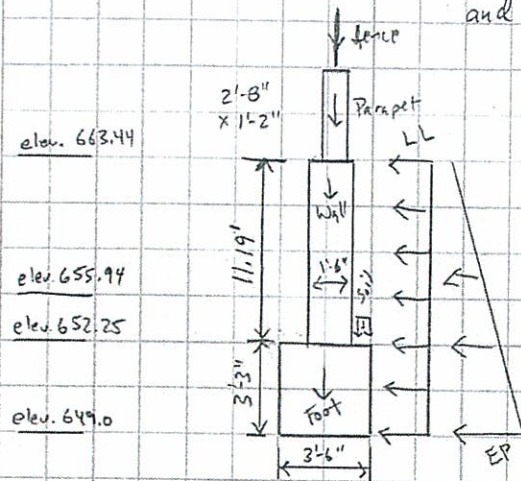

Vertical

$$\downarrow \text{Foot} = (3.25)(3.5)(6.25)(150) = 10,664 \#$$

$$\downarrow \text{Wall} = \left[(11.19)(1.5)(13.25) - (7)(1.5)(4.50 \frac{1}{2}) - 3.69(7)(1.5) \right] (150) = 24,005 \#$$

$$\downarrow \text{Parapet} = 2.667(1.167)(13.25)(150) = 6,180 \#$$

$$\downarrow \text{Fence} = 13.25(100 \#/\text{ft}) = 1,325 \#$$

$$\downarrow \text{Soil on Foot} = (1')(11.19)(6.25)(120 \#/\text{ft}^2) = 8,393 \#$$

$$\text{Total Vertical} = \downarrow 50,573 \#$$

Horizontal

Active EP: $K_a = \tan^2(45 - \frac{30}{2}) = 0.33$; $\sigma_a = 0.33(120) = 40 \#/\text{ft}^2$

$$\leftarrow \text{LL surcharge} = 2'(40 \#/\text{ft}^2)(11.19 + 3.25)(6.25) + 2(40)(3 + \frac{4.5}{2})(7) = 10,160 \#$$


$$\leftarrow \text{EP}_{\text{Foot}} = \frac{1}{2}(11.19(40) + (11.19 + 3.25)(40))(3.25)(6.25) = 10,412 \#$$

$$\leftarrow \text{EP}_{\text{Wall}} = \frac{1}{2}(40)(11.19)(11.19)(6.25) + \frac{1}{2}(40)(3 + \frac{4.50}{2})(3 + \frac{4.50}{2})(7) = 19,511 \#$$

$$\text{Total Horizontal} = 40,083 \# \leftarrow$$

KFI 95

For BL 13 w. lg wall Pile	Job no. 49633	Sheet no. 2
Made by EDG	Checked by BTA	Backchecked by
Date 9-6-11	Date 9/6/11	Date

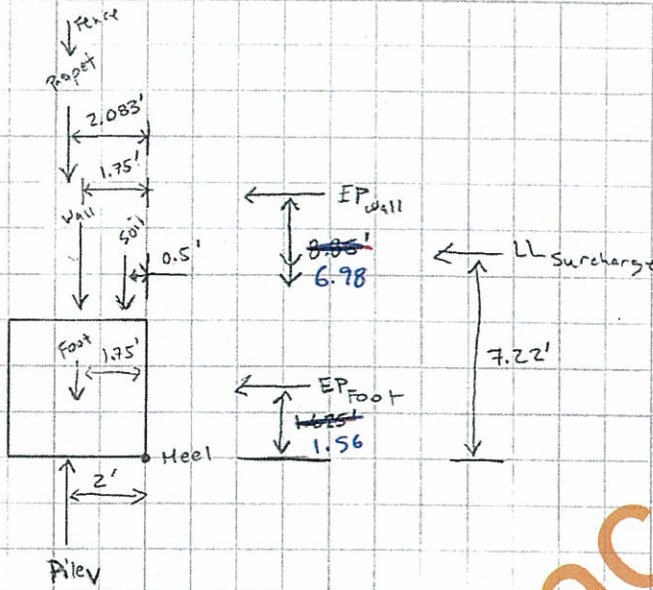

$$\sum \text{Moment about Heel} = 0 = (-10664 - 24005)(1.75) - (6186 + 1325)(2.083) - 8393(0.5) + Pile_y(2) + (-19511)(\frac{8.85}{6.98}) + (-10412)(\frac{1.625}{1.56}) + (-10160)(7.22)$$

$$Pile_y = \frac{343,460}{306,297} \div 2' = \frac{172}{153} \text{ K}$$

$$Pile_{result} = 153 \text{ K} / \cos 14^\circ = 158 \text{ K}$$

$$\frac{172}{158} \div 0.7 = \frac{246}{225} \text{ K} \quad \begin{matrix} \text{UBV} \\ \text{URV} \end{matrix}$$

For Reference