

FOR: Pier 11 - RFI 228	JOB NO: 49633	SHEET NO:
MADE BY: LER	CHECKED BY: KDG	BACKCHECKED BY:
DATE: 1/30/12	DATE: 1/31/12	DATE:

HNTB

Issue

Note on sheet 16/90 states that concrete for second pour (above hor. c.j.) shall not be placed until the concrete in the first pour reaches 100% of its 28-day comp. strength.

The contractor would like to release the forms for the first pour and place the second pour the following day. Per ST-01.12, forms shall not be released prior to concrete reaching 85% of its 28-day strength.

Per Joel Halterman of Walsh, 85% f'c has been reached within 10 to 12 days on this project. Placement of pour 2 would then occur on day 11 to 13.

Evaluate impact of proposed change in const. sequence/timing on following items:

- (1) Flexural strength at time of P2 placement
- (2) Shear strength at time of P2 placement
- (3) Differential shrinkage

(1) Flexural Strength

Evaluate interim condition P1+P2 using $0.85f'_c$.

$$0.85f'_c = 3400 \text{ psi}$$

See attach calculations.

Design sections 1, 2, and 3 are satisfactory for strength, and crack control.

No Δ's Required

(5) Shear Strength

Shear strength of concrete section still exceeds the factored shear load. Verify min. steel requirements.

$$A/s_{min} = 0.0316 \sqrt{f'_c} \frac{b_v}{f_y}$$

$$b_v = 144 \text{ in}$$

$$f_y = 60 \text{ ksi}$$

$$A/s_{min} = 0.0314 \sqrt{3.4} \frac{144}{60}$$

$$= 0.139 \text{ in}^2/\text{in}$$

This is less than the calculated value based on $f'_c = 4 \text{ ksi}$. The section is ∴ satisfactory for shear.

No Δ's Required

FOR: Pier 11 - RFI 228	JOB NO: 49033	SHEET NO:
MADE BY: LER	CHECKED BY: KDG	BACKCHECKED BY:
DATE: 1/30/12	DATE: 1/31/12	DATE:

HNTB

B) Shrinkage

Differential shrinkage calculations were based on a time lapse of 21 days between placement of P1 and P2. With the proposed change in sequence/timing, this time lapse is reduced to \approx 13 days. This will result in a corresponding decrease in differential shrinkage forces within the capbeam and columns. The forces based on the original analysis are therefore conservative.

The pier is \therefore satisfactory for differential shrinkage forces.

No Δ 's Required

For	Cleveland - Pier 11 Cap Beam	Job No.	49633	Sheet No.
Made by	LER	Checked by	KPG	Backchecked by
Date	11/2/11	Date	10/12	Date

SECTION 1 - P1 + P2

Section Geometry

Width:	b = 144.000 in	$I_g = 35831808 \text{ in}^4$																					
Total Depth (inc. red. for wear):	D = 144.000 in	$f_{cr} = 682 \text{ psi}$	(LRFD AASHTO 5.4.2.6)																				
Cover Prim. Bar:	$c_p = 0.875 \text{ in}$	$1.2 * M_{cr} = 407435301 \text{ lb-in}$																					
Cover on Sec. Bar:	$c_s = 2.000 \text{ in}$	x = 26.70 in																					
Side Cover:	$c_{side} = 3.000 \text{ in}$	$\beta = 0.85$																					
Stirrups/Outer Bar:	#6 bar	$d_{stirrup} = 0.750 \text{ in}$																					
		$A_{stirrup} = 0.440 \text{ in}^2$																					
Primary Bars:	<table border="1"> <thead> <tr> <th>Layer</th> <th>No. Bars</th> <th>Size</th> <th>Layer Spa.</th> <th>No./Bundle</th> </tr> </thead> <tbody> <tr> <td>Layer 1</td> <td>32.00</td> <td>#11</td> <td></td> <td>2</td> </tr> <tr> <td>Layer 2</td> <td></td> <td>#11</td> <td></td> <td></td> </tr> <tr> <td>Layer 3</td> <td></td> <td>#11</td> <td></td> <td></td> </tr> </tbody> </table>	Layer	No. Bars	Size	Layer Spa.	No./Bundle	Layer 1	32.00	#11		2	Layer 2		#11			Layer 3		#11			No. Leges for Shear = 2	No. Leges for Torsion = 2
Layer	No. Bars	Size	Layer Spa.	No./Bundle																			
Layer 1	32.00	#11		2																			
Layer 2		#11																					
Layer 3		#11																					
Secondary Bars:	18.00 #11		$d_v = 137.37 \text{ in}$																				
Eff. Depth for Primary Bars:	d = 140.97 in	$A_s = 49.920 \text{ in}^2$	$d_s = 1.410 \text{ in}$																				
Eff. Depth for Secondary Bars:	d' = 3.455 in	$A'_s = 28.080 \text{ in}^2$	$d'_s = 1.410 \text{ in}$																				

Materials

Concrete Compression Strength:	$f'_c = 3400 \text{ psi}$
Concrete Modulus of Elasticity:	$E_c = 3323600 \text{ psi}$
Modular Ratio:	n = 9
Reinforcing Yield Strength:	$f_y = 60000 \text{ psi}$
Reinforcing Modulus of Elasticity:	$E_s = 29000 \text{ ksi}$
Crack Width Parameter:	$\gamma = 0.75 \text{ k/in}$

Resistance Factors

Flexure and Tension:	$\phi = 0.90$ *
Shear and Torsion:	$\phi = 0.90$

Loads

$M_u = 21600 \text{ k-ft}$
$M_s = 17280 \text{ k-ft}$
$V_u = 0.0 \text{ kip}$
$T_u = 0.0 \text{ kip}$

Flexure - Strength

Analyze as Doubly Reinforced (Y/N): n

Flexural Strength:

$R_n = 100.65 \text{ psi}$	$A_s F_y = 2995200 \text{ lb}$
m = 20.76	a = 7.20 in
$\rho = 0.0017$	$\phi M_n = 30858 \text{ kip-ft}$
$A_{s_req} = 34.51 \text{ in}^2$	OK

Minimum Steel:

$R_n = 158.21 \text{ psi}$	$4/3R_n = 134$
m = 20.76	m = 20.76
$\rho_{min,1} = 0.0027$	$\rho_{min,2} = 0.0023$
$A_{s_min1} = 54.81 \text{ in}^2$	$A_{s_min2} = 46.69 \text{ in}^2$
	OK

Maximum Steel:

*The maximum steel requirement has been removed. This provision is compensated for by adjusting the resistance factor based on whether the section is tension controlled, compression controlled, or in transition. A section is tension controlled if $c/d \leq 0.375$ and $\phi = 0.90$

$c = a/\beta = 8.47 \text{ in}$
$c/d = 0.06 < 0.375$, Tension Controlled
(Use this for single and double reinforcement)

Flexure - Crack Control

$f_s = 31.45 \text{ ksi}$	
$f_c = 0.82$	
$d_c = 3.035 \text{ in}$	
$\beta_s = 1.031$	
$s_{max} = 10.12 \text{ in}$	
$s_{prov} = 9.01 \text{ in}$	OK

$\rightarrow \text{actual } s \approx 10.5''$

Shear and Torsion

$A_{cp} = 20736 \text{ in}^2$	$A_v = 0.88 \text{ in}^2$
$P_{cp} = 576 \text{ in}$	$A_t = 0.44 \text{ in}^2$
$A_{oh} = 19266 \text{ in}^2$	$p_n = 555 \text{ in}$
$A_o = 16376 \text{ in}^2$	
$V_c = 2306.8 \text{ kip}$	
$\phi V_c = 2076.1 \text{ kip}$	No Shear Rein. Reqd.
$T_{cr} = 12800 \text{ kip-ft}$	No Torsional Rein. Reqd.

$(A_v/s) = 0.000 \text{ in}^2/\text{in}/n\text{-legs}$
$(A_t/s) = 0.000 \text{ in}^2/\text{in}/\text{leg}$
$0.00 \text{ in}^2/\text{in}/2\text{legs}$

$s_{req} = \#DIV/0! \text{ in}$	
$s_{min} = 6.29 \text{ in}$	(AASHTO 5.8.2.5)
$s_{max,v} = 24 \text{ in}$	(AASHTO 5.8.2.7)
$s_{max,t} = 12 \text{ in}$	

For	Cleveland - Pier 11 Cap Beam	Job No.	49633	Sheet No.	
Made by	LER	Checked by	KDG	Backchecked by	
Date	11/2/11	Date	10/12	Date	

SECTION 2 - P1 + P2

Section Geometry

Width:	b = 144.000 in	$I_g = 7112448 \text{ in}^4$	
Total Depth (inc. red. for wear):	D = 84.000 in	$f_{cr} = 682 \text{ psi}$	(LRFD AASHTO 5.4.2.6)
Cover Prim. Bar:	$c_p = 2.000 \text{ in}$	$1.2^*M_{cr} = 138641179 \text{ lb-in}$	
Cover on Sec. Bar:	$c_s = 2.000 \text{ in}$	x = 28.50 in	
Side Cover:	$c_{side} = 3.000 \text{ in}$	$\beta = 0.85$	
Stirrups/Outer Bar:	#6 bar	$d_{stirrup} = 0.750 \text{ in}$	
		$A_{stirrup} = 0.440 \text{ in}^2$	
Primary Bars:		No. Legs for Shear = 2	
Layer 1	44.00 #11	No. Legs for Torsion = 2	
Layer 2	44.00 #11		
Layer 3	#11	$d_v = 68.26 \text{ in}$	
Secondary Bars:	18.00 #11		
Eff. Depth for Primary Bars:	d = 75.84 in	$A_s = 137.280 \text{ in}^2$	$d_s = 1.410 \text{ in}$
Eff. Depth for Secondary Bars:	d' = 3.455 in	$A_s' = 28.080 \text{ in}^2$	$d_s' = 1.410 \text{ in}$

Materials

Concrete Compression Strength:	$f_c' = 3400 \text{ psi}$
Concrete Modulus of Elasticity:	$E_c = 3323600 \text{ psi}$
Modular Ratio:	n = 9
Reinforcing Yield Strength:	$f_y = 60000 \text{ psi}$
Reinforcing Modulus of Elasticity:	$E_s = 29000 \text{ ksi}$
Crack Width Parameter:	$\gamma = 0.75 \text{ k/in}$

Resistance Factors

Flexure and Tension:	$\phi = 0.90$ *
Shear and Torsion:	$\phi = 0.90$

Loads

$M_u = 8795 \text{ k-ft}$
$M_s = 7035 \text{ k-ft}$
$V_u = 0.0 \text{ kip}$
$T_u = 0.0 \text{ kip}$

Flexure - Strength

Analyze as Doubly Reinforced (Y/N): n

Flexural Strength:

$R_n = 141.58 \text{ psi}$	$A_s F_y = 8236800 \text{ lb}$
m = 20.76	a = 19.79 in
$\rho = 0.0024$	$\phi M_n = 40738 \text{ kip-ft}$
$A_{s_req} = 26.21 \text{ in}^2$	OK

Minimum Steel:

$R_n = 185.99 \text{ psi}$	$4/3R_n = 189$
m = 20.76	m = 20.76
$\rho_{min,1} = 0.0032$	$\rho_{min,2} = 0.0033$
$A_{s_min1} = 34.95 \text{ in}^2$	$A_{s_min2} = 36.04 \text{ in}^2$

OK

Maximum Steel:

*The maximum steel requirement has been removed. This provision is compensated for by adjusting the resistance factor based on whether the section is tension controlled, compression controlled, or in transition. A section is tension controlled if $c/d \leq 0.375$ and $\phi = 0.90$

c = a/ β = 23.28 in
c/d = 0.31 ≤ 0.375, Tension Controlled

(Use this for single and double reinforcement)

Flexure - Crack Control

$f_s = 9.27 \text{ ksi}$
$f_c = 0.62$
$d_c = 4.16 \text{ in}$
$\beta_s = 1.074$
$s_{max} = 44.39 \text{ in}$
$s_{prov} = 6.43 \text{ in}$ OK

\rightarrow actual $s \approx 6.5''$

Shear and Torsion

$A_{cp} = 12096 \text{ in}^2$	$A_v = 0.88 \text{ in}^2$
$P_{cp} = 456 \text{ in}$	$A_t = 0.44 \text{ in}^2$
$A_{oh} = 10877 \text{ in}^2$	$p_n = 433 \text{ in}$
$A_o = 9246 \text{ in}^2$	
$V_c = 1146.2 \text{ kip}$	
$\phi V_c = 1031.6 \text{ kip}$	No Shear Rein. Reqd.
$T_{cr} = 62.56 \text{ kip-ft}$	No Torsional Rein. Reqd.

$(A_v/s) = 0.000 \text{ in}^2/\text{in}/n\text{-legs}$
$(A_t/s) = 0.000 \text{ in}^2/\text{in}/\text{leg}$
0.00 $\text{in}^2/\text{in}/2\text{legs}$

$s_{req} = \#DIV/0! \text{ in}$	
$s_{min} = 6.29 \text{ in}$	(AASHTO 5.8.2.5)
$s_{max,v} = 24 \text{ in}$	(AASHTO 5.8.2.7)
$s_{max,t} = 12 \text{ in}$	

For	Cleveland - Pier 11 Cap Beam	Job No.	49633	Sheet No.	
Made by	LER	Checked by	KPG	Backchecked by	
Date	11/2/11	Date	12/1/12	Date	

SECTION 3 - P1 + P2

Section Geometry

Width:	b = 144.000 in	$I_g = 35831808 \text{ in}^4$	
Total Depth (inc. red. for wear):	D = 144.000 in	$f_{cr} = 682 \text{ psi}$	(LRFD AASHTO 5.4.2.6)
Cover Prim. Bar:	$c_p = 0.875 \text{ in}$	$1.2 * M_{cr} = 407435301 \text{ lb-in}$	
Cover on Sec. Bar:	$c_s = 2.000 \text{ in}$	x = 26.70 in	
Side Cover:	$c_{side} = 3.000 \text{ in}$	$\beta = 0.85$	
Stirrups/Outer Bar:	#6 bar		$d_{stirrup} = 0.750 \text{ in}$
			$A_{stirrup} = 0.440 \text{ in}^2$
Primary Bars:			No. Legs for Shear = 2
Layer 1	No. Bars: 32.00, Size: #11, Layer Spa.: , No./Bundle: 2		No. Legs for Torsion = 1
Layer 2			
Layer 3			$d_v = 137.37 \text{ in}$
Secondary Bars:	18.00 #11		
Eff. Depth for Primary Bars:	d = 140.97 in	$A_s = 49.920 \text{ in}^2$	$d_s = 1.410 \text{ in}$
Eff. Depth for Secondary Bars:	d' = 3.455 in	$A_s' = 28.080 \text{ in}^2$	$d_s' = 1.410 \text{ in}$

Materials

Concrete Compression Strength:	$f'_c = 3400 \text{ psi}$
Concrete Modulus of Elasticity:	$E_c = 3323600 \text{ psi}$
Modular Ratio:	n = 9
Reinforcing Yield Strength:	$f_y = 60000 \text{ psi}$
Reinforcing Modulus of Elasticity:	$E_s = 29000 \text{ ksi}$
Crack Width Parameter:	$\gamma = 0.75 \text{ k/in}$

Resistance Factors

Flexure and Tension:	$\phi = 0.90$ *
Shear and Torsion:	$\phi = 0.90$

Loads

$M_u = 22940 \text{ k-ft}$
$M_s = 18355 \text{ k-ft}$
$V_u = 0.0 \text{ kip}$
$T_u = 0.0 \text{ kip}$

Flexure - Strength

Analyze as Doubly Reinforced (Y/N): n

Flexural Strength:

$R_n = 106.89 \text{ psi}$	
m = 20.76	$A_s F_y = 2995200 \text{ lb}$
$\rho = 0.0018$	a = 7.20 in
$A_{s_req} = 36.54 \text{ in}^2$	$\phi M_n = 30858 \text{ kip-ft}$
OK	OK

Minimum Steel:

$R_n = 158.21 \text{ psi}$	$4/3 R_n = 143$
m = 20.76	m = 20.76
$\rho_{min_1} = 0.0027$	$\rho_{min_2} = 0.0024$
$A_{s_min1} = 54.81 \text{ in}^2$	$A_{s_min2} = 48.72 \text{ in}^2$
	OK

Maximum Steel:

*The maximum steel requirement has been removed. This provision is compensated for by adjusting the resistance factor based on whether the section is tension controlled, compression controlled, or in transition. A section is tension controlled if $c/d \leq 0.375$ and $\phi = 0.90$

$c = a/\beta = 8.47 \text{ in}$
$c/d = 0.06 \leq 0.375$, Tension Controlled
(Use this for single and double reinforcement)

Flexure - Crack Control

$f_s = 33.41 \text{ ksi}$
$f_c = 0.87 \text{ ksi}$
$d_c = 3.035 \text{ in}$
$\beta_s = 1.031$
$s_{max} = 9.17 \text{ in}$
$s_{prov} = 9.01 \text{ in}$
OK

↳ actual $s \approx 6.5"$

Shear and Torsion

$A_{cp} = 20736 \text{ in}^2$	$A_v = 0.88 \text{ in}^2$
$P_{cp} = 576 \text{ in}$	$A_t = 0.44 \text{ in}^2$
$A_{oh} = 19266 \text{ in}^2$	$p_h = 555 \text{ in}$
$A_o = 16376 \text{ in}^2$	
$V_c = 2306.8 \text{ kip}$	
$\phi V_c = 2076.1 \text{ kip}$	No Shear Rein. Reqd.
$T_{cr} = 14789 \text{ kip-ft}$	No Torsional Rein. Reqd.

$(A_v/s) = 0.000 \text{ in}^2/\text{in}/n\text{-legs}$
$(A_t/s) = 0.000 \text{ in}^2/\text{in}/\text{leg}$
0.00 $\text{in}^2/\text{in}/2\text{legs}$

$s_{req} = \#DIV/0! \text{ in}$	
$s_{min} = 6.29 \text{ in}$	(AASHTO 5.8.2.5)
$s_{max_v} = 24 \text{ in}$	(AASHTO 5.8.2.7)
$s_{max_t} = 12 \text{ in}$	

FOR:	JOB NO:	SHEET NO:
MADE BY:	CHECKED BY:	BACKCHECKED BY:
DATE:	DATE:	DATE:

Excerpts from Pier II Horizontal
Construction Joint Design
Computations.

For Cleveland - Pier 11	Job no. 49633	Sheet no.
Made by LER	Checked by PDB	Backchecked by
Date 10/3/11	Date 11/06/11	Date

Section ① - Inside face right column

D_i = total depth, pour 1
 D = total final depth

$D_i = 144"$
 $D = 192"$

Design Loads (-M)

	M_u (k-ft)	M_s (k-ft)
Stage 1	12,725	9,995
Stage 2	21,600	17,280
* Final (1)	65,470	42,285
(2)	65,470	42,295

Stage 1: 16 Bund. 2-#11 @ $\approx 6.5"$

$\phi M_n = 30,998$ k-ft OK
 $S_{max} = 23.5" > 6.5" \text{ OK}$

Stage 2: 16-Bund. 2-#11 @ $\approx 6.5"$

$\phi M_n = 31,119$ k-ft OK
 $S_{max} = 11.6" > 6.5" \text{ OK}$

* Final (1) - Loads from cap design including truck load on all units (U₂, U₃, Ramp A5)


(2) - Loads from cap design excluding truck load on U₂.

Final: ϕ 16-Bund 2-#11 } $S \approx 6.5"$
 @ 16-Bund 2-#11 }
 @ 16-#11 }

$\phi M_n = 97,603$ k-ft OK
 $S_{max} = 7.49" > 6.5" \text{ OK}$

* Includes tension due to restrained shrinkage on four section, $F_{sh} = 860$ k.

The bars must be detailed to fit around the 3' wide access hole opening.

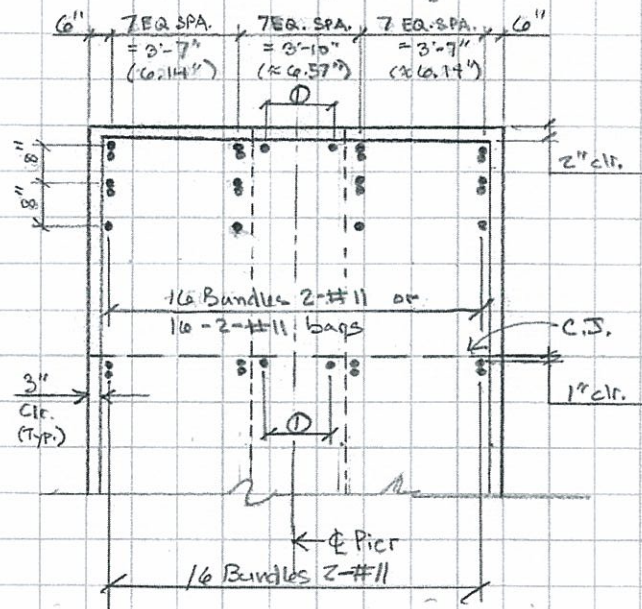

① ϕ #6 Bars, EQ SPA.

For Cleveland - Pier 11	Job no. 49633	Sheet no.
Made by LEP	Checked by PDB	Backchecked by
Date 10/3/11	Date 11/08/11	Date

Section ③ - Inside face left column.

$D_i = 147''$
 $D = 220''$ (use height to top of second step from right)


Design Loads

	M_u (k-ft)	M_s (k-ft)
Stage 1	12,725	9,995
Stage 2	22,940	18,355
Final ①	68,880	51,840
②	70,170	52,540

Stage 1: Loading and design section is identical to that for Section ①.

Stage 2: 16 Bund. 2-#11 @ $a \approx 6.5''$
 $\phi M_n = 31,119$ k-ft ok
 $S_{max} = 10.6'' > 6.5''$ ok.

Final:

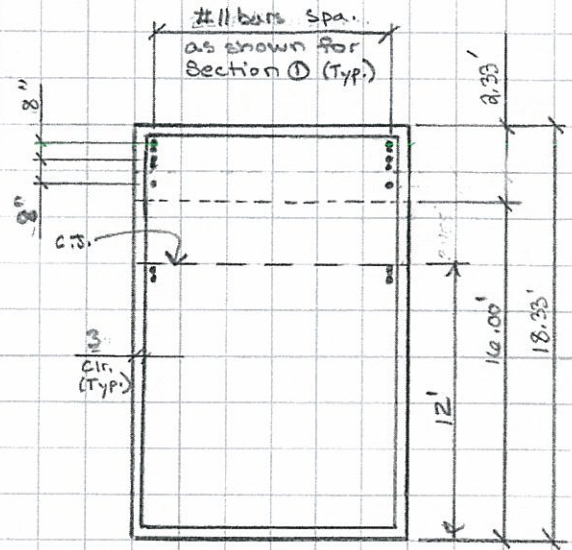

$\phi M_n = 113,328$ k-ft ok
 $S_{max} = 6.75'' > 6.5''$ ok.

Additional 1'-2" step not shown.

Add 22-#6 bars to face of 3rd step spa. sim. to main bars for section ① & ③.

For <u>Cleveland - Pier II</u>	Job no. <u>49633</u>	Sheet no.
Made by <u>LER</u>	Checked by <u>KDG</u>	Backchecked by
Date <u>12/13/11</u>	Date <u>12/15/11</u>	Date

Minimum Shear Requirements

Determine min. shear reinforcement requirements for portion of pour I where $V_u > \frac{1}{2} \phi V_c$.
(see shear diagram).

$$A_{s_{min}} = 0.0316 \sqrt{f'_c} \frac{b_v}{f_y}$$

$$b_v = 144 \text{ in}$$

$$f_y = 60 \text{ ksi}$$

$$A_{s_{min}} = 0.0316 \sqrt{4} \frac{144 \text{ in}}{60 \text{ ksi}}$$


$$= 0.152 \text{ in}^2/\text{in}$$

$$S = 6' \frac{1}{2} \text{ max.}$$


$$\therefore A_v = 0.152 \text{ in}^2/\text{in} (6.5'')$$

$$= 0.99 \text{ in}^2$$

$$4 \#5 = 1.24 \text{ in}^2 \quad +$$

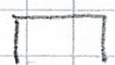
Use 2-#5  to match shear reinforcement.

Provide stirrups to $\approx X = 55'$
or 55-23.5-6 $\approx 26'$ from face of column.

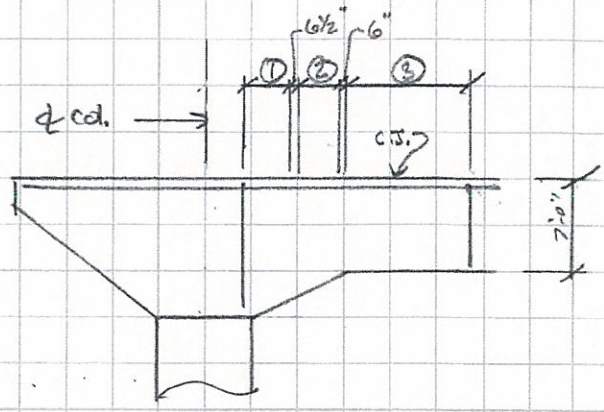


Elev. Near Left Col.

- Two Sets
- ① 17 - 11 P550 @ 6' 1/2" = 8'-8"
 - ② 7 - 11 P550 @ 6" = 3'-3"
 - ③ 28 - 11 P550 @ 6" = 13'-6"

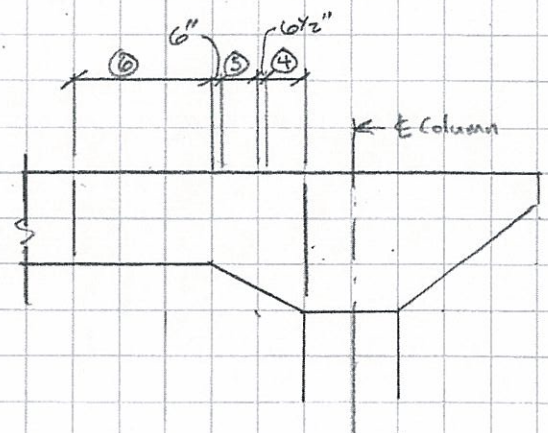

- Two Sets
- ④ 15 - 11 P550 @ 6' 1/2" = 7'-7"
 - ⑤ 9 - 11 P550 @ 6' 1/2" = 4'-4"
 - ⑥ 28 - 11 P550 @ 6" = 13'-6"

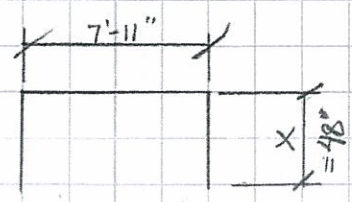


11 P550

$X >$ class C splice
 $\geq 37''$ (7/16" space, EPOX)

For Reference

SHEAR DIAGRAM

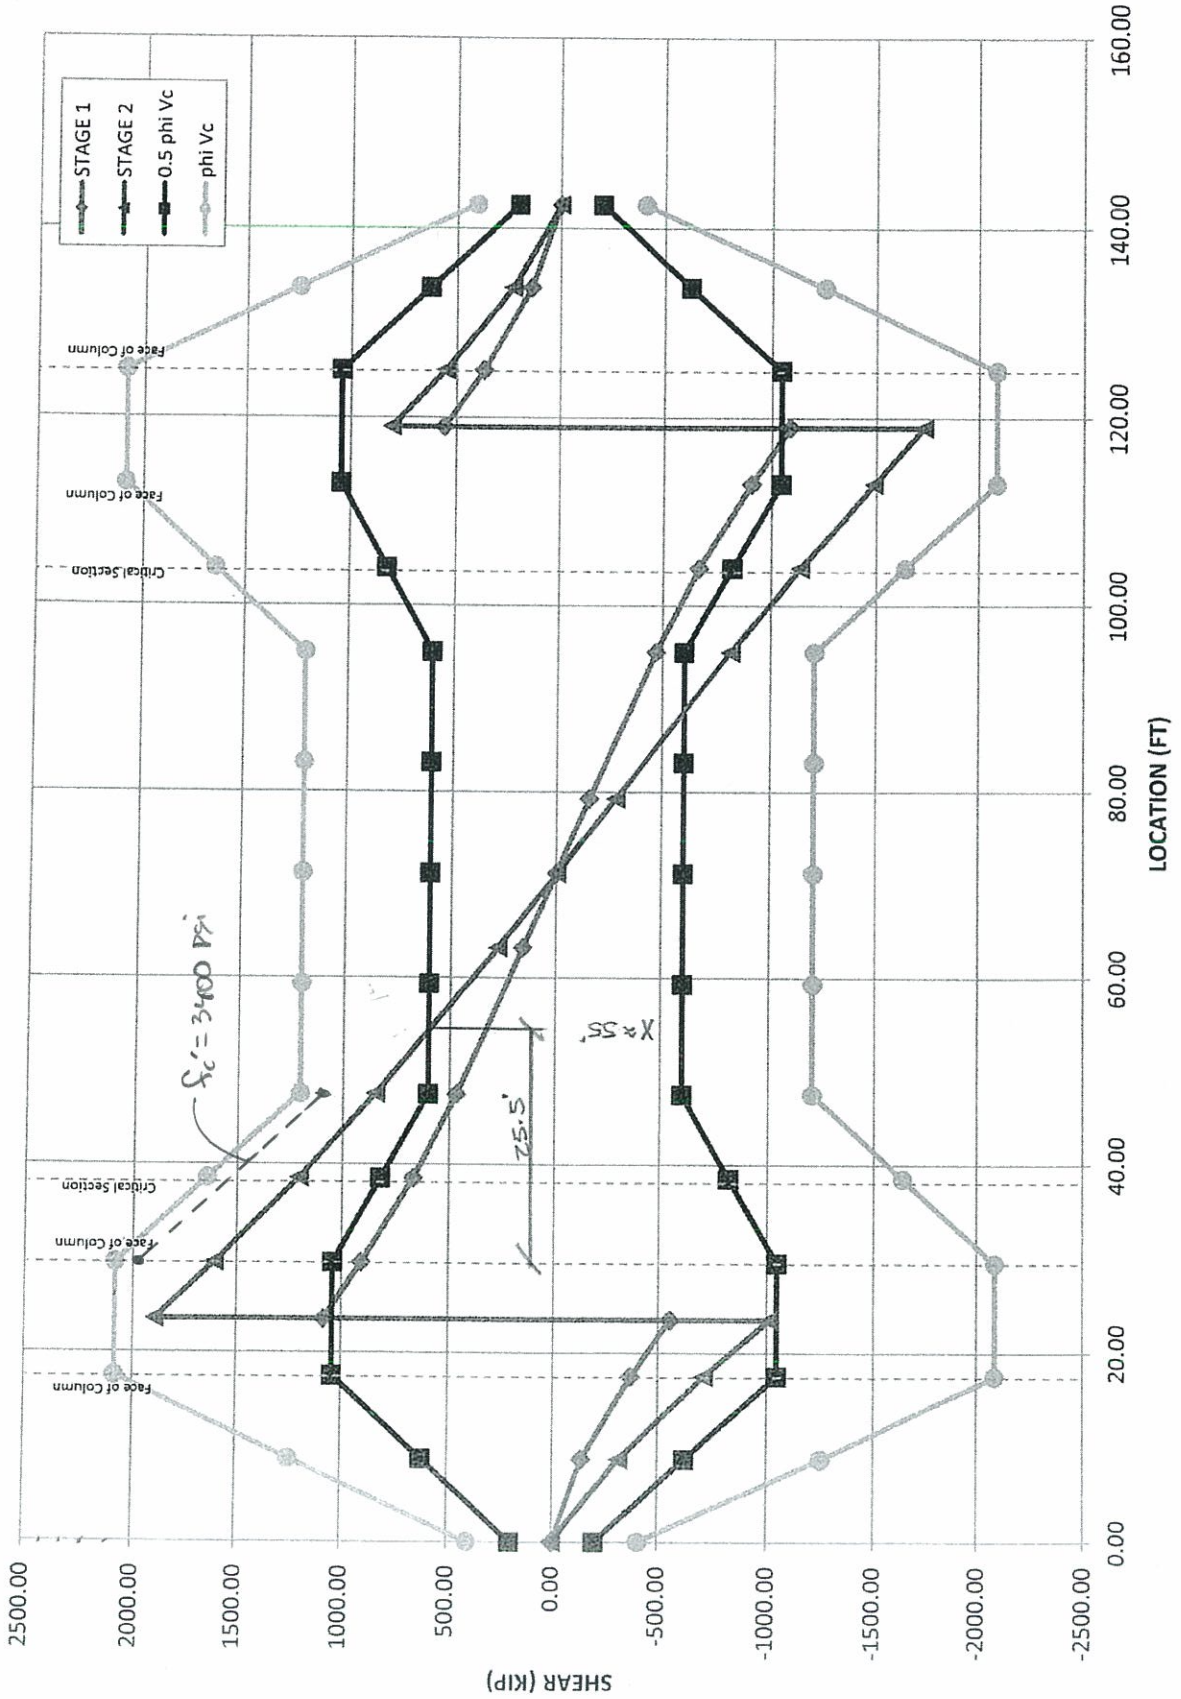

For	Cleveland - Pier 11 Cap Beam	Job No.	49633	Sheet No.	
Made by	LER	Checked by	KDG	Backchecked by	
Date	11/2/11	Date	12/5/11	Date	



SECTION 1 - P1 + P2

Section Geometry

Width:	b = 144.000 in	$I_g = 35831808 \text{ in}^4$	<i>Recheck crack control w/ new d.</i>
Total Depth (inc. red. for wear):	D = 144.000 in	$f_{cr} = 740 \text{ psi}$	
Cover Prim. Bar:	$c_p = 0.875 \text{ in}$	$1.2 * M_{cr} = 441925632 \text{ lb-in}$	
Cover on Sec. Bar:	$c_s = 2.000 \text{ in}$	$x = 25.33 \text{ in}$	
Side Cover:	$c_{side} = 3.000 \text{ in}$	$\beta = 0.85$	
Stirrups/Outer Bar:	#6 bar	$d_{stirrup} = 0.750 \text{ in}$	
		$A_{stirrup} = 0.440 \text{ in}^2$	
Primary Bars:	Layer 1 32.00 #11	2	No. Legs for Shear = 2
	Layer 2 #11		No. Legs for Torsion = 2
	Layer 3 #11		$d_v = 137.91 \text{ in}$
Secondary Bars:	18.00 #11		
Eff. Depth for Primary Bars:	$d = 140.97 \text{ in}$	$A_s = 49.920 \text{ in}^2$	$d = 1.410 \text{ in}$
Eff. Depth for Secondary Bars:	$d' = 3.455 \text{ in}$	$A_s' = 28.080 \text{ in}^2$	$d_c' = 1.410 \text{ in}$

Materials

Concrete Compression Strength:	$f_c' = 4000 \text{ psi}$
Concrete Modulus of Elasticity:	$E_c = 3605000 \text{ psi}$
Modular Ratio:	$n = 8$
Reinforcing Yield Strength:	$f_y = 60000 \text{ psi}$
Reinforcing Modulus of Elasticity:	$E_s = 29000 \text{ ksi}$
Crack Width Parameter:	$\gamma = 0.75 \text{ k/in}$

Flexure - Crack Control

$f_s = 31.34 \text{ ksi}$
$f_c = 0.86$
$d_c = 3.035 \text{ in}$
$\beta_s = 1.031$
$s_{max} = 10.18 \text{ in}$
$s_{prov} = 9.01 \text{ in}$
<i>6.14"</i>

OK ✓

Resistance Factors

Flexure and Tension:	$\phi = 0.90$	*
Shear and Torsion:	$\phi = 0.90$	

Shear and Torsion

$A_{cp} = 20736 \text{ in}^2$	$A_v = 0.88 \text{ in}^2$
$P_{cp} = 576 \text{ in}$	$A_t = 0.44 \text{ in}^2$
$A_{oh} = 19266 \text{ in}^2$	$p_h = 555 \text{ in}$
$A_o = 16376 \text{ in}^2$	
$V_c = 2511.9 \text{ kip}$	
$\phi V_c = 2260.7 \text{ kip}$	No Shear Rein. Reqd.
$T_{cr} = 13758 \text{ kip-ft}$	No Torsional Rein. Reqd.

Loads

$M_u = 21600 \text{ k-ft}$
$M_s = 17280 \text{ k-ft}$
$V_u = 0.0 \text{ kip}$
$T_u = 0.0 \text{ kip}$

Flexure - Strength

Analyze as Doubly Reinforced (Y/N):

n

Flexural Strength:

$R_n = 100.65 \text{ psi}$	$A_s F_y = 2995200 \text{ lb}$
$m = 17.65$	$a = 6.12 \text{ in}$
$\rho = 0.0017$	$\phi M_n = 30979 \text{ kip-ft}$
$A_{s_{req}} = 34.51 \text{ in}^2$	OK

Minimum Steel:

$R_n = 171.60 \text{ psi}$	$4/3 R_n = 134$
$m = 17.65$	$m = 17.65$
$\rho_{min,1} = 0.0029$	$\rho_{min,2} = 0.0023$
$A_{s_{min1}} = 58.87 \text{ in}^2$	$A_{s_{min2}} = 46.69 \text{ in}^2$
	OK

Maximum Steel:

*The maximum steel requirement has been removed. This provision is compensated for by adjusting the resistance factor based on whether the section is tension controlled, compression controlled, or in transition. A section is tension controlled if $c/d \leq 0.375$ and $\phi = 0.90$

$c = a/\beta = 7.20 \text{ in}$
$c/d = 0.05 \leq 0.375$, Tension Controlled
(Use this for single and double reinforcement)

$(A_v/s) = 0.000 \text{ in}^2/\text{in}/\text{n-legs}$
$(A_v/s) = 0.000 \text{ in}^2/\text{in}/\text{leg}$
$0.00 \text{ in}^2/\text{in}/2\text{legs}$

$s_{req} = \#DIV/0! \text{ in}$	
$s_{min} = 5.80 \text{ in}$	(AASHTO 5.8.2.5)
$s_{max,v} = 24 \text{ in}$	(AASHTO 5.8.2.7)
$s_{max,t} = 12 \text{ in}$	

For	Cleveland - Pier 11 Cap Beam	Job No.	49633	Sheet No.	
Made by	LER	Checked by	KDG	Backchecked by	
Date	11/2/11	Date	12/15/11	Date	

HNTB

SECTION 3 - P1 + P2

Recheck crack control w/ new d.

Section Geometry

Width:	b = 144.000 in	$I_g = 35831808 \text{ in}^4$	
Total Depth (inc. red. for wear):	D = 144.000 in	$f_{cr} = 740 \text{ psi}$	(LRFD AASHTO 5.4.2.6)
Cover Prim. Bar:	$c_p = 0.875 \text{ in}$	$1.2 * M_{cr} = 441925632 \text{ lb-in}$	
Cover on Sec. Bar:	$c_s = 2.000 \text{ in}$	$x = 25.33 \text{ in}$	
Side Cover:	$c_{side} = 3.000 \text{ in}$	$\beta = 0.85$	
Stirrups/Outer Bar:	#6 bar		$d_{stirrup} = 0.750 \text{ in}$
			$A_{stirrup} = 0.440 \text{ in}^2$
Primary Bars:			No. Legs for Shear = 2
Layer 1	32.00 #11	2	No. Legs for Torsion = 1
Layer 2	#11		
Layer 3	#11		$d_v = 137.91 \text{ in}$
Secondary Bars:	18.00 #11		
Eff. Depth for Primary Bars:	d = 140.97 in	$A_s = 49.920 \text{ in}^2$	$d_s = 1.410 \text{ in}$
Eff. Depth for Secondary Bars:	d' = 3.455 in	$A_s' = 28.080 \text{ in}^2$	$d_s' = 1.410 \text{ in}$

Materials

Concrete Compression Strength:	$f_c' = 4000 \text{ psi}$
Concrete Modulus of Elasticity:	$E_c = 3605000 \text{ psi}$
Modular Ratio:	$n = 8$
Reinforcing Yield Strength:	$f_y = 60000 \text{ psi}$
Reinforcing Modulus of Elasticity:	$E_s = 29000 \text{ ksi}$
Crack Width Parameter:	$\gamma = 0.75 \text{ k/in}$

Flexure - Crack Control

$f_c = 33.29 \text{ ksi}$	
$f_{cr} = 0.91 \text{ ksi}$	
$d_c = 3.035 \text{ in}$	
$\beta_s = 1.031$	
$s_{max} = 9.23 \text{ in}$	OK ✓
$s_{prov} = 9.01 \text{ in}$	
$6.14"$	

Resistance Factors

Flexure and Tension:	$\phi = 0.90$	*
Shear and Torsion:	$\phi = 0.90$	

Shear and Torsion

$A_{cp} = 20736 \text{ in}^2$	$A_v = 0.88 \text{ in}^2$
$P_{cp} = 576 \text{ in}$	$A_t = 0.44 \text{ in}^2$
$A_{oh} = 19266 \text{ in}^2$	$P_h = 555 \text{ in}$
$A_o = 16376 \text{ in}^2$	
$V_c = 2511.9 \text{ kip}$	
$\phi V_c = 2260.7 \text{ kip}$	No Shear Rein. Reqd.
$T_{cr} = 13733 \text{ kip-ft}$	No Torsional Rein. Reqd.

Loads

$M_u = 22940 \text{ k-ft}$
$M_s = 18355 \text{ k-ft}$
$V_u = 0.0 \text{ kip}$
$T_u = 0.0 \text{ kip}$

Flexure - Strength

Analyze as Doubly Reinforced (Y/N):	<input type="checkbox"/> n
Flexural Strength:	
$R_n = 106.89 \text{ psi}$	
$m = 17.65$	$A_s F_y = 2995200 \text{ lb}$
$\rho = 0.0018$	$a = 6.12 \text{ in}$
$A_{s,req} = 36.54 \text{ in}^2$	$\phi M_n = 30979 \text{ kip-ft}$
OK	OK
Minimum Steel:	
$R_n = 171.60 \text{ psi}$	$4/3 R_n = 143$
$m = 17.65$	$m = 17.65$
$\rho_{min,1} = 0.0029$	$\rho_{min,2} = 0.0024$
$A_{s,min1} = 58.87 \text{ in}^2$	$A_{s,min2} = 48.72 \text{ in}^2$
	OK

$(A_s/s) = 0.000 \text{ in}^2/\text{in}/n\text{-legs}$
$(A_s/s) = 0.000 \text{ in}^2/\text{in}/\text{leg}$
$0.00 \text{ in}^2/\text{in}/2\text{legs}$

$s_{req} = \#DIV/0! \text{ in}$	
$s_{min} = 5.80 \text{ in}$	(AASHTO 5.8.2.5)
$s_{max,v} = 24 \text{ in}$	(AASHTO 5.8.2.7)
$s_{max,t} = 12 \text{ in}$	

Maximum Steel:

*The maximum steel requirement has been removed. This provision is compensated for by adjusting the resistance factor based on whether the section is tension controlled, compression controlled, or in transition. A section is tension controlled if $c/d \leq 0.375$ and $\phi = 0.90$

$c = a/\beta = 7.20 \text{ in}$
$c/d = 0.05 \leq 0.375, \text{ Tension Controlled}$
(Use this for single and double reinforcement)

For <u>Cleveland - Pier 11 CJ</u>	Job no. <u>49633</u>	Sheet no.
Made by <u>LER</u>	Checked by <u>PDB</u>	Backchecked by
Date <u>10/31/11</u>	Date <u>11/06/11</u>	Date

Shrinkage & Restraint Forces

The time lapse between placement of the first and second pours will result in a differential shrinkage strain, generating internal forces in the two sections in addition to restraint forces due to the continuity between the cap and columns. The magnitude of these forces will be estimated using the CEB-FIP Model Code 1990 and HNTB's proprietary structural analysis software, T187.

Assumptions

1. Assume shrinkage of a pour starts at end of 7-day curing period required by CMS 511.17. Set concrete age to 0 days for pours 1 and 2. Start erection analysis at $t = 7$ (Day 7).
2. Assume second pour is placed 21 days after first pour. This includes 14 days for concrete to reach 85% of 28-day strength prior to form removal and loading plus 7 days to setting of additional forms, etc. Pour 2 placed at $t = 21$ (Day 21). Start computing shrinkage of pour 2 at end of 7 day cure period, $t = 28$ (Day 28).

3. Ignore creep.
4. Assume gross section properties apply (i.e. ignore cracking).
5. The stiffness of the footing will be included.
6. Run the analysis out to $t = 75$ years (Day 27375) at the following increments:
 - 7 - Activate pour 1 members
 - 14 - Release forms
 - 21.0 - Pre-pour 2
 - 21.1 - Place Pour 2
 - 27.9
 - 28 - Activate Pour 2 members
 - 35
 - 50
 - 100 } 200
 - 1600 } 400
 - 3200 } 800
 - 6400
 - 12800
 - 25600
 - 27375 - End of service (EOS) - 75 years

7. Assume in-service humidity of 70% (Design Criteria II.B.4.b)
8. When calculating volume to surface ratio, the shared surface of the two pours will be excluded throughout the analysis.
9. Construction joint set 8' from bottom of cap beam soffit.

Over →