

**NOTES:**

**GENERAL**

1. MARK CENTERLINES ON BEARING MASONRY PLATE EDGES. THESE IDENTIFICATION IDENTIFICATION MARKS WILL BE USED TO MEASURE OFFSETS IN THE FIELD. USE INDELIBLE INK TO PLACE THESE MARKS.
2. THIS SHOP DRAWING WAS PREPARED IN ACCORDANCE WITH CONTRACT DOCUMENTS.

**MATERIALS**

1. ALL STEEL FOR BEARINGS SHALL BE ASTM A709 GR. 50. NO SUPPLEMENTARY REQUIREMENTS OF ASTM A709 GR. 50 ARE SPECIFIED FOR BEARING PLATES. THEREFORE, ASTM A572 GR. 50 IS AN ACCEPTABLE EQUIVALENT.

**COATINGS**

1. ALL MILL SCALE SHALL BE REMOVED FROM STEEL PLATES VIA ABRASIVE BLASTING IN ACCORDANCE WITH SSPC-SP10. THE PLATE SURFACES BELOW THE POLYTRON DISC SHALL BE ABRASIVE BLASTED TO A NEAR WHITE CONDITION AS DEFINED IN SSPC-SP10. THE BLAST PROFILE SHALL BE JAGGED RATHER THAN "PEENED".
2. PAINT ALL EXPOSED STEEL SURFACES WITH AN IZEU PAINT SYSTEM IN ACCORDANCE WITH CMS514. THE TOP COAT COLOR SHALL BE SW 7008 ALABASTER.

- THE FOLLOWING SHALL NOT BE COATED:
- SRM HOLE

- PRIME COAT CARBOZINC 11 HS (MAY BE FIELD APPLIED, CONTRACTORS OPTION). INTERMEDIATE AND FINISH COATS TO BE FIELD APPLIED.

**WELDING**

1. ALL STEEL FABRICATION SHALL CONFORM TO THE CONTRACT SPECIFICATIONS AND APPLICABLE SECTIONS OF AASHTO STANDARD SPECIFICATIONS FOR HIGHWAY BRIDGES. ALL WELDING SHALL BE PERFORMED BY WELDERS/WELDING OPERATORS QUALIFIED TO PROCESS AND POSITION IN ACCORDANCE WITH AWS D1.5.
2. WELDING TO BEARING PLATES AFTER ASSEMBLY IS PERMITTED PROVIDED WELDING PROCEDURES RESTRICT THE MAXIMUM TEMPERATURE IN THE AREAS OF THE POLYTRON DISC AND PTFE TO NO MORE THAN 225°F AS DETERMINED BY USE OF TEMPERATURE INDICATING WAX PENCILS. PROTECTIVE MATERIAL SHALL BE PLACED OVER THE BEARING ASSEMBLY TO PROTECT AGAINST SPARKS AND FLASH. AFTER WELDING IS COMPLETE, EXPOSED STEEL IS TO BE COATED IN ACCORDANCE WITH THE SPECIFIED COATING SYSTEM.




**SHIPPING AND HANDLING**

1. COMPLETED BEARINGS SHALL BE INDIVIDUALLY Banded IN THE UPRIGHT POSITION.
2. BEARING ASSEMBLIES SHALL BE HANDLED BY THEIR BOTTOM SURFACES ONLY, AND SHALL NOT BE LIFTED BY THEIR TOPS, SIDES AND/OR SHIPPING BANDS.
3. BEARINGS SHALL BE STORED IN A CLEAN, DRY AND UPRIGHT POSITION.
4. AT NO TIME PRIOR TO THE COMPLETION OF THE PROJECT MAY ANY BEARING BE DISASSEMBLED WITHOUT AUTHORIZATION FROM RJ WATSON, INC. AND WRITTEN APPROVAL OF THE ENGINEER.



**INSTALLATION**

1. CONTRACTOR SHALL ADJUST BEARING SEAT ELEVATIONS TO ACCOMMODATE FINAL BEARING HEIGHT.
2. BEARINGS SHALL BE INSTALLED IN ACCORDANCE WITH THE TOLERANCES PROVIDED IN THE AASHTO LRFD BRIDGE CONSTRUCTION SPECIFICATIONS SECTION 18.1.7.


DB2650F		3	LOCATION: UNIT 2 - PIER 6, GIRDERS 2,3,4							
MARK	QTY UNIT	QTY TOTAL	DESCRIPTION (IN)			PIECE	COATING	MATERIAL		REMARKS
			DIM1	DIM2	DIM3					
PC3	1	3	59.000	68.000	2.500	MASONRY PLATE	PAINT	ASTM	A709 GR 50	
PD3	1	3	42.000	Ø	2.750	LOWER BEARING PLATE	PAINT	ASTM	A709 GR 50	
MC3	1	3	59.000	68.000	0.125	BEARING PAD	NONE	CMS	711.21	
MD3	6	18	2.000	Ø	23.000	ANCHOR ROD	GALVANIZE	ASTM	A449	SWEDGED W/ 4.000 THREAD
ME3	6	18	2.000	Ø	6.000	COUPLER	GALVANIZE	ASTM	A563 GR DH OR EQUIV.	

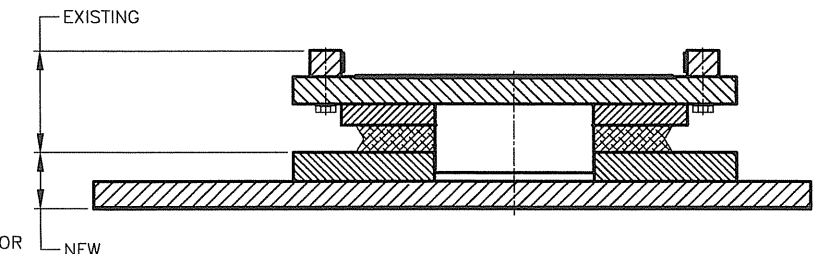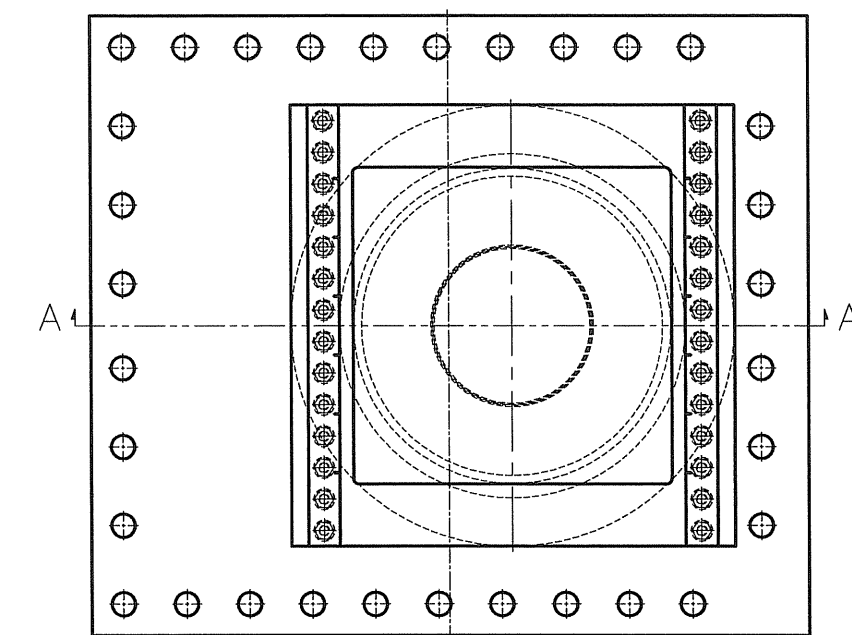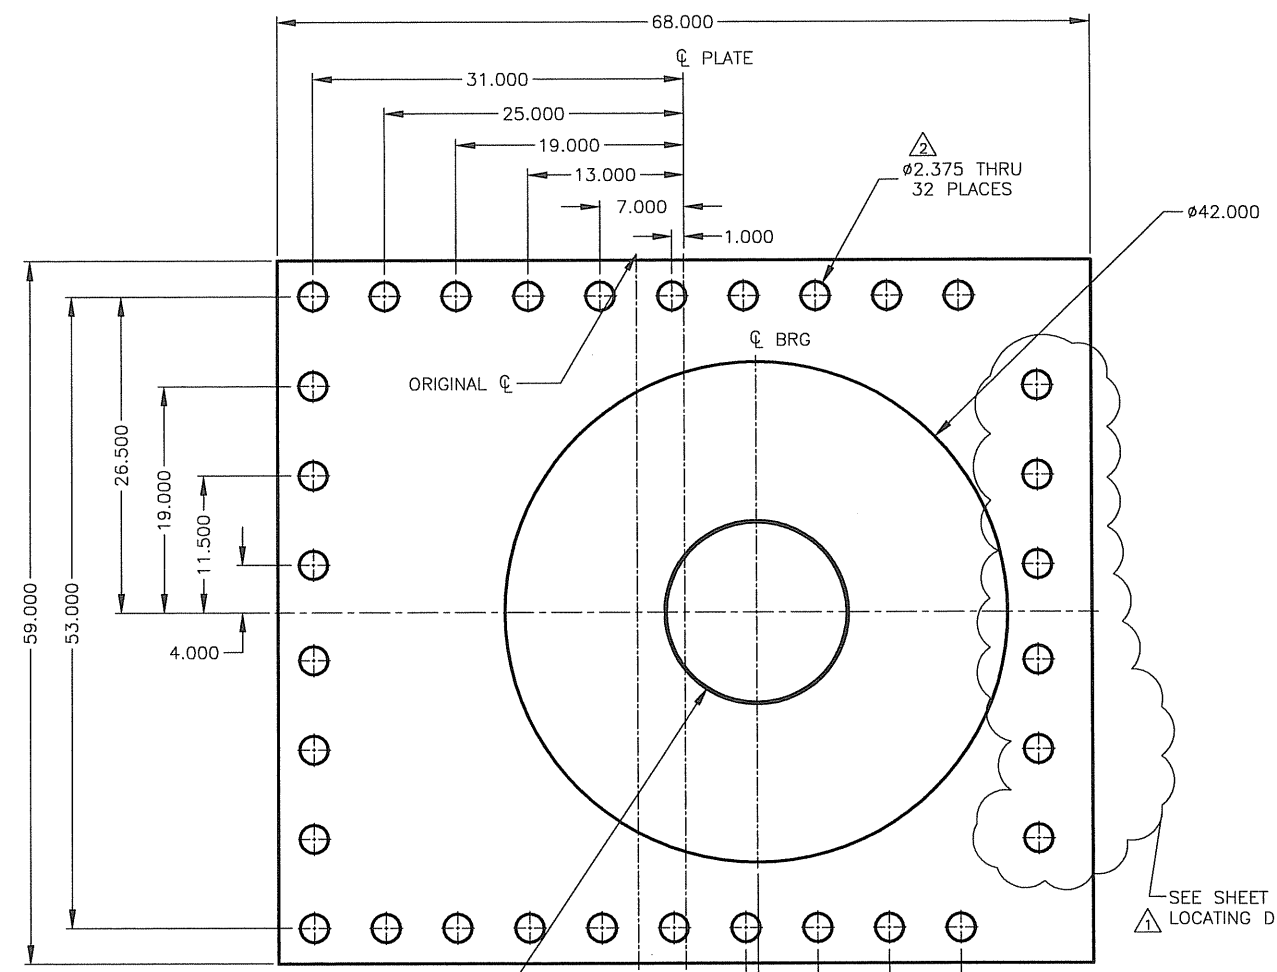

SECT A-A QTY 3 DB2650F ASSEMBLY SCALE: 1:5

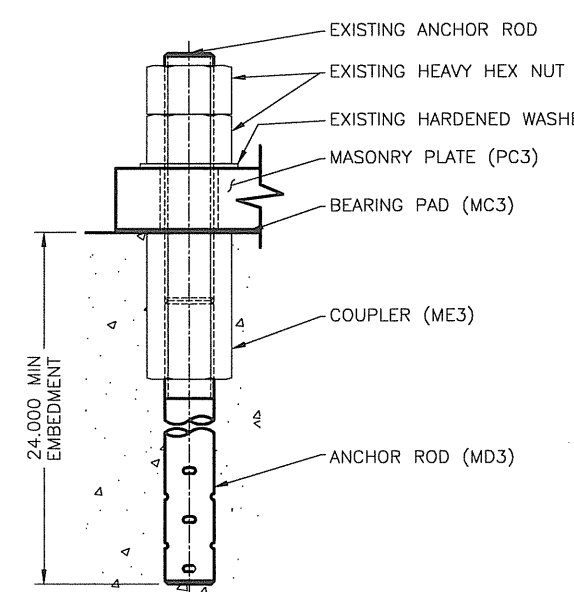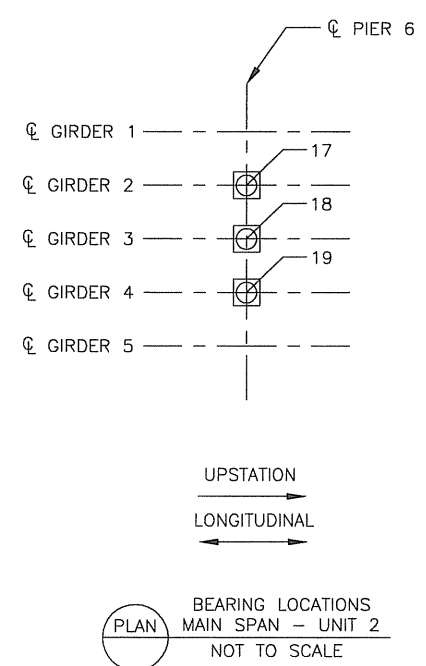

DET. ANCHOR ROD DETAIL NOT TO SCALE

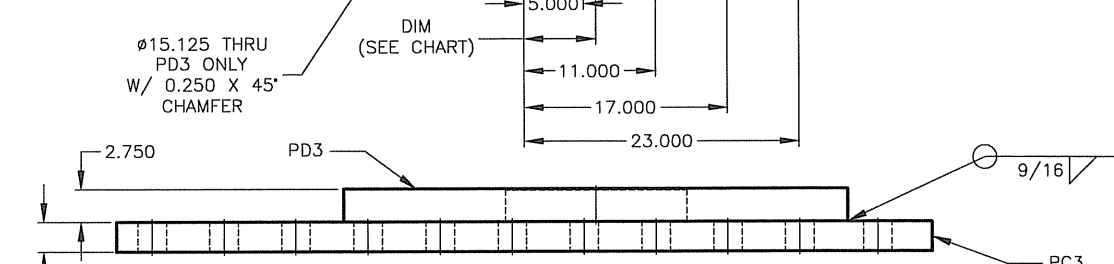


PIER 6, GIRDERS 2,3,4 DB2650F MASONRY PLATE ASSEMBLY SCALE: 1:5

TOTAL PC3 MASONRY PLATE 3 1

TOTAL PD3 LOWER BEARING PLATE 3 1


BEARING	DIM
DB2650F-17	6.500
DB2650F-18	6.000
DB2650F-19	6.375

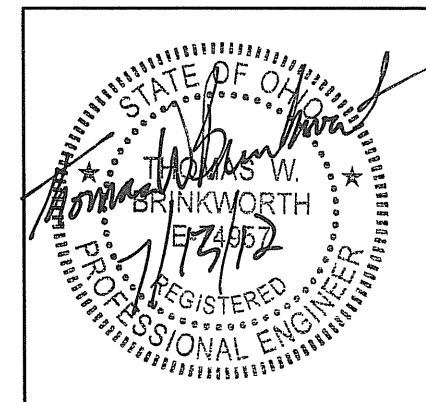


LEGEND				TOLERANCING:				PROJECT INFORMATION:															
<p>## DENOTES QUANTITY</p> <p>CLOUDY NOTES ARE TO BE PERMANENTLY MARKED IN POSITIONS SHOWN ON DETAILS</p> <p>TYP=TYPICAL</p> <p>TPI=THREADS PER INCH</p> <p>THDS=THREADS</p> <p>⊗ DENOTES THICK END</p>				<p>AS PER AASHTO LRFD BRIDGE CONSTRUCTION SPECIFICATIONS TABLE 18.1.4.2-1 UNLESS NOTED OTHERWISE</p> <p>SCALE: AS NOTED DO NOT SCALE DRAWING</p> <table border="1"> <thead> <tr> <th>REVISION</th> <th>DATE</th> <th>DTL'D</th> <th>CHK'D</th> </tr> </thead> <tbody> <tr> <td>ANCHOR FIELD MEASUREMENTS</td> <td>7/10/12</td> <td>AMT</td> <td>JCC</td> </tr> <tr> <td>ANCHOR HOLE SIZE INCREASE</td> <td>7/13/12</td> <td>AMT</td> <td>JCC</td> </tr> </tbody> </table>				REVISION	DATE	DTL'D	CHK'D	ANCHOR FIELD MEASUREMENTS	7/10/12	AMT	JCC	ANCHOR HOLE SIZE INCREASE	7/13/12	AMT	JCC	<p>MAIN SPAN - UNIT 2</p> <p>INNERBELT BRIDGE</p> <p>1-90 WB, BRIDGE NO. CUY-90-1566</p> <p>CLEVELAND, OHIO</p> <p>CUY-90-14.90</p> <p>PID NO. 77332/85531</p> <p>OWNER: OHIO DEPARTMENT OF TRANSPORTATION</p> <p>CONSULTANT: HNTB</p> <p>CONTRACTOR: WALSH CONSTRUCTION COMPANY</p>			
REVISION	DATE	DTL'D	CHK'D																				
ANCHOR FIELD MEASUREMENTS	7/10/12	AMT	JCC																				
ANCHOR HOLE SIZE INCREASE	7/13/12	AMT	JCC																				
<p>R. J. WATSON, INC.</p> <p>78 JOHN GLENN DRIVE AMHERST, NEW YORK 14228</p>								<p>TITLE: DB2650F MASONRY PLATE ASSEMBLY DETAILS UNIT 2 - PIER 6, GIRDERS 2,3,4 RETROFIT</p>															
<p>DTL'D BY: JSM DATE: 6-27-12</p>				<p>DATE: 6-27-12</p>				<p>RJW PO No. 2687A</p>															
<p>CHK'D BY: JCC DATE: 6-27-12</p>				<p>BEARING TYPE: DISKTRON</p>				<p>SHEET: 1 OF 2</p>															

ALL DIMENSIONS IN INCHES


LOWER BEARING PLATES NOT SHOWN FOR CLARITY.

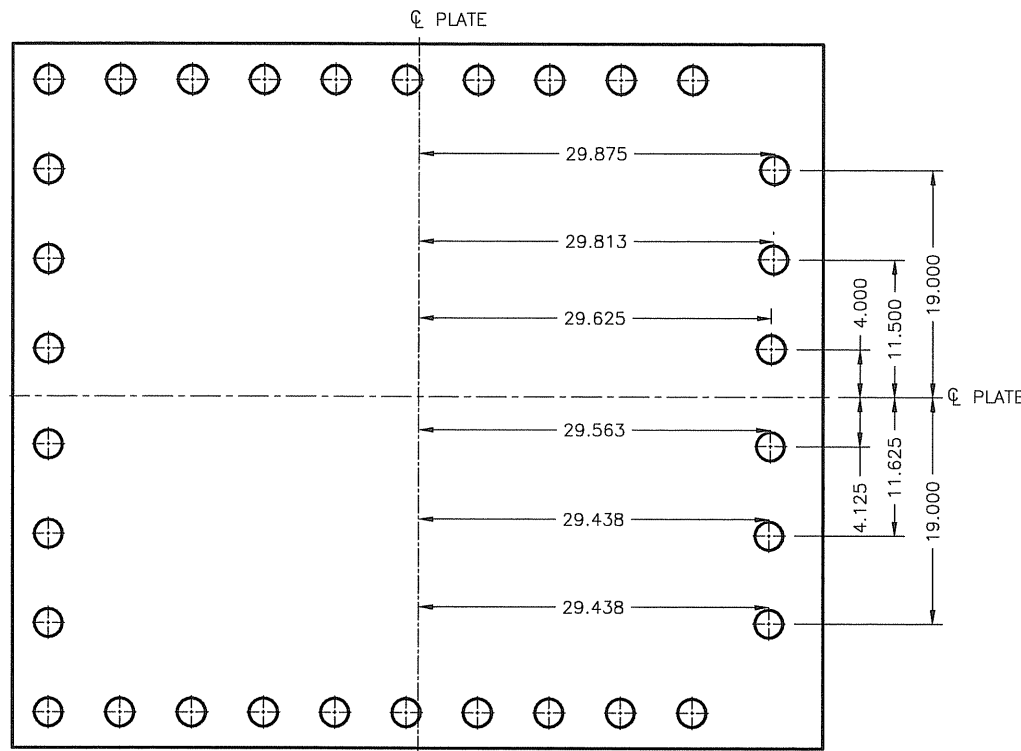

△ PC3 BEARING NO. 17  
1 MASONRY PLATE  
(PIER 6 G2)

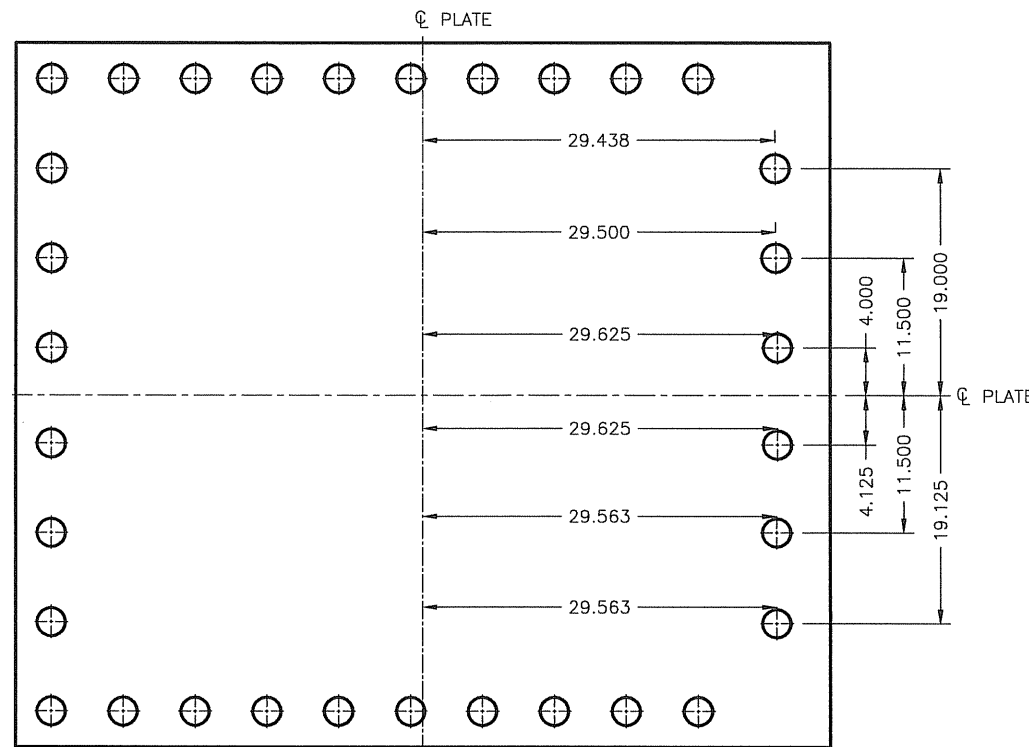


△ PC3 BEARING NO. 18  
1 MASONRY PLATE  
(PIER 6 G3)

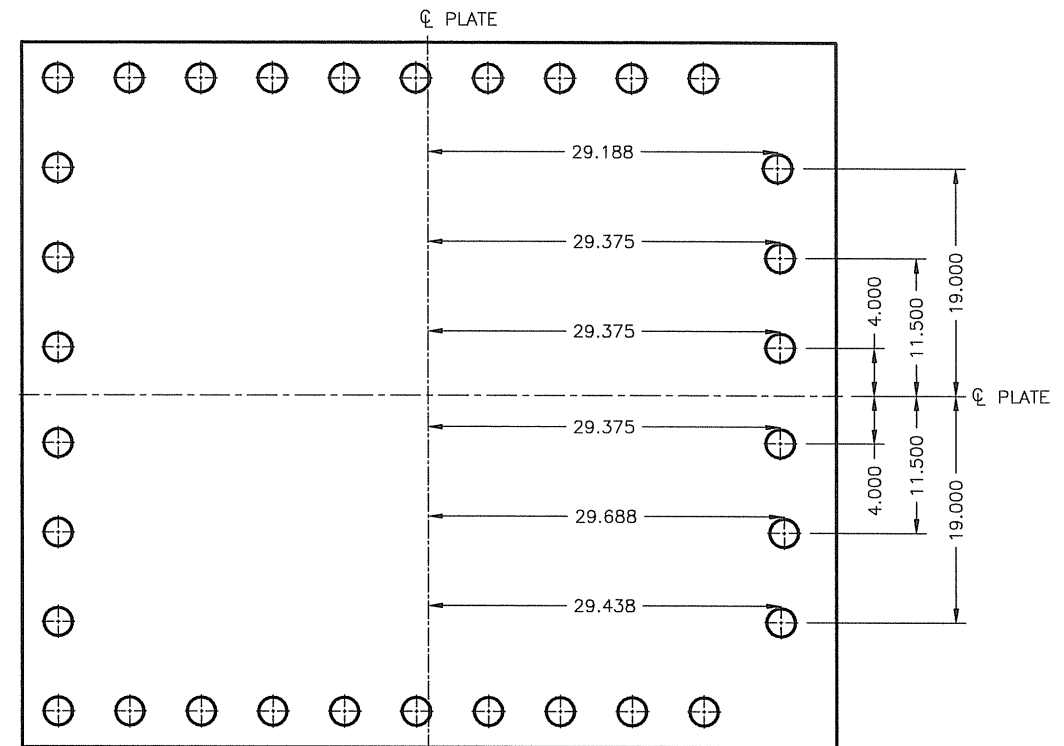

△ PC3 BEARING NO. 19  
1 MASONRY PLATE  
(PIER 6 G4)

NOTE: HOLE LOCATING DIMENSIONS PROVIDED BY WALSH - 7/9/12.

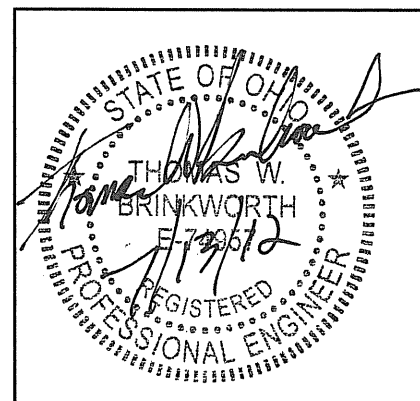

<b>LEGEND</b> DENOTES QUANTITY CLOUDY NOTES ARE TO BE PERMANENTLY MARKED IN POSITIONS SHOWN ON DETAILS TYP=TYPICAL TPI=THREADS PER INCH THDS=THREADS DENOTES THICK END	<b>TOLERANCING:</b> AS PER AASHTO LRFD BRIDGE CONSTRUCTION SPECIFICATIONS TABLE 18.1.4.2-1 UNLESS NOTED OTHERWISE	<b>PROJECT INFORMATION:</b> MAIN SPAN - UNIT 2 INNERBELT BRIDGE I-90 WB, BRIDGE NO. CUY-90-1566 CLEVELAND, OHIO CUY-90-14.90 PID NO. 77332/85531	 <b>R. J. WATSON, INC.</b> 78 JOHN GLENN DRIVE AMHERST, NEW YORK 14228								
	<b>SCALE:</b> AS NOTED DO NOT SCALE DRAWING <table border="1"> <thead> <tr> <th>REVISION</th> <th>DATE</th> <th>DTL'D</th> <th>CHK'D</th> </tr> </thead> <tbody> <tr> <td>ANCHOR FIELD MEASUREMENTS</td> <td>7/10/12</td> <td>AMT</td> <td>JCC</td> </tr> </tbody> </table>	REVISION	DATE	DTL'D	CHK'D	ANCHOR FIELD MEASUREMENTS	7/10/12	AMT	JCC	<b>OWNER:</b> OHIO DEPARTMENT OF TRANSPORTATION <b>CONSULTANT:</b> HNTB <b>CONTRACTOR:</b> WALSH CONSTRUCTION COMPANY	<b>TITLE:</b> DB2650F MASONRY PLATE CONTRACTOR VERIFIED HOLE DIMENSIONS DTL'D BY: JSM/AMT DATE: 7-9-12 CHK'D BY: JCC DATE: 7-10-12 BEARING TYPE: DISKTRON
REVISION	DATE	DTL'D	CHK'D								
ANCHOR FIELD MEASUREMENTS	7/10/12	AMT	JCC								

ALL DIMENSIONS IN INCHES