



FORM DQP 2.01-1
LEVEL 1 CHECK PRINT SIGN-OFF SHEET

Client Name: Ohio Department of Transportation
 Job Title: Cleveland Innerbelt Design-Build Contract
 Job Number: CUY-90-14.90

Document Title: Erection Bolt Revised - Diaphragm connection

Check Level (Mark One): 1A 100% Document Check
 1B 100% Input Check

check

Enter description below:

	Print Name	Signature	Date
<input checked="" type="checkbox"/> Originator	<u>SARAH LARSON</u>	<u>Sarah Larson</u>	<u>9-14-11</u>
<input checked="" type="checkbox"/> Checker	<u>Jim Truesdell</u>	<u>Jim Truesdell</u>	<u>9/16/11</u>
<input checked="" type="checkbox"/> Backchecker	<u>SARAH LARSON</u>	<u>Sarah Larson</u>	<u>9-16-11</u>
<input checked="" type="checkbox"/> Updater	<u>SARAH LARSON</u>	<u>Sarah Larson</u>	<u>9-16-11</u>
<input checked="" type="checkbox"/> Validator	<u>Jim Truesdell</u>	<u>Jim Truesdell</u>	<u>9/16/11</u>

Insert an "X" in the box to indicate a required QC activity.



The HNTB Companies
Engineers Architects

Made	SJL	Date	9/8/2011	Job Number	49633
Checked	JBT	Date	9/13/2011		
For	Cleveland Innerbelt	Backch'k'd	SJL	Date	9/15/2011
				Sheet No.	

(TYPE A)

**1-Stringer Standard Diaphragm Connection
Unit 2 (Lateral Bracing Revision)**

Connection Geometry

$n_{col} = 3$
 $s_{col} = 3.25$ in
 $s_{row} = 3.875$ in
 $gap = 0.50$ in
 $d_{edge} = 2.00$ in

$n_{bolt} = 21$
 $I_x = 8519.2$ in²
 $I_y = 55.3$ in²
 $I_p = 8574.6$ in²
 $eh = 1.55$ in
 $ev = 16.86$ in
 $x_{max} = 1.55$ in
 $y_{max} = 36.33$ in
 $r_{max} = 36.4$ in

Bolt Capacity

Slip Resistance (6.13.2.8)

$$R_n = K_h * K_s * N_s * P_t$$

$K_h = 0.85$ Oversize holes (Table 6.13.2.8-2)
 $K_s = 0.5$ Class B Surface (Table 6.13.2.8-3)
 $N_s = 2$
 $P_t = 51$ kip (Table 6.13.2.8-1)
 $\phi_s = 1.00$ (6.13.2.2)
 $\phi R_n = 43.35$

Factored Member Forces

Service II

$P_u = -6.9$ kip
 $M_u = 788.3$ kip-ft
 $V_u = -27.5$ kip

Bolt Forces

Service II

Total M = $M_u + V_u * e = 9673$ kip-in
 $M * y_{max} / I_p = 41.0$ kip
 $F_x = P_u / n_{bolt} = 0.3$ kip
 $F_x = 41.3$ kip
 $M * x_{max} / I_p = 1.7$ kip
 $F_y = V_u / n_{bolt} = 1.3$ kip
 $F_y = 3.1$ kip
 Resultant F = 41.4 kip
 $41.4 \text{ kip} < 43.4 \text{ kip, OK}$

HNTB The HNTB Companies Engineers Architects	Made	SJL	Date	9/8/2011	Job Number	49633
	Checked	JBT	Date	9/13/2011		
	For	Cleveland Innerbelt	Backchk'd	SJL	Date	9/15/2011

1-Stringer Standard Diaphragm Connection

Ip calculation

knee-brace bolt row = 3.4500 in

	column 1	column 2	column 3	distance from centroid (dy)	(from centroid) dx	lxi	lyi			Ybar ⁱ	
row 1	1	1		26.54		1409.2	5.3	19.375	9	34.5	62.875
row 2	1	1		22.669		1027.8	5.3	15.50	9	34.5	59
row 3	1	1		18.794		706.4	5.3	11.63	9	34.5	55.125
row 4	1			14.919		222.6	2.4	7.75	9	34.5	51.25
row 5	1	1		11.044		243.9	5.3	3.88	9	34.5	47.375
row 6	1	1		7.169		102.8	5.3	0.00	9	34.5	43.5
row 7		1		-1.831		3.4	2.9			34.5	34.5
row 8	1			-5.281		27.9	2.4			31.05	31.05
row 9		1		-8.731		76.2	2.9			27.60	27.6
row 10	1			-12.181		148.4	2.4			24.15	24.15
row 11		1		-15.631		244.3	2.9			20.70	20.7
row 12	1			-19.081		364.1	2.4			17.25	17.25
row 13				-22.531		0.0	0.0			13.80	13.8
row 14	1			-25.981		675.0	2.4			10.35	10.35
row 15		1		-29.431		866.2	2.9			6.90	6.9
row 16	1			-32.881		1081.2	2.4			3.45	3.45
row 17		1		-36.331		1319.9	2.9			0.00	4.441E-15
row 18						0.0	0.0				0
row 19						0.0	0.0				0
row 20						0.0	0.0				0
row 21						0.0	0.0				0.00
row 22						0.0	0.0				0.00
row 23						0.0	0.0				0.00
row 24						0.0	0.0				0.00
row 25						0.0	0.0				0.00
row 26						0.0	0.0				0.00
row 27						0.0	0.0				0.00
row 28						0.0	0.0				0.00

Total # bolts = 21

8519.2 55.3

$\Sigma y_{bar}^i \cdot n_i / n = 36.330952$

$I_p = 8574.6$

$\bar{x} = 1.548$ in

1-Stringer Standard Diaphragm Design
Check web for connection (Final Forces)

(AASHTO 6.13.4)

Check for Block ShearHorizontal Force = **153.0** kips
Resultant factored force = 153.00 kipsYielding in gross section, $\Phi_y =$ **0.95**
Fracture in net section, $\Phi_u =$ **0.80**
(Use thickness of kneebrace, conservative)
web thickness = **0.6250** in
Bolt hole dia. = **1.1250** in
Rows of Bolts = **6**
Columns of Bolts = **2**

Length of Block Shear Failure Planes

Gross Vertical Length = **19.375** in
Gross Horizontal Length = **5.25** in
Net Vertical Length = **13.75** in
Net Horizontal Length = **3.56** in
 $F_y =$ **50.0** ksi
 $F_u =$ **65.0** ksi

$$R_r = \Phi_{bs} R_p (0.58 F_u A_{vn} + U_{bs} F_u A_{tn}) \leq \Phi_{bs} R_p (0.58 F_y A_{vg} + U_{bs} F_u A_{tn})$$

Block Shear Factor, $\Phi_{bs} =$ **0.80**
 $R_p =$ **1.00**
 $U_{bs} =$ **0.50****Block Shear**
Horizontal Force
 $A_{gv} =$ 3.28 in²
 $A_{nv} =$ 2.23 in²
 $A_{nt} =$ 8.59 in²
 $R_r =$ 290.6 k**OK for Block Shear****Check for Bearing Resistance at Bolt Holes**

For bolts spaced at a clear distance between holes not less than 2.0d and with a clear end distance not less than 2.0 d:

$$\text{Bolt Capacity} = \Phi R_n = \Phi 2.4dF_u t \quad (\text{eqn. 6.13.2.9-1})$$

If either the clear distance between holes is less than 2.0d, or the clear end distance is less than 2.0d:

$$\text{Bolt Capacity} = \Phi R_n = \Phi 1.2L_c F_u t \quad (\text{eqn. 6.13.2.9-2})$$

 $\Phi =$ **0.80**
 $F_u =$ **65** (Grade 50, AASHTO 6.4.1-1)
 $t =$ **0.6250** in
 $d =$ **1.000** in
End clear spacing = **1.69** in
clear Bolt spacing = **2.13** in
 $L_c =$ **1.69** (shear planes)
 $\Phi R_n =$ **65.81** kips/boltMax Resultant force on bolt = **56.20** kipsCheck Bearing at Bolt Holes = **OK****Need to change web End Clear distance from 2" to 2.25"**

**1-Stringer Standard Diaphragm (Final Forces)
Stiffener/Connection Plate Design**

(AASHTO 6.13.4)

Check for Block Shear

Check failure plane of bolts in diaphragm only (not including knee-brace, conservative)

Vertical Force = **148.0** kips

Horizontal Force = **153.0** kips

Resultant factored force = **212.9** kips

Yielding in gross section, $\Phi_y =$ **0.95**

Fracture in net section, $\Phi_u =$ **0.80**

(Assume 3/4" thickness, conservative)

thickness = **0.750** in

Bolt hole dia. = **1.2500** in

Rows of Bolts = **6**

Columns of Bolts = **2**

Length of Block Shear Failure Planes

Gross Vertical Length = **19.38** in

Gross Horizontal Length = **5.25** in

Net Vertical Length = **13.13** in

Net Horizontal Length = **3.38** in

$F_y =$ **50.0** ksi

$F_u =$ **65.0** ksi

$$R_r = \Phi_{bs} R_p (0.58 F_u A_{vn} + U_{bs} F_u A_{tn}) \leq \Phi_{bs} R_p (0.58 F_y A_{vg} + U_{bs} F_u A_{tn})$$

Block Shear Factor, $\Phi_{bs} =$ **0.80**

$R_p =$ **1.00**

$U_{bs} =$ **0.50**

Block ShearHorizontal Force

$A_{gv} =$ **7.88** in²

$A_{nv} =$ **5.06** in²

$A_{nt} =$ **9.84** in²

$R_r =$ **408.6** k

OK for Block Shear**Check for Bearing Resistance at Bolt Holes**

For bolts spaced at a clear distance between holes not less than 2.0d and with a clear end distance not less than 2.0 d:

Bolt Capacity = $\Phi R_n = \Phi 2.4dF_u t$ (eqn. 6.13.2.9-1)

If either the clear distance between holes is less than 2.0d, or the clear end distance is less than 2.0d:

Bolt Capacity = $\Phi R_n = \Phi 1.2L_c F_u t$ (eqn. 6.13.2.9-2)

$\Phi =$ **0.80**

$F_u =$ **65** (Grade 50, AASHTO 6.4.1-1)

$t =$ **0.7500** in

$d =$ **1.000** in

End clear spacing = **1.38** in

clear Bolt spacing = **2.00** in

$L_c =$ **1.38** (shear planes)

$\Phi R_n =$ **64.35** kips/bolt

Max Resultant force on bolt = **56.20** kips

Check Bearing at Bolt Holes = **OK**

For Cleveland Innerbelt	HNTB	The HNTB Companies	Made	SJL	Date	9/8/2011	Job Number	49633
			Checked	JBT	Date	9/12/2011		
			Backch'kd	SJL	Date	9/15/2011	Sheet No.	

NY check

Type B Diaphragm Connection
Unit 2 (Lateral Bracing Revision)

Connection Geometry

$n_{col} = 3$
 $s_{col} = 3.25$ in
 $s_{row} = 3.250$ in
 $gap = 0.50$ in
 $d_{edge} = 2.00$ in

$n_{bolt} = 47$
 $I_x = 32800.1$ in²
 $I_y = 121.5$ in²
 $I_p = 32921.6$ in²
 $eh = 1.59$ in
 $ev = 32.40$ in
 $x_{max} = 1.59$ in
 $y_{max} = 46.35$ in
 $r_{max} = 46.4$ in

Bolt Capacity

Slip Resistance (6.13.2.8)

$$R_n = K_h * K_s * N_s * P_t$$

$K_h = 0.85$ Oversize holes (Table 6.13.2.8-2)
 $K_s = 0.5$ Class B Surface (Table 6.13.2.8-3)
 $N_s = 2$
 $P_t = 51$ kip (Table 6.13.2.8-1)
 $\phi_s = 1.00$ (6.13.2.2)
 $\phi R_n = 43.35$

Factored Member Forces

Service II

$P_u = -176.4$ kip
 $M_u = 2078.0$ kip-ft
 $V_u = -154.0$ kip

Bolt Forces

Service II

Total M = $M_u + V_u * e = 27743$ kip-in
 $M * y_{max} / I_p = 39.1$ kip
 $F_x = P_u / n_{bolt} = 3.8$ kip
 $F_x = 42.8$ kip
 $M * x_{max} / I_p = 1.3$ kip
 $F_y = V_u / n_{bolt} = 3.3$ kip
 $F_y = 4.6$ kip
Resultant F = 43.1 kip
43.1 kip < 43.4 kip, OK

For	Cleveland Innerbelt	HNTB	The HNTB Companies	Made	SJL	Date	9/8/2011	Job Number	49633
				Checked	JBT	Date	9/12/2011		
				Backch'kd	SJL	Date	9/15/2011	Sheet No.	

Type B Diaphragm Connection
Ip calculation

knee-brace bolt row = 1.7140 in

	column 1	column 2	column 3	(from centroid) dx	lxi	lyi				y_{bar}^i
			distance from centroid (dy)							
row 1	1	1	40.52	1.63	3284.0	5.3	52	10.875	23.996	86.871
row 2	1	1	37.271	1.625	2778.3	5.3	48.75	10.875	23.996	83.621
row 3	1	1	34.021	1.625	2314.9	5.3	45.50	10.875	23.996	80.371
row 4	1	1	30.771	1.625	1893.8	5.3	42.25	10.875	23.996	77.121
row 5	1	1	27.521	1.625	1514.9	5.3	39.00	10.875	23.996	73.871
row 6	1	1	24.271	1.625	1178.2	5.3	35.75	10.875	23.996	70.621
row 7	1	1	21.021	1.625	883.8	5.3	32.50	10.875	23.996	67.371
row 8	1	1	17.771	1.625	631.6	5.3	29.25	10.875	23.996	64.121
row 9	1		14.521	1.625	210.9	0.0	26.00	10.875	23.996	60.871
row 10	1	1	11.271	1.625	254.1	5.3	22.75	10.875	23.996	57.621
row 11	1	1	8.021	1.625	128.7	5.3	19.50	10.875	23.996	54.371
row 12	1	1	4.771	1.625	45.5	5.3	16.25	10.875	23.996	51.121
row 13	1	1	1.521	1.625	4.6	5.3	13.00	10.875	23.996	47.871
row 14	1	1	-1.729	1.625	6.0	5.3	9.75	10.875	23.996	44.621
row 15	1	1	-4.979	1.625	49.6	5.3	6.50	10.875	23.996	41.371
row 16	1	1	-8.229	1.625	135.4	5.3	3.25	10.875	23.996	38.121
row 17	1	1	-11.479	1.625	263.5	5.3	0.00	10.875	23.996	34.871
row 18		1	-22.354	1.625	499.7	2.8			23.996	23.996
row 19	1		-24.068	1.625	579.2	2.5			22.28	22.282
row 20		1	-25.782	1.625	664.7	2.8			20.57	20.568
row 21	1		-27.496	1.625	756.0	2.5			18.85	18.85
row 22		1	-29.210	1.625	853.2	2.8			17.14	17.14
row 23	1		-30.924	1.625	956.3	2.5			15.43	15.43
row 24		1	-32.638	1.625	1065.2	2.8			13.71	13.71
row 25	1		-34.352	1.625	1180.0	2.5			12.00	12.00
row 26			-36.066	1.625	0.0	0.0			10.28	10.28
row 27	1		-37.780	1.625	1427.3	2.5			8.57	8.57
row 28		1	-39.494	1.625	1559.7	2.8			6.86	6.86
row 29	1		-41.208	1.625	1698.1	2.5			5.14	5.14
row 30		1	-42.922	1.625	1842.3	2.8			3.43	3.43
row 31	1		-44.636	1.625	1992.3	2.5			1.71	1.71
row 32		1	-46.350	1.625	2148.3	2.8			0.00	0.00
row 33										

Total # bolts = 47

32800.1 121.5

$\Sigma y_{bar}^i \cdot n_i / n = 46.349553$

$I_p = 32921.6$

$\bar{x} = 1.590$ in

Made	SJL	Date	9/8/2011	Job Number	49633
Checked	JBT	Date	9/12/2011		
Backchk'd	SJL	Date	9/15/2011	Sheet No.	

Delta Diaphragm Design (Lateral Bracing Revision)
Check web for connection

(AASHTO 6.13.4)

Check for Block Shear

Horizontal Force = **533.0** kips
 Resultant factored force = **533.00** kips

Yielding in gross section, $\Phi_y =$ **0.95**
 Fracture in net section, $\Phi_u =$ **0.80**

web thickness = **0.625** in
 Bolt hole dia. = **1.1250** in
 Rows of Bolts = **17**
 Columns of Bolts = **2**

Length of Block Shear Failure Planes

Gross Vertical Length = **52.00** in
 Gross Horizontal Length = **5.25** in
 Net Vertical Length = **34.00** in
 Net Horizontal Length = **3.56** in
 $F_y =$ **50.0** ksi
 $F_u =$ **65.0** ksi

$$R_r = \Phi_{bs} R_p (0.58 F_u A_{gv} + U_{bs} F_u A_{nt}) \leq \Phi_{bs} R_p (0.58 F_y A_{gv} + U_{bs} F_u A_{nt})$$

Block Shear Factor, $\Phi_{bs} =$ **0.80**
 $R_p =$ **1.00**
 $U_{bs} =$ **0.50**

Block Shear
Horizontal Force
 $A_{gv} =$ **3.28** in²
 $A_{nt} =$ **2.23** in²
 $A_{nt} =$ **21.25** in²
 $R_r =$ **619.7** k

OK for Block Shear

Check for Bearing Resistance at Bolt Holes

For bolts spaced at a clear distance between holes not less than 2.0d and with a clear end distance not less than 2.0 d:

$$\text{Bolt Capacity} = \Phi R_n = \Phi 2.4 d F_u t \quad (\text{eqn. 6.13.2.9-1})$$

If either the clear distance between holes is less than 2.0d, or the clear end distance is less than 2.0d:

$$\text{Bolt Capacity} = \Phi R_n = \Phi 1.2 L_c F_u t \quad (\text{eqn. 6.13.2.9-2})$$

$\Phi =$ **0.80**
 $F_u =$ **65** (Grade 50, AASHTO 6.4.1-1)
 $t =$ **0.6250** in
 $d =$ **1.000** in
 End clear spacing = **1.44** in
 clear Bolt spacing = **2.13** in
 $L_c =$ **1.44** (shear planes)
 $\Phi R_n =$ **56.06** kips/bolt

Max Resultant force on bolt = **53.90** kips

Check Bearing at Bolt Holes = **OK**

Delta Stiffener/Connection Plate Design (Lateral Bracing Revision)

(AASHTO 6.13.4)

Check for Block Shear

Check failure plane of bolts in diaphragm only (not including knee-brace, conservative)

Vertical Force = **247.0** kips

Horizontal Force = **533.0** kips

Resultant factored force = **587.45** kips

Yielding in gross section, $\Phi_y =$ **0.95**

Fracture in net section, $\Phi_u =$ **0.80**

(Assume 3/4" thickness, conservative)

thickness = **0.750** in

Bolt hole dia. = **1.2500** in

Rows of Bolts = **17**

Columns of Bolts = **2**

Length of Block Shear Failure Planes

Gross Vertical Length = **52.00** in

Gross Horizontal Length = **5.25** in

Net Vertical Length = **32.00** in

Net Horizontal Length = **3.38** in

$F_y =$ **50.0** ksi

$F_u =$ **65.0** ksi

$$R_r = \Phi_{bs} R_p (0.58 F_u A_{vn} + U_{bs} F_u A_{tn}) \leq \Phi_{bs} R_p (0.58 F_y A_{vg} + U_{bs} F_u A_{tn})$$

Block Shear Factor, $\Phi_{bs} =$ **0.80**

$R_p =$ **1.00**

$U_{bs} =$ **0.50**

Block Shear
Horizontal Force

$A_{gv} =$ **7.88** in²

$A_{nv} =$ **5.06** in²

$A_{nt} =$ **24.00** in²

$R_r =$ **776.7** k

OK for Block Shear**Check for Bearing Resistance at Bolt Holes**

For bolts spaced at a clear distance between holes not less than 2.0d and with a clear end distance not less than 2.0 d:

Bolt Capacity = $\Phi R_n = \Phi 2.4dF_u t$ (eqn. 6.13.2.9-1)

If either the clear distance between holes is less than 2.0d, or the clear end distance is less than 2.0d:

Bolt Capacity = $\Phi R_n = \Phi 1.2L_c F_u t$ (eqn. 6.13.2.9-2)

$\Phi =$ **0.80**

$F_u =$ **65** (Grade 50, AASHTO 6.4.1-1)

$t =$ **0.7500** in

$d =$ **1.000** in

End clear spacing = **1.38** in

clear Bolt spacing = **2.00** in

$L_c =$ **1.38** (shear planes)

$\Phi R_n =$ **64.35** kips/bolt

Max Resultant force on bolt = **53.90** kips

Check Bearing at Bolt Holes = **OK**

(TYPE C)**2-Stringer Standard Diaphragm Connection****Unit 2 (Lateral Bracing Revision)**Connection Geometry

$$\begin{aligned} n_{col} &= 3 \\ s_{col} &= 3.25 \text{ in} \\ s_{row} &= 3.250 \text{ in} \\ gap &= 0.50 \text{ in} \\ d_{edge} &= 2.00 \text{ in} \end{aligned}$$

$$\begin{aligned} n_{bolt} &= 35 \\ I_x &= 17607.0 \text{ in}^2 \\ I_y &= 89.9 \text{ in}^2 \\ I_p &= 17696.9 \text{ in}^2 \\ ev &= 9.90 \text{ in} \\ eh &= 1.58 \text{ in} \\ x_{max} &= 1.58 \text{ in} \\ y_{max} &= 46.60 \text{ in} \\ r_{max} &= 46.6 \text{ in} \end{aligned}$$

Bolt CapacitySlip Resistance (6.13.2.8)

$$R_n = K_h * K_s * N_s * P_t$$

$$\begin{aligned} K_h &= 0.85 && \text{Oversize holes (Table 6.13.2.8-2)} \\ K_s &= 0.5 && \text{Class B Surface (Table 6.13.2.8-3)} \\ N_s &= 2 \\ P_t &= 51 \text{ kip} && \text{(Table 6.13.2.8-1)} \\ \phi_s &= 1.00 && \text{(6.13.2.2)} \end{aligned}$$

$$\phi R_n = 43.35$$

Factored Member ForcesService II

$$\begin{aligned} P_u &= -2.5 \text{ kip} \\ M_u &= 1276.3 \text{ kip-ft} \\ V_u &= 36.3 \text{ kip} \end{aligned}$$

Bolt ForcesService II

$$\begin{aligned} \text{Total } M &= M_u + V_u * e = 15283 \text{ kip-in} \\ M * y_{max} / I_p &= 40.2 \text{ kip} \\ F_x = P_u / n_{bolt} &= 0.1 \text{ kip} \\ F_x &= 40.3 \text{ kip} \\ M * x_{max} / I_p &= 1.4 \text{ kip} \\ F_y = V_u / n_{bolt} &= 1.0 \text{ kip} \\ F_y &= 2.4 \text{ kip} \\ \text{Resultant } F &= 40.4 \text{ kip} \\ &= 40.4 \text{ kip} < 43.4 \text{ kip, OK} \end{aligned}$$



The HNTB Companies
Engineers Architects

Made	SJL	Date	9/15/2011	Job Number	49633
Checked	JBT	Date	9/15/2011		
For	Cleveland Innerbelt	Backchk'd	SJL	Date	9/15/2011
				Sheet No.	

2-Stringer Standard Diaphragm Connection

Ip calculation

knee-brace bolt row = 3.2500 in

	column 1	column 2	column 3	(from centroid) dx	lxi	lyi				y_{bar}^i
				distance from centroid (dy)						
row 1	1	1		31.02	1924.7	5.3	42.25	9.375	26	77.625
row 2	1	1		27.771	1542.5	5.3	39.00	9.375	26	74.375
row 3	1	1		24.521	1202.6	5.3	35.75	9.375	26	71.125
row 4	1	1		21.271	904.9	5.3	32.50	9.375	26	67.875
row 5	1	1		18.021	649.5	5.3	29.25	9.375	26	64.625
row 6	1	1		14.771	436.4	5.3	26.00	9.375	26	61.375
row 7	1	1		11.521	265.5	5.3	22.75	9.375	26	58.125
row 8	1	1		8.271	136.8	5.3	19.50	9.375	26	54.875
row 9	1	1		5.021	50.4	5.3	16.25	9.375	26	51.625
row 10	1	1		1.771	3.1	0.0	13.00	9.375	26	48.375
row 11	1	1		-1.479	4.4	5.3	9.75	9.375	26	45.125
row 12	1	1		-4.729	44.7	5.3	6.50	9.375	26	41.875
row 13	1	1		-7.979	127.3	5.3	3.25	9.375	26	38.625
row 14	1	1		-11.229	252.2	5.3	0.00	9.375	26	35.375
row 15		1		-20.604	424.5	2.8			26	26
row 16	1			-23.854	569.0	2.5			22.75	22.75
row 17				-27.104	0.0	0.0			19.50	19.5
row 18	1			-30.354	921.3	2.5			16.25	16.25
row 19		1		-33.604	1129.2	2.8			13.00	13
row 20	1			-36.854	1358.2	2.5			9.75	9.75
row 21		1		-40.104	1608.3	2.8			6.50	6.50
row 22	1			-43.354	1879.5	2.5			3.25	3.25
row 23		1		-46.604	2171.9	2.8			0.00	0.00
row 24					0.0	0.0				0.00
row 25					0.0	0.0				0.00
row 26					0.0	0.0				0.00
row 27					0.0	0.0				0.00
row 28					0.0	0.0				0.00

Total # bolts = 35

17607.0 89.9

$\Sigma y_{bar}^i * n_i / n = 46.603571$

$I_p = 17696.9$

$\bar{x} = 1.579$

Made	SJL	Date	9/15/2011	Job Number	49633
Checked	JBT	Date	9/15/2011		
Backchk'd	SJL	Date	9/15/2011	Sheet No.	

2-Stringer Standard Diaphragm Design

**Check web for connection
(Lateral Bracing Revision)**

(AASHTO 6.13.4)

Check for Block Shear

Horizontal Force = 225.0 kips
Resultant factored force = 225.00 kips

Yielding in gross section, $\Phi_y = 0.95$
Fracture in net section, $\Phi_u = 0.80$

web thickness = 0.4375 in
Bolt hole dia. = 1.1250 in
Rows of Bolts = 14
Columns of Bolts = 2

Length of Block Shear Failure Planes

Gross Vertical Length = 42.25 in
Gross Horizontal Length = 5.75 in
Net Vertical Length = 27.63 in
Net Horizontal Length = 4.06 in
 $F_y = 50.0$ ksi
 $F_u = 65.0$ ksi

$$R_r = \Phi_{bs} R_p (0.58 F_u A_{vn} + U_{bs} F_u A_{tn}) \leq \Phi_{bs} R_p (0.58 F_y A_{vg} + U_{bs} F_u A_{tn})$$

Block Shear Factor, $\Phi_{bs} = 0.80$
 $R_p = 1.00$
 $U_{bs} = 0.50$

**Block Shear
Horizontal Force**

$A_{gv} = 2.52$ in²
 $A_{nv} = 1.78$ in²
 $A_{nt} = 12.09$ in²
 $R_r = 367.8$ k

OK for Block Shear

Check for Bearing Resistance at Bolt Holes

For bolts spaced at a clear distance between holes not less than 2.0d and with a clear end distance not less than 2.0 d:

$$\text{Bolt Capacity} = \Phi R_n = \Phi 2.4dF_u t \quad (\text{eqn. 6.13.2.9-1})$$

If either the clear distance between holes is less than 2.0d, or the clear end distance is less than 2.0d:

$$\text{Bolt Capacity} = \Phi R_n = \Phi 1.2L_c F_u t \quad (\text{eqn. 6.13.2.9-2})$$

$\Phi = 0.80$
 $F_u = 65$ (Grade 50, AASHTO 6.4.1-1)
 $t = 0.4375$ in
 $d = 1.000$ in
End clear spacing = 2.19 in
clear Bolt spacing = 2.13 in
 $L_c = 2.13$ (shear planes)
 $\Phi R_n = 54.60$ kips/bolt

Max Resultant force on bolt = 54.60 kips

Check Bearing at Bolt Holes = **OK**

Need to change web End Clear distance from 2.5" to 2.75"

**2-Stringer Standard Diaphragm
Stiffener/Connection Plate Design
(Lateral Bracing Revision)**

(AASHTO 6.13.4)

Check for Block Shear

Check failure plane of bolts in diaphragm only (not including knee-brace, conservative)

$$\begin{aligned} \text{Vertical Force} &= 241.0 \text{ kips} \\ \text{Horizontal Force} &= 225.0 \text{ kips} \\ \text{Resultant factored force} &= 329.7 \text{ kips} \end{aligned}$$

$$\begin{aligned} \text{Yielding in gross section, } \Phi_y &= 0.95 \\ \text{Fracture in net section, } \Phi_u &= 0.80 \end{aligned}$$

(Assume 3/4" thickness, conservative)

$$\begin{aligned} \text{thickness} &= 0.750 \text{ in} \\ \text{Bolt hole dia.} &= 1.2500 \text{ in} \\ \text{Rows of Bolts} &= 14 \\ \text{Columns of Bolts} &= 2 \end{aligned}$$

Length of Block Shear Failure Planes

$$\begin{aligned} \text{Gross Vertical Length} &= 42.25 \text{ in} \\ \text{Gross Horizontal Length} &= 5.25 \text{ in} \\ \text{Net Vertical Length} &= 26.00 \text{ in} \\ \text{Net Horizontal Length} &= 3.38 \text{ in} \\ F_y &= 50.0 \text{ ksi} \\ F_u &= 65.0 \text{ ksi} \end{aligned}$$

$$R_r = \Phi_{bs} R_p (0.58 F_u A_{vn} + U_{bs} F_u A_{tn}) \leq \Phi_{bs} R_p (0.58 F_y A_{vg} + U_{bs} F_u A_{tn})$$

$$\begin{aligned} \text{Block Shear Factor, } \Phi_{bs} &= 0.80 \\ R_p &= 1.00 \\ U_{bs} &= 0.50 \end{aligned}$$

Block Shear
Horizontal Force

$$\begin{aligned} A_{gv} &= 7.88 \text{ in}^2 \\ A_{nv} &= 5.06 \text{ in}^2 \\ A_{nt} &= 19.50 \text{ in}^2 \\ R_r &= 659.7 \text{ k} \end{aligned}$$

OK for Block Shear**Check for Bearing Resistance at Bolt Holes**

For bolts spaced at a clear distance between holes not less than 2.0d and with a clear end distance not less than 2.0 d:

$$\text{Bolt Capacity} = \Phi R_n = \Phi 2.4dF_u t \quad (\text{eqn. 6.13.2.9-1})$$

If either the clear distance between holes is less than 2.0d, or the clear end distance is less than 2.0d:

$$\text{Bolt Capacity} = \Phi R_n = \Phi 1.2L_c F_u t \quad (\text{eqn. 6.13.2.9-2})$$

$$\begin{aligned} \Phi &= 0.80 \\ F_u &= 65 \text{ (Grade 50, AASHTO 6.4.1-1)} \\ t &= 0.7500 \text{ in} \\ d &= 1.000 \text{ in} \\ \text{End clear spacing} &= 1.38 \text{ in} \\ \text{clear Bolt spacing} &= 2.00 \text{ in} \\ L_c &= 1.38 \text{ (shear planes)} \\ \Phi R_n &= 64.35 \text{ kips/bolt} \end{aligned}$$

$$\text{Max Resultant force on bolt} = 54.60 \text{ kips}$$

Check Bearing at Bolt Holes = **OK**

For	Cleveland Innerbelt	Made	SJL	Date	9/8/2011	Job Number	49633
		Checked	JBT	Date	9/13/2011		
		Backchk'd	SJL	Date	9/15/2011	Sheet No.	

**Type D Diaphragm Connection
Unit 2 (Lateral Bracing Revision)**

Connection Geometry

$n_{col} = 3$
 $s_{col} = 3.25$ in
 $s_{row} = 3.250$ in
 $gap = 0.50$ in
 $d_{edge} = 2.00$ in

$n_{bolt} = 61$
 $I_x = 27964.5$ in²
 $I_y = 421.8$ in²
 $I_p = 28386.3$ in²
 $eh = 3.14$ in
 $ev = 25.19$ in
 $x_{max} = 3.14$ in
 $y_{max} = 38.68$ in
 $r_{max} = 38.8$ in

Bolt Capacity

Slip Resistance (6.13.2.8)

$$R_n = K_h * K_s * N_s * P_t$$

$K_h = 0.85$

Oversize holes (Table 6.13.2.8-2)

$K_s = 0.5$

Class B Surface (Table 6.13.2.8-3)

$N_s = 2$

$P_t = 51$ kip

(Table 6.13.2.8-1)

$\phi_s = 1.00$

(6.13.2.2)

$$\phi R_n = 43.35$$

Factored Member Forces

Service II

$P_u = -176.4$ kip
 $M_u = 2078.0$ kip-ft
 $V_u = -154.0$ kip

Bolt Forces

Service II

$Total M = M_u + V_u * e = 26711$ kip-in
 $M * y_{max} / I_p = 36.4$ kip
 $F_x = P_u / n_{bolt} = 2.9$ kip
 $F_x = 39.3$ kip
 $M * x_{max} / I_p = 3.0$ kip
 $F_y = V_u / n_{bolt} = 2.5$ kip
 $F_y = 5.5$ kip
 $Resultant F = 39.7$ kip
39.7 kip < 43.4 kip, OK

For	Cleveland Innerbelt	The HNTB Companies Engineers Architects Planners	Made	SJL	Date	9/8/2011	Job Number	49633
			Checked	JBT	Date	9/13/2011	Sheet No.	
			Backchk'd	SJL	Date	9/15/2011		

Type D Diaphragm Connection

Ip calculation

knee-brace bolt row = 3.5000 in

	column 1	column 2	column 3	distance from centroid (dy)	(from centroid) dx	lxi	lyi			Ybar ⁱ	
row 1	1	1	1	33.32	3.25	3330.6	21.2	52	9.5	10.5	72
row 2	1	1	1	30.070	3.25	2712.6	21.2	48.75	9.5	10.5	68.75
row 3	1	1	1	26.820	3.25	2157.9	21.2	45.50	9.5	10.5	65.5
row 4	1	1	1	23.570	3.25	1666.6	21.2	42.25	9.5	10.5	62.25
row 5	1	1	1	20.320	3.25	1238.7	21.2	39.00	9.5	10.5	59
row 6	1	1	1	17.070	3.25	874.1	21.2	35.75	9.5	10.5	55.75
row 7	1	1	1	13.820	3.25	573.0	21.2	32.50	9.5	10.5	52.5
row 8	1	1	1	10.570	3.25	335.2	21.2	29.25	9.5	10.5	49.25
row 9	1	1		7.320	3.25	107.2	9.9	26.00	9.5	10.5	46
row 10	1	1	1	4.070	3.25	49.7	21.2	22.75	9.5	10.5	42.75
row 11	1	1	1	0.820	3.25	2.0	21.2	19.50	9.5	10.5	39.5
row 12	1	1	1	-2.430	3.25	17.7	21.2	16.25	9.5	10.5	36.25
row 13	1	1	1	-5.680	3.25	96.8	21.2	13.00	9.5	10.5	33
row 14	1	1	1	-8.930	3.25	239.3	21.2	9.75	9.5	10.5	29.75
row 15	1	1	1	-12.180	3.25	445.1	21.2	6.50	9.5	10.5	26.5
row 16	1	1	1	-15.430	3.25	714.3	21.2	3.25	9.5	10.5	23.25
row 17	1	1	1	-18.680	3.25	1046.9	21.1	0.00	9.5	10.5	20
row 18	1	1	1	-28.180	3.25	2382.4	21.2			10.5	10.5
row 19	1	1	1	-31.680	3.25	3010.9	21.2			7.00	7
row 20	1	1		-35.180	3.25	2475.3	9.9			3.50	3.5
row 21	1	1	1	-38.680	3.25	4488.5	21.2			0.00	0.00
row 22					3.25	0.0	0.0				0.00
row 23					3.25	0.0	0.0				0.00
row 24					3.25	0.0	0.0				0.00
row 25					3.25	0.0	0.0				0.00
row 26					3.25	0.0	0.0				0.00
row 27					3.25	0.0	0.0				0.00
row 28					3.25	0.0	0.0				0.00
row 29					3.25	0.0	0.0				0.00
row 30					3.25	0.0	0.0				0.00
row 31					3.25	0.0	0.0				0.00
row 32					3.25	0.0	0.0				0.00
row 33					3.25	0.0	0.0				0.00

Modified Delta Diaphragm Design
(Lateral Bracing Revision)
Check web for connection

(AASHTO 6.13.4)

Check for Block Shear

Horizontal Force = **533.0** kips
 Resultant factored force = 533.00 kips

Yielding in gross section, $\Phi_y =$ **0.95**
 Fracture in net section, $\Phi_u =$ **0.80**

web thickness = **0.625** in
 Bolt hole dia. = **1.1250** in
 Rows of Bolts = **17**
 Columns of Bolts = **3**

Length of Block Shear Failure Planes

Gross Vertical Length = **52.00** in
 Gross Horizontal Length = **8.50** in
 Net Vertical Length = **34.00** in
 Net Horizontal Length = **5.69** in
 $F_y =$ **50.0** ksi
 $F_u =$ **65.0** ksi

$$R_r = \Phi_{bs} R_p (0.58 F_u A_{vn} + U_{bs} F_u A_{tn}) \leq \Phi_{bs} R_p (0.58 F_y A_{vg} + U_{bs} F_u A_{tn})$$

Block Shear Factor, $\Phi_{bs} =$ **0.80**
 $R_p =$ **1.00**
 $U_{bs} =$ **0.50**

Block Shear
Horizontal Force

$A_{gv} =$ 5.31 in²
 $A_{nv} =$ 3.55 in²
 $A_{nt} =$ 21.25 in²

$R_r =$ 659.7 k

OK for Block Shear**Check for Bearing Resistance at Bolt Holes**

For bolts spaced at a clear distance between holes not less than 2.0d and with a clear end distance not less than 2.0 d:

$$\text{Bolt Capacity} = \Phi R_n = \Phi 2.4dF_u t \quad (\text{eqn. 6.13.2.9-1})$$

If either the clear distance between holes is less than 2.0d, or the clear end distance is less than 2.0d:

$$\text{Bolt Capacity} = \Phi R_n = \Phi 1.2L_c F_u t \quad (\text{eqn. 6.13.2.9-2})$$

$\Phi =$ **0.80**
 $F_u =$ **65** (Grade 50, AASHTO 6.4.1-1)
 $t =$ **0.6250** in
 $d =$ **1.000** in
 End clear spacing = **1.44** in
 clear Bolt spacing = **2.13** in
 $L_c =$ **1.44** (shear planes)
 $\Phi R_n =$ **56.06** kips/bolt

Max Resultant force on bolt = **55.10** kips

Check Bearing at Bolt Holes = **OK**

Made	SJL	Date	9/8/2011	Job Number	49633
Checked	JBT	Date	9/13/2011		
Backchk'd	SJL	Date	9/15/2011	Sheet No.	

**Modified Delta Stiffener/Connection Plate Design
(Lateral Bracing Revision)**

(AASHTO 6.13.4)

Check for Block Shear

Check failure plane of bolts in diaphragm only (not including knee-brace, conservative)

Vertical Force = **247.0** kips
 Horizontal Force = **533.0** kips
 Resultant factored force = **587.45** kips

Yielding in gross section, $\Phi_y =$ **0.95**
 Fracture in net section, $\Phi_u =$ **0.80**

thickness = **1.000** in
 Bolt hole dia. = **1.2500** in
 Rows of Bolts = **17**
 Columns of Bolts = **3**

Length of Block Shear Failure Planes

Gross Vertical Length = **52.00** in
 Gross Horizontal Length = **8.50** in
 Net Vertical Length = **32.00** in
 Net Horizontal Length = **5.38** in
 $F_y =$ **50.0** ksi
 $F_u =$ **65.0** ksi

$$R_r = \Phi_{bs} R_p (0.58 F_u A_{vn} + U_{bs} F_u A_{tn}) \leq \Phi_{bs} R_p (0.58 F_y A_{vg} + U_{bs} F_u A_{tn})$$

Block Shear Factor, $\Phi_{bs} =$ **0.80**
 $R_p =$ **1.00**
 $U_{bs} =$ **0.50**

Block Shear
Horizontal Force

$A_{gv} =$ 17.00 in²
 $A_{nv} =$ 10.75 in²
 $A_{nt} =$ 32.00 in²
 $R_r =$ 1156.2 k

OK for Block Shear

Check for Bearing Resistance at Bolt Holes

For bolts spaced at a clear distance between holes not less than 2.0d and with a clear end distance not less than 2.0 d:

$$\text{Bolt Capacity} = \Phi R_n = \Phi 2.4dF_u t \quad (\text{eqn. 6.13.2.9-1})$$

If either the clear distance between holes is less than 2.0d, or the clear end distance is less than 2.0d:

$$\text{Bolt Capacity} = \Phi R_n = \Phi 1.2L_c F_u t \quad (\text{eqn. 6.13.2.9-2})$$

$\Phi =$ **0.80**
 $F_u =$ **65** (Grade 50, AASHTO 6.4.1-1)
 $t =$ **1.0000** in
 $d =$ **1.000** in
 End clear spacing = **1.38** in
 clear Bolt spacing = **2.00** in
 $L_c =$ **1.38** (shear planes)
 $\Phi R_n =$ **85.80** kips/bolt

Max Resultant force on bolt = **55.10** kips

Check Bearing at Bolt Holes = **OK**

UNIT 2 - DIAPHRAGMS

ERECTION BOLT COVER PL

→ Determine Required thickness for Erection Bolt cover PL to resist bending under Bolt tension force

Assume 50 ksi steel

$$50 \text{ ksi} = \sigma = \frac{m}{s} = \frac{m_u}{b t^2 / 6} = \frac{5.2 \text{ k} \cdot \text{in}}{(1'')(t)^2 / 6}$$

$$t \geq 0.79''$$

→ Bolt Tension Force for 1" ϕ Bolt
= 51k (AASHTO Tbl, 6.13.2.8.1)

Area under Washer:

$$A = \pi (2'')^2 / 4 = 3.14 \text{ in}^2$$

Area of 1 1/16" ϕ Hole:

$$A = \pi (1 \frac{1}{16}'')^2 / 4 = 0.887 \text{ in}^2$$

Check Shear:

$$\text{Shear Area} = \pi (2'') t = 6.28 t$$

Net Area under Washer:

$$= 3.14 \text{ in}^2 - 0.887 \text{ in}^2 = 2.25 \text{ in}^2$$

$$\phi V_n = \phi 0.58 F_y A \quad \phi = 1.0$$


$$\phi V_n = (1)(0.58)(50 \text{ ksi})(6.28'') t > 51k$$

$$\Rightarrow t > 0.28''$$

$$\text{Distributed Force} = \frac{51k}{2.25 \text{ in}^2} = 22.7 \text{ ksi}$$

→ Use t = 7/8" for Erection Bolt cover PL

Assume cover PL is a cantilever with 1" width

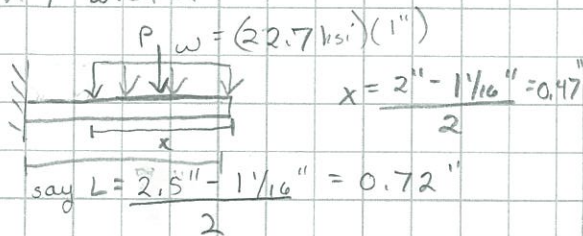

$$m_u = P_b = (22.7 \text{ k/in})(0.47'')(0.72'' - 0.47''/2)$$

$$m_u = 5.2 \text{ k} \cdot \text{in}$$


FLOORBEAM TYPE A, B, C, D, E, F, G

Erection Bolts

S3L 9-15-11

4BT 9-16-11


S3L 9-16-11

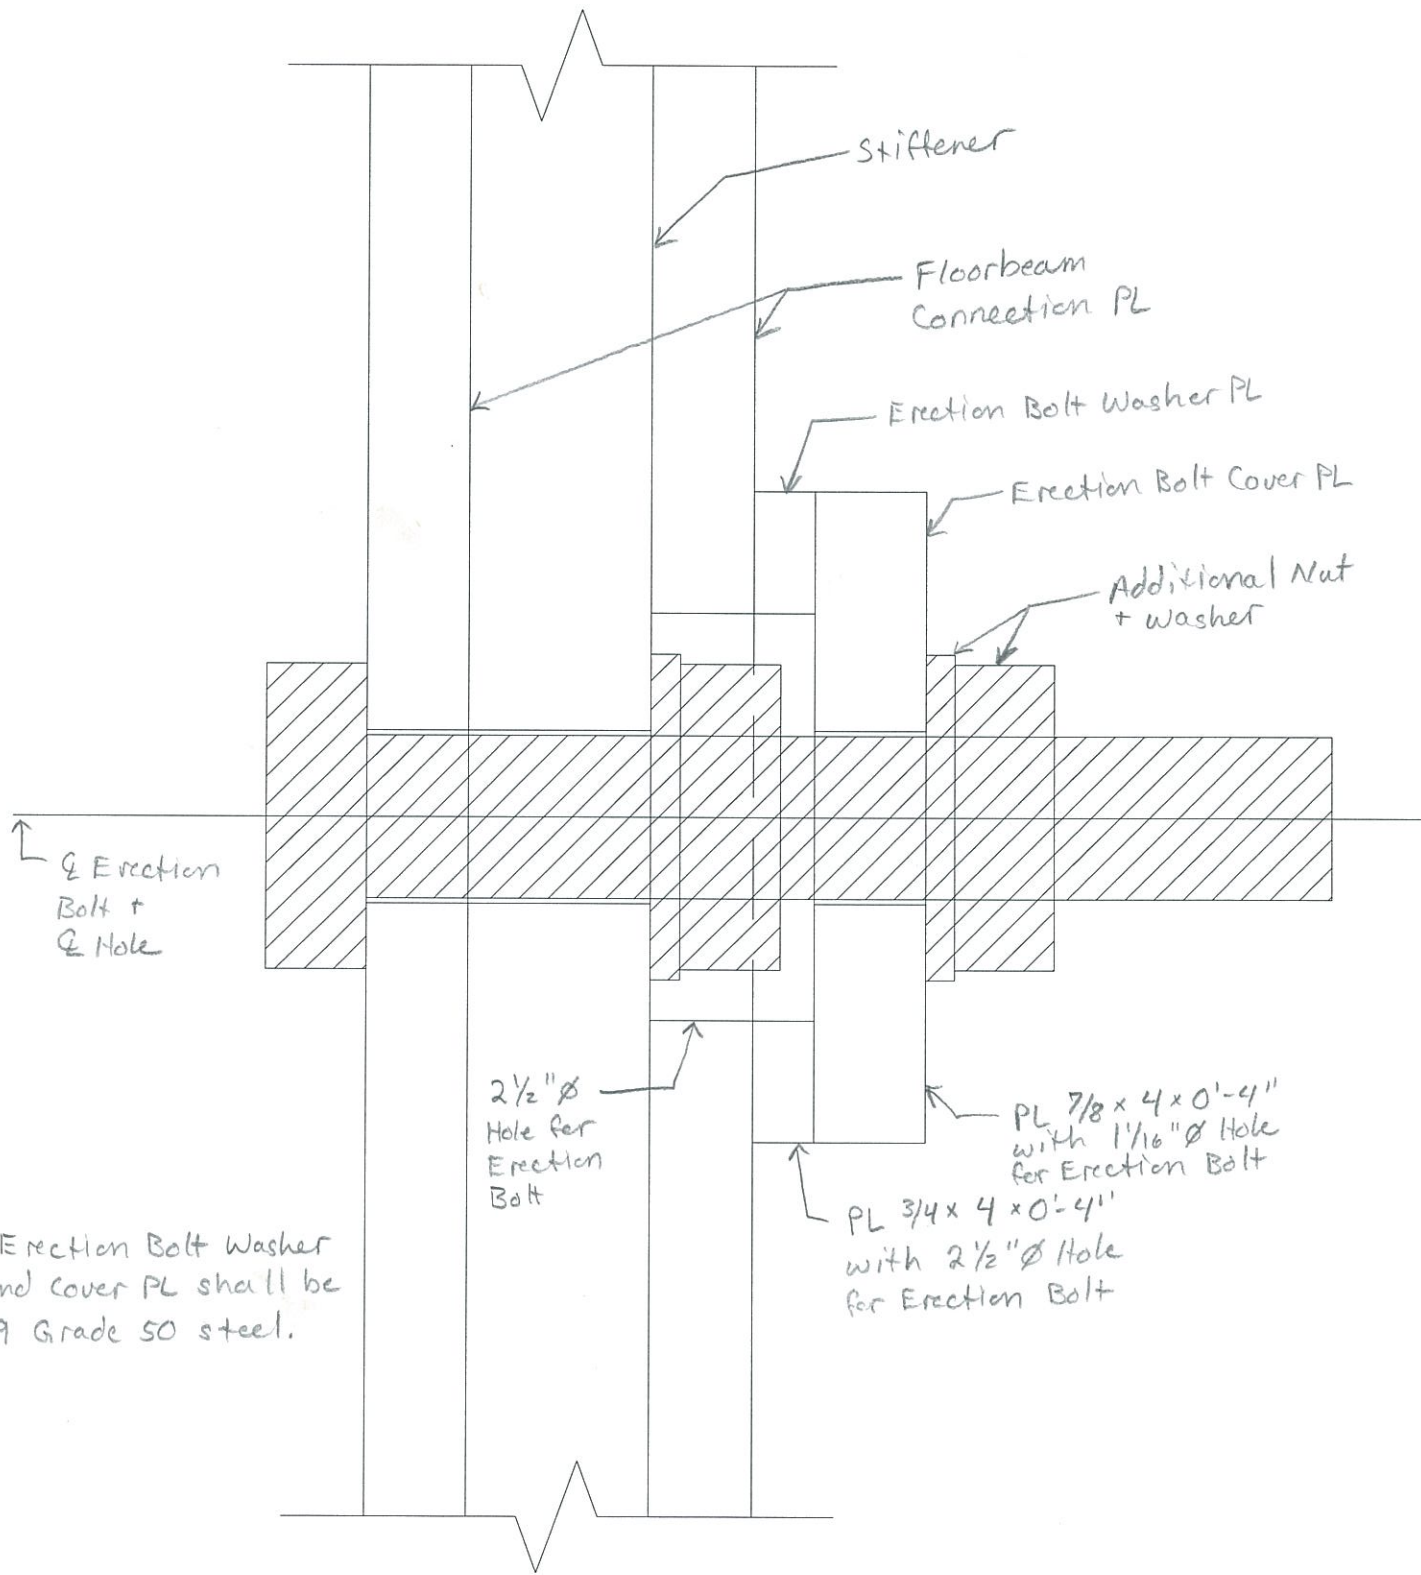

Note: Erection Bolt Washer PL and cover PL shall be A709 Grade 50 steel.


SECTION THRU ERECTION BOLT

Heavy Hex Heads

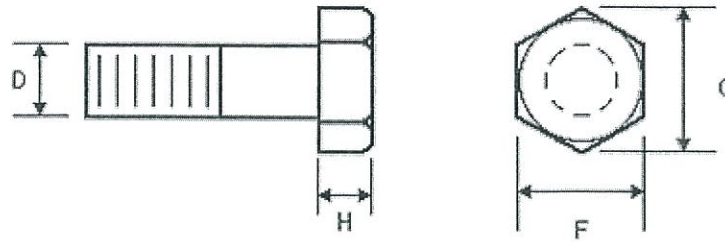

D	F	C	H
1/2	7/8	1	3/8
5/8	1-1/16	1-1/4	7/16
3/4	1-1/4	1-7/16	1/2
7/8	1-7/16	1-11/16	9/16
→ 1	1-5/8	1-7/8	11/16
1-1/8	1-13/16	2-1/16	3/4
1-1/4	2	2-5/16	7/8
1-3/8	2-3/16	2-1/2	15/16
1-1/2	2-3/8	2-3/4	1
1-3/4	2-3/4	3-3/16	1-3/16
2	3-1/8	3-5/8	1-3/8
2-1/4	3-1/2	4-1/16	1-1/2
2-1/2	3-7/8	4-1/2	1-11/16
2-3/4	4-1/4	4-15/16	1-13/16
3	4-5/8	5-5/16	2
All dimensions in inches			


Table 7-15
Dimensions of High-Strength Fasteners, in.

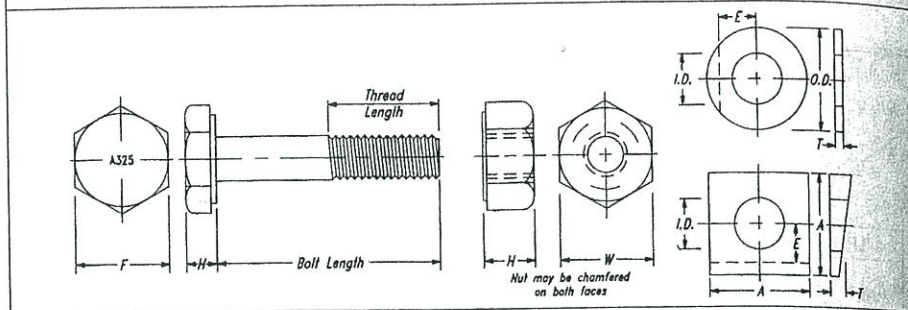

Measurement		Nominal Bolt Diameter, in									
		1/2	5/8	3/4	7/8	1	1 1/8	1 1/4	1 3/8	1 1/2	
A325 and A490 Bolts ^a	Width Across Flats, <i>F</i>	7/8	1 1/16	1 1/4	1 7/16	1 5/8	1 13/16	2	2 3/16	2 3/8	
	Height, <i>H</i>	5/16	25/64	15/32	35/64	39/64	11/16	25/32	27/32	5/16	
	Thread Length	1	1 1/4	1 3/8	1 1/2	1 3/4	2	2	2 1/4	2 1/4	
	Bolt Length = Grip + Washer Thickness + →	1 1/16	7/8	1	1 1/8	1 1/4	1 1/2	1 5/8	1 3/4	1 7/8	
A563 Nuts ^b	Width Across Flats, <i>W</i>	7/8	1 1/16	1 1/4	1 7/16	1 5/8	1 13/16	2	2 3/16	2 3/8	
	Height, <i>H</i>	31/64	39/64	47/64	55/64	63/64	17/64	17/32	11 1/16	11 1/32	
F436 Circular Washers ^c	Nom. Outside Diameter, <i>OD</i>	1 1/16	1 5/16	1 15/32	1 3/4	2	2 1/4	2 1/2	2 3/4	3	
	Nom. Inside Diameter, <i>ID</i>	17/32	1 1/16	1 3/16	1 5/16	1 1/8	1 1/4	1 3/8	1 1/2	1 5/8	
	Thckns., <i>T</i>	Min.	0.097	0.122	0.122	0.136	0.136	0.136	0.136	0.136	0.136
		Max.	0.177	0.177	0.177	0.177	0.177	0.177	0.177	0.177	0.177
	Min. Edge Distance, <i>E^d</i>	7/16	9/16	2 1/32	25/32	7/8	1	1 3/32	17/32	15/16	
F436 Square or Rect. Washers ^{c,e}	Min. Side Dimension, <i>A</i>	1 3/4	1 3/4	1 3/4	1 3/4	1 3/4	2 1/4	2 1/4	2 1/4	2 1/4	
	Mean Thickness, <i>T</i>	5/16	5/16	5/16	5/16	5/16	5/16	5/16	5/16	5/16	
	Taper in Thickness	2:12	2:12	2:12	2:12	2:12	2:12	2:12	2:12	2:12	
	Min. Edge Distance, <i>E^d</i>	7/16	9/16	2 1/32	25/32	7/8	1	1 3/32	17/32	15/16	

^a Tolerances as specified in ASTM A325 and A490.
^b Tolerances as specified in ASTM A563.
^c ASTM F436 Washer Tolerances, in.:
 Nominal Outside Diameter -1/32; +1/32
 Nominal Diameter of Hole -0; +1/32
 Flatness: max. deviation from straight-edge placed on cut side shall not exceed 0.010
 Concentricity: center of hole to outside diameter (full indicator runout) 0.030
 Burr shall not project above immediately adjacent washer surface more than 0.010
^d For clipped washers only.
^e For use with American standard beams (S) and channel (C).

Entering and Tigt
Conventional AST

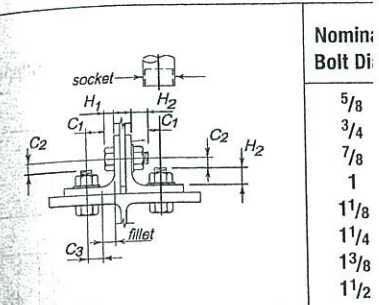





F	Nominal Bolt Di	
	5/8	1 1/2
1	15/8	1 1/2
1 1/8	1 1/2	1 1/2
1 1/4	1 1/2	1 1/2
1 3/8	1 1/2	1 1/2
1 1/2	1 1/2	1 1/2
1 5/8	1 1/2	1 1/2
1 3/4	1 1/2	1 1/2
1 7/8	1 1/2	1 1/2
2	1 1/2	1 1/2
2 1/8	1 1/2	1 1/2
2 1/4	1 1/2	1 1/2
2 3/8	1 1/2	1 1/2
2 1/2	1 1/2	1 1/2
2 5/8	1 1/2	1 1/2
2 3/4	1 1/2	1 1/2
2 7/8	1 1/2	1 1/2
3	1 1/2	1 1/2
3 1/8	1 1/2	1 1/2
3 1/4	1 1/2	1 1/2
3 3/8	1 1/2	1 1/2
3 1/2	1 1/2	1 1/2
3 5/8	1 1/2	1 1/2
3 3/4	1 1/2	1 1/2
3 7/8	1 1/2	1 1/2
4	1 1/2	1 1/2

Notes:
*H*₁ = height of nut
*H*₂ = maximum height of washer
*C*₁ = clearance
*C*₂ = clearance

SJL 9-13-11
UBT 9/13/2011

Type A



Location of Erection Bolts shown

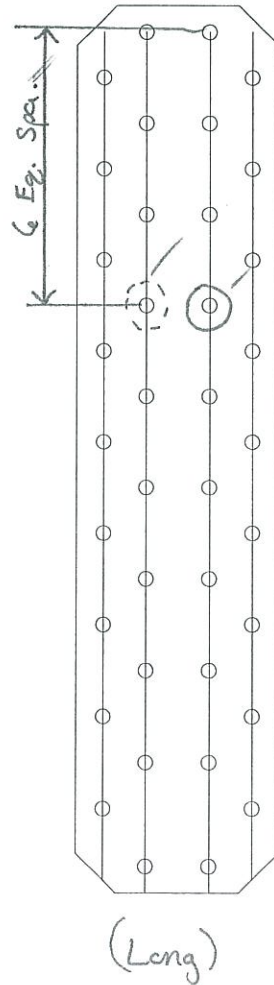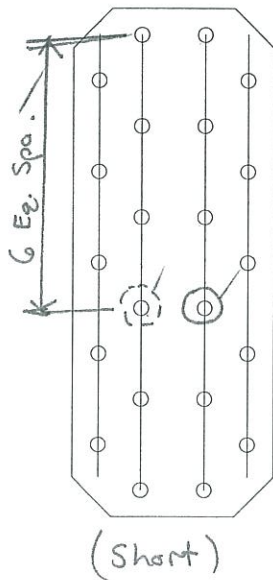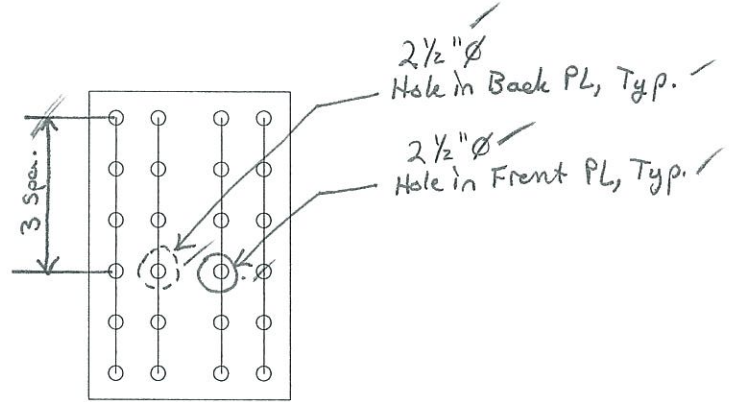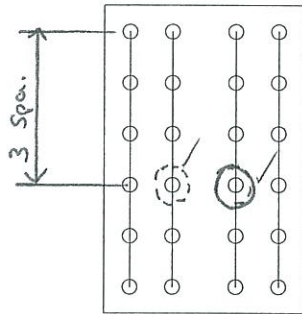

SSL 9-13-11
JBT 9/13/2011



Type B

Location of Erection Bolts

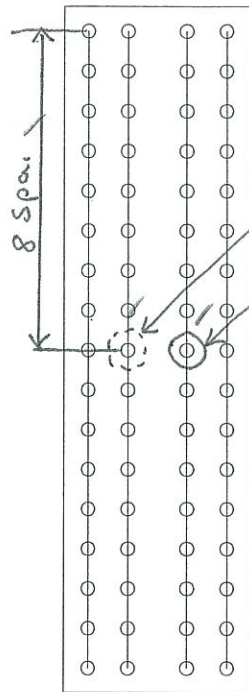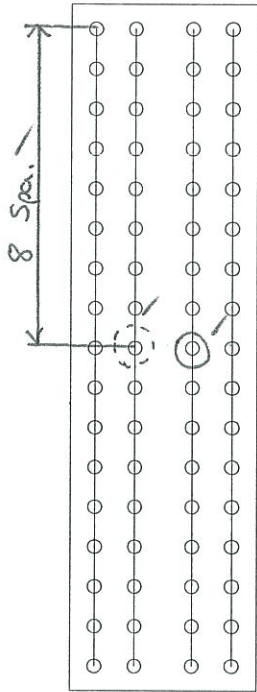

2 1/2" \varnothing
Hole in back PL,
Typ.



2 1/2" \varnothing
Hole in front PL,
Typ.

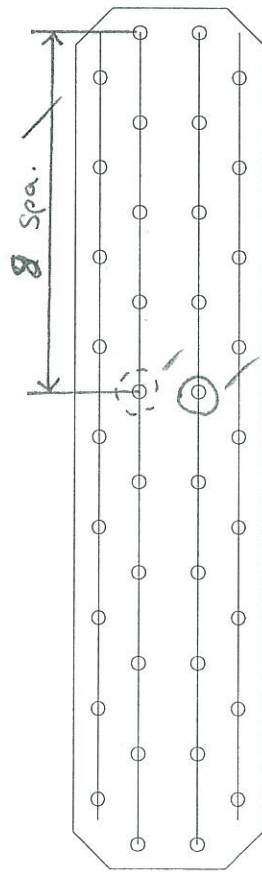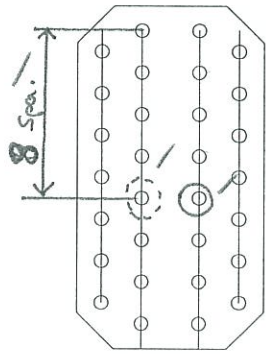


S3L 9-15-11
JBT 9-15-11

Type C


Location of Erection Bolts shown

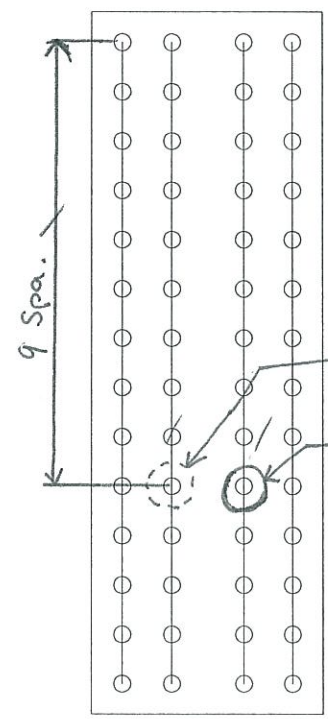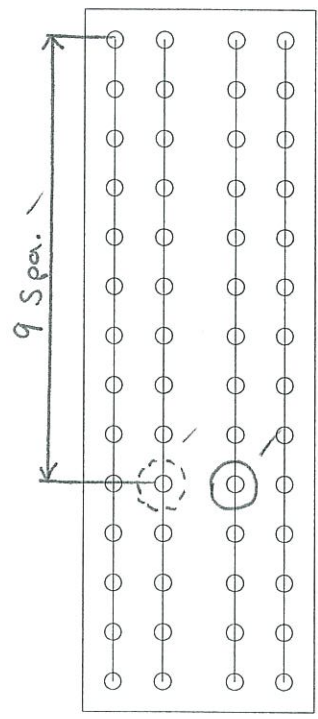

2 1/2" \varnothing Hole in Back PL, Typ. ✓
2 1/2" \varnothing Hole in front PL, Typ. ✓

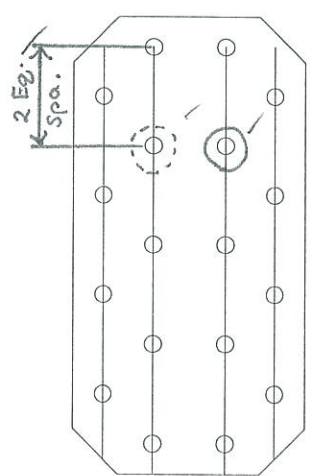

(Short) ✓




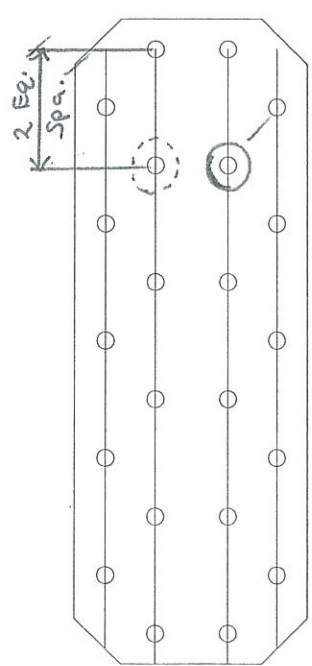


(Long) ✓

Type D, E, F


Location of Erection Bolts.

SSC 9-13-11
JBT 9/13/2011

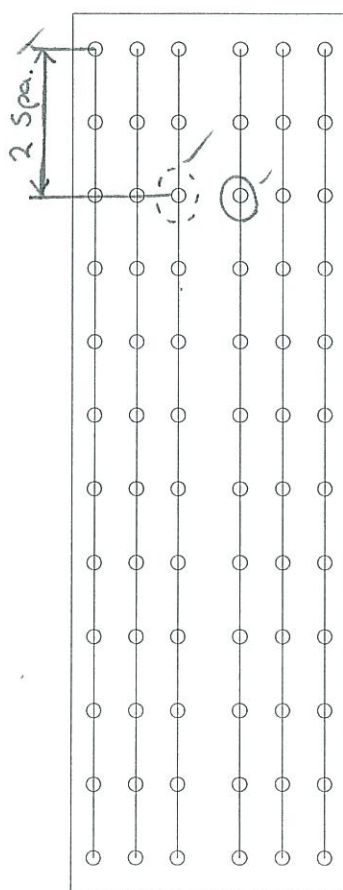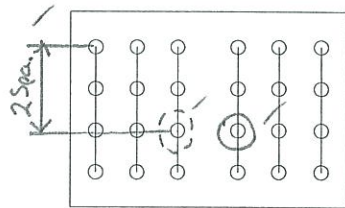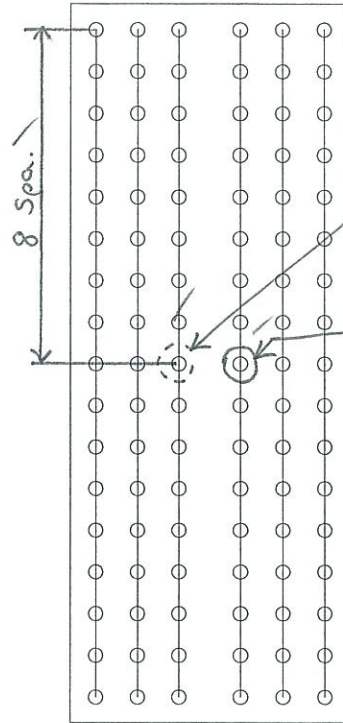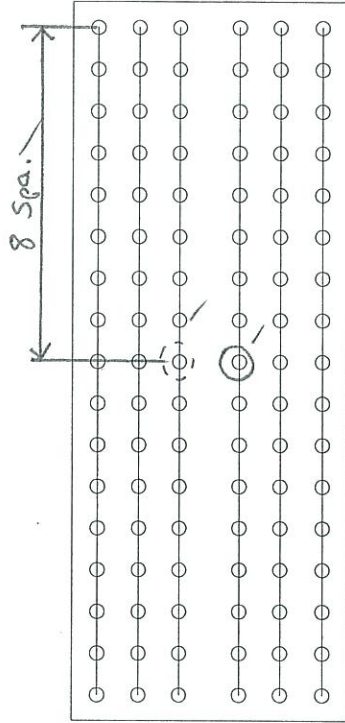

Type G

Location of Erection Bolts.

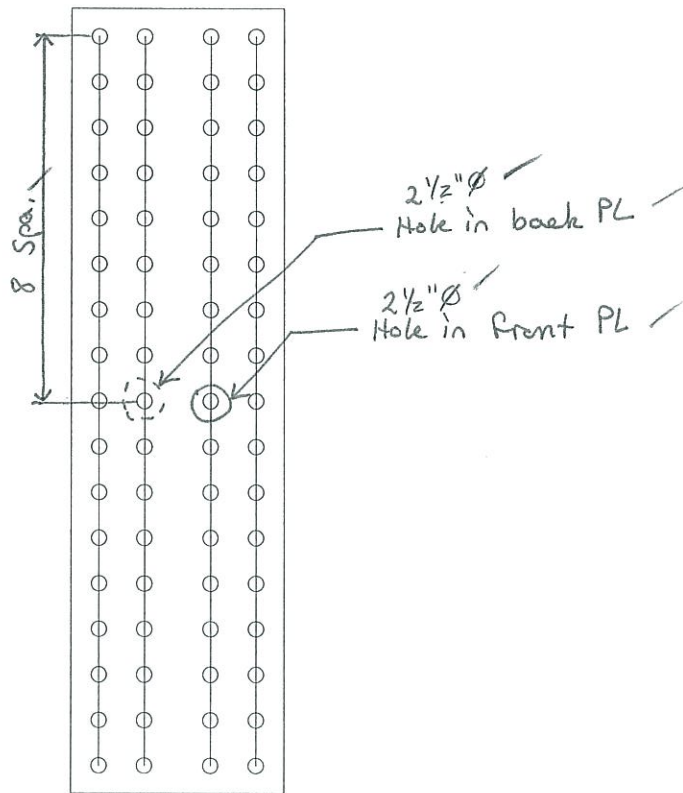

Changes due to Erection Bolt RFI

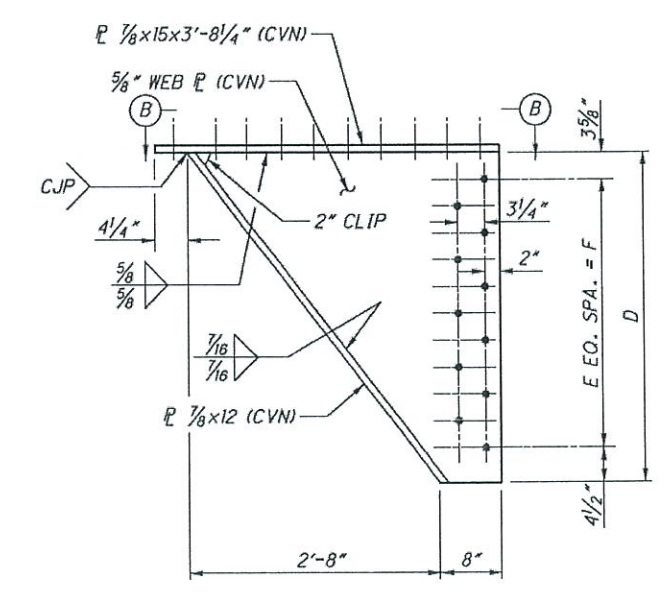
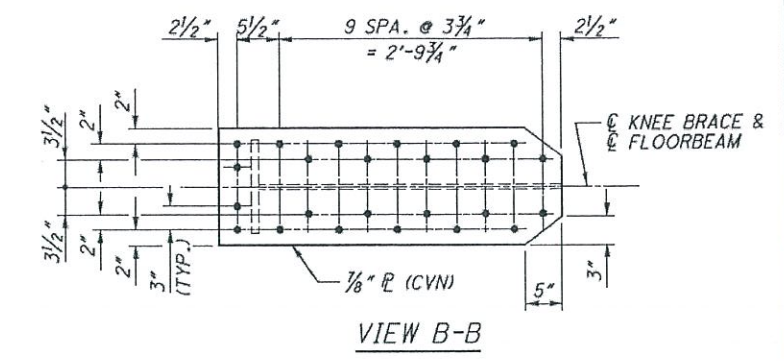
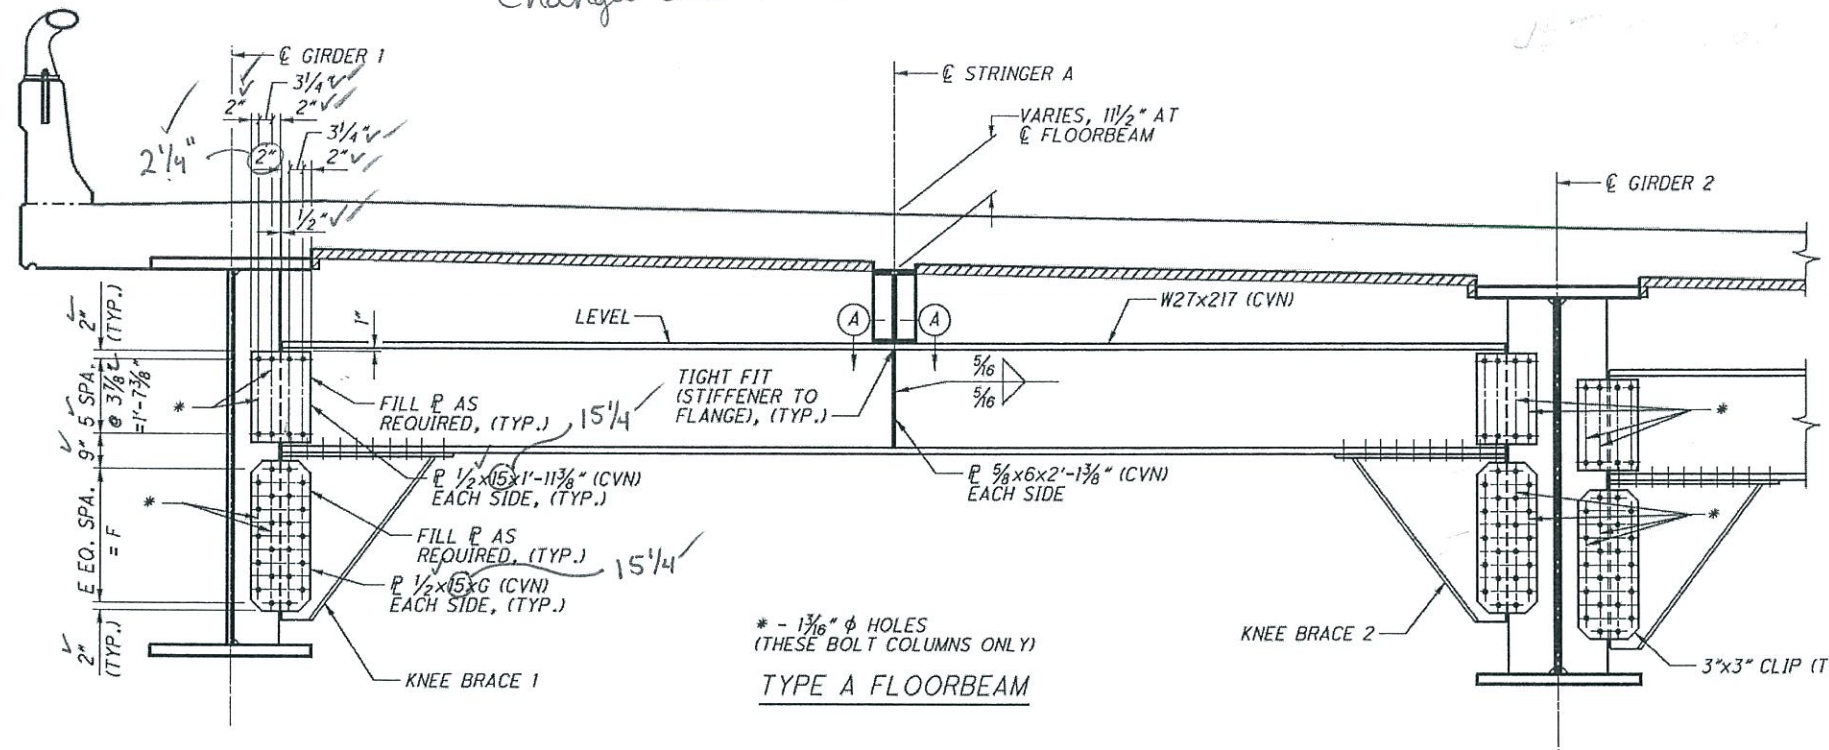



TABLE OF DIMENSIONS
GIRDERS 2, 3 AND 4 STIFFENERS

GIRDER WEB DEPTH	T	B	A
LESS THAN 11'-0"	1 1/8"	1'-0"	5/16"


TABLE OF DIMENSIONS
GIRDERS 1 AND 5 STIFFENERS

GIRDER WEB DEPTH	T	B	A
LESS THAN 10'-0"	1 1/8"	1'-0"	3/8"
10'-0" TO 11'-0"	1 5/8"	1'-4 1/2"	3/8"


GIRDERS 1 & 5 SHALL ONLY HAVE INSIDE STIFFENERS

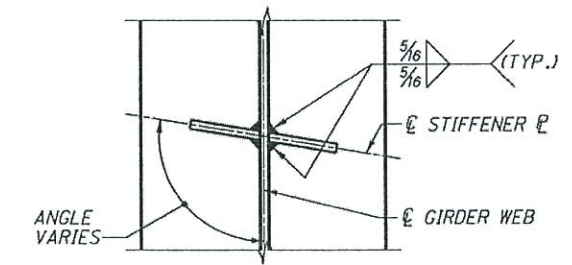

KNEE BRACE DETAIL

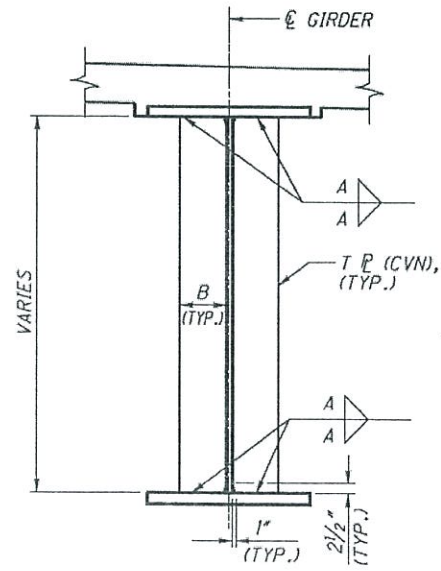

STIFFENER DETAIL
(GIRDERS 2-4 SHOWN)
(CONNECTION TO FLOORBEAM
NOT SHOWN FOR CLARITY)

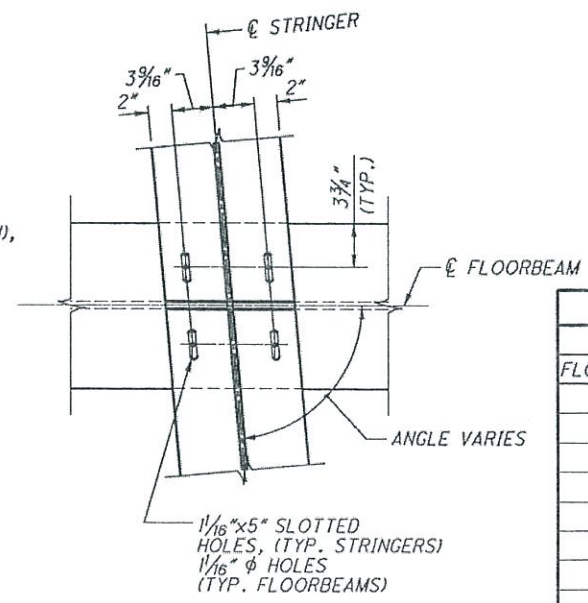

SECTION A-A

see attached
for Erection
Bolt locations

TABLE OF DIMENSIONS - KNEE BRACES

FLOORBEAM TYPE	KB 1	KB 2	KB 1	KB 2	KB 1	KB 2	KB 1	KB 2
A1	3'-10 1/8"	3'-10 1/8"	12	12	3'-2"	3'-2"	3'-6"	3'-6"
A2	5'-11 1/8"	5'-11 1/8"	16	16	5'-3"	5'-3"	5'-7"	5'-7"
A3	3'-6 5/8"	3'-10 1/8"	10	12	2'-10 1/2"	3'-2"	3'-2 1/2"	3'-6"
A4	3'-10 1/8"	4'-11 1/8"	12	14	3'-2"	4'-3"	3'-6"	4'-7"
A5	4'-4 1/8"	4'-11 1/8"	14	14	3'-8"	4'-3"	4'-0"	4'-7"
A6	4'-11 1/8"	5'-11 1/8"	14	16	4'-3"	5'-3"	4'-7"	5'-7"
A7	4'-11 1/8"	4'-11 1/8"	14	14	4'-3"	4'-3"	4'-7"	4'-7"
A8	3'-6 5/8"	4'-4 1/8"	10	14	2'-10 1/2"	3'-8"	3'-2 1/2"	4'-0"
A9	4'-4 1/8"	5'-11 1/8"	14	16	3'-8"	5'-3"	4'-0"	5'-7"

KB 1 DENOTES KNEE BRACE 1
KB 2 DENOTES KNEE BRACE 2

NOTES:

- WHERE A SHAPE OR PLATE IS DESIGNATED (CVN), FURNISH MATERIAL THAT MEETS THE MINIMUM NOTCH TOUGHNESS REQUIREMENTS AS SPECIFIED IN 711.01.
- FLOORBEAMS SHALL BE DETAILED, FABRICATED AND INSTALLED SO THAT THEY ARE UNLOADED AT ERECTION, ALLOWING GIRDER WEBS TO BE THEORETICALLY VERTICAL OR PLUMB UNDER THE NO LOAD CONDITION.
- ALL STEEL SHALL BE A709 GRADE 50.
- ALL STEEL SHALL BE PAINTED WITH AN IZEU COATING SYSTEM. SURFACES OF BOLTED CONNECTIONS SHALL BE PAINTED WITH A COATING THAT WILL PROVIDE CLASS B SLIP RESISTANCE AS DEFINED IN SECTION 6.13.2.8 OF THE AASHTO LRFD BRIDGE DESIGN SPECIFICATIONS.
- ALL BOLTS SHALL BE HIGH STRENGTH 1" φ, A325 GALVANIZED TYPE I BOLTS. ALL HOLES ARE 1/16" φ UNLESS NOTED OTHERWISE.
- FOR FLOORBEAM LOCATIONS, SEE SHEETS 15|84 THRU 18|84.
- STIFFENERS THAT EXTEND BEYOND EDGE OF FLANGE SHALL BE CLIPPED AT A 45° ANGLE.
- BOLTS AT STRINGER TO FLOORBEAM CONNECTION SHALL BE SNUG TIGHT PRIOR TO DECK PLACEMENT. NUTS SHALL BE FULLY TIGHTENED AFTER DECK IS PLACED.
- STRINGERS SHALL BE PLACED WITH BOLTS CENTERED IN THE SLOTTED HOLE.

PRELIMINARY NOT
FOR CONSTRUCTION

ENGINEER'S
SEAL

NO.	REVISIONS	DATE
A	FINAL SUBMITTAL	04/14/11
B	FINAL SUBMITTAL - REVISED	06/09/11
C	FINAL SUBMITTAL - REVISED	08/09/11
D	FINAL SUBMITTAL - REVISED	

DESIGN AGENCY
WALSH HNTB
WALSH CONSULTANTS

CLARENCE J. JANNERBELTRIDGE
REGISTERED PROFESSIONAL ENGINEER
NO. 9000

MAIN SPAN
UNIT 2
STRUCTURAL STEEL

SUPERSTRUCTURE DETAILS
BRIDGE NO. CUY-90-1532
1-90 WEST BOUND

DESIGNED
S.J.L.

DRAWN
T.K.T.

CHECKED
G.D.H.

DATE
08/09/11

STRUCTURE FILE NUMBER
1809431

CUY-90-14.90
PID No. 77332/85531

34/84

0
0

S3LA0919-12-11
45T 9-16-11

Date: 9/9/2011
Model: Sheet1
File: 49633-S-BR-SSD05-U2S1Steel.dgn

ENGINEER'S SEAL

NO.	REVISIONS	DATE
B	FINAL SUBMITTAL - REVISED	04/14/11
C	FINAL SUBMITTAL - REVISED	06/09/11
D	FINAL SUBMITTAL - REVISED	07/09/11

DESIGN AGENCY
WALSH HNTB
WALSH CONSULTING

CUSTOMER
MINNERBETZ
GO TRANSPORTATION

BRIDGE NO. CUY-90-1532
1-90 WEST BOUND

MAIN SPAN
UNIT 2
STRUCTURAL STEEL


DESIGNED	DRAWN	CHECKED	DATE
S.J.L.	F.W.G.	J.P.C.	08/09/11

STRUCTURE FILE NUMBER
1809431

PID No. 77332/85531

35/84

Changes due to Erection Bolt RFI

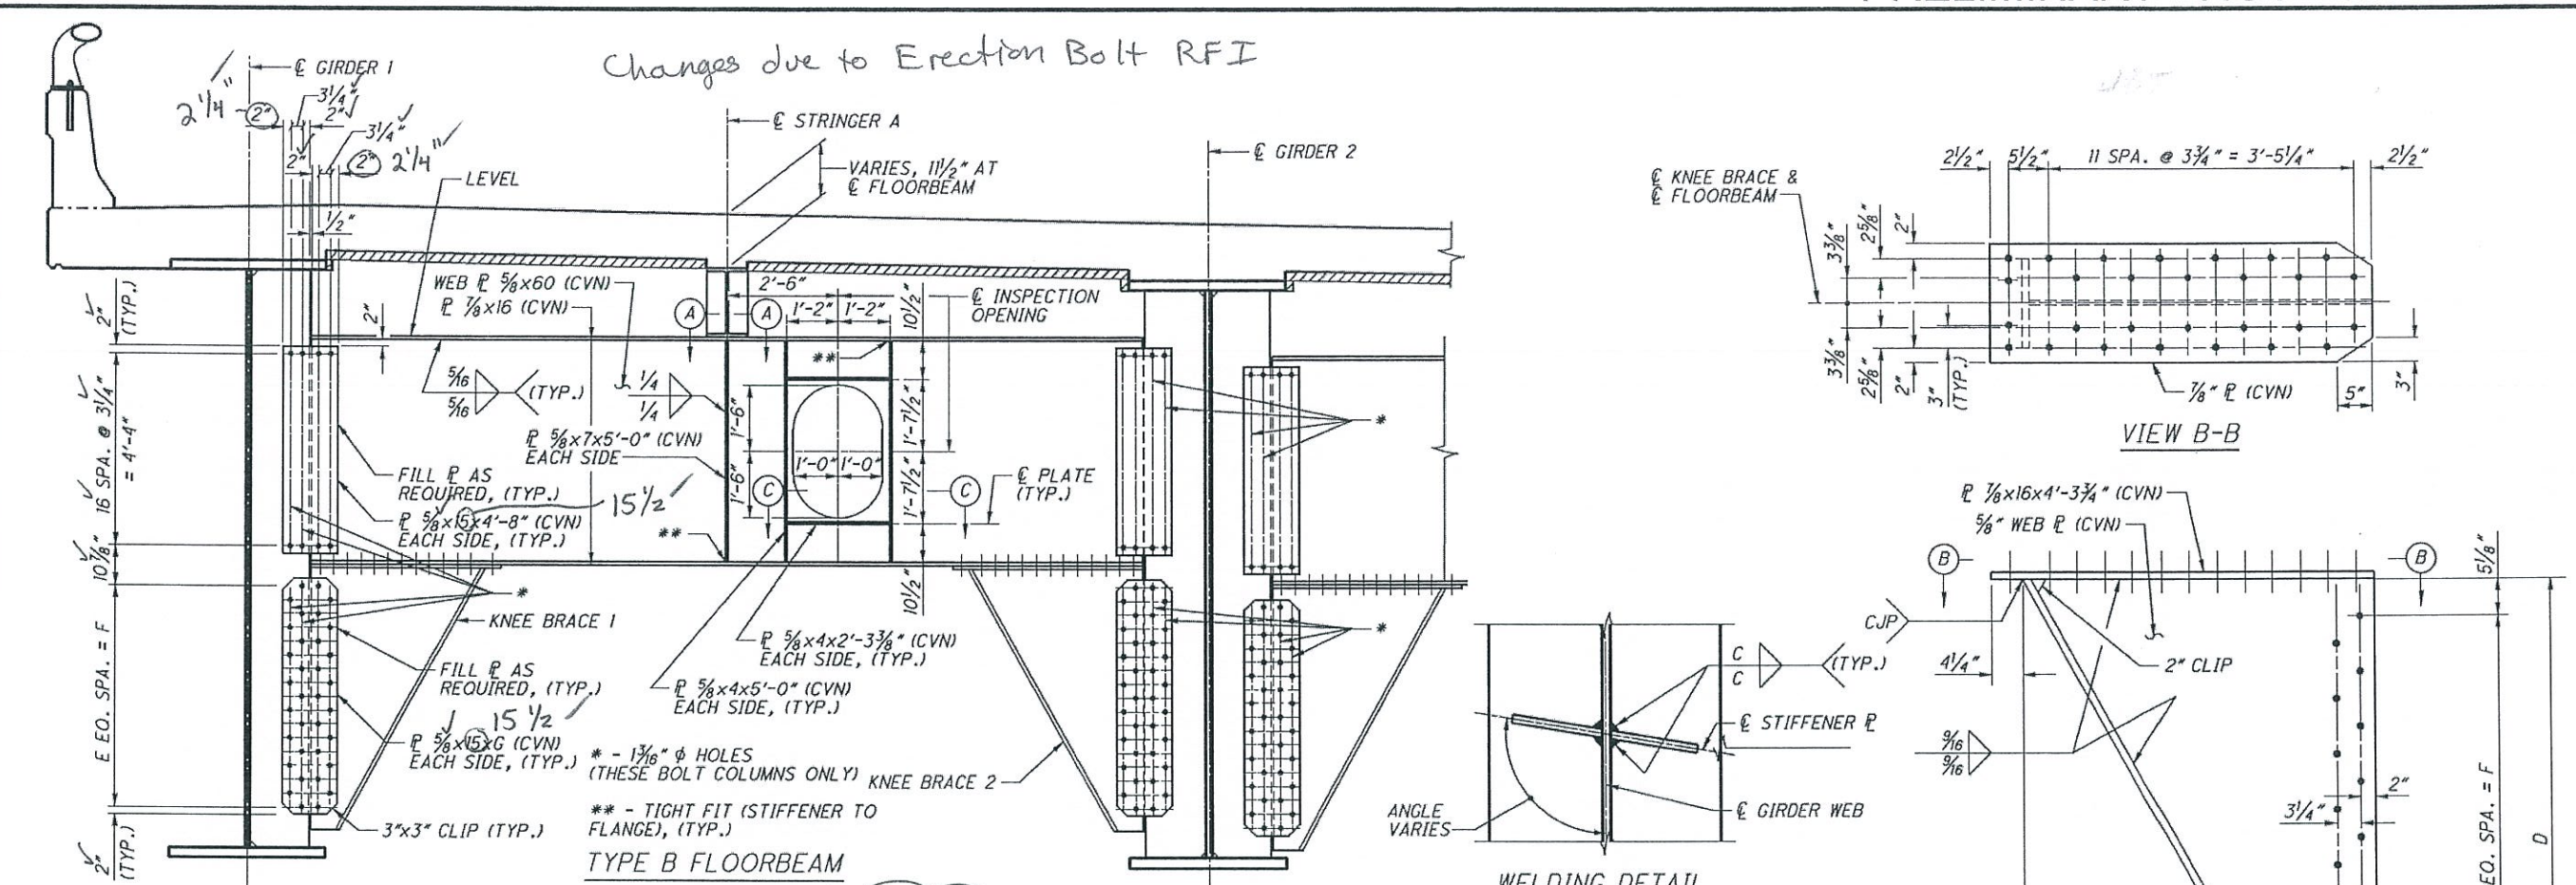

see attached for location of Erection Bolts

GIRDER WEB DEPTH	T	B	A	C
LESS THAN 15'-6"	1 1/2"	1'-3"	5/16"	5/16"

GIRDER WEB DEPTH	T	B	A	C
LESS THAN 12'-0"	1 3/4"	1'-6"	9/16"	7/16"
12'-0" TO 15'-6"	1 3/4"	1'-6"	3/8"	5/16"

GIRDER 1 AND 5 SHALL ONLY HAVE INSIDE STIFFENERS

FLOORBEAM TYPE	D		E		F		G	
	KB 1	KB 2	KB 1	KB 2	KB 1	KB 2	KB 1	KB 2
B1	6'-5 1/8"	6'-5 1/8"	18	18	5'-6"	5'-6"	5'-10"	5'-10"
B2	2'-11 1/8"	3'-7 1/8"	14	16	2'-0"	2'-8"	2'-4"	3'-0"
B3	3'-7 1/8"	4'-11 1/8"	16	16	2'-8"	4'-0"	3'-0"	4'-4"
B4	4'-11 1/8"	6'-5 1/8"	16	18	4'-0"	5'-6"	4'-4"	5'-10"
B5	6'-5 1/8"	4'-11 1/8"	18	16	5'-6"	4'-0"	5'-10"	4'-6"
B6	4'-11 1/8"	3'-7 1/8"	16	16	4'-0"	2'-8"	4'-4"	3'-0"
B7	3'-7 1/8"	2'-11 1/8"	16	14	2'-8"	2'-0"	3'-0"	2'-4"

KB 1 DENOTES KNEE BRACE 1
KB 2 DENOTES KNEE BRACE 2


NOTES:

- WHERE A SHAPE OR PLATE IS DESIGNATED (CVN), FURNISH MATERIAL THAT MEETS THE MINIMUM NOTCH TOUGHNESS REQUIREMENTS AS SPECIFIED IN 711.01.
- FLOORBEAMS SHALL BE DETAILED, FABRICATED AND INSTALLED SO THAT THEY ARE UNLOADED AT ERECTION, ALLOWING GIRDER WEBS TO BE THEORETICALLY VERTICAL OR PLUMB UNDER THE NO LOAD CONDITION.
- ALL STEEL SHALL BE A709 GRADE 50.
- ALL STEEL SHALL BE PAINTED WITH AN IZEU COATING SYSTEM. SURFACES OF BOLTED CONNECTIONS SHALL BE PAINTED WITH A COATING THAT WILL PROVIDE CLASS B SLIP RESISTANCE AS DEFINED IN SECTION 6.13.2.8 OF THE AASHTO LRFD BRIDGE DESIGN SPECIFICATIONS.
- ALL BOLTS SHALL BE HIGH STRENGTH 1" φ, A325 GALVANIZED TYPE I BOLTS. ALL HOLES ARE 1/16" φ UNLESS NOTED OTHERWISE.
- FOR FLOORBEAM LOCATIONS, SEE SHEETS 15/84 THRU 18/84.
- STIFFENERS THAT EXTEND BEYOND EDGE OF FLANGE SHALL BE CLIPPED AT A 45° ANGLE.
- BOLTS AT STRINGER TO FLOORBEAM CONNECTION SHALL BE SNUG TIGHT PRIOR TO DECK PLACEMENT. NUTS SHALL BE FULLY TIGHTENED AFTER DECK IS PLACED.
- STRINGERS SHALL BE PLACED WITH BOLTS CENTERED IN THE SLOTTED HOLES.

SJL ARSON 9-12-11
JBT 9-16-11

Date: 9/9/2011
Model: Sheet1
File: 49633-S-BR-SSD06-U2StSteel.dgn

Changes due to Erection Bolt RFI

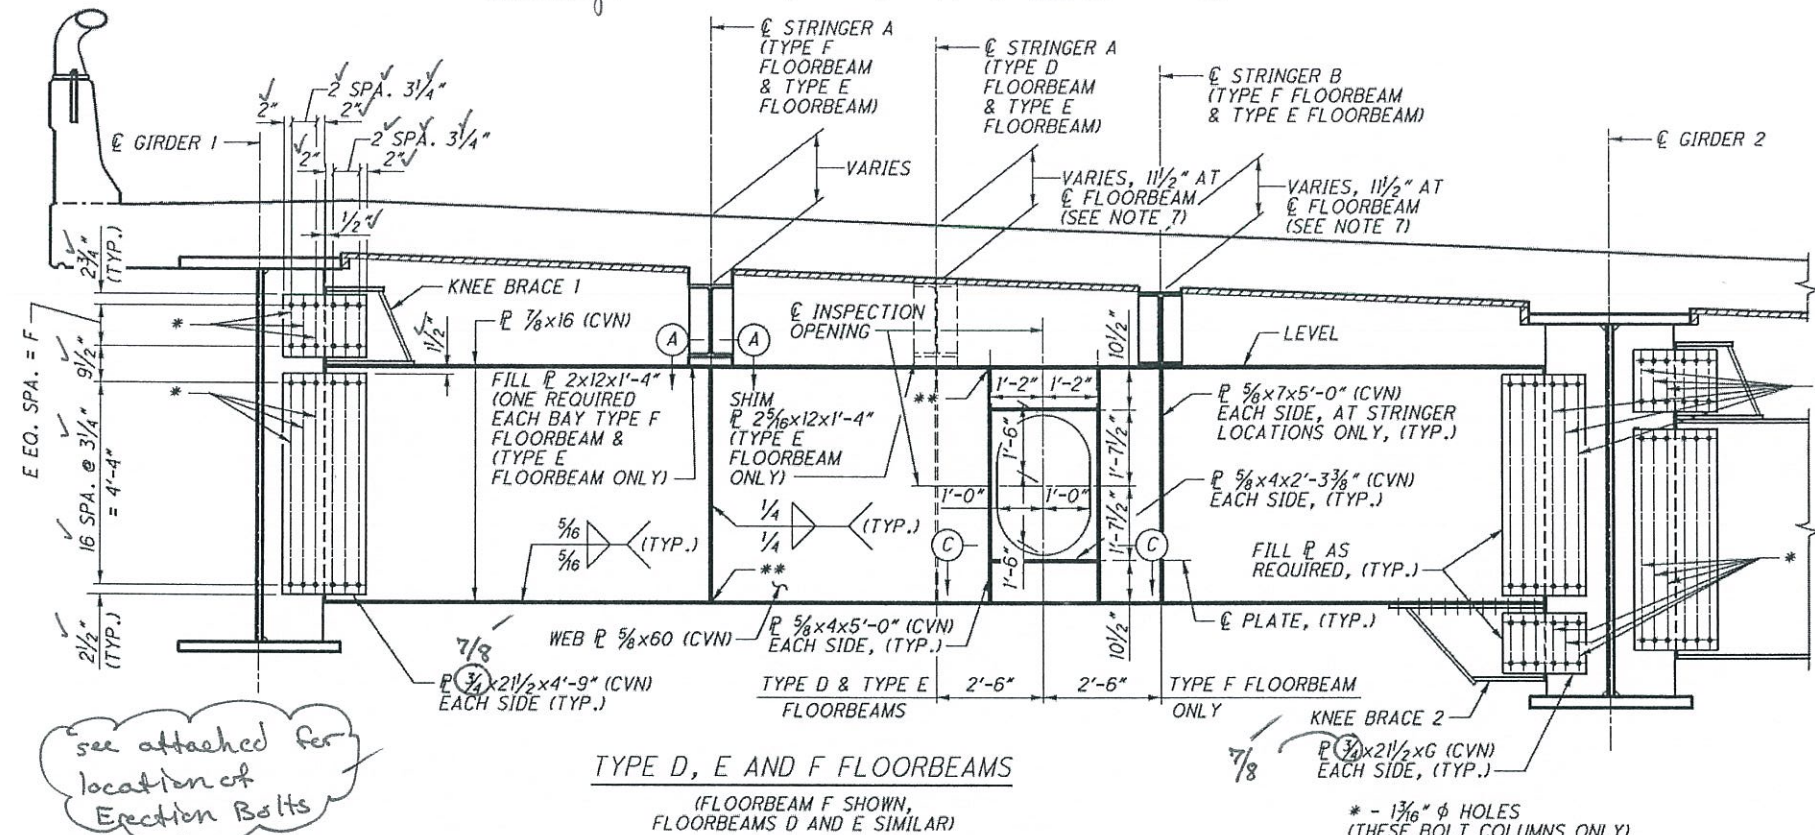

see attached for location of Erection Bolts

TYPE D, E AND F FLOORBEAMS
(FLOORBEAM F SHOWN, FLOORBEAMS D AND E SIMILAR)

TABLE OF DIMENSIONS
GIRDERS 2, 3 AND 4 STIFFENERS


GIRDER WEB DEPTH	T	B	A	C
8'-0"	1 1/8"	1'-0"	3/16"	3/16"
8'-0" TO 10'-0"	1 1/2"	1'-3"	3/16"	3/16"
10'-0" TO 15'-6"	1 1/2"	1'-3"	3/16"	3/16"

TABLE OF DIMENSIONS
GIRDERS 1 AND 5 STIFFENERS

GIRDER WEB DEPTH	T	B	A	C
8'-0"	1 1/8"	1'-0"	9/16"	3/16"
8'-0" TO 12'-0"	1 3/4"	1'-6"	9/16"	3/16"
12'-0" TO 15'-6"	1 3/4"	1'-6"	3/8"	3/16"

GIRDERS 1 & 5 SHALL HAVE INSIDE STIFFENERS 1'-6"

* - 1 3/16" φ HOLES (THESE BOLT COLUMNS ONLY)
** - TIGHT FIT (STIFFENER TO FLANGE), (TYP.)

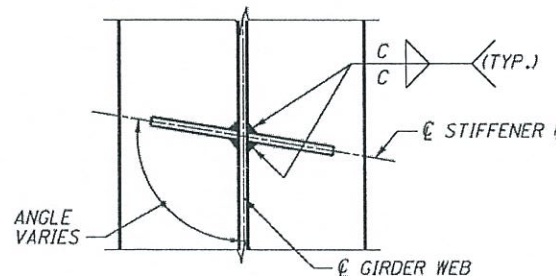

WELDING DETAIL


TABLE OF DIMENSIONS
KNEE BRACE CONNECTION (KB1 & KB2)

	D	H	J	K
1'-6"	9	3 1/4"	2'-5 1/4"	
2'-10 1/4"	11	3 3/4"	3'-5 1/4"	
5'-10 1/4"	11	3 3/4"	3'-5 1/4"	


TABLE OF DIMENSIONS - KNEE BRACES

FLOORBEAM TYPE	D		E		F		G	
	KB 1	KB 2	KB 1	KB 2	KB 1	KB 2	KB 1	KB 2
D1, E1 AND F1	1'-6"	1'-6"	3	3	10 1/2"	10 1/2"	1'-4"	1'-4"
D2	1'-6"	2'-10 1/4"	3	5	10 1/2"	2'-2 3/4"	1'-4"	2'-8 1/4"
F7	1'-6"	5'-10 1/4"	3	11	10 1/2"	5'-2 3/4"	1'-4"	5'-8 1/4"


KB 1 DENOTES KNEE BRACE 1
KB 2 DENOTES KNEE BRACE 2

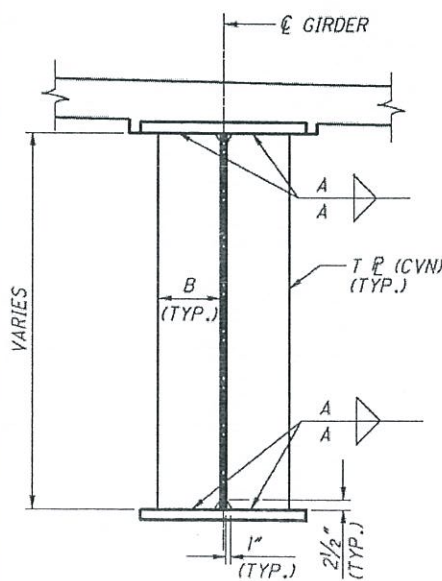


STIFFENER DETAIL
(GIRDERS 2-4 SHOWN)
(CONNECTION TO FLOORBEAM NOT SHOWN FOR CLARITY)

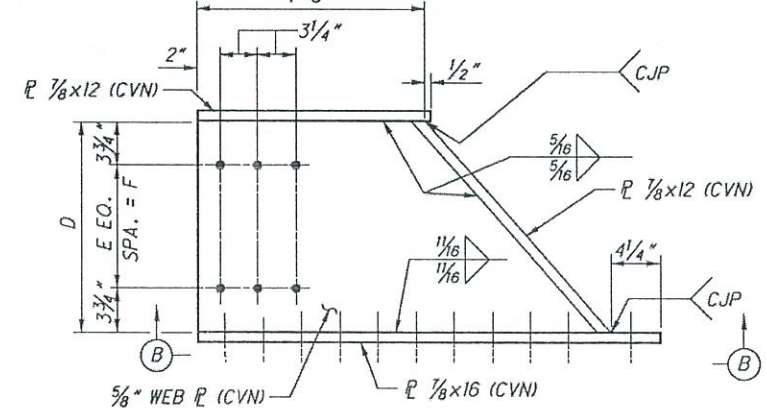

KNEE BRACE 1 DETAIL

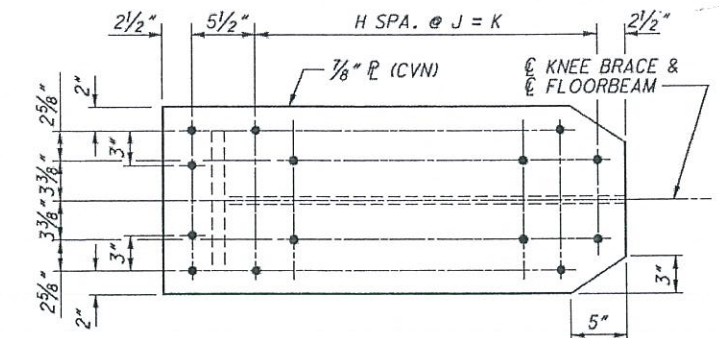

VIEW B-B
(KNEE BRACE 2 DETAIL SHOWN, KNEE BRACE 1 OPPOSITE HAND)

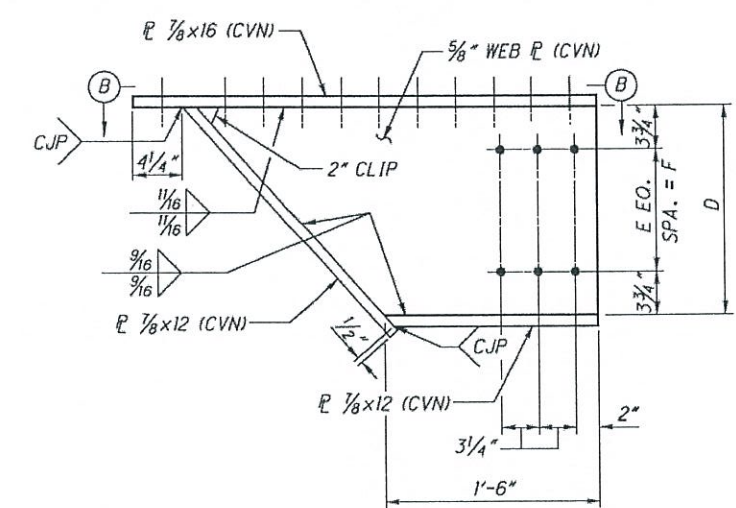

KNEE BRACE 2 DETAIL

- NOTES:
- WHERE A SHAPE OR PLATE IS DESIGNATED (CVN), FURNISH MATERIAL THAT MEETS THE MINIMUM NOTCH TOUGHNESS REQUIREMENTS AS SPECIFIED IN 711.01.
 - FLOORBEAMS SHALL BE DETAILED, FABRICATED AND INSTALLED SO THAT THEY ARE UNLOADED AT ERECTION, ALLOWING GIRDER WEBS TO BE THEORETICALLY VERTICAL OR PLUMB UNDER THE NO LOAD CONDITION.
 - ALL STEEL SHALL BE A709 GRADE 50.
 - ALL STEEL SHALL BE PAINTED WITH AN IZEU COATING SYSTEM. SURFACES OF BOLTED CONNECTIONS SHALL BE PAINTED WITH A COATING THAT WILL PROVIDE CLASS B SLIP RESISTANCE AS DEFINED IN SECTION 6.13.2.8 OF THE AASHTO LRFD BRIDGE DESIGN SPECIFICATIONS.
 - ALL BOLTS SHALL BE HIGH STRENGTH 1" φ, A325 GALVANIZED TYPE I BOLTS. ALL HOLES ARE 1 1/16" φ UNLESS NOTED OTHERWISE.
 - FOR FLOORBEAM LOCATIONS, SEE SHEETS 15|84 THRU 18|84.
 - MINIMUM SLAB + HAUNCH THICKNESS SHALL BE 11 1/2" FOR STRINGERS A, C, E AND G AT TYPE D FLOORBEAMS. MINIMUM SLAB + HAUNCH THICKNESS SHALL BE 11 1/2" FOR STRINGERS B, D, F AND H AT TYPE E & F FLOORBEAMS. FOR TYPE E FLOORBEAMS, CENTER STRINGER SHALL BE SUPPORTED ON A SHIM P TO MAINTAIN 11 1/2" MINIMUM SLAB + HAUNCH THICKNESS.
 - STIFFENERS THAT EXTEND BEYOND THE EDGE OF FLANGE SHALL BE CLIPPED AT A 45° ANGLE.
 - BOLTS AT STRINGER TO FLOORBEAM CONNECTION SHALL BE SNUG TIGHT PRIOR TO DECK PLACEMENT. NUTS SHALL BE FULLY TIGHTENED AFTER DECK IS PLACED.
 - FOR SECTIONS A-A AND C-C, SEE SHEET 38|84.
 - STRINGERS SHALL BE PLACED WITH BOLTS CENTERED IN THE SLOTTED HOLES.

PRELIMINARY NOT FOR CONSTRUCTION

ENGINEER'S SEAL

DATE: 04/17/11, 06/09/11, 08/09/11

REVISIONS: NO. 1, 2, 3, 4

DESIGN AGENCY: WASH HNTB

MAIN SPAN UNIT 2

STRUCTURAL STEEL

DATE: 06/09/11

STRUCTURE FILE NUMBER: 1809431

CUY-90-14-90


PID No. 77332/85531

37/84

SJLARSON 9-12-11
UBT 9-16-11

Date: 9/9/2011
Model: Sheet1
File: 49633-S-BR-SSD08-U2S1Steel.dgn

Changes due to Erection Bolt RFI

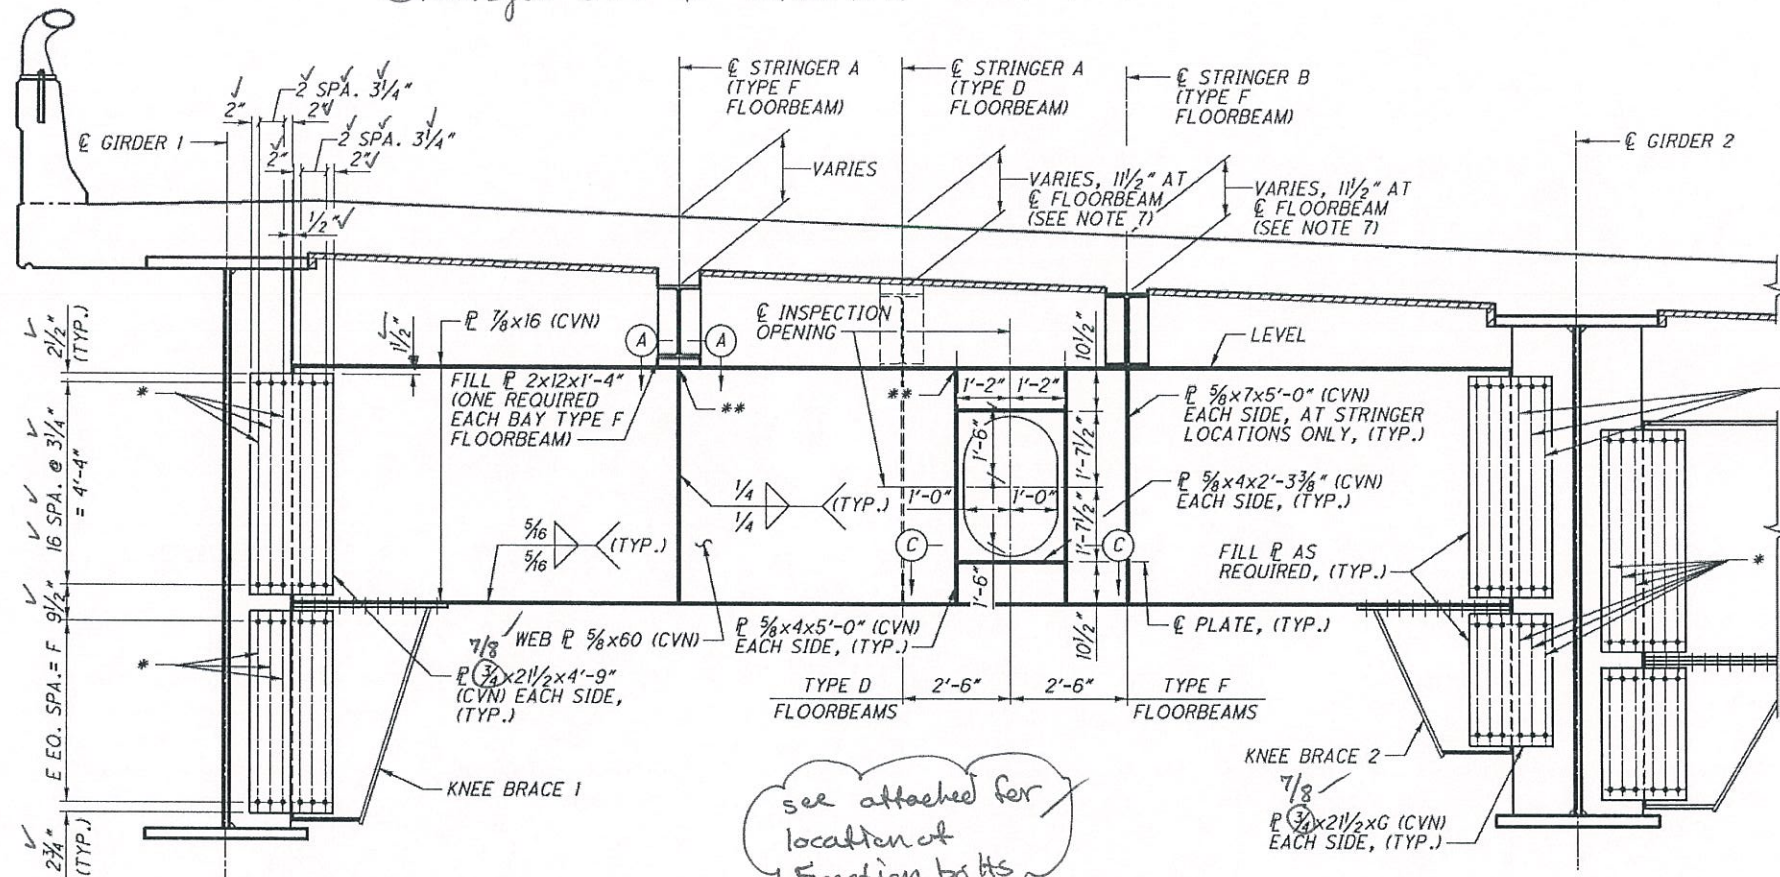

see attached for location of Erection bolts

TYPE D AND F FLOORBEAMS
(FLOORBEAM TYPE F SHOWN, FLOORBEAM TYPE D SIMILAR)

- * - 1 3/16" φ HOLES (THESE BOLT COLUMNS ONLY)
- ** - TIGHT FIT (STIFFENER TO FLANGE), (TYP.)

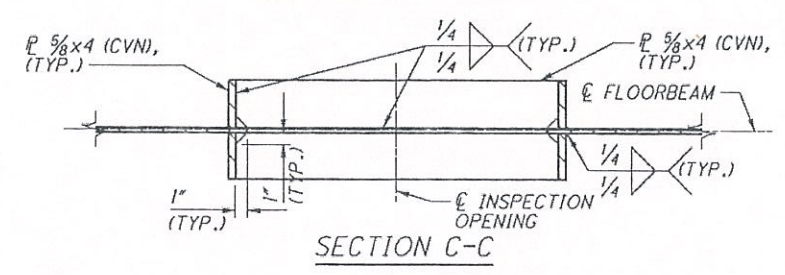
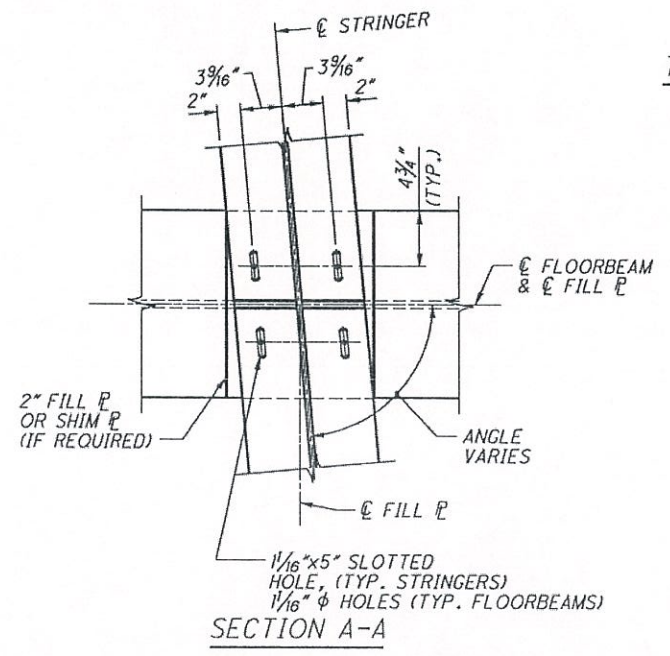
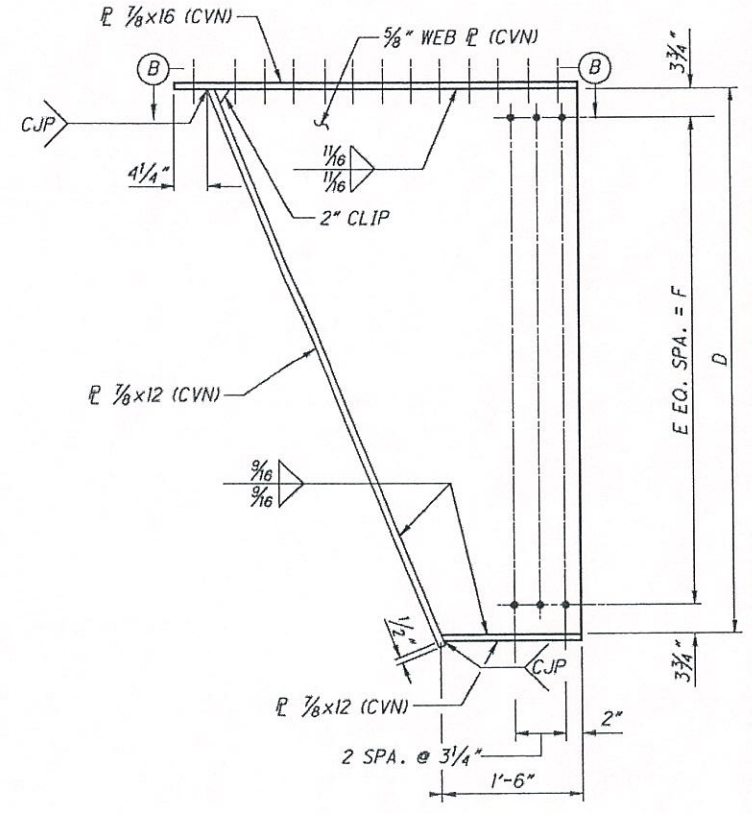
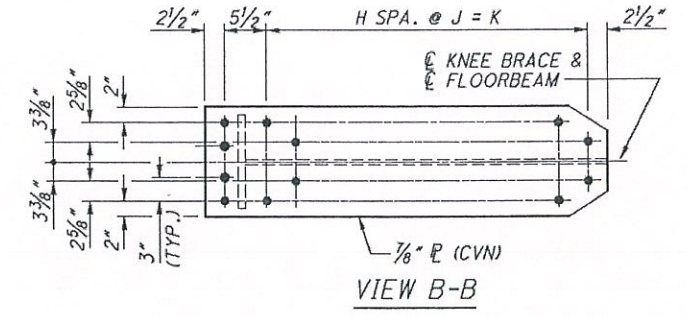


TABLE OF DIMENSIONS
KNEE BRACE CONNECTION (KB1 AND KB2)

D	H	J	K
1'-6"	9	3 1/4"	2'-5 1/4"
2'-3 3/4"	9	3 1/4"	2'-5 1/4"
2'-10 1/4"	11	3 3/4"	3'-5 1/4"
4'-4 1/4"	11	3 3/4"	3'-5 1/4"
5'-10 1/4"	11	3 3/4"	3'-5 1/4"

TABLE OF DIMENSIONS - KNEE BRACES

FLOORBEAM TYPE	D		E		F		G	
	KB 1	KB 2	KB 1	KB 2	KB 1	KB 2	KB 1	KB 2
D3	2'-10 1/4"	4'-4 1/4"	5	9	2'-2 3/4"	3'-8 3/4"	2'-8 1/4"	4'-2 1/4"
D4	4'-4 1/4"	5'-10 1/4"	9	11	3'-8 3/4"	5'-2 3/4"	4'-2 1/4"	5'-8 1/4"
D5	5'-10 1/4"	1'-6"	11	3	5'-2 3/4"	10 1/2"	5'-8 1/4"	1'-4"
D6	2'-3 3/4"	4'-4 1/4"	5	9	1'-8 1/4"	3'-8 3/4"	2'-1 3/4"	4'-2 1/4"
F8	5'-10 1/4"	5'-10 1/4"	11	11	5'-2 3/4"	5'-2 3/4"	5'-8 1/4"	5'-8 1/4"
F9	4'-4 1/4"	4'-4 1/4"	9	9	3'-8 3/4"	3'-8 3/4"	4'-2 1/4"	4'-2 1/4"
F10	5'-10 1/4"	4'-4 1/4"	11	9	5'-2 3/4"	3'-8 3/4"	5'-8 1/4"	4'-2 1/4"
F11	2'-10 1/4"	2'-3 3/4"	5	5	2'-2 3/4"	1'-8 1/4"	2'-8 1/4"	2'-1 3/4"
F12	2'-3 3/4"	2'-3 3/4"	5	5	1'-8 1/4"	1'-8 1/4"	2'-1 3/4"	2'-1 3/4"

KB 1 DENOTES KNEE BRACE 1
KB 2 DENOTES KNEE BRACE 2

NOTE:
1. FOR NOTES AND DETAILS, SEE SHEET 37/84

SJLARSON 9-12-11
JBT 9-16-11

Date: 9/9/2011
Model: Sheet1
File: 49633-S-BR-SSD08a-U2StSteel.dgn

ENGINEER'S SEAL

REVISIONS

NO.	DATE	REVISIONS
B	04/14/11	FINAL SUBMITTAL
C	06/08/11	FINAL SUBMITTAL - REVISED
D	08/09/11	FINAL SUBMITTAL - REVISED

DESIGN AGENCY
WILSH HNTB
WALKER CONSULTANTS

CLEVELAND
INNERBELT BRIDGE
SUPERSTRUCTURE DETAILS
BRIDGE NO. CUY-90-1532
1-90 WEST BOUND

MAIN SPAN
UNIT 2
STRUCTURAL STEEL

DATE: 08/09/11

DESIGNED	DATE	REVIEWED	DATE
SJL	08/09/11	HRH	08/09/11
GDH		GDH	

STRUCTURE FILE NUMBER: 1809431

CUY-90-14.90
PID No. 77332/85531

38/84

PRELIMINARY NOT FOR CONSTRUCTION

