

GEOTECHNICAL REVIEW CHECK PRINT



400 N 34th St, Suite 100; Seattle, WA 98103
 PROJECT: Cleveland Innerbelt CCG1
 CLIENT: HNTB / Walsh

CALC. NO: GC-073 REV4 Add 2
 JOB NO: 21-1-21361-614
 # SHEETS: 32
 SUBMITTAL NO.: GC-073 Addendum2

TITLE:
 External stability of Wall C1

PURPOSE AND OBJECTIVE:
 Evaluate external stability of Wall C1 after the wall bottom is deepened to the same elevation as the bottom of wall C.

SUMMARY AND CONCLUSIONS:
 See summaries on Sheets 1 and 2

SIGN OFF

REV. NO.	ORIGINATOR Sign/Date	TECHNICAL REVIEW Sign/Date	PRINCIPAL REVIEW Sign/Date
0	<i>MMY</i> <i>[Signature]</i> 7/12/12	<i>MUEHLEBACH</i> <i>[Signature]</i> 7/12/12	<i>[Signature]</i> 8-2-2012

Rev. No	Revision Description	Revision Date



CALCULATION GC-073 Rev 4 Addendum 2: Wall C1 External Stability

Table of Contents

	Sheet(s)
Main Text	1-2
Wall Plan of C and C1	3-13
Reinforcement length of Wall C1	14
Spreadsheet Calculation for External Stability Analyses at Wall C1	15-32

Calculation Objective:

Bottom elevation of MSE Wall C1 is considered to move down to the same elevation as Wall C (shown on Sheet 7). The external stability with the new wall height is calculated and checked in this addendum.

General Approach / Assumptions:

External stability for Wall C1 was checked in this calculation package considering discontinuous reinforcement at the base of the wall. An in-house, QA/QC'd Excel spreadsheet called "External_Stability_v2.2.xlsx" was used. This spreadsheet was originally designed for Allowable Stress Design (ASD) and has been updated for Load and Resistance Factor Design (LRFD). See Sheets 86 to 89 in GC-073 for more information about the spreadsheet.

The wall height at selected stations is measured from the latest wall plan (Sheets 3-13) and has been summarized in the following table. For the purposes of this calculation, the variable H is used for the as-design height of the wall (i.e., prior to deepening its base). A new variable, H' is defined for this calculation as the increased height of Wall C1 due to deepening its base to the same elevation as the base of gravity block wall C. The wall heights H and H' are both presented on Sheet 11. Other parameters for the spreadsheet input have been calculated in GC-012, GC-013, and GC-073. The cross section drawings were included in GC-073.

Summary and Conclusions:

The spreadsheets used for external stability analyses are attached on Sheets 15 through 26, and the analysis results are summarized as follows:

	Sta. 11+90 ¹	Sta. 11+95	Sta. 12+00	Sta. 12+25	Sta. 12+70	Sta. 12+90
Height (H) ² , ft	6	7.3	10.5	18	36	23
Height (H') ² , ft	11	12	14	22	42	25
Backslope (β), degree	6.5	6.5	6.5	6.5	0	6.5
Friction angle of the foundation soils, degree	30	30	30	30	30	30
req. B/H _{min}	B=8'	B=15' ⁴	1.1	1.1	1.1	1.1
Controlling Factor	AASHTO	Reinforced Earth Co. Shop Drawings	Global Stability GC-012 Sheet 2 ³	Global Stability GC-012 Sheet 2 ³	Global Stability GC-012 Sheet 2 ³	Global Stability GC-012 Sheet 2 ³
Spreadsheet Calculation	Sheets 15-17	Sheets 18-20	Sheets 21-23	Sheets 24-26	Sheets 27-29	Sheets 30-32

Note:

1. The wall station used in this calculation package refers to Wall C station. The selected stations have been marked on Sheet 7.
2. Wall heights H and H' have been shown on Sheet 11.
3. Global stability of Wall C1 in GC-012 indicated that the B/Hmin ratio needs to be 1.1 to reach required FS. Thus 1.1 is analyzed and checked in this calculation package.
4. Refer to Sheet 14 for the reinforcement length in this station.

The analyses indicate that (1) the wall design meets external stability requirements with a minimum B/H of 1.1 from Stations 12+00 through 14+00; and (2) a reinforcement length B of 15ft is required from Stations 11+90 to 12+00 (refer to Sheet 14).

STATE OF OHIO

DEPARTMENT OF TRANSPORTATION

CUY-90-14.90

CITY OF CLEVELAND

CUYAHOGA COUNTY

(INDEX OF SHEETS - SEE DWG. NO. 2)

PROJECT DESCRIPTION


- WALL C - GRAVITY BLOCK RETAINING WALL ALONG I.R. 90 WESTBOUND, AND FAIRFIELD AVE.
- WALL C1 - MSE RETAINING WALL ALONG FAIRFIELD AVE. AND FORWARD ABUTMENT OF BL-4.
- WALL C2 - GRAVITY BLOCK RETAINING WALL ALONG RAMP A6

LIMITED ACCESS

SEE DWG. NO. T1-050 INCLUDED IN SURVEY CONTROL.

2010 SPECIFICATIONS

THE STANDARD SPECIFICATIONS OF THE STATE OF OHIO, DEPARTMENT OF TRANSPORTATION, INCLUDING CHANGES AND SUPPLEMENTAL SPECIFICATIONS LISTED IN THE PROPOSAL SHALL GOVERN THIS IMPROVEMENT.

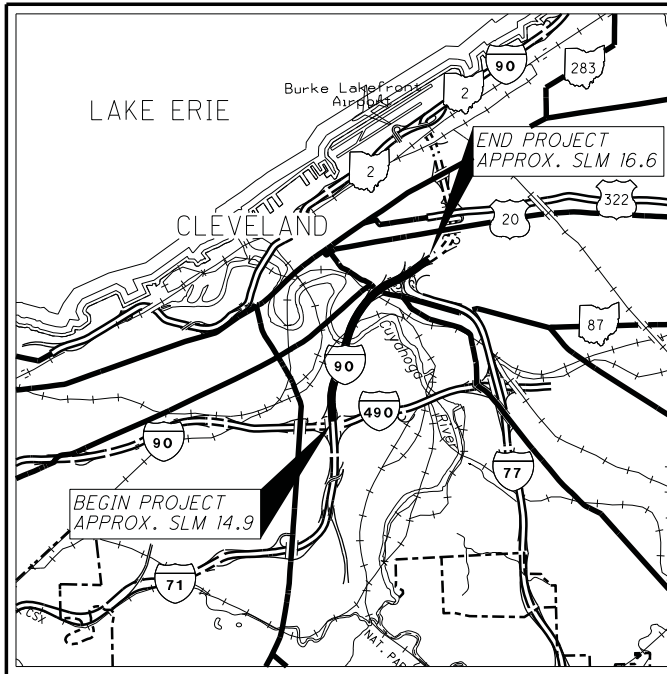

LOCATION MAP

LATITUDE: 41°29'12" LONGITUDE: 81°41'28"



PORTION TO BE IMPROVED.....	
INTERSTATE HIGHWAY.....	
STATE & FEDERAL ROUTES.....	
COUNTY & TOWNSHIP ROADS.....	
OTHER ROADS.....	

DESIGN DESIGNATION

SEE DWG. NO. DD-002 INCLUDED IN SURVEY CONTROL.

WALL "C"
WALL "C1"
WALL "C2"

UNDERGROUND UTILITIES
 CONTACT BOTH SERVICES
 CALL TWO WORKING DAYS
BEFORE YOU DIG

CALL
1-800-362-2764
 (TOLL FREE)

OHIO UTILITIES PROTECTION SERVICE
 NON-MEMBERS
 MUST BE CALLED DIRECTLY

OIL & GAS PRODUCERS PROTECTIVE
 SERVICE CALL: **1-800-925-0988**

WALSH
 WALSH CONSTRUCTION
 929 WEST ADAMS STREET
 CHICAGO, IL 60607

HNTB
 1100 Superior Ave. Ste 1330
 Cleveland, OH 44114

ENGINEERS SEAL:	ENGINEERS SEAL:
SIGNED: _____ DATE: _____	SIGNED: _____ DATE: _____

APPROVED _____
 DATE _____ DISTRICT DEPUTY DIRECTOR

APPROVED _____
 DATE _____ DIRECTOR, DEPARTMENT OF
 TRANSPORTATION

CORRECTED BY:
 VERIFIED BY:

CHECKED BY:
 BACKCHECKED BY:

CHECK PRINT (INITIAL & DATE)
 MADE BY:

9/20/2011 2:23:51 PM
 Model:Sheet1
 File:49633-S-BR-COV-C-C1_C2.dgn

NO.	REVISIONS	DATE
A	INTERIM REVIEW SUBMITTAL	09-19-11

DESIGN AGENCY
WALSH HNTB
 WALSH CONSTRUCTION

CONSTRUCTION PROJECT NO.
10-3000

CLEVELAND'S
INNERBELT BRIDGE
 RAILROAD INVOLVEMENT

FEDERAL PROJECT NO.
**E090(546)
 E100(247)**

PID NO.
77332 / 85531

DELIVERABLE ID
1440-WALL C

DWG. NO.
1 / 11

CUY-90-14.90

THE CONSTRUCTION OF THIS BUILDABLE UNIT WILL BE IN CONJUNCTION WITH THE CONSTRUCTION OF THE FOLLOWING BUILDABLE UNITS:

1011	SURVEY CONTROL
1020	ROADWAY - TREMONT
1020B	GRADING - TREMONT #2
1040	MOT - PHASES 1-2
1050	MOT - PHASE 3
1060	MOT - PHASE 4
1070	MOT - PHASE 5
1080	MOT - PHASE 6
1120	LIGHTING - TREMONT - ODOT
1130	LIGHTING - TREMONT - CITY
1210	BRIDGES CUY-90-1526 (BL-4)
2150	SWPPP - TREMONT

STANDARD DRAWINGS AND SUPPLEMENTAL SPECIFICATIONS:

REFER TO THE FOLLOWING STANDARD CONSTRUCTION DRAWING(S):

DM-1.1	DATED (REVISED)	04-21-2006
A-1-69	DATED (REVISED)	07-19-2002

REFER TO APPENDIX SS-1 FOR THE FOLLOWING SUPPLEMENTAL SPECIFICATION:

MODIFIED SS 840	DATED (REVISED)	06-03-2010
SS 836	DATED (REVISED)	04-15-2005

DESIGN SPECIFICATIONS:

AMERICAN ASSOCIATION OF STATE HIGHWAY AND TRANSPORTATION OFFICIALS, (AASHTO) 2010, AASHTO LRFD BRIDGE DESIGN SPECIFICATIONS, 5TH EDITION, AND 2007 EDITION OF THE OHIO DEPARTMENT OF TRANSPORTATION (ODOT) BRIDGE DESIGN MANUAL WITH SUBSEQUENT UPDATES THROUGH APRIL 2010.

DESIGN DATA:

CONCRETE CLASS C - REFER TO CMS 511, COMPRESSIVE STRENGTH 4,000 PSI (CONCRETE COPING AND LEVELING PAD)

REINFORCING STEEL - ASTM A615 OR A996 GRADE 60, MINIMUM YIELD STRENGTH 60,000 PSI. (EPOXY COATED)

WALL DESIGN CRITERIA:

REFER TO GEOTECHNICAL DESIGN MEMORANDUM GD-9, REVISION NO. 3, DATED 9-16-2011. WALL DESIGN BASED ON SUBGRADE SOIL EFFECTIVE FRICTION ANGLE $\phi = 30^\circ$ (C AND C1), $\phi = 28^\circ$ (C2)

UNSUITABLE SOILS:

NO UNSUITABLE SOILS ANTICIPATED

QUANTITIES:

THE FOLLOWING WALL C ESTIMATED QUANTITIES HAVE BEEN INCLUDED IN THE ESTIMATED QUANTITIES FOR USE AS DIRECTED BY THE ENGINEER:

ITEM 203 SELECT GRANULAR BACKFILL, AS PER PLAN	39 CU YD
ITEM 304 OR 601 COMPACTED AGGREGATE	576 CU YD
ITEM 840 WALL EXCAVATION, ESTIMATED	290 CU YD

THE FOLLOWING WALL C1 ESTIMATED QUANTITIES HAVE BEEN INCLUDED IN THE ESTIMATED QUANTITIES FOR USE AS DIRECTED BY THE ENGINEER:

ITEM 203 SELECT GRANULAR BACKFILL, AS PER PLAN	4508 CU YD
ITEM 512 EPOXY-URETHANE SEALER, AS PER PLAN	576 SQ YD
ITEM 840 WALL EXCAVATION, ESTIMATED	653 CU YD

THE FOLLOWING WALL C2 ESTIMATED QUANTITIES HAVE BEEN INCLUDED IN THE ESTIMATED QUANTITIES FOR USE AS DIRECTED BY THE ENGINEER:

ITEM 203 SELECT GRANULAR BACKFILL, AS PER PLAN	14 CU YD
ITEM 304 OR 601 COMPACTED AGGREGATE	286 CU YD
ITEM 840 WALL EXCAVATION, ESTIMATED	0 CU YD

PROPRIETARY RETAINING WALL DATA

THE PROPRIETARY WALL SUPPLIER SHALL DESIGN THE INTERNAL STABILITY OF A MECHANICALLY STABILIZED EARTH (MSE) WALL IN ACCORDANCE WITH MODIFIED SS840 (SS-01) TO SUPPORT THE ABUTMENT. THE DESIGN FOR INTERNAL STABILITY SHALL INCLUDE A NOMINAL (I.E., UNFACTORED) HORIZONTAL STRIP LOAD DUE TO FRICTION (FR) FROM THE SUPERSTRUCTURE OF 2.3 K/FT. APPLIED PERPENDICULAR TO THE FACE OF WALL AT THE BASE OF THE CONCRETE FOOTING. THIS STRIP LOAD DOES NOT INCLUDE EARTH PRESSURE LOADS FROM THE ABUTMENT BACKFILL. HOWEVER, THE PROPRIETARY WALL SUPPLIER SHALL INCLUDE AT REST EARTH PRESSURE LOADS FROM THE ABUTMENT BACKFILL IN THE DESIGN CALCULATIONS. CONTINUOUS REINFORCEMENT SHALL NOT BE USED BY THE PROPRIETARY WALL SUPPLIER.

EXCAVATION, SHEETING AND BRACING

EXCAVATION ENVELOPES AS DETAILED IN THE PLANS SHOULD BE PROTECTED FROM CAVING AND SLOUGHING. WHERE CLEARANCES AND CONSTRUCTION SEQUENCING WILL NOT ALLOW FOR SLOPED EXCAVATIONS, APPROPRIATE SHEETING OR BRACING METHODS SHALL BE EMPLOYED BY THE CONTRACTOR.

GRAVITY WALL

PART 1: GENERAL

- 1.1 SCOPE
WORK INCLUDES FURNISHING AND INSTALLING CONCRETE RETAINING WALL UNITS TO THE LINES AND GRADES DESIGNATED ON THE CONSTRUCTION DRAWINGS AND AS SPECIFIED HEREIN.
- 1.2 REFERENCE STANDARDS
ASTM C94 READY-MIXED CONCRETE
ASTM C1372 SEGMENTAL RETAINING WALL UNITS
- 1.3 DELIVERY, STORAGE, AND HANDLING
A. CONTRACTOR SHALL CHECK THE MATERIALS UPON DELIVERY TO ASSURE PROPER MATERIAL HAS BEEN RECEIVED.
B. CONTRACTOR SHALL PREVENT EXCESSIVE MUD, WET CEMENT AND LIKE MATERIALS FROM COMING IN CONTACT WITH THE SRW UNITS.
C. CONTRACTOR SHALL PROTECT THE MATERIALS FROM DAMAGE. DAMAGED MATERIAL SHALL NOT BE INCORPORATED IN THE PROJECT

PART 2: MATERIALS

- 2.1 WALL UNITS
A. WALL UNITS SHALL BE REDI-ROCK AS PRODUCED BY A LICENSED MANUFACTURER.
B. WALL UNITS SHALL BE MADE WITH READY-MIXED CONCRETE IN ACCORDANCE WITH ASTM C94, LATEST REVISION, AND PER THE FOLLOWING CHART:

CLIMATE	AIR CONTENT	28 DAY COMPRESSIVE STRENGTH (PSI)	SLUMP*
SEVERE	4 1/2% - 7 1/2%	4000	5" +/- 1 1/2"

* HIGHER SLUMPS ARE ALLOWED IF ACHIEVED BY USE OF APPROPRIATE ADMIXTURES. NOTWITHSTANDING ANYTHING STATED ABOVE, ALL MATERIAL USED IN THE WALL UNITS MUST MEET APPLICABLE ASTM AND LOCAL REQUIREMENTS FOR EXTERIOR CONCRETE.

- C. EXTERIOR BLOCK DIMENSIONS SHALL BE UNIFORM AND CONSISTENT. MAXIMUM DIMENSIONAL DEVIATIONS SHALL BE 1% EXCLUDING THE ARCHITECTURAL SURFACE. MAXIMUM WIDTH (FACE TO BACK) DEVIATION INCLUDING THE ARCHITECTURAL SURFACE SHALL BE 1.0 INCH.
- D. EXPOSED FACE SHALL BE FINISHED AS SPECIFIED. OTHER SURFACES TO BE SMOOTH FORM TYPE. DIME-SIZE BUG HOLES ON THE BLOCK FACE MAY BE PATCHED AND/OR SHAKE-ON COLOR STAIN CAN BE USED TO BLEND INTO THE REMAINDER OF THE BLOCK FACE.
- 2.2 LEVELING PAD AND FREE DRAINING BACKFILL
A. LEVELING PAD SHALL BE CRUSHED STONE. SEE DETAIL SHEET DEFINING LEVELING PAD OPTIONS FOR DRAIN PLACEMENT IN THE BOTTOM OF THE FOUNDATION LEVELING PAD.
B. FREE DRAINING BACKFILL MATERIAL SHALL BE WASHED STONE AND SHALL BE PLACED TO A MINIMUM OF 1" WIDTH BEHIND THE BACK OF THE WALL AND SHALL EXTEND VERTICALLY FROM THE LEVELING PAD TO AN ELEVATION 4" BELOW THE TOP OF WALL.
C. BACKFILL MATERIAL SHALL BE APPROVED BY THE GEOTECHNICAL ENGINEER. SITE EXCAVATED SOILS MAY BE USED IF APPROVED UNLESS OTHERWISE SPECIFIED IN THE DRAWINGS. UNSUITABLE SOILS WITH A PL>6, ORGANIC SOILS AND FROST SUSCEPTIBLE SOILS SHALL NOT BE USED WITHIN A 1 TO 1 INFLUENCE AREA.
D. WHERE ADDITIONAL FILL IS NEEDED, CONTRACTOR SHALL SUBMIT SAMPLE AND SPECIFICATIONS TO THE ENGINEER FOR APPROVAL.

- 2.3 BACKFILL MATERIAL
A. BACKFILL MATERIAL SHALL CONFORM TO CMS 703.17 (AGGREGATE MATERIALS FOR ITEM 304 AGGREGATE BASE) OR CMS 703.19A (CRUSHED AGGREGATE SLOPE PROTECTION AND FILTER AGGREGATE FOR ITEM 601 SLOPE AND CHANNEL PROTECTION)

PART 3: CONSTRUCTION OF WALL SYSTEM

- 3.1 EXCAVATION
A. CONTRACTOR SHALL EXCAVATE TO THE LINES AND GRADES SHOWN ON THE CONSTRUCTION DRAWINGS.
- 3.2 FOUNDATION SOIL PREPARATION
A. NATIVE FOUNDATION SOIL SHALL BE COMPACTED TO 95% OF STANDARD PROCTOR OR 90% OF MODIFIED PROCTOR PRIOR TO PLACEMENT OF THE LEVELING PAD MATERIAL.
B. IN-SITU FOUNDATION SOIL SHALL BE EXAMINED BY THE ENGINEER TO ASSESS WHETHER THE ACTUAL FOUNDATION SOILS ARE CONSISTENT WITH FOUNDATION SOILS ASSUMED DURING DESIGN. SOIL NOT CONSISTENT WITH DESIGN SOIL SHALL BE REMOVED AND REPLACED WITH ACCEPTABLE, COMPACTED MATERIAL.
- 3.3 LEVELING PAD PLACEMENT
A. LEVELING PAD SHALL BE PLACED AS SHOWN ON THE CONSTRUCTION DRAWINGS.
B. LEVELING PAD SHALL BE PLACED ON UNDISTURBED NATIVE SOILS OR SUITABLE REPLACEMENTS FILLS.
C. LEVELING PAD SHALL BE COMPACTED TO 95% OF STANDARD PROCTOR OR 90% OF MODIFIED PROCTOR TO ENSURE A LEVEL, HARD SURFACE ON WHICH TO PLACE THE FIRST COURSE BLOCKS. PAD SHALL BE CONSTRUCTED TO THE PROPER ELEVATION TO ENSURE THE FINAL ELEVATION SHOWN ON THE PLANS.
D. LEVELING PAD SHALL HAVE A 6 INCH MINIMUM DEPTH FOR WALLS UNDER 8 FEET IN HEIGHT AND A 12 INCH MINIMUM DEPTH FOR WALLS OVER 8 FEET. PAD DIMENSIONS SHALL EXTEND BEYOND THE BLOCKS IN ALL DIRECTIONS TO A DISTANCE AT LEAST EQUAL TO THE DEPTH OF THE PAD OR AS DESIGNED BY ENGINEER.
E. FOR STEPS AND PAVERS, A MINIMUM OF 1" - 1 1/2" OF FREE DRAINING SAND SHALL BE SCREEDED SMOOTH TO ACT AS A PLACEMENT BED FOR THE STEPS OR PAVERS.
- 3.4 UNIT INSTALLATION
A. THE FIRST COURSE OF WALL UNITS SHALL BE PLACED ON THE PREPARED LEVELING PAD WITH THE AESTHETIC SURFACE FACING OUT AND THE FRONT EDGES TIGHT TOGETHER. ALL UNITS SHALL BE CHECKED FOR LEVEL AND ALIGNMENT AS THEY ARE PLACED.
B. ENSURE THAT UNITS ARE IN FULL CONTACT WITH LEVELING PAD. PROPER CARE SHALL BE TAKEN TO DEVELOP STRAIGHT LINES AND SMOOTH CURVES ON BASE COURSE AS PER WALL LAYOUT.
C. THE BACKFILL IN FRONT AND BACK OF ENTIRE BASE ROW SHALL BE PLACED AND COMPACTED TO FIRMLY LOCK THEM IN PLACE. CHECK ALL UNITS AGAIN FOR LEVEL AND ALIGNMENT. ALL EXCESS MATERIAL SHALL BE SWEEPED FROM TOP OF UNITS.
D. INSTALL NEXT COURSE OF WALL UNITS ON TOP OF BASE ROW. POSITION BLOCKS TO BE OFFSET FROM SEAMS OF BLOCKS BELOW. BLOCKS SHALL BE PLACED FULLY FORWARD SO KNOB AND GROOVE ARE ENGAGED. CHECK EACH BLOCK FOR PROPER ALIGNMENT AND LEVEL. BACKFILL TO 12 INCH WIDTH BEHIND BLOCK WITH FREE DRAINING BACKFILL. SPREAD BACKFILL IN UNIFORM LIFTS NOT EXCEEDING 9 INCHES. EMPLOY METHODS USING LIGHTWEIGHT COMPACTION EQUIPMENT THAT WILL NOT DISRUPT THE STABILITY OR BATTER OF THE WALL. HAND-OPERATED PLATE COMPACTION EQUIPMENT SHALL BE USED AROUND THE BLOCK AND WITHIN 3 FEET OF THE WALL TO ACHIEVE CONSOLIDATION. COMPACT BACKFILL TO 95% OF STANDARD PROCTOR (ASTM D 698, AASHTO T-99) DENSITY WITHIN 2% OF ITS OPTIMUM MOISTURE CONTENT.
E. INSTALL EACH SUBSEQUENT COURSE IN LIKE MANNER. REPEAT PROCEDURE TO THE EXTENT OF WALL HEIGHT.
F. ALLOWABLE CONSTRUCTION TOLERANCE AT THE WALL FACE IS 2 DEGREES VERTICALLY AND 1 INCH IN 10 FEET HORIZONTALLY.

CORRECTED BY:
VERIFIED BY:

CHECKED BY:
BACKCHECKED BY:

CHECK PRINT (INITIAL & DATE)
MADE BY:

Date: 20-SEP-2011
Model: Sheet1
File: IP_PWP:dms72787.49633-S-BR-GEN-C.dgn

NO.	REVISIONS	DATE
A	INTERIM REVIEW SUBMITTAL	09-19-11



WALL C

DESIGNED	AKS	DATE	9-13-11
CHECKED	CAB	REVIEWED	DBT
CHECKED	CAB	STRUCTURE FILE NUMBER	
CUY-90-14.90			
PID No. 77332 / 85631			
3 / 11			

GENERAL NOTES
WALLS C, C1, AND C2
ALONG I.R. 90 WESTBOUND, FARIFIELD AVE. AND RAMP A6

PRELIMINARY NOT FOR CONSTRUCTION

CORRECTED BY:
VERIFIED BY:

CHECKED BY:
BACKCHECKED BY:

(TO BE TURNED OFF AT AFC SUBMITTAL)
CHECK PRINT (INITIAL & DATE)
MADE BY:


NO.	REVISIONS	DATE
A	INTERIM REVIEW SUBMITTAL	09-19-11

DESIGN AGENCY
WASH HNTB
WALSH CONSTRUCTION

CLEVELAND'S
INNERBELT BRIDGE
90
TRANSFORMATION

WALL C
SITE PLAN - 1
WALLS C, C1, AND C2
ALONG I.R. 90 WESTBOUND, FAIRFIELD AVE. AND RAMP A6

DESIGNED	DATE	REVIEWED	DATE
AKS	9-13-11	DBT	9-13-11
CHECKED	STRUCTURE FILE NUMBER	CDD	CAB
CAB	CUY-90-14.90		
CAB	PID NO. 77332 / 85531		

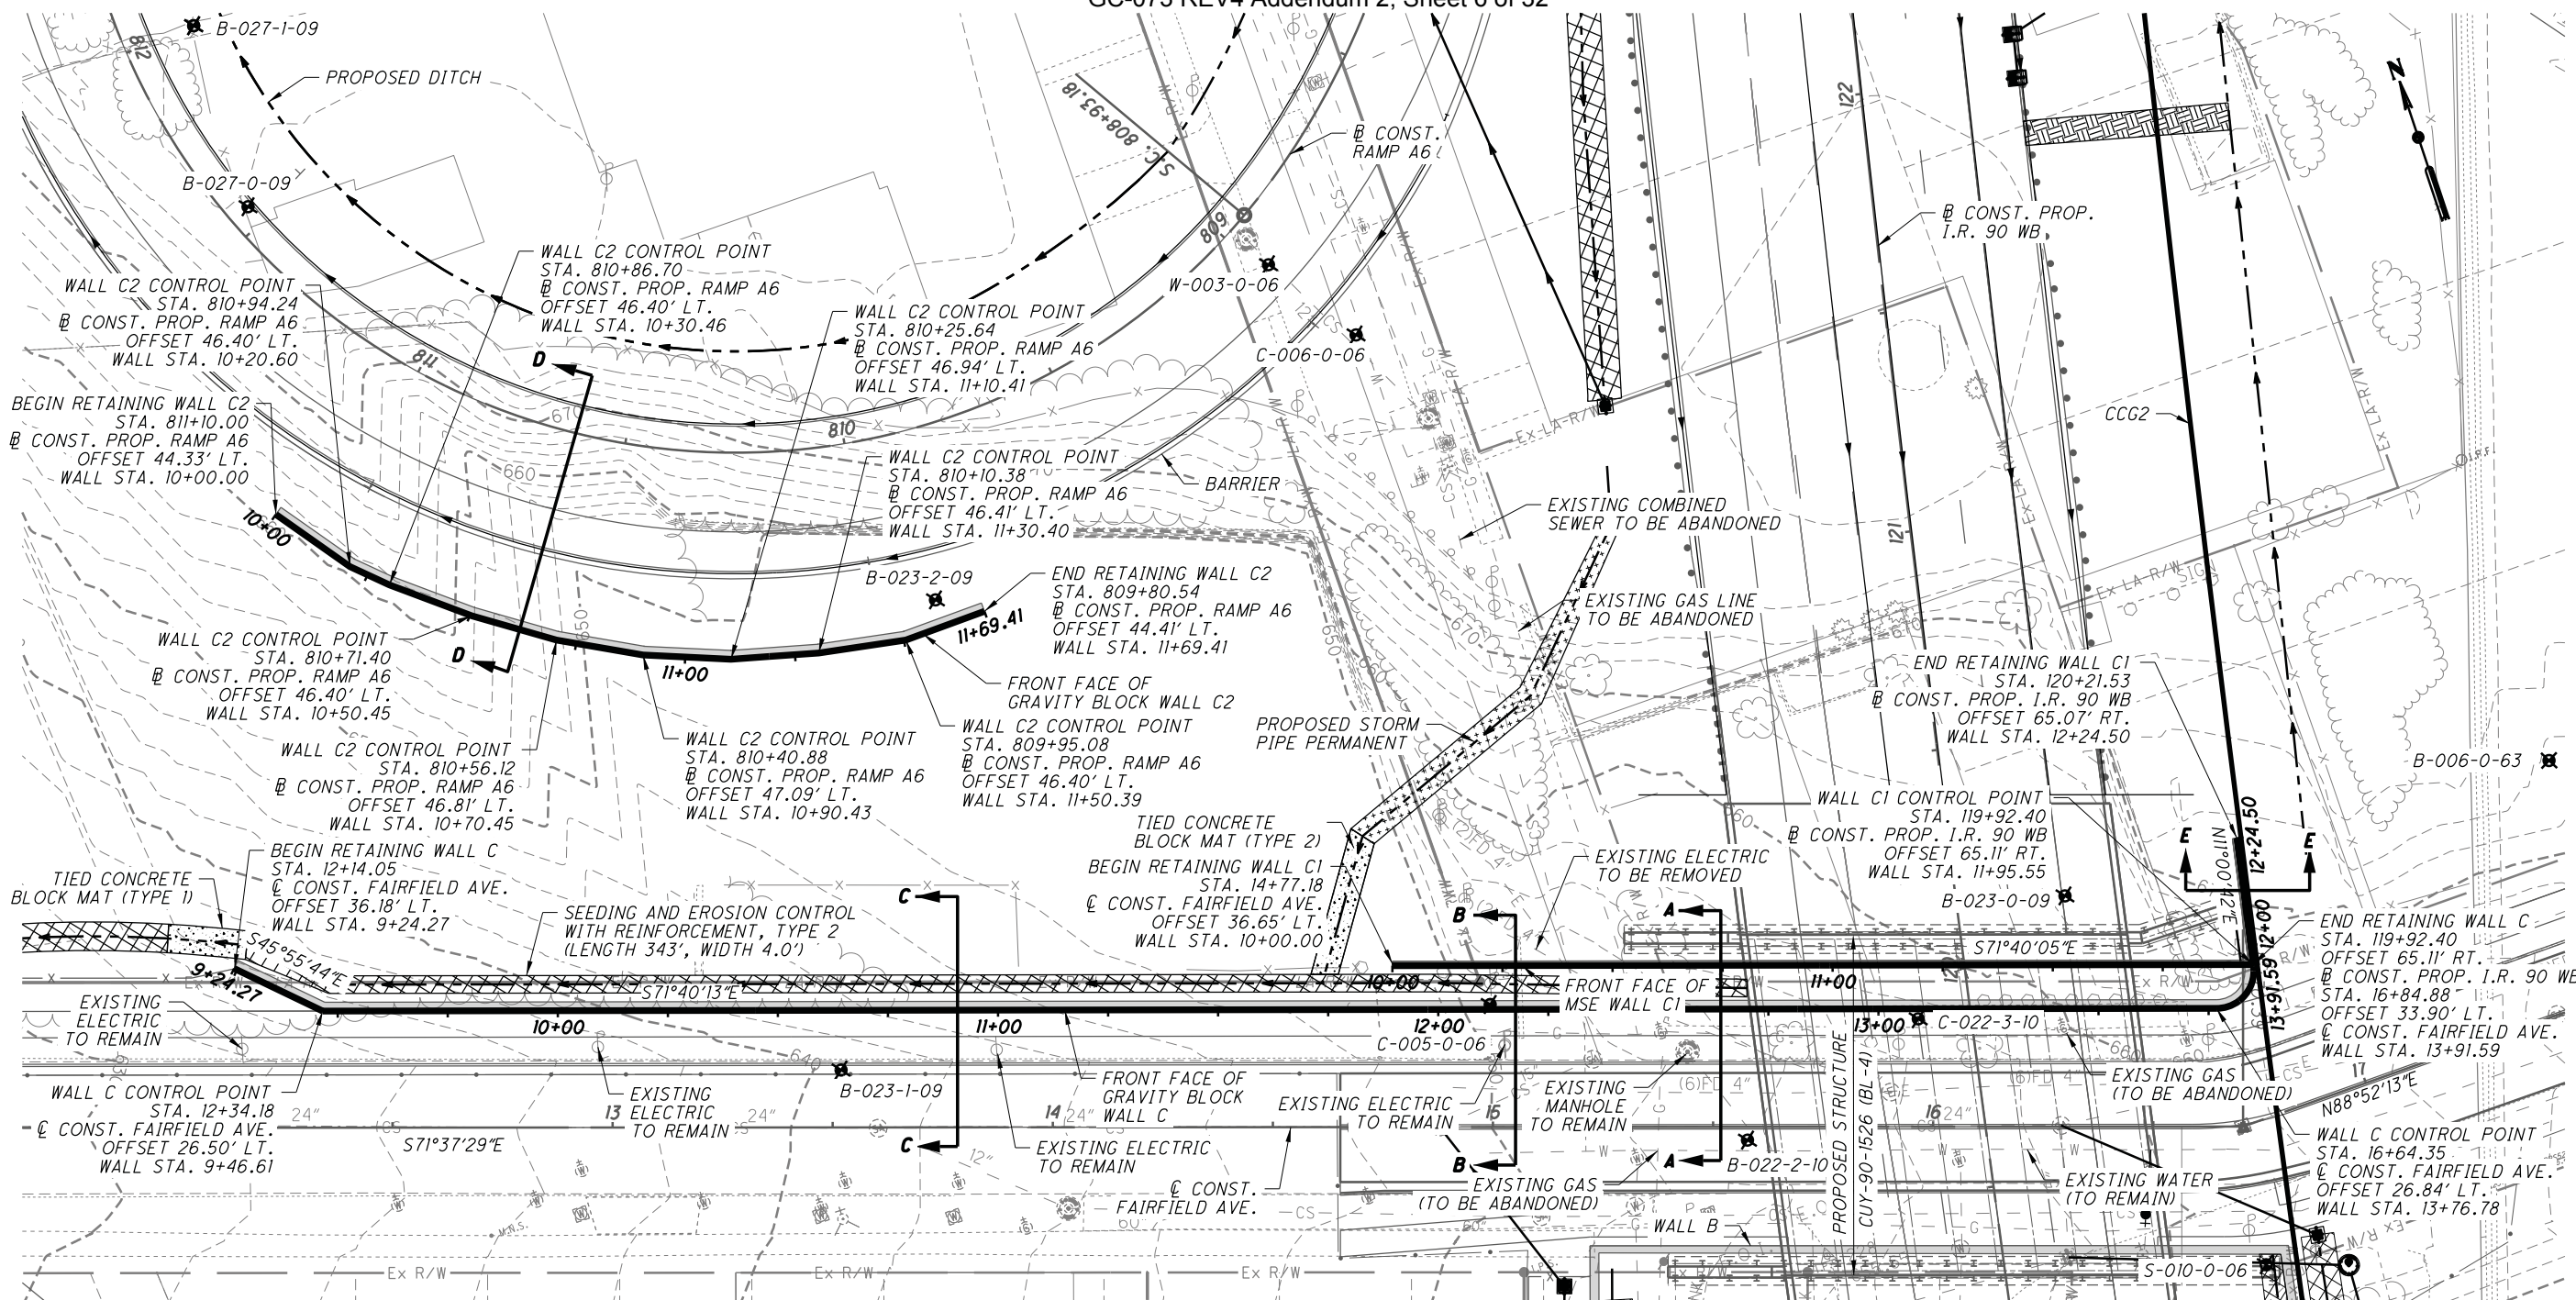

PLAN

NOTES:

1. WALL C1 BASELINE IS LOCATED AT FRONT FACE OF MSE WALL.
2. WALL C AND C2 BASELINE IS LOCATED AT FRONT FACE OF BOTTOM OF GRAVITY BLOCK WALL.
3. FOR ELEVATION OF WALL C AND C1, SEE SHEET 5 OF 11.
4. FOR ELEVATION OF WALL C2, SEE SHEET 6 OF 11.
5. FOR SECTION A-A, SEE SHEET 9 OF 11.
6. FOR SECTION B-B, SEE SHEET 10 OF 11.
7. FOR SECTIONS C-C AND D-D, SEE SHEET 11 OF 11.
8. BORING AND CPT STATION/OFFSET BASED ON B CONST. PROP. I.R. 90 WB ALIGNMENT.
9. TURF REINFORCING MATERIALS SHALL MEET MANUFACTURER REQUIREMENTS FOR THE SLOPES AND GRADES SHOWN ON THE PLANS. INSTALLATION SHALL BE IN ACCORDANCE WITH SS 836 AND MANUFACTURER RECOMMENDATIONS.

BORING AND CPT LOCATIONS		
BORING / CPT	STATION	OFFSET
S-010-0-06	119+24.00	59.0' RT.
B-022-2-10	119+68.00	54.0' LT.
B-023-0-09	120+13.44	24.67' RT
B-006-0-63	120+30.00	138.0' RT
C-022-3-10	119+90.00	12.0' LT
B-025-0-09	121+21.32	46.79' LT
C-005-0-06	120+05.00	108.00' LT

BORING AND CPT LOCATIONS		
BORING / CPT	STATION	OFFSET
B-023-2-09	121+09.76	221.81' LT
B-027-0-09	122+13.00	367.00' LT
B-027-1-09	122+54.42	374.99' LT
W-003-0-06	121+76.00	138.00' LT
C-006-0-09	121+58.00	120.00' LT

BENCHMARK DATA	
SEE BM24 ON DWG. NO. BM-004	INCLUDED IN SURVEY CONTROL


LIST OF UTILITIES	
EXIST. COMBINED SEWERS	IMPACTED
EXIST. ELECTRIC LINES	IMPACTED

LEGEND
 BORING OR CPT LOCATION
 SEEDING AND EROSION CONTROL WITH TURF REINFORCING, TYPE 2, PER SS 836
 TIED CONCRETE BLOCK MAT (TYPE 1 OR TYPE 2)
 'B', 'W' OR 'S' = BORINGS
 'C' = CONE PENETROMETER TEST (CPT) SOUNDINGS


B CONST. PROP. I.R. 90 WB
 CURVE DATA:
 P.I. = STA. 126+69.54
 $\Delta = 16^\circ 25' 51''$ RT.
 $D_c = 00^\circ 35' 00''$
 $R = 9822.14'$
 $T = 1418.10'$
 $L = 2816.74'$
 $E = 101.84'$

B CONST. PROP. RAMP A6:
 P.I. = STA. 836+03.51
 $\Delta = 173^\circ 37' 54''$ RT.
 $D_c = 38^\circ 00' 00''$
 $R = 150.78'$
 $T = 2710.33'$
 $L = 456.93'$
 $E = 2563.74'$

C CONST. FAIRFIELD AVE.
 TANGENT DATA:
 P.I. = STA. 16+70.39
 $\Delta Dir = S71^\circ 37' 29'' E$
 $L = 670.39'$

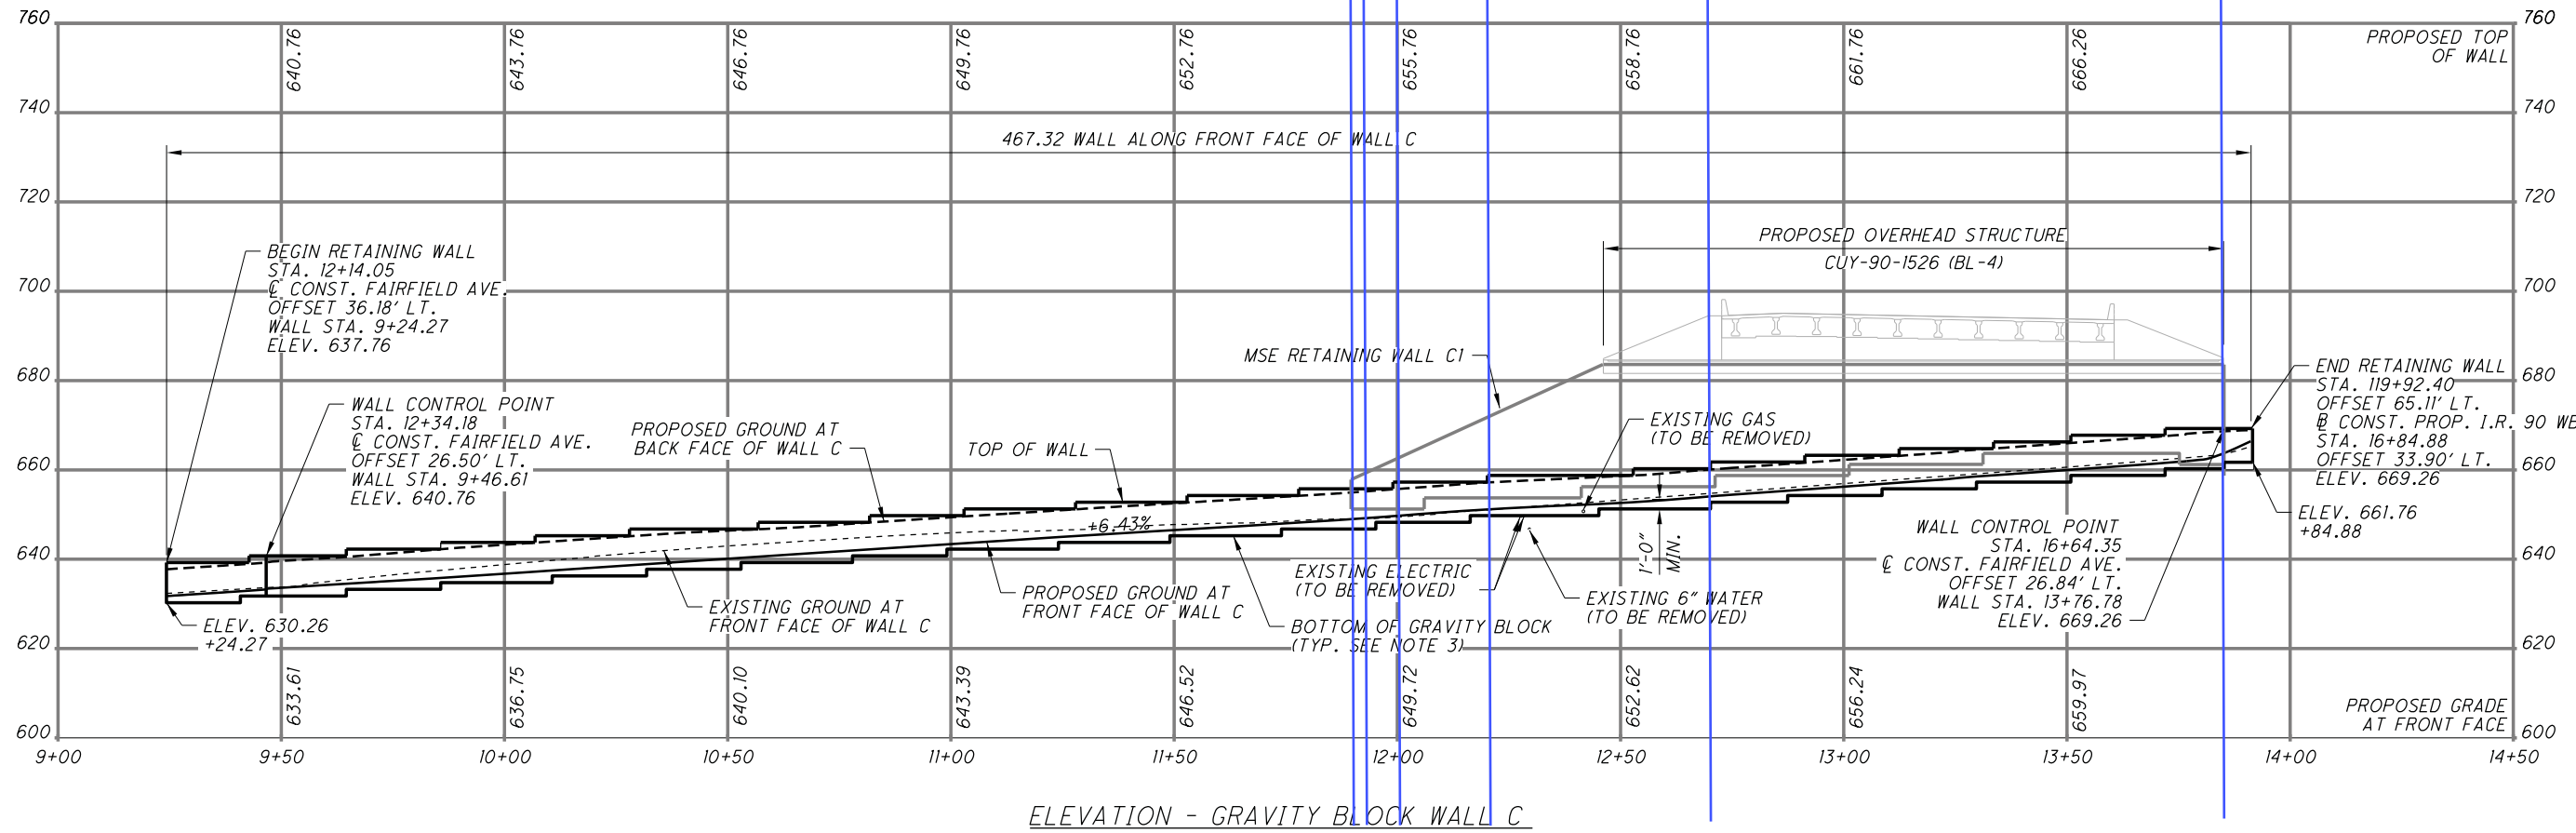

ELEVATION - GRAVITY BLOCK WALL C

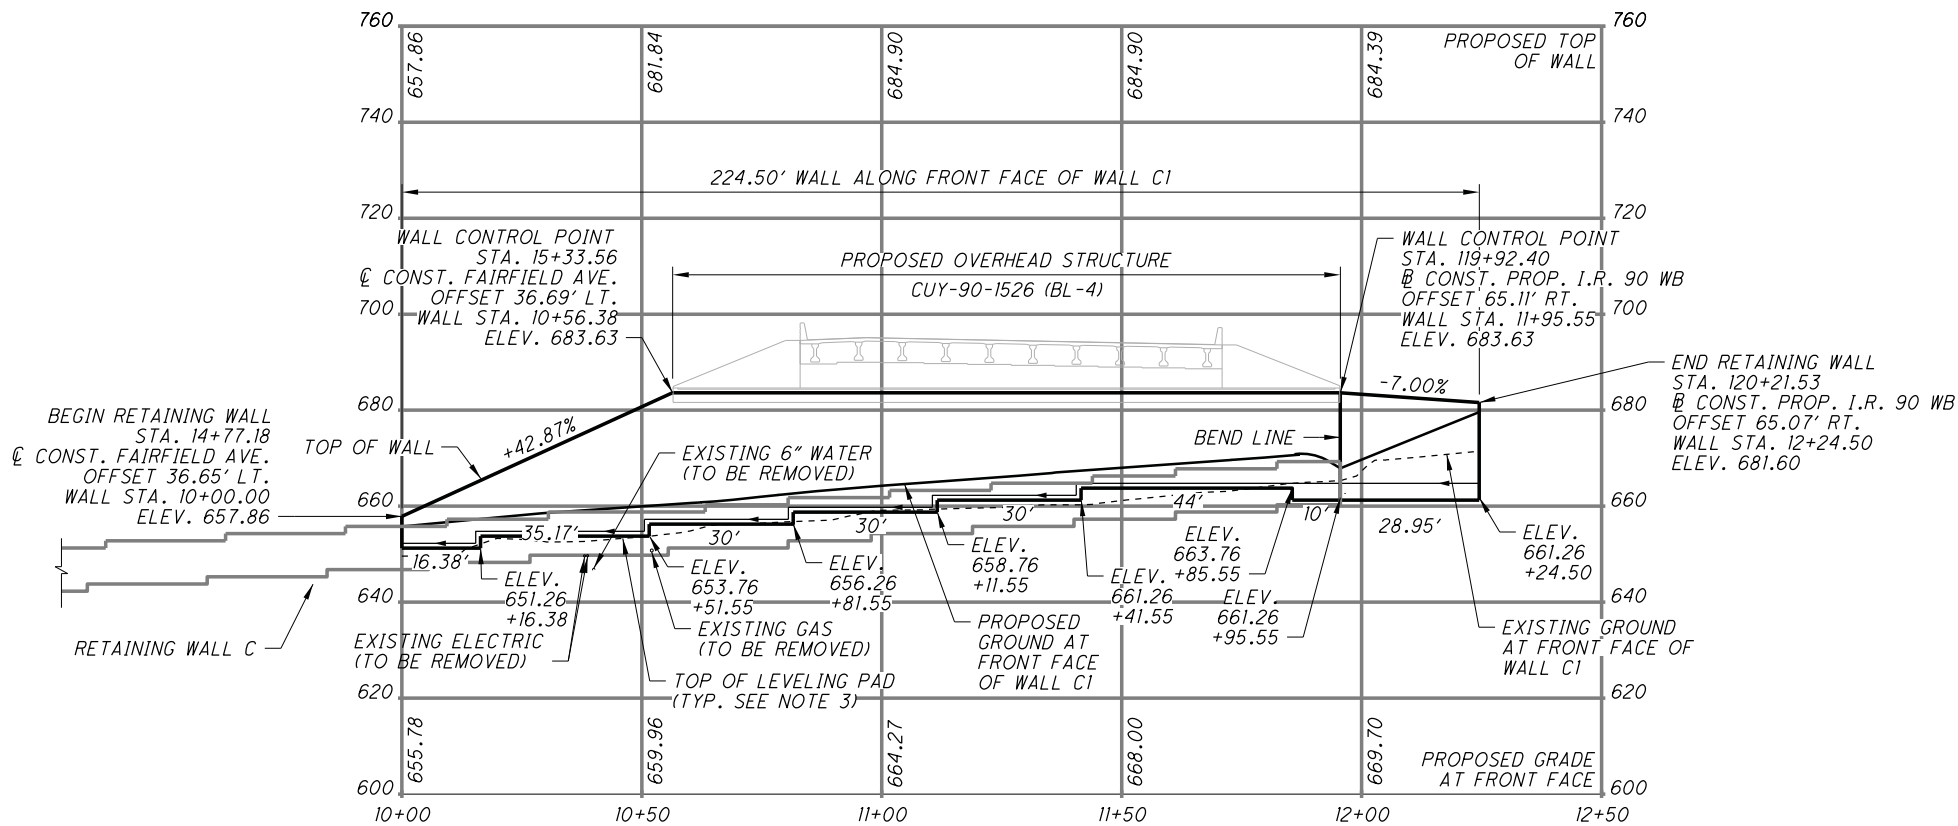

ELEVATION - MSE RETAINING WALL C1

NOTES:

1. ALL TOP OF WALL C ELEVATIONS ARE GIVEN AT THE TOP OF GRAVITY BLOCK.
2. ALL TOP OF WALL C1 ELEVATIONS ARE GIVEN AT THE TOP OF COPING.
3. MINIMUM DISTANCE FROM PROPOSED GROUND SURFACE TO THE TOP OF LEVELING PAD FOR WALL C1 AND BOTTOM OF GRAVITY BLOCK FOR WALL C IS DETERMINED BASED ON MIN. EMBEDMENT = 1'-0".
4. FOR PLAN VIEW OF WALLS C AND C1, SEE SHEET 4 OF 11.


CORRECTED BY:
VERIFIED BY:

CHECKED BY:
BACKCHECKED BY:

CHECK PRINT (INITIAL & DATE)
MADE BY:

Date: 9/20/2011
Model: Sheet1
File: 49633-S-BR-RET-C1.dgn

DESIGNED AKS	DRAWN CDD	CHECKED CAB	REVIEWED DBT	DATE 9-13-11
			STRUCTURE FILE NUMBER	
DESIGNED AKS	DRAWN CDD	CHECKED CAB	REVIEWED DBT	DATE 9-13-11
			STRUCTURE FILE NUMBER	
DESIGN AGENCY WALSH HNTB WALSH CONSTRUCTION				
PROJECT TITLE WALL C				
SITE PLAN - 2 WALLS C, C1, AND C2 ALONG I.R. 90 WESTBOUND, FARIFIELD AVE. AND RAMP A6				
CUY-90-14.90 PID NO. 77332 / 85531				
PRELIMINARY NOT FOR CONSTRUCTION				

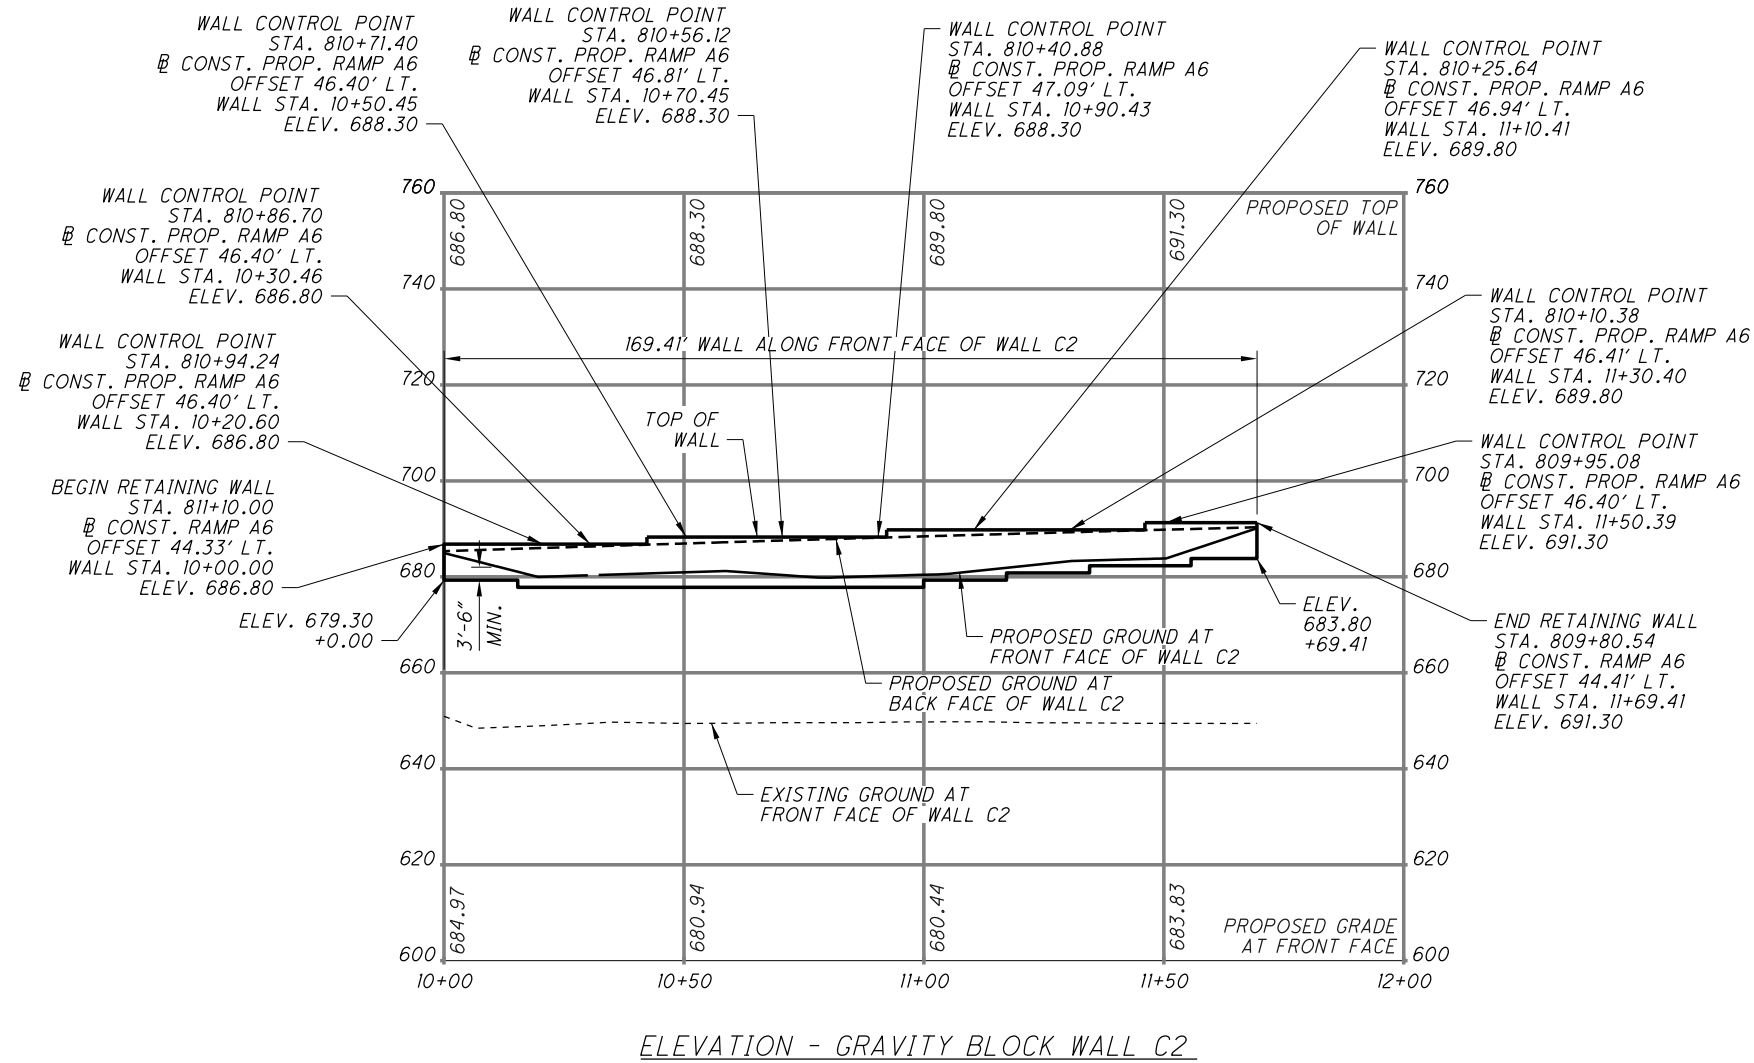

NOTES:


1. ALL TOP OF WALL C2 ELEVATIONS ARE GIVEN AT THE TOP OF GRAVITY BLOCK.
2. MINIMUM DISTANCE FROM PROPOSED GROUND SURFACE TO THE TOP OF GRAVITY BLOCK FOR WALL C2 IS DETERMINED BASED ON MIN. EMBEDMENT = 3'-6".
3. FOR PLAN VIEW OF WALL C2, SEE SHEET 4 OF 11.

(TO BE TURNED OFF AT AFC SUBMITTAL)
 CHECKED BY: CORRECTED BY:
 BACKCHECKED BY: VERIFIED BY:
 MADE BY:

Date: 9/20/2011
 Model: Sheet1
 File: 49633-S-BR-RET-C2.dgn

ENGINEER'S SEAL

NO.	REVISIONS	DATE
A	INTERIM REVIEW SUBMITTAL	09-19-11

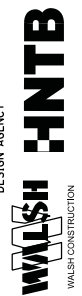


WALL C

SITE PLAN - 3
 WALLS C, C1, AND C2
 ALONG I.R. 90 WESTBOUND, FARIFIELD AVE. AND RAMP A6

DESIGNED	DRAWN	REVIEWED	DATE
AKS	CDD	DBT	9-13-11
CAB	CAB	CAB	STRUCTURE FILE NUMBER

CUY-90-14.90
 PID NO. 77332 / 85531


PRELIMINARY NOT FOR CONSTRUCTION

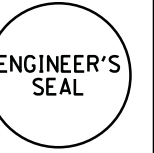

DATE
09-19-11

REVISIONS
INTERIM REVIEW SUBMITTAL

NO. A

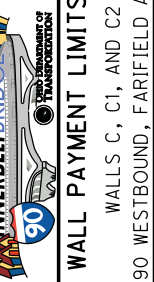

WALL C

REVIEWED DATE
DBT 9-13-11
STRUCTURE FILE NUMBER

DRAWN CDD
CHECKED CAB

DESIGNED AKS
CHECKED CAB

WALL PAYMENT LIMITS - 1
WALLS C, C1, AND C2
ALONG I.R. 90 WESTBOUND, FARFIELD AVE. AND RAMP A6


CUY-90-14.90
PID No. 77332 / 85531

7 / 11

CORRECTED BY:
VERIFIED BY:
CHECKED BY:
BACKCHECKED BY:
MADE BY:

(TO BE TURNED OFF AT AFC SUBMITTAL)
CHECK PRINT (INITIAL & DATE)

Date: 9/20/2011
Model: Sheet2
File: 49633-S-BR-RET-C.dgn

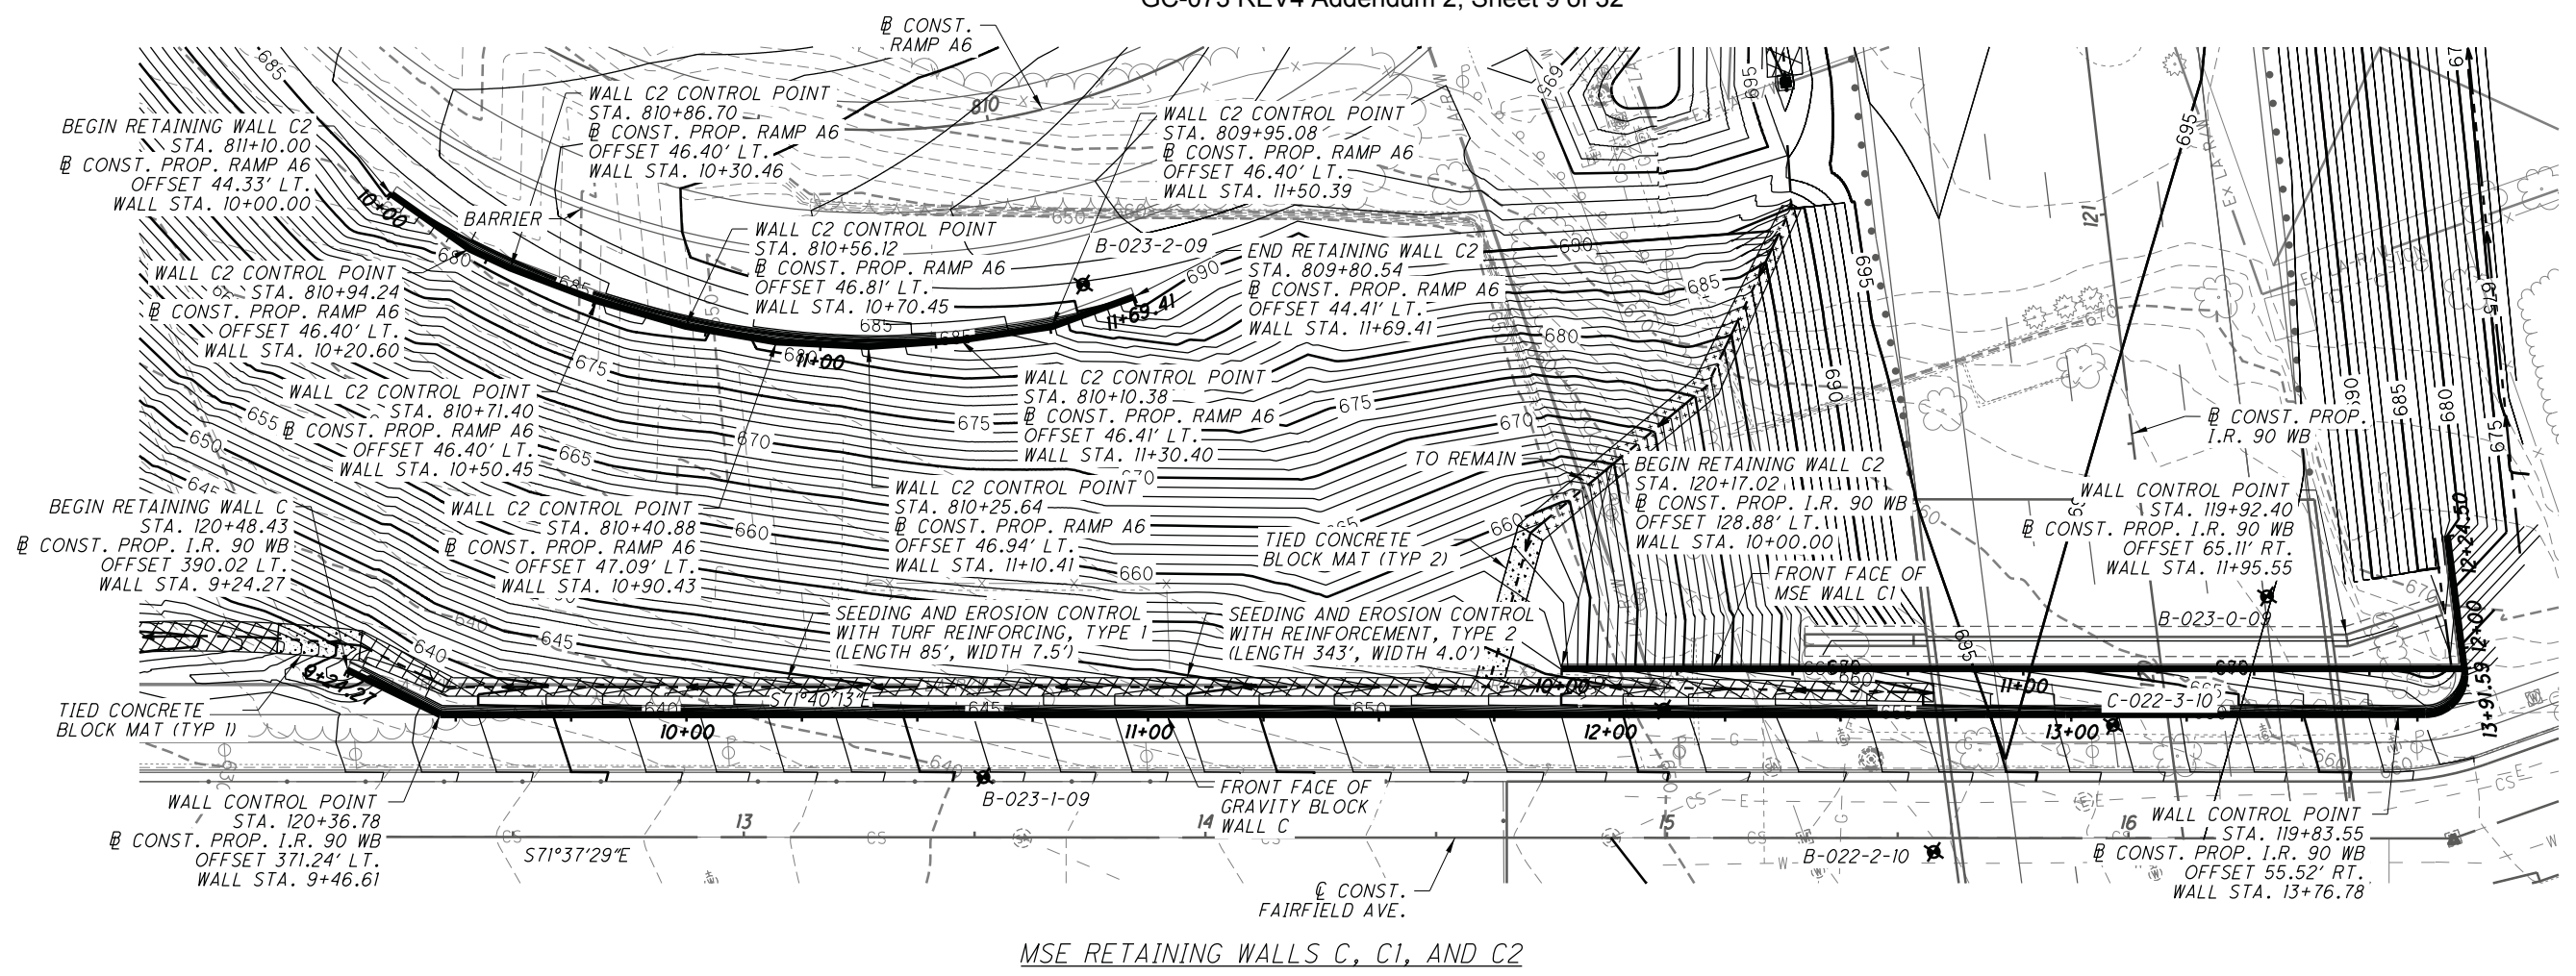


MSE RETAINING WALLS C, C1, AND C2

CONST. PROP. I.R. 90 WB CURVE DATA:
P.I. = STA. 126+69.54
 $\Delta = 16^\circ 25' 51''$ RT.
Dc = 00°35'00"
R = 9822.14'
T = 1418.10'
L = 2816.74'
E = 101.84'

CONST. FAIRFIELD AVE. TANGENT DATA:
P.I. = STA. 16+70.39
Dir = $S71^\circ 37' 29''$ E
L = 670.39'

CONST. PROP. RAMP A6:
P.I. = STA. 836+03.51
 $\Delta = 173^\circ 37' 54''$ RT.
Dc = 38°00'00"
R = 150.78'
T = 2710.33'
L = 456.93'
E = 2563.74'

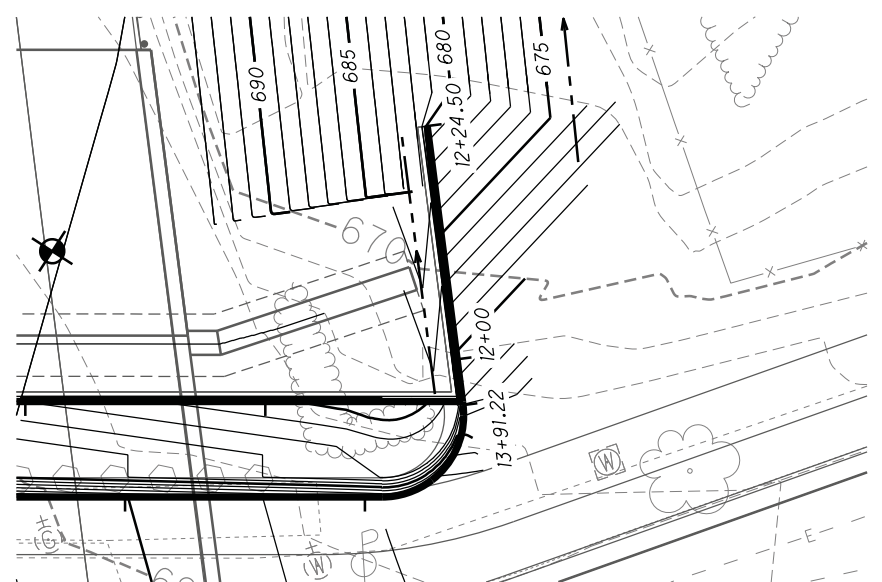

PROPOSED GRADING AT END WALL C (12+24.50)

PROPOSED GRADING AT END WALL C1 (13+91.22)

LEGEND


- SEEDING AND EROSION CONTROL WITH TURF REINFORCING, TYPE 2, PER SS 836
- TIED CONCRETE BLOCK MAT (TYPE 1 OR TYPE 2)

NOTES:


1. STATIONS AND OFFSETS ARE MEASURED FROM FRONT FACE OF MSE WALL FACING PANELS.
2. ELEVATION OF 6" ϕ PERFORATED PLASTIC PIPE WILL VARY TO PROVIDE INVERT ELEVATION AT OUTLET.

PRELIMINARY NOT FOR CONSTRUCTION


Date: 9/20/2011
 Model: Sheet2
 File: 49633-S-BR-RET-C1.dgn
 CHECK PRINT (INITIAL & DATE)
 MADE BY:
 CHECKED BY:
 BACKCHECKED BY:
 CORRECTED BY:
 VERIFIED BY:

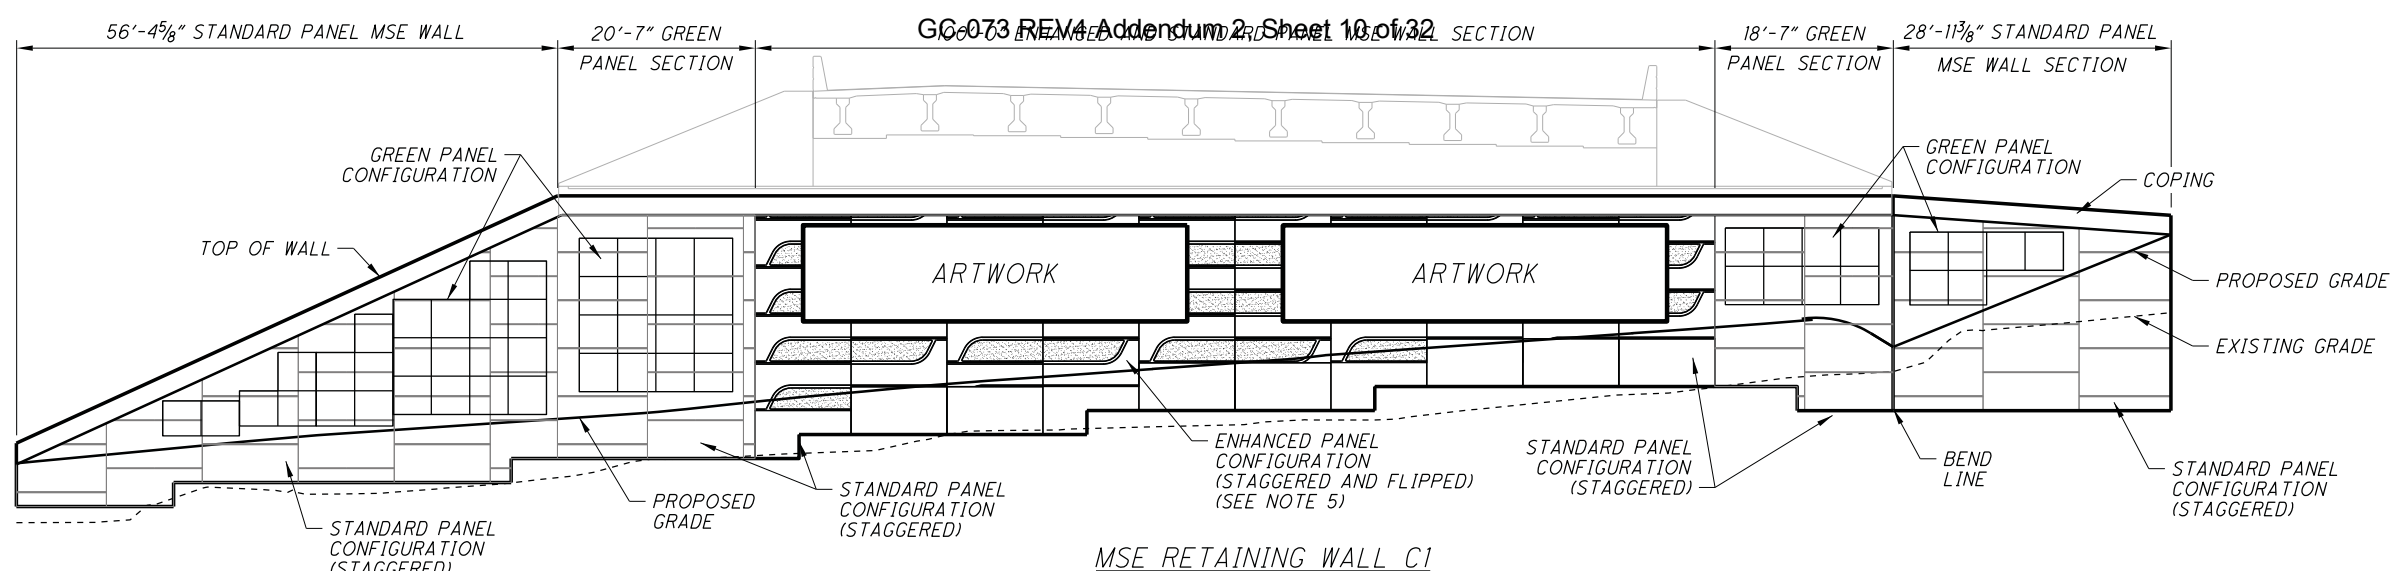


MSE RETAINING WALL C1

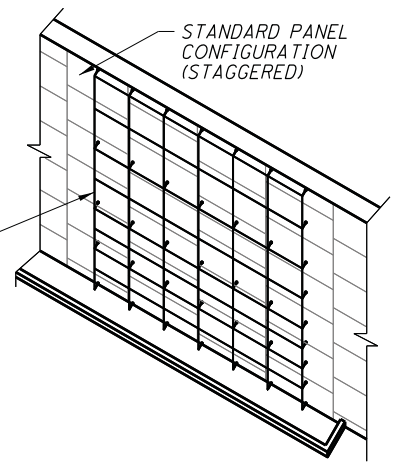


GREEN PANEL SECTION

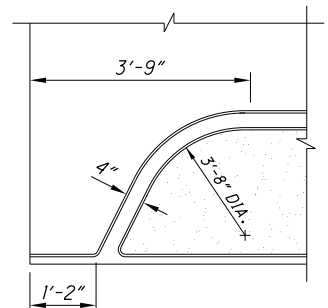


ENHANCED PANEL DETAIL

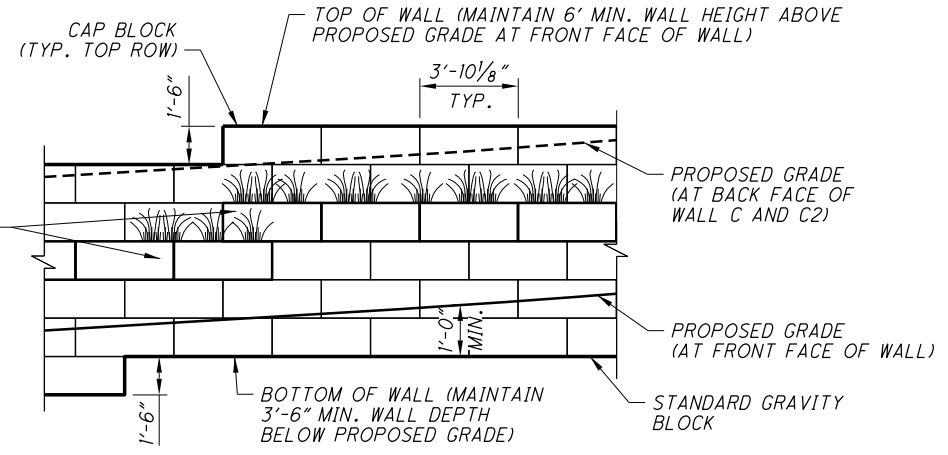


GRAVITY BLOCK WALL SECTION
(RETAINING WALLS C AND C2)

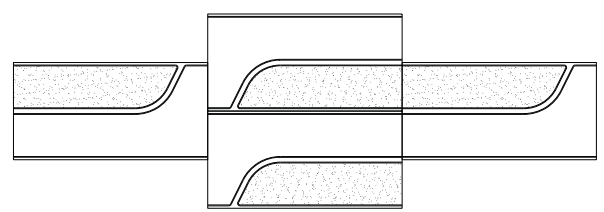


ENHANCED PANEL CONFIGURATION (STAGGERED AND FLIPPED)

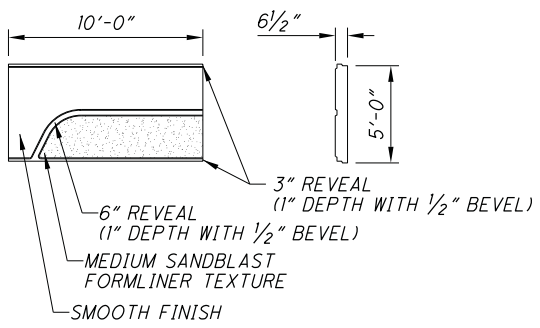


ENHANCED PANEL ELEVATION AND SECTION

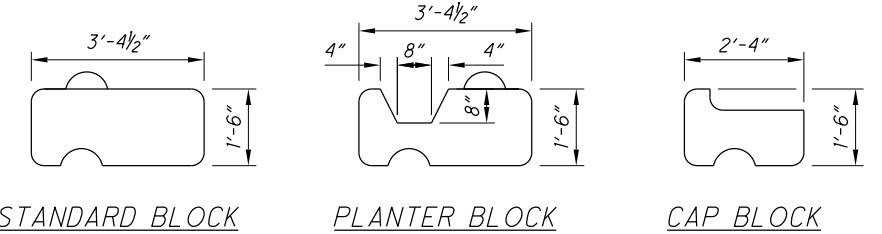

STANDARD BLOCK PLANTER BLOCK CAP BLOCK

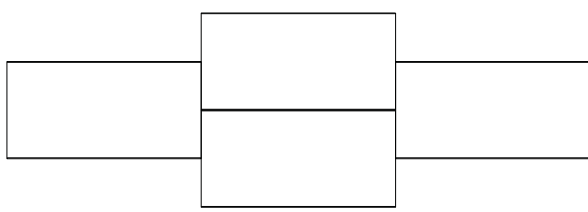

STANDARD PANEL CONFIGURATION (STAGGERED)

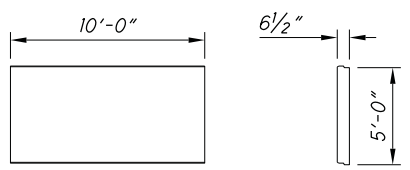


STANDARD PANEL ELEVATION AND SECTION

NOTES:

1. FINISH COAT COLOR FOR WALL COPING SHALL BE SW 7022 (ALPACA). FINISH COAT COLOR FOR MSE ENHANCED PANELS SHALL BE SW 7565 (OYSTER BAR). FINISH COAT COLOR FOR MSE STANDARD PANELS SHALL BE SW 7565 (OYSTER BAR).
2. FINISH COAT TINT AS SPECIFIED SHALL BE ADDED TO EPOXY URETHANE SEALANT.
3. MSE ABUTMENT WALL - FUTURE ARTWORK TO BE COORDINATED WITH ODOT
4. INCLUDE STAINLESS STEEL PLANT CABLES FOR THIS WALL 5' x 5' GRID, ANCHORED AS PER MANUFACTURER, CABLES SHALL BE TAUGHT, PLUMB, AND LEVEL. FOR STEEL PLANT CABLE DETAILS REFER TO 1020 ROADWAY-TREMONT BUILDABLE UNIT.
5. ENHANCED PANELS SHALL EXTEND A MINIMUM OF 1'-0" BELOW PROPOSED GRADE.
6. GRAVITY BLOCKS TO BE PLACED IN A STAGGERED PATTERN.
7. FOR GREEN PANEL SECTION PLANTINGS AND GRAVITY BLOCK PLANTINGS REFER TO 1020 ROADWAY - TREMONT BUILDABLE UNIT.
8. INSTALLATION OF PLANTINGS SHALL BE IN ACCORDANCE WITH CMS 661.17.


PRELIMINARY NOT FOR CONSTRUCTION

DESIGNED AKS	DRAWN CDD	REVIEWED DBT	DATE 9-13-11
		CHECKED CAB	STRUCTURE FILE NUMBER
CHECKED CAB	CDD	CAB	
DESIGN AGENCY WASH HNTB <small>WALSH-CONSTRUCTION</small>			NO. A INTERIM REVIEW SUBMITTAL
WALL C WALLS C, C1, AND C2 ALONG I.R. 90 WESTBOUND, FARIFIELD AVE. AND RAMP A6			DATE 09-09-11
CUY-90-14.90 PID NO. 77332 / 85531			REVISIONS 8 / 11

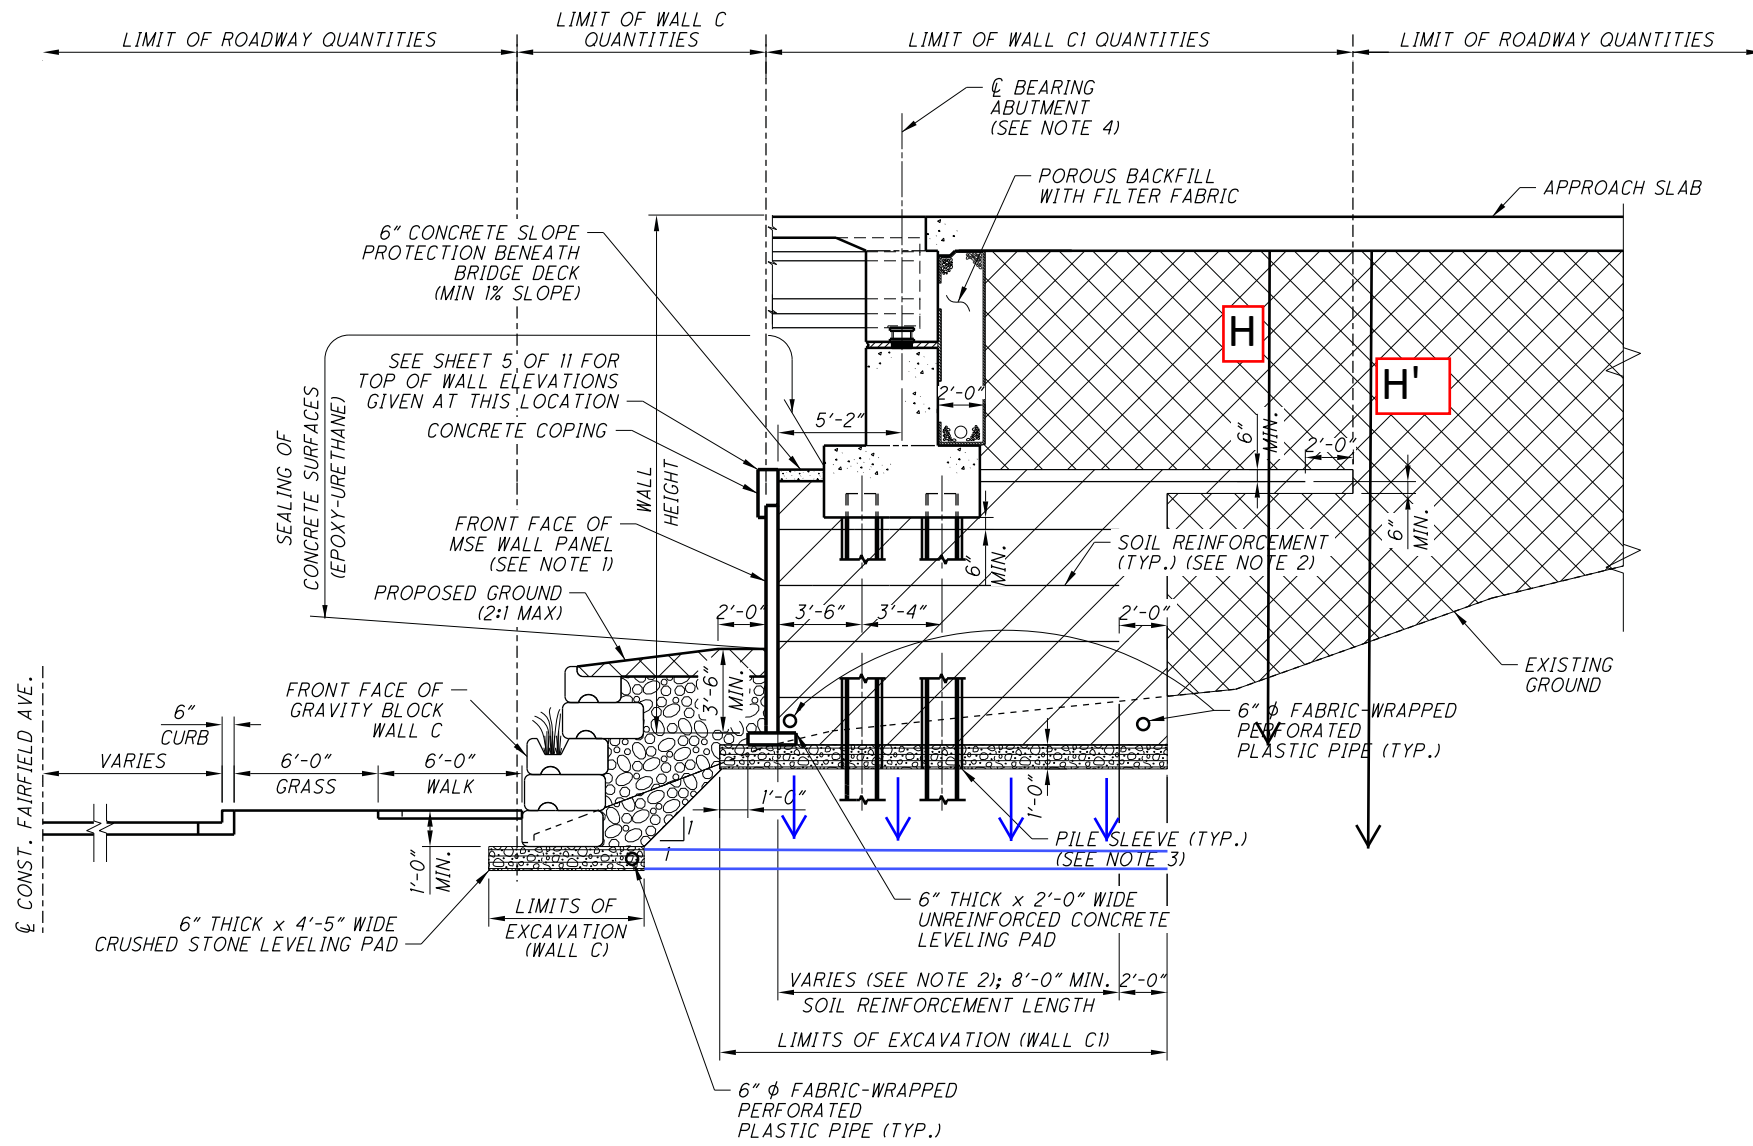

SECTION A-A

MINIMUM SOIL REINFORCEMENT LENGTH		
BEGIN STATION	END STATION	STRAP LENGTH
10+00.00	12+24.50	1.1 x (WALL HEIGHT)

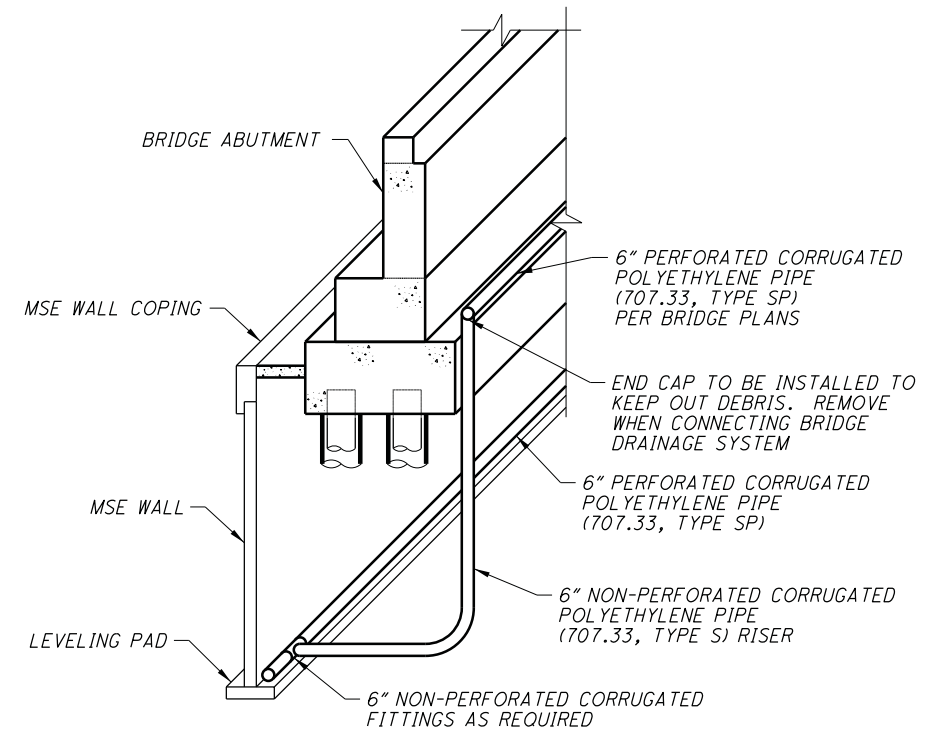


TYPICAL RISER DETAIL
(CONNECTION FROM BRIDGE DRAINAGE SYSTEM TO MSE WALL DRAINAGE)

NOTES:


- THICKNESS OF MSE WALL PANELS IS ASSUMED AT 6 1/2". ACTUAL THICKNESS DEPENDS ON THE APPROVED WALL SYSTEM.
- SOIL REINFORCEMENT LENGTH TO BE DETERMINED BY WALL SUPPLIER ON THE APPROVED WALL SYSTEM, BUT SHALL NOT BE LESS THAN 110% OF THE WALL HEIGHT OR 8'-0", WHICHEVER IS GREATER
- INSTALL PILE PIPE SLEEVES WITH MINIMUM 2'-6" φ DURING THE CONSTRUCTION OF MSE WALL. PLACE THE BOTTOM OF THE SLEEVES AT THE BOTTOM OF THE SELECT GRANULAR BACKFILL OR AT THE BOTTOM OF THE UNDERCUT, WHICHEVER IS DEEPER. INSTALL PILES THROUGH THE SLEEVES AND BACKFILL WITH GRANULAR FILL IN ACCORDANCE WITH MODIFIED SS 840 (SS-01) AFTER THE MSE WALL CONSTRUCTION IS COMPLETE. PILE SLEEVES SHALL CONFORM TO SS 840.
- FOR ADDITIONAL ABUTMENT DETAILS SEE SHEETS 5 THRU 8 AND 14 OF THE BRIDGE CUY-90-1526 - BRIDGE 4 PLANS.
- FACTORED BEARING RESISTANCE AT BASE OF WALL C IS 2.5 KSF. FACTORED BEARING RESISTANCE AT BASE OF REINFORCED SOIL MASS FOR WALL C1 VARIES LINEARLY FROM 5.4 KSF TO 16.8 KSF FOR STRAP LENGTHS 8'-0" TO 35'-0". FACTORED BEARING RESISTANCE AT BASE OF WALL C2 IS 2.9 KSF. REFER TO GEOTECHNICAL DESIGN MEMORANDUM GD-9, REVISION NO. 3, DATED 9/16/2011.
- ELEVATION OF 6" φ PERFORATED PLASTIC PIPE WILL VARY TO PROVIDE INVERT ELEVATION AT OUTLET (MIN. SLOPE 1/8" PER FT).
- COPING EXPANSION JOINTS SHALL BE SPACED NO MORE THAN 20 FEET APART AND ALIGNED WITH JOINTS BETWEEN FACING PANELS.
- DO NOT PLACE GEOTEXTILE BELOW THE BASE OF WALL WITHOUT APPROVAL OF GEOTECHNICAL ENGINEER OF RECORD.
- BEFORE CONSTRUCTION OF WALL C1, WALL C MUST BE CONSTRUCTED TO A POINT THAT WALL C IS EQUAL OR HIGHER THAN THE TOP OF LEVELING PAD ELEVATION OF WALL C1.

LEGEND:

- ITEM 203 EMBANKMENT
- SELECT GRANULAR BACKFILL PER MODIFIED SUPPLEMENTAL SPECIFICATION 840 (SS-01) (NO MORE THAN 5% PASSING #200 SIEVE)
- ITEM 203, GRANULAR MATERIAL TYPE C
- AGGREGATE MATERIALS FOR ITEM 304 AGGREGATE BASE OR CRUSHED AGGREGATE SLOPE PROTECTION AND FILTER AGGREGATE FOR ITEM 601 SLOPE AND CHANNEL PROTECTION

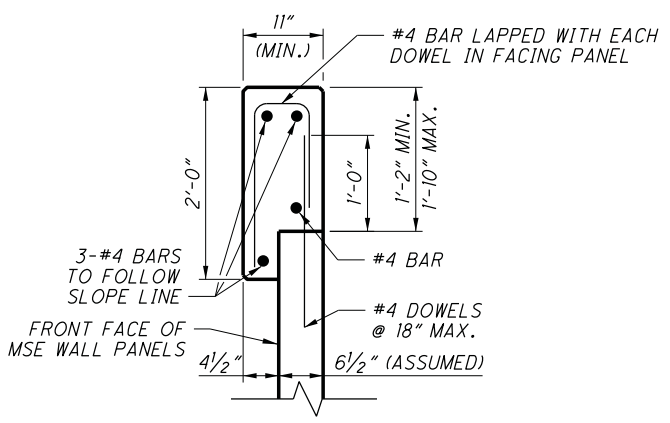

MSE WALL CONCRETE COPING
ALL REINFORCING STEEL TO BE EPOXY COATED

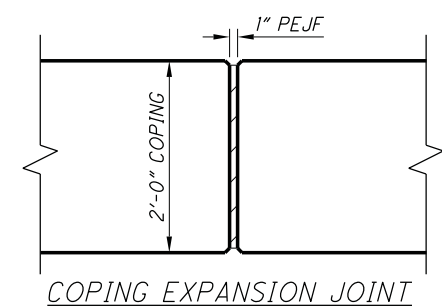

COPING EXPANSION JOINT

CORRECTED BY: _____
 VERIFIED BY: _____
 CHECKED BY: _____
 BACKCHECKED BY: _____
 CHECK PRINT (INITIAL & DATE)
 MADE BY: _____

Date: 9/20/2011
 Model: Sheet1
 File: 49633-S-BR-DET-C1.dgn

DESIGNED	AKS	DATE	9-13-11
CHECKED	CAB	REVIEWED	DBT
CHECKED	CAB	STRUCTURE FILE NUMBER	
NO.	A	INTERIM REVIEW SUBMITTAL	
REVISIONS			
DATE			

DESIGN AGENCY: **WASH HNTB**
 WASH HNTB
 WALL CONSTRUCTION

WALL C
 RETAINING WALL DETAILS - 1
 WALLS C, C1, AND C2
 ALONG I.R. 90 WESTBOUND, FAIRFIELD AVE. AND RAMP A6

CUY-90-14.90
 PID No. 77332 / 85531

9 / 11


PRELIMINARY NOT FOR CONSTRUCTION

CORRECTED BY:
VERIFIED BY:


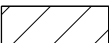


CHECKED BY:
BACKCHECKED BY:

CHECK PRINT (INITIAL & DATE)
MADE BY:

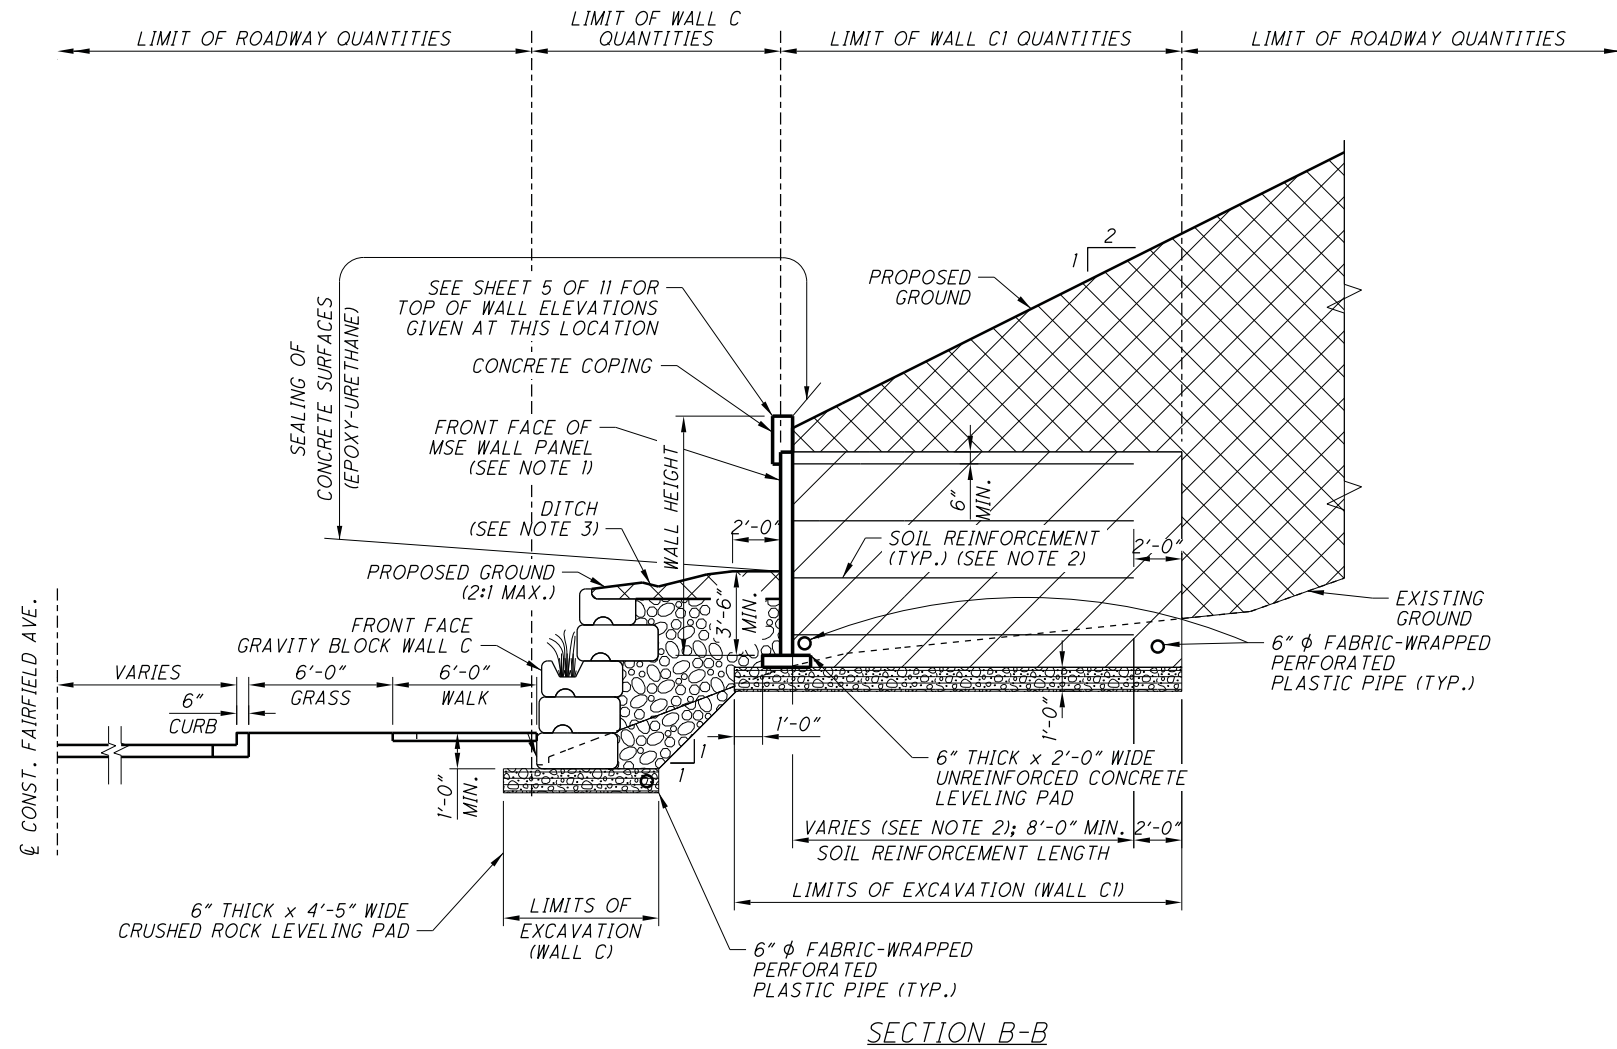Date: 9/20/2011
Model: Sheet2
File: 49633-S-BR-DET-C1.dgn



LEGEND:

-  ITEM 203 EMBANKMENT
-  SELECT GRANULAR BACKFILL PER MODIFIED SUPPLEMENTAL SPECIFICATION 840 (SS-01) (NO MORE THAN 5% PASSING #200 SIEVE)
-  ITEM 203, GRANULAR MATERIAL TYPE C
-  AGGREGATE MATERIALS FOR ITEM 304 AGGREGATE BASE OR CRUSHED AGGREGATE SLOPE PROTECTION AND FILTER AGGREGATE FOR ITEM 601 SLOPE AND CHANNEL PROTECTION

NOTES:

1. THICKNESS OF MSE WALL PANELS IS ASSUMED AT 61#2". ACTUAL THICKNESS DEPENDS ON THE APPROVED WALL SYSTEM.
2. SOIL REINFORCEMENT LENGTH TO BE DETERMINED BY WALL SUPPLIER ON THE APPROVED WALL SYSTEM, BUT SHALL NOT BE LESS THAN 110% OF THE WALL HEIGHT OR 8'-0", WHICHEVER IS GREATER.
3. DITCH BEHIND WALL IS TRANSITIONING BETWEEN FULL DITCH (SHOWN IN SECTION C-C ON SHEET 11 OF 11) AND 2:1 SLOPE (SHOWN IN SECTION A-A ON SHEET 9 OF 11) FROM WALL C1 STATION 10+56.38 TO STATION 10+00.
4. FOR ADDITIONAL NOTES, SEE 9 OF 11.

PRELIMINARY NOT FOR CONSTRUCTION


DESIGNED AKS	DATE 9-13-11	NO.	REVISIONS	DATE
CHECKED CAB	REVIEWED DBT	A	INTERIM REVIEW SUBMITTAL	09-19-11
CHECKED CAB	STRUCTURE FILE NUMBER			
	CUY-90-14.90			
	PID No. 77332 / 85531			
	10 / 11			

DESIGN AGENCY
WASH HNTB
WALSH CONSTRUCTION


CLEVELAND'S
INNERBELTBRIDGE
90
TRANSFORMATION

WALL C


RETAINING WALL DETAILS - 2
WALLS C, C1, AND C2
ALONG I.R. 90 WESTBOUND, FAIRFIELD AVE. AND RAMP A6

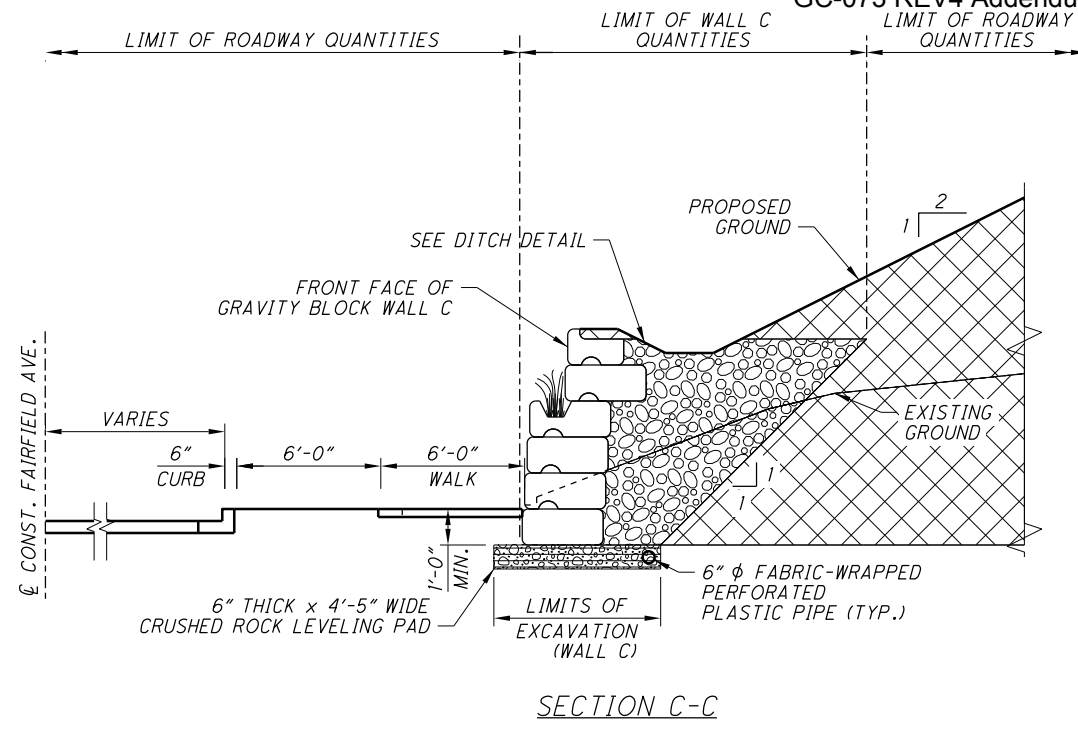


SECTION C-C

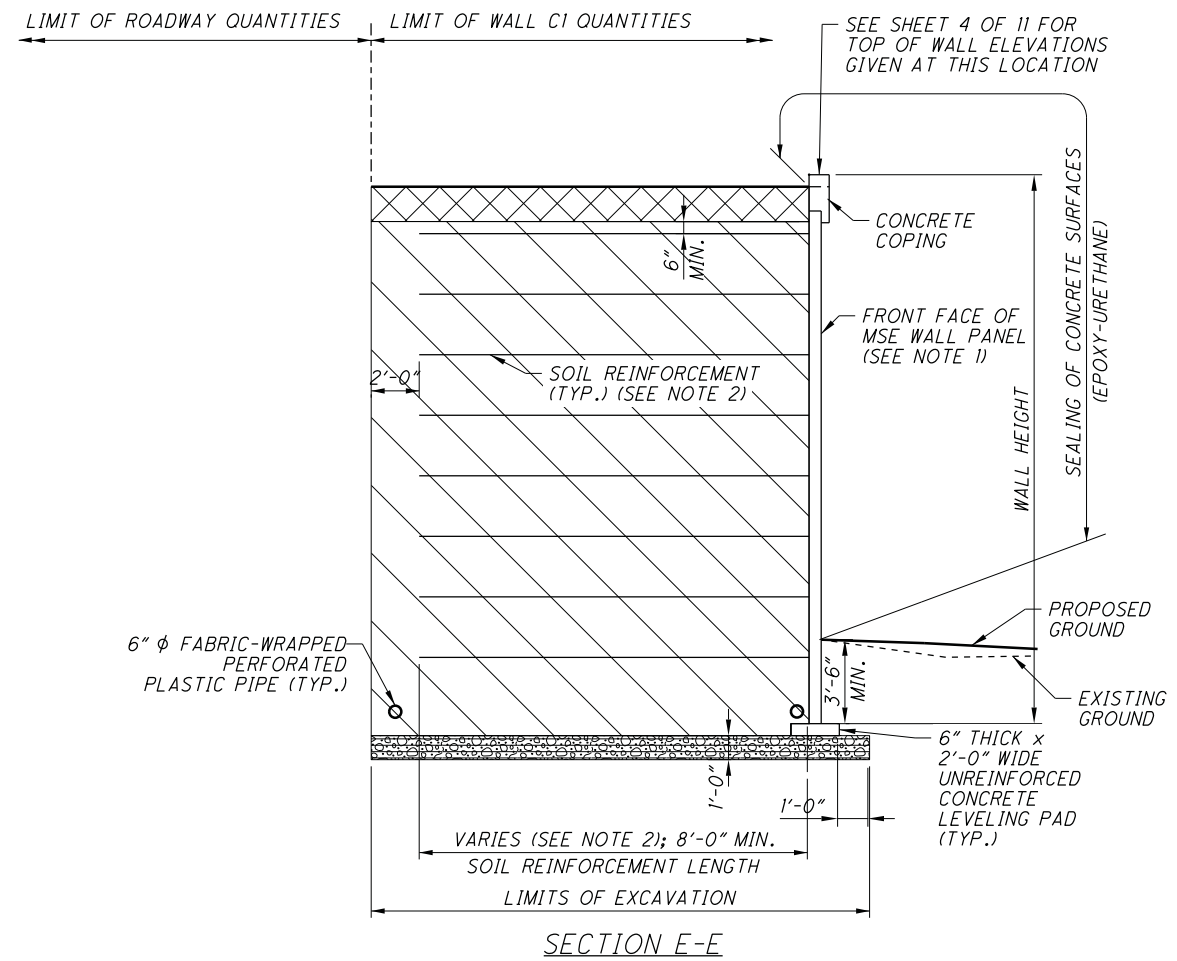

SECTION E-E

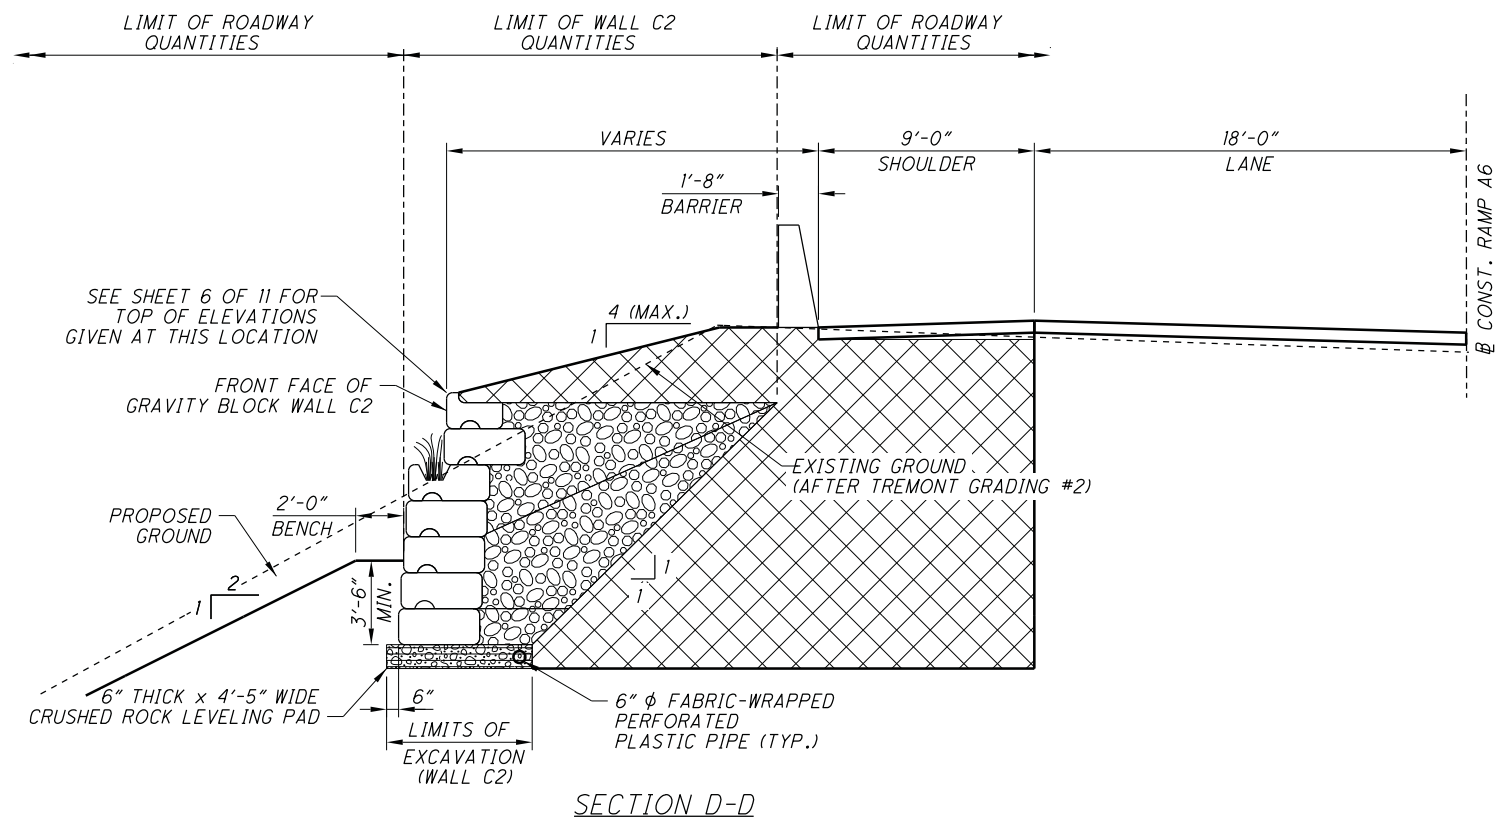

SECTION D-D

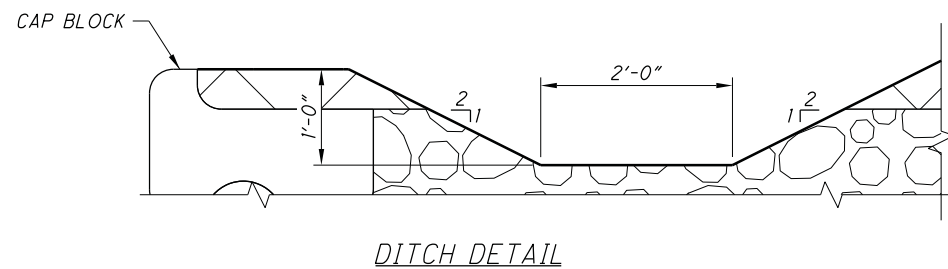

DITCH DETAIL

- LEGEND:**
- ITEM 203 EMBANKMENT
 - ITEM 203, GRANULAR MATERIAL TYPE C
 - AGGREGATE MATERIALS FOR ITEM 304 AGGREGATE BASE OR CRUSHED AGGREGATE SLOPE PROTECTION AND FILTER AGGREGATE FOR ITEM 601 SLOPE AND CHANNEL PROTECTION

- NOTES:**
1. THICKNESS OF MSE WALL PANELS IS ASSUMED AT 61#2". ACTUAL THICKNESS DEPENDS ON THE APPROVED WALL SYSTEM.
 2. SOIL REINFORCEMENT LENGTH TO BE DETERMINED BY WALL SUPPLIER ON THE APPROVED WALL SYSTEM, BUT SHALL NOT BE LESS THAN 110% OF THE WALL HEIGHT OR 8'-0", WHICHEVER IS GREATER.
 3. ELEVATION OF 6" ϕ PERFORATED PLASTIC PIPE WILL VARY TO PROVIDE INVERT ELEVATION AT OUTLET. MINIMUM SLOPE OF PIPE SHALL BE 1/8" / FOOT.
 4. FOR ADDITIONAL NOTES AND LEGENDS, SEE SHEET 9 OF 11.

PRELIMINARY NOT FOR CONSTRUCTION

CORRECTED BY:
VERIFIED BY:

CHECKED BY:
BACKCHECKED BY:

CHECK PRINT (INITIAL & DATE)
MADE BY:

Date: 9/20/2011
Model: Sheet2
File: 496333-S-BR-DET-C.dgn

NO.	REVISIONS	DATE
A	INTERIM REVIEW SUBMITTAL	09-19-11

DESIGN AGENCY
WALSH HNTB
WALSH CONSTRUCTION


CLEVELAND'S
INNERBELT BRIDGE
90
RETAINING WALL DETAILS - 3
WALLS C, C1, AND C2
ALONG I.R. 90 WESTBOUND, FAIRFIELD AVE. AND RAMP A6

WALL C

DESIGNED	DATE	REVIEWED	DATE
AKS	9-13-11	DBT	9-13-11
CHECKED	DATE	REVIEWED	DATE
CAB		DBT	9-13-11

STRUCTURE FILE NUMBER: CUY-90-14.90
PID NO. 77332 / 85531




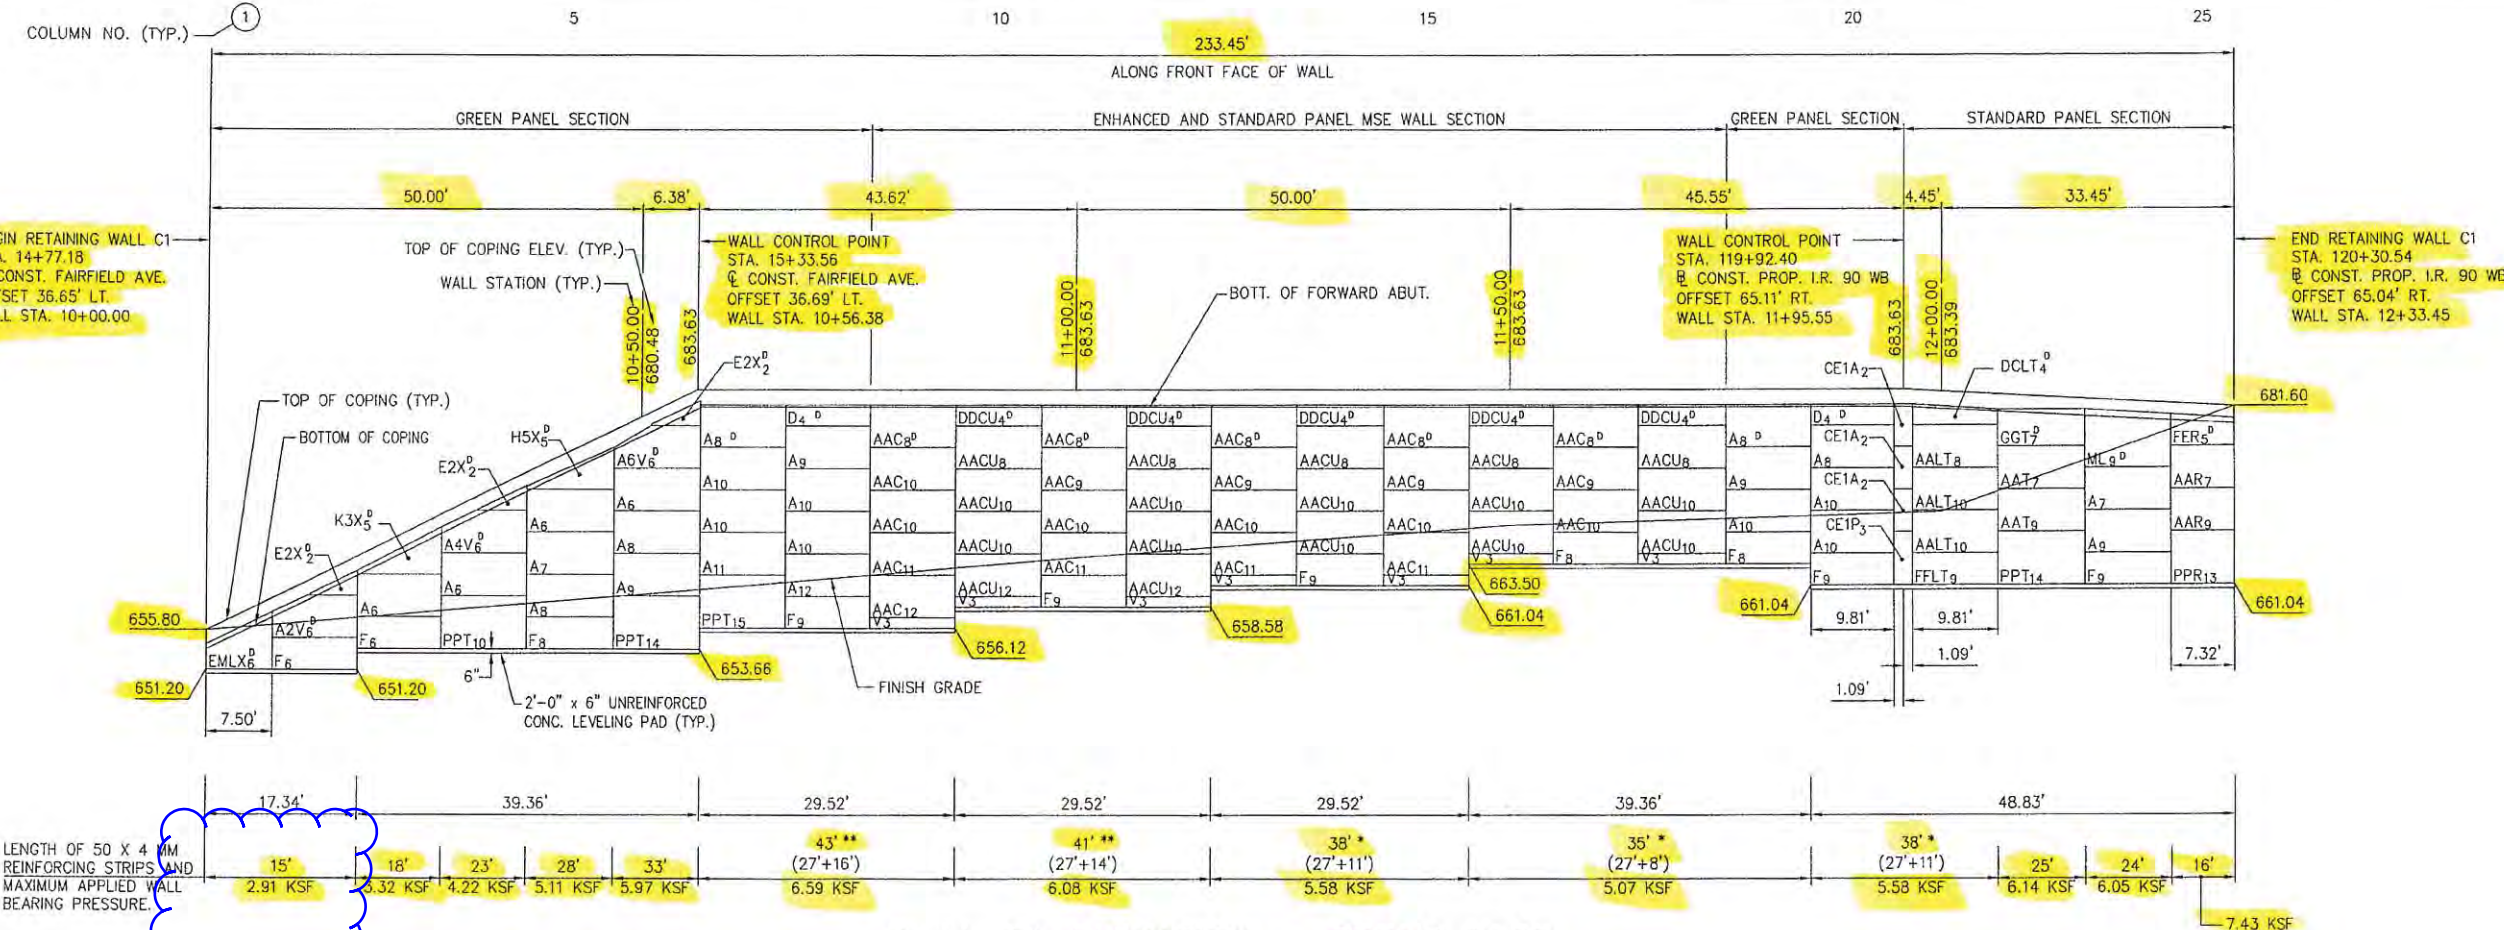



SHOP DRAWING REVIEW
HNTB OHIO, INC.

Review is only for general conformance with the design concept of the contract documents. Markings or comments shall not be construed as relieving the contractor from compliance with the project plans and specifications, nor departures therefrom. The contractor remains solely responsible for details and accuracy, for confirming and correlating all quantities and dimensions, for selecting fabricating processes, for techniques of assembly, for safety and for satisfactory performance of his work.


- No Exceptions Taken
- Approved as Noted By DWB
- Amend and Resubmit
- Rejected - See Remarks Date 1/23/12

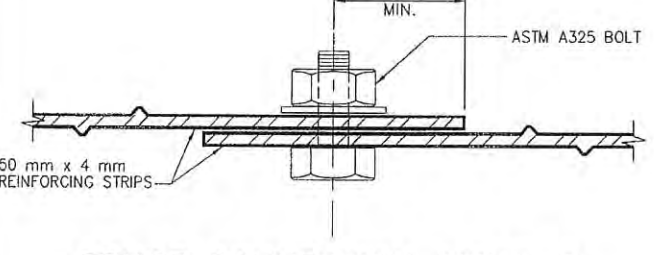

SPlice CONNECTION DETAIL E
SCALE 1:1

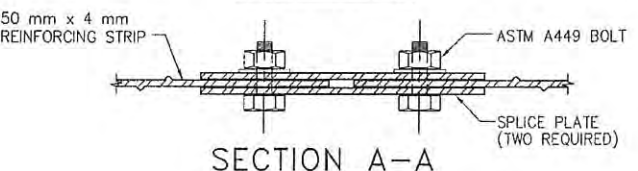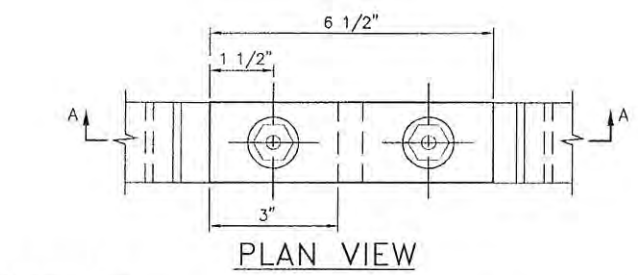

SECTION A-A
SPlice CONNECTION DETAIL F
SCALE 1:2

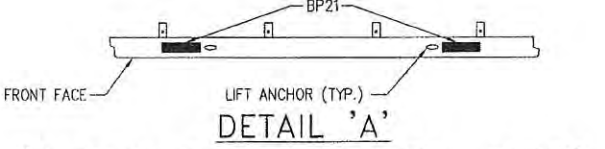

DETAIL 'A'
(2 PADS PER HORIZONTAL JOINT)
SCALE: N.T.S.

NOTE: USE (2) BP21 PADS PLACED AS SHOWN.

BACKWALL STRIPS FORWARD ABUT.:
1 LEVEL, 2'-0" FROM BOTT. OF FOOTER
127 PCS. 16' STRIPS @ 1'-1" O/C

LEGEND:
* SEE SPLICE CONNECTION DETAIL E (SEE BELOW)
** SEE SPLICE CONNECTION DETAIL F (SEE BELOW)

KEY TO DESIGN 5X10 (NOMINAL) PANEL LABEL:
A12RCT10 D ← COPING DOWELS
BASE PANEL SERIES (ONE OR TWO LETTERS)
SEQUENTIAL PANEL NUMBER (IF ANY)
MODIFICATION (ONE OR MORE, IF ANY)
PANEL CUT (IF ANY)
AESTHETIC FINISH DESIGNATION *** (ONE OR TWO LETTERS, IF ANY)
*** AESTHETIC FINISH DESIGNATION (IF ANY)
"C" = "C" FINISH
"CU" = FLIPPED "C" FINISH

CERTIFIED WITH RESPECT TO INTERNAL STABILITY OF REINFORCED EARTH STRUCTURES ONLY.

STATE OF OHIO
REGISTERED ENGINEER
ALEXANDER ABRAHAM
E-57708

STATE OF OHIO
REGISTERED ENGINEER
JOHN A. NICHOLSON, JR.
E-63091

NO.	DATE	DESCRIPTION

This drawing contains information proprietary to The Reinforced Earth Company, and is being furnished for the use of The Ohio Department of Transportation only in connection with this project, and the information contained is not to be transmitted to any other organization unless specifically authorized in writing by The Reinforced Earth Company. The Reinforced Earth Company is an exclusive licensee in the United States under patents issued to Henri Vidal, and the furnishing of this drawing does not constitute an expressed or implied license under the Vidal patents.

The design contained on these drawings is based on information provided by the owner. On the basis of this information, The Reinforced Earth Company has designed, and is responsible for the internal stability of the structure only. External stability, including foundation (bearing capacity and settlement) and slope stability (sliding and rotation), is the responsibility of the owner.

1/18/12

CALC. G1: WALL C1 AT WALL HEIGHT OF 11FT STATIC EXTERNAL STABILITY									
ENTER PARAMETERS IN YELLOW CELLS. SEE DIAGRAM TAB FOR CLARIFICATION.									
References:		AASHTO 2010 LRFD Bridge Manual		for seismic loads, LRFD calcs					
		NAVFAC DM 7.2 (1986)		for friction properties					
		Das (1999)		for earth pressures					
				B/H = 0.7					
Retained Soil Properties					Geometry				
Retained Friction Angle, ϕ_r		30 degrees		Height, H		11 feet		(above top of leveling pad)	
Unit Weight Above GWT, $\gamma_{m,r}$		120 pcf		Width, B		8 feet			
Unit Weight Below GWT, $\gamma_{sat,r}$		120 pcf		Height of GWT, H_w		0 feet		(0 means below the wall bottom)	
Ignore Vertical Component of Inclined Loads for Sliding/Overturning?		No		Backslope Angle, β		6.5 degrees			
Ka override (blank for auto-calc using Das, 1999 eqn.)		(autocalc)		Distance to Slope Break, X		100 feet		(0 if no slope break)	
				Backslope Height, Δy		11.4 feet			
MSE Properties					Effective Backslope Angle, β'				
Continuous Reinforcement Friction Factor, μ		0.36 (sheets, grids)		Effective Backslope Angle, β'		11.0 degrees		(0 if $x < B$)	
Discontinuous Reinforcement Friction Factor, μ		0.58 (strips)		Surcharge/Seismic Loads				(all surcharges ignored for seismic. Surcharge above MSE ignored for sliding/overturning)	
Adhesion, a		0 psf		Retained Soil Surcharge, q_r		250 psf			
SLIDING Calc: Unit Weight Above GWT, $\gamma_{m,mse}$		120 pcf		MSE Surcharge, q_{mse}		250 psf			
SLIDING Calc: Unit Weight Below GWT, $\gamma_{sat,mse}$		120 pcf		k_h		0 g's			
BEARING Calc: Unit Weight Above GWT, $\gamma_{m,mse}$		135 pcf		ΔK_{ae}		0.00 g's			
BEARING Calc: Unit Weight Below GWT, $\gamma_{sat,mse}$		135 pcf		ΔK_{ae} override		0 (blank for autocalc)			
Subgrade/Bearing Properties					Passive Resistance				
Subgrade Friction Angle, ϕ_s				Ignore Passive Resistance?		Yes			
Subgrade Cohesion, c				Height of Passive, H_p					
Foundation Depth, D				Passive Friction Angle, ϕ_p					
Nominal Bearing Resistance, q_n for B = 8 feet		8.0 ksf		Unit Weight Above GWT, $\gamma_{m,p}$		pcf			
Unit Weight Above GWT, $\gamma_{m,s}$		pcf		Unit Weight Below GWT, $\gamma_{sat,p}$		pcf			
Unit Weight Below GWT, $\gamma_{sat,s}$		pcf							
AASHTO LRFD:									
FAILURE BY SLIDING		LOAD SIDE		RESISTANCE SIDE		LRFD CHECK			
		L (lbs/ft)	LF	L*LF (lbs/ft)	R (lbs/ft)	RF	R*RF (lbs/ft)	R*RF > L*LF ?	
LOAD									
Earth (L_{EH})		2948	1.5	4422				$L_{EH} = ('SL\&OT\ LOADS'\!E15 + 'SL\&OT\ LOADS'\!E16 + 'SL\&OT\ LOADS'\!E17) * \cos('SL\&OT\ LOADS'\!B8)$	
Surcharge (L_{LS})		1032	1.75	1805				$L_{LS} = ('SL\&OT\ LOADS'\!E18) * \cos('SL\&OT\ LOADS'\!B8)$	
Earthquake (L_{EQ})		0	1	0				$L_{EQ} = 'SL\&OT\ LOADS'\!E19 + 'SL\&OT\ LOADS'\!E20 + 'SL\&OT\ LOADS'\!E21 + 'SL\&OT\ LOADS'\!E22 * \cos('SL\&OT\ LOADS'\!B8)$	
RESISTANCE									
Base Friction (continuous reinforcement)					4395	1	4395	$R_{friction} = ('SL\&OT\ LOADS'\!E3 + 'SL\&OT\ LOADS'\!E4 + 'SL\&OT\ LOADS'\!E5 + (D36 + D37) * \tan('SL\&OT\ LOADS'\!B8) + 'SL\&OT\ LOADS'\!E22 * \sin('SL\&OT\ LOADS'\!B8)) * D15$	
Passive					0	0.75	0	$R_{passive} = \text{IF}(I24 = "YES", 0, 'SL\&OT\ LOADS'\!E31)$	
SUM				6227			4395	NO	
RESISTANCE									
Base Friction (DIScontinuous reinforcement)					7080	1	7080	$R_{friction} = ('SL\&OT\ LOADS'\!E3 + 'SL\&OT\ LOADS'\!E4 + 'SL\&OT\ LOADS'\!E5 + (D36 + D37) * \tan('SL\&OT\ LOADS'\!B8) + 'SL\&OT\ LOADS'\!E22 * \sin('SL\&OT\ LOADS'\!B8)) * D16$	
Passive					0	0.75	0	$R_{passive} = \text{IF}(I24 = "YES", 0, 'SL\&OT\ LOADS'\!E31)$	
SUM				6227			7080	YES	
FAILURE BY BEARING		LOAD SIDE		RESISTANCE SIDE		LRFD CHECK			
B-2e = 5.9 feet		L (lbs/ft)	LF	L*LF (lbs/ft)	$q_{FACTORED}$ (psf)	$= \sum L * LF / (B - 2e)$			
LOAD									
Earth (L_{EV})		12890	1.35	17402				$L_{EV} = \sin('BEARING\ LOADS'\!B8) * ('BEARING\ LOADS'\!E15 + 'BEARING\ LOADS'\!E16 + 'BEARING\ LOADS'\!E17) + 'BEARING\ LOADS'\!E3 + 'BEARING\ LOADS'\!E4 + 'BEARING\ LOADS'\!E5 + 'BEARING\ LOADS'\!E6$	
Surcharge (L_{LS})		2201	1.75	3851				$L_{LS} = \sin('BEARING\ LOADS'\!B8) * ('BEARING\ LOADS'\!E18) + 'BEARING\ LOADS'\!E7$	
Earthquake (L_{EQ})		0	1	0				$L_{EQ} = 'BEARING\ LOADS'\!E22 * \sin('BEARING\ LOADS'\!B8)$	
SUM				21253	3630			$q_{factored} = D54 / (I9 - 2 * 'BEARING\ LOADS'\!B34)$	
RESISTANCE									
Nominal Bearing Resistance, q_n for B = 8 feet				8000 psf					
Factored Bearing Resistance = $q_n * RF =$				5200 psf				$= \text{IF}(I18 = 0, E56 * L27, E56 * L28)$	
R*RF > $\sum L * LF / (B - 2e)$?				YES				$= \text{IF}(E57 > E54, "YES", "NO")$	
FAILURE BY OVERTURNING									
		Parameter	Value	Note					
		e	1.87	ft from center of base reinforcement layer					
		1/4 B	2.00	ft from center of base reinforcement layer					
		$e \leq 1/4 B$?	YES	See Sections 11.10.5.5 and 11.6.3.3 in AASHTO 2010					

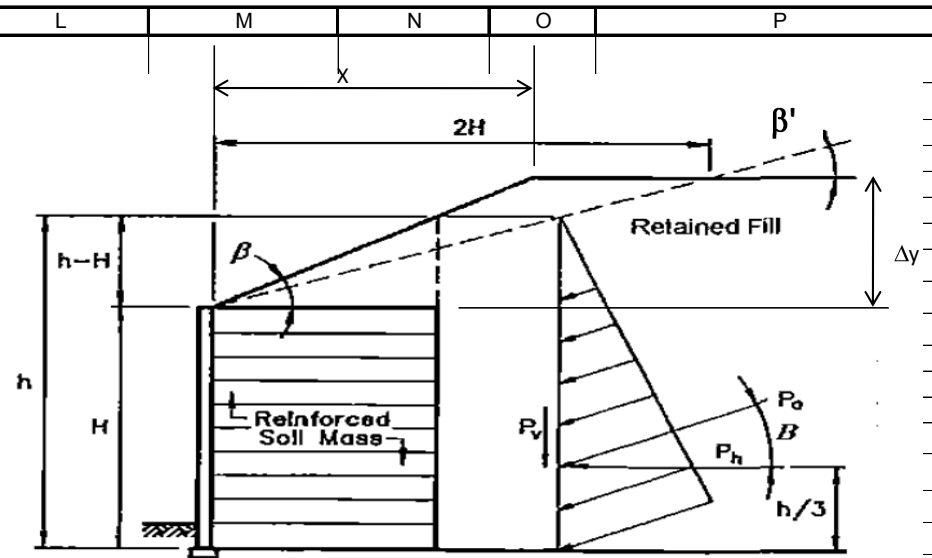


Figure 3.11.5.8.1-3—Earth Pressure Distribution for MSE Wall with Broken Back Backfill Surface

	A	B	C	D	E	F	G	H	I	J	K	L
2	Geometry			VERTICAL FORCES (not counting vertical components of driving forces)							Moment Arms (about toe)	
3	Height, H	11 ft		$W_m (\beta=0)$	10560 lbs/ft		$W_m = B*(H-H_w)*\gamma_{m,mse}$		x_m	4.00 feet	B/2	
4	Width, B	8 ft		$W_{\beta 1}$ (triangular part)	437 lbs/ft		$W_{\beta 1} = 1/2*\min(x,B)*(h-H)*\gamma_{m,r}$		$x_{\beta 1}$	5.33 feet	$2/3*\min(B,x)$	
5	Height of GWT, H_w	0 ft		$W_{\beta 2}$ (broken slope)	0 lbs/ft		$W_{\beta 2} = (B-x)*(h-H)*\gamma_{m,r}$		$x_{\beta 2}$	54.00 feet	$x+(B-x)/2$	
6	Height of Retained Fill, h	11.91 ft		W_{sat}'	0 lbs/ft		$W_{sat}' = B*H_w*(\gamma_{sat,mse}-62.4)$		x_{sat}	4.00 feet	B/2	
7	$h = H+B*\tan(\beta)$ $\beta=$	0.113 rad		W_q	0 lbs/ft		$W_q = 0$ for sliding and overturning		x_q	4.00 feet	B/2	
8	Effective Backslope Angle, β'	0.192 rad		W_{TOTAL}	10997 lbs/ft		<- Factored			44569 ft-lb/ft		
9	Seismic Effective Height, H_2	11.66 ft							11.6			
10	$H_2 = H+0.5*H*\tan(\beta)/[1-0.5\tan(\beta)]$											
11	Broken slope width, x	100 ft		DRIVING FORCES								
12	MSE***			K_a	0.353		From AASHTO Eqs 3.11.5.3-1 and 2 for $\theta = 90$ and $\delta = 0$					
13	Friction Factor, μ	0.36		ΔK_{ae}	0.000		From AASHTO Eq A11.1.1.1-2 for β and $\delta = 0$ (notation is different in equation)					
14	Adhesion, a	0 psf		A_m	0.000 g's		$A_m = (1.45-k_h)*k_h$ for $k_h < 0.45$	Direction of Force		Moment Arms (about toe, horz. component)		
15	Unit Weight Above GWT, $\gamma_{m,mse}$	120 pcf		F_{T1}	3003 lbs/ft		$F_{T1} = 1/2*K_a*(h-H_w)^2*\gamma_{m,r}$	Parallel to β'	y_{T1}	3.97 feet	$H_w+(h-H_w)/3$	
16	Unit Weight Below GWT, $\gamma_{sat,mse}$	120 pcf		F_{T2}	0 lbs/ft		$F_{T2} = K_a*(h-H_w)*H_w*\gamma_{m,r}$	Parallel to β'	y_{T2}	0.00 feet	$H_w/2$	
17	Retained			F_{T3}	0 lbs/ft		$F_{T3} = 1/2*K_a*H_w^2*(\gamma_{sat,r}-62.4)$	Parallel to β'	y_{T3}	0.00 feet	$H_w/3$	
18	Friction Angle, ϕ_r	0.524 rad		F_q	1051 lbs/ft		$F_q = K_a*h*q_r$	Parallel to β'	y_q	5.96 feet	$h/2$	
19	Unit Weight Above GWT, $\gamma_{m,r}$	120 pcf		P_{ir}	0 lbs/ft		$P_{ir} = 0.5*A_m*\gamma_{m,mse}*H_2*H$	Horizontal	y_{ir}	5.50 feet	$H/2$	
20	Unit Weight Below GWT, $\gamma_{sat,r}$	120 pcf		P_{is1} (triangular)	0 lbs/ft		$P_{is} = A_m*\gamma_{m,r}*Area_{is}$	Horizontal	y_{is1}	11.22 feet	$H+(H_2-H)/3$	
21	Surcharge/Seismic			P_{is2} (broken slope)	0 lbs/ft			Horizontal	y_{is2}	11.33 feet	$H+(H_2-H)/2$	
22	Retained Soil Surcharge, q_r	250 psf		$0.5P_{AE}$	0 lbs/ft		$0.5P_{AE} = 0.5*\Delta K_{ae}*\gamma_{m,r}*H_2^2$	Parallel to β'	y_{AE}	7.00 feet	$0.6H_2$	
23	MSE Surcharge, q_{mse}	250 psf		F_{HORZ}	0 lbs/ft		<-Factored		M_{HORZ}	0 ft-lb/ft	<-Factored	
24	k_h	0 g's		F_{βx}	6227 lbs/ft		<-Factored		M_{β+}	28315 ft-lb/ft	<-Factored	
25	theta	0		F_{βy}	1211 lbs/ft		<-Factored		M_{β-}	9688 ft-lb/ft	<-Factored	
26	Passive			PASSIVE FORCES (HORIZONTAL)								
27	Height of Passive, H_p	0 ft		10.8	1.00		$K_p = \tan^2(45+\phi/2)$			Moment Arms (about toe)		
28	Friction Angle, ϕ_p	0 rad		F_{P1}	0 lbs/ft		$F_{P1} = 1/2*K_p*(H_p-H_w)^2*\gamma_{m,p}$		y_{P1}	0.00 feet	$H_w+(H_p-H_w)/3$	
29	Unit Weight Above GWT, $\gamma_{m,p}$	0 pcf		F_{P2}	0 lbs/ft		$F_{P2} = K_p*(H_p-H_w)*H_w*\gamma_{m,p}$		y_{P2}	0.00 feet	$H_w/2$	
30	Unit Weight Below GWT, $\gamma_{sat,p}$	0 pcf		F_{P3}	0 lbs/ft		$F_{P3} = 1/2*K_p*H_w^2*(\gamma_{sat,p}-62.4)$		y_{P3}	0.00 feet	$H_w/3$	
31	Ignore Passive Resistance?	Yes		F_{PASSIVE}	0 lbs/ft				M_{PASSIVE}	0 ft-lb/ft		
32	Ignore Vertical from Inclined?	No										
33												
34	Eccentricity, e	1.87 ft		$e = (J23+J24-J25/2-E4*(J4-B4/2)-E5*(J5-B4/2))/(E8+E25)$						$e = \frac{\sum M_{DRIVING}}{\sum F_{VERT}}$		
35				(Ignores passive resistance but includes vertical shear due to inclined backfill.)								
36	NOTE:											
37	*** TABLE 840.04-1 of ODOT Supplemental Specification 840 (Mechanically Stabilized Earth Wall) specifies 120 pcf as the design unit weight for MSE wall backfill. This value was used for											
38	sliding resistance analyses but a value of 135 pcf (corresponding to Select Granular Backfill) was assumed in Bearing Resistance calculation.											

	A	B	C	D	E	F	G	H	I	J	K	L	
2	Geometry			VERTICAL FORCES (not counting vertical components of driving forces)							Moment Arms (about toe)		
3	Height, H	11 ft		$W_m (\beta=0)$	11880 lbs/ft		$W_m = B*(H-H_w)*\gamma_{m,mse}$		x_m	4.00 feet		B/2	
4	Width, B	8 ft		$W_{\beta1}$ (triangular part)	437 lbs/ft		$W_{\beta1} = 1/2*\min(x,B)*(h-H)*\gamma_{m,r}$		$x_{\beta1}$	5.33 feet		$2/3*\min(B,x)$	
5	Height of GWT, H_w	0 ft		$W_{\beta2}$ (broken slope)	0 lbs/ft		$W_{\beta2} = (B-x)*(h-H)*\gamma_{m,r}$		$x_{\beta2}$	54.00 feet		$x+(B-x)/2$	
6	Height of Retained Fill, h	11.91 ft		W_{sat}'	0 lbs/ft		$W_{sat}' = B*H_w(\gamma_{sat,mse}-62.4)$		x_{sat}	4.00 feet		B/2	
7	$h = H+B*\tan(\beta)$ $\beta=$	0.113 rad		W_q	2000 lbs/ft		$W_q = B*q_{mse}$		x_q	4.00 feet		B/2	
8	Effective Backslope Angle, β'	0.192 rad		W_{TOTAL}	20128 lbs/ft		<- Factored			81296 ft-lb/ft			
9	Seismic Effective Height, H_2	11.66 ft							11.6				
10	$H_2 = H+0.5*H*\tan(\beta)/[1-0.5\tan(\beta)]$												
11	Broken slope width, x	100 ft		DRIVING FORCES									
12	MSE***			K_a	0.353		From AASHTO Eqs 3.11.5.3-1 and 2 for $\theta = 90$ and $\delta = 0$						
13	Friction Factor, μ	0.36		ΔK_{ae}	0.000		From AASHTO Eq A11.1.1.1-2 for β and $\delta = 0$ (notation is different in equation)						
14	Adhesion, a	0 psf		A_m	0.000 g's		$A_m = (1.45-k_h)*k_h$ for $k_h < 0.45$	Direction of Force		Moment Arms (about toe, horz. component)			
15	Unit Weight Above GWT, $\gamma_{m,mse}$	135 pcf		F_{T1}	3003 lbs/ft		$F_{T1} = 1/2*K_a*(h-H_w)^2*\gamma_{m,r}$	Parallel to β'	y_{T1}	3.97 feet		$H_w+(h-H_w)/3$	
16	Unit Weight Below GWT, $\gamma_{sat,mse}$	135 pcf		F_{T2}	0 lbs/ft		$F_{T2} = K_a*(h-H_w)*H_w*\gamma_{m,r}$	Parallel to β'	y_{T2}	0.00 feet		$H_w/2$	
17	Retained			F_{T3}	0 lbs/ft		$F_{T3} = 1/2*K_a*H_w^2*(\gamma_{sat,r}-62.4)$	Parallel to β'	y_{T3}	0.00 feet		$H_w/3$	
18	Friction Angle, ϕ_r	0.524 rad		F_q	1051 lbs/ft		$F_q = K_a*h*q_r$	Parallel to β'	y_q	5.96 feet		$h/2$	
19	Unit Weight Above GWT, $\gamma_{m,r}$	120 pcf		P_{ir}	0 lbs/ft		$P_{ir} = 0.5*A_m*\gamma_{m,mse}*H_2*H$	Horizontal	y_{ir}	5.50 feet		$H/2$	
20	Unit Weight Below GWT, $\gamma_{sat,r}$	120 pcf		P_{is1} (triangular)	0 lbs/ft		$P_{is} = A_m*\gamma_{m,r}*Area_{is}$	Horizontal	y_{is1}	11.22 feet		$H+(H_2-H)/3$	
21	Surcharge/Seismic			P_{is2} (broken slope)	0 lbs/ft			Horizontal	y_{is2}	11.33 feet		$H+(H_2-H)/2$	
22	Retained Soil Surcharge, q_r	250 psf		$0.5P_{AE}$	0 lbs/ft		$0.5P_{AE} = 0.5*\Delta K_{ae}*\gamma_{m,r}*H_2^2$	Parallel to β'	y_{AE}	7.00 feet		$0.6H_2$	
23	MSE Surcharge, q_{mse}	250 psf		F_{HORZ}	0 lbs/ft		<- Factored		M_{HORZ}	0 ft-lb/ft		<- Factored	
24	k_h	0 g's		F_{βx}	6227 lbs/ft		<- Factored		M_{β+}	28315 ft-lb/ft		<- Factored	
25	theta	0		F_{βy}	1211 lbs/ft		<- Factored		M_{β-}	9688 ft-lb/ft		<- Factored	
26	Passive			PASSIVE FORCES (HORIZONTAL)									
27	Height of Passive, H_p	0 ft		10.8	1.00		$K_p = \tan^2(45+\phi/2)$			Moment Arms (about toe)			
28	Friction Angle, ϕ_p	0 rad		F_{P1}	0 lbs/ft		$F_{P1} = 1/2*K_p*(H_p-H_w)^2*\gamma_{m,p}$		y_{P1}	0.00 feet		$H_w+(H_p-H_w)/3$	
29	Unit Weight Above GWT, $\gamma_{m,p}$	0 pcf		F_{P2}	0 lbs/ft		$F_{P2} = K_p*(H_p-H_w)*H_w*\gamma_{m,p}$		y_{P2}	0.00 feet		$H_w/2$	
30	Unit Weight Below GWT, $\gamma_{sat,p}$	0 pcf		F_{P3}	0 lbs/ft		$F_{P3} = 1/2*K_p*H_w^2*(\gamma_{sat,p}-62.4)$		y_{P3}	0.00 feet		$H_w/3$	
31	Ignore Passive Resistance?	Yes		F_{PASSIVE}	0 lbs/ft				M_{PASSIVE}	0 ft-lb/ft			
32	Ignore Vertical from Inclined?	No											
33													
34	Eccentricity, e	1.07 ft		$e = (J23+J24-J25/2-E4*(J4-B4/2)-E5*(J5-B4/2))/(E8+E25)$						$e = \frac{\sum M_{DRIVING}}{\sum F_{VERT}}$			
35				(Ignores passive resistance but includes vertical shear due to inclined backfill.)									
36	NOTE:												
37	*** TABLE 840.04-1 of ODOT Supplemental Specification 840 (Mechanically Stabilized Earth Wall) specifies 120 pcf as the design unit weight for MSE wall backfill. This value was used for												
38	sliding resistance analyses but a value of 135 pcf (corresponding to Select Granular Backfill) was assumed in Bearing Resistance calculation.												

	A	B	C	D	E	F	G	H	I	J	K	
1	CALC. G1: WALL C1 AT WALL HEIGHT OF 12FT STATIC EXTERNAL STABILITY											
2	ENTER PARAMETERS IN YELLOW CELLS. SEE DIAGRAM TAB FOR CLARIFICATION.											
3	References:	AASHTO 2010 LRFD Bridge Manual		for seismic loads, LRFD calcs								
4		NAVFAC DM 7.2 (1986)		for friction properties								
5		Das (1999)		for earth pressures								
6								B/H =	1.3			
7	Retained Soil Properties					Geometry						
8	Retained Friction Angle, ϕ_r	30	degrees	Height, H	12	feet	(above top of leveling pad)					
9	Unit Weight Above GWT, $\gamma_{m,r}$	120	pcf	Width, B	15	feet						
10	Unit Weight Below GWT, $\gamma_{sat,r}$	120	pcf	Height of GWT, H_w	0	feet	(0 means below the wall bottom)					
11	Ignore Vertical Component of Inclined Loads for Sliding/Overturning?	No		Backslope Angle, β	6.5	degrees						
12				Distance to Slope Break, X	100	feet	(0 if no slope break)					
13	Ka override (blank for auto-calc using Das, 1999 eqn.)		(autocalc)	Backslope Height, Δy	11.4	feet						
14	MSE Properties			Effective Backslope Angle, β'	11.0	degrees	(0 if $x < B$)					
15	Continuous Reinforcement Friction Factor, μ	0.36	(sheets, grids)	Surcharge/Seismic Loads								
16	Discontinuous Reinforcement Friction Factor, μ	0.58	(strips)	Retained Soil Surcharge, q_r	250	psf	(all surcharges ignored for seismic. Surcharge above MSE ignored for sliding/overturning)					
17	Adhesion, a	0	psf	MSE Surcharge, q_{mse}	250	psf						
18	SLIDING Calc: Unit Weight Above GWT, $\gamma_{m,mse}$	120	pcf	k_h	0	g's						
19	SLIDING Calc: Unit Weight Below GWT, $\gamma_{sat,mse}$	120	pcf	ΔK_{ae}	0.00	g's						
20	BEARING Calc: Unit Weight Above GWT, $\gamma_{m,mse}$	135	pcf	ΔK_{ae} override	0	(blank for autocalc)						
21	BEARING Calc: Unit Weight Below GWT, $\gamma_{sat,mse}$	135	pcf									
22												
23	Subgrade/Bearing Properties				Passive Resistance			RESISTANCE FACTORS		LOAD FACTORS		
24	Subgrade Friction Angle, ϕ_s		degrees	Ignore Passive Resistance?	Yes		Resistance	RF	Load	Symbol	LF	
25	Subgrade Cohesion, c		psf	Height of Passive, H_p		feet	Sliding (MSE)	1.0	Earth (Horizontal)	γ_{EH}	1.5	
26	Foundation Depth, D		feet	Passive Friction Angle, ϕ_p		degrees	Passive (MSE)	0.75	Earth (Vertical)	γ_{EV}	1.35	
27	Nominal Bearing Resistance, q_n for B = 15 feet	12.5	ksf	Unit Weight Above GWT, $\gamma_{m,p}$		pcf	Bearing (MSE) (Static)	0.65	Live Surcharge	γ_{LS}	1.75	
28	Unit Weight Above GWT, $\gamma_{m,s}$		pcf	Unit Weight Below GWT, $\gamma_{sat,p}$		pcf	Bearing (MSE) (Seismic)	1.0	Earthquake	γ_{EQ}	1	
29	Unit Weight Below GWT, $\gamma_{sat,s}$		pcf									
30												
31	AASHTO LRFD:											
32												
33	FAILURE BY SLIDING		LOAD SIDE		RESISTANCE SIDE		LRFD CHECK					
34		L (lbs/ft)	LF	L*LF (lbs/ft)	R (lbs/ft)	RF	R*RF (lbs/ft)	R*RF > L*LF ?				
35	LOAD											
36	Earth (L_{EH})	3906	1.5	5859					$L_{EH} = ('SL\&OT\ LOADS'\!E15 + 'SL\&OT\ LOADS'\!E16 + 'SL\&OT\ LOADS'\!E17) * \cos('SL\&OT\ LOADS'\!B8)$			
37	Surcharge (L_{LS})	1187	1.75	2077					$L_{LS} = ('SL\&OT\ LOADS'\!E18) * \cos('SL\&OT\ LOADS'\!B8)$			
38	Earthquake (L_{EQ})	0	1	0					$L_{EQ} = 'SL\&OT\ LOADS'\!E19 + 'SL\&OT\ LOADS'\!E20 + 'SL\&OT\ LOADS'\!E21 + 'SL\&OT\ LOADS'\!E22 * \cos('SL\&OT\ LOADS'\!B8)$			
39	RESISTANCE											
40	Base Friction (continuous reinforcement)				8885	1	8885		$R_{friction} = ('SL\&OT\ LOADS'\!E3 + 'SL\&OT\ LOADS'\!E4 + 'SL\&OT\ LOADS'\!E5 + (D36 + D37) * \tan('SL\&OT\ LOADS'\!B8) + 'SL\&OT\ LOADS'\!E22 * \sin('SL\&OT\ LOADS'\!B8)) * D15$			
41	Passive				0	0.75	0		$R_{passive} = \text{IF}(I24 = "YES", 0, 'SL\&OT\ LOADS'\!E31)$			
42	SUM			7936			8885	YES				
43	RESISTANCE											
44	Base Friction (DIScontinuous reinforcement)				14315	1	14315		$R_{friction} = ('SL\&OT\ LOADS'\!E3 + 'SL\&OT\ LOADS'\!E4 + 'SL\&OT\ LOADS'\!E5 + (D36 + D37) * \tan('SL\&OT\ LOADS'\!B8) + 'SL\&OT\ LOADS'\!E22 * \sin('SL\&OT\ LOADS'\!B8)) * D16$			
45	Passive				0	0.75	0		$R_{passive} = \text{IF}(I24 = "YES", 0, 'SL\&OT\ LOADS'\!E31)$			
46	SUM			7936			14315	YES				
47												
48	FAILURE BY BEARING		LOAD SIDE		RESISTANCE SIDE		LRFD CHECK					
49		L (lbs/ft)	LF	L*LF (lbs/ft)	$q_{FACTORED}$ (psf)	$= \sum L * LF / (B - 2e)$						
50	LOAD											
51	Earth (L_{EV})	26598	1.35	35908					$L_{EV} = \sin('BEARING\ LOADS'\!B8) * ('BEARING\ LOADS'\!E15 + 'BEARING\ LOADS'\!E16 + 'BEARING\ LOADS'\!E17) + 'BEARING\ LOADS'\!E3 + 'BEARING\ LOADS'\!E4 + 'BEARING\ LOADS'\!E5 + 'BEARING\ LOADS'\!E6$			
52	Surcharge (L_{LS})	3981	1.75	6966					$L_{LS} = \sin('BEARING\ LOADS'\!B8) * ('BEARING\ LOADS'\!E18) + 'BEARING\ LOADS'\!E7$			
53	Earthquake (L_{EQ})	0	1	0					$L_{EQ} = 'BEARING\ LOADS'\!E22 * \sin('BEARING\ LOADS'\!B8)$			
54	SUM			42874		3105			$q_{factored} = D54 / (I9 - 2 * 'BEARING\ LOADS'\!B34)$			
55	FAILURE BY OVERTURNING		LOAD SIDE		RESISTANCE SIDE		LRFD CHECK					
56		Nominal Bearing Resistance, q_n for B = 15 feet			12500	psf			Parameter Value Note			
57		Factored Bearnig Resistance = $q_n * RF =$			8125	psf			e	1.04	ft from center of base reinforcement layer	
58		R*RF > $\sum L * LF / (B - 2e)$?			YES				1/4 B	3.75	ft from center of base reinforcement layer	
59									e ≤ 1/4 B ?	YES	See Sections 11.10.5.5 and 11.6.3.3 in AASHTO 2010	

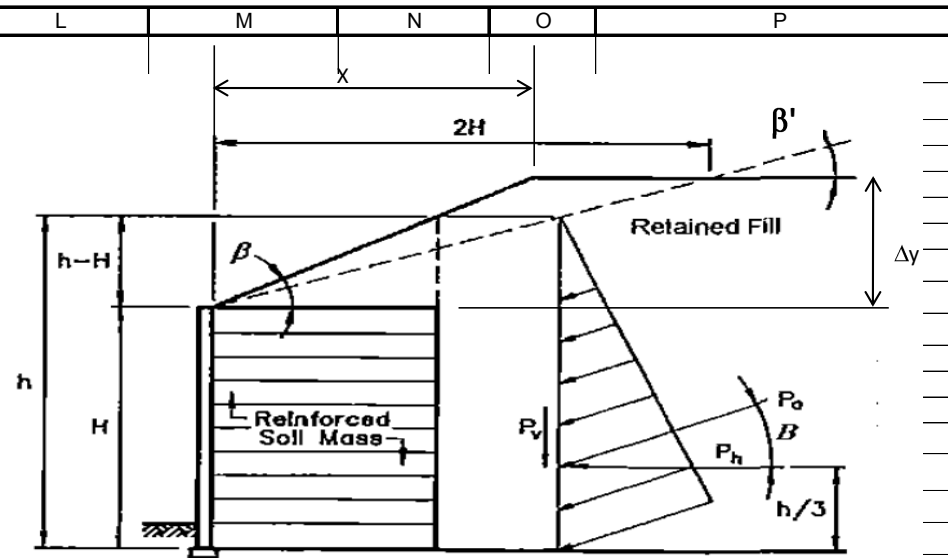


Figure 3.11.5.8.1-3—Earth Pressure Distribution for MSE Wall with Broken Back Backfill Surface

	A	B	C	D	E	F	G	H	I	J	K	L	
2	Geometry			VERTICAL FORCES (not counting vertical components of driving forces)							Moment Arms (about toe)		
3	Height, H	12 ft		$W_m (\beta=0)$	21600 lbs/ft		$W_m = B*(H-H_w)*\gamma_{m,mse}$		x_m	7.50 feet		B/2	
4	Width, B	15 ft		$W_{\beta1}$ (triangular part)	1539 lbs/ft		$W_{\beta1} = 1/2*\min(x,B)*(h-H)*\gamma_{m,r}$		$x_{\beta1}$	10.00 feet		$2/3*\min(B,x)$	
5	Height of GWT, H_w	0 ft		$W_{\beta2}$ (broken slope)	0 lbs/ft		$W_{\beta2} = (B-x)*(h-H)*\gamma_{m,r}$		$x_{\beta2}$	57.50 feet		$x+(B-x)/2$	
6	Height of Retained Fill, h	13.71 ft		W_{sat}'	0 lbs/ft		$W_{sat}' = B*H_w*(\gamma_{sat,mse}-62.4)$		x_{sat}	7.50 feet		B/2	
7	$h = H+B*\tan(\beta)$ $\beta=$	0.113 rad		W_q	0 lbs/ft		$W_q = 0$ for sliding and overturning		x_q	7.50 feet		B/2	
8	Effective Backslope Angle, β'	0.192 rad		W_{TOTAL}	23139 lbs/ft		<- Factored			177390 ft-lb/ft			
9	Seismic Effective Height, H_2	12.72 ft							11.6				
10	$H_2 = H+0.5*H*\tan(\beta)/[1-0.5\tan(\beta)]$												
11	Broken slope width, x	100 ft		DRIVING FORCES									
12	MSE***			K_a	0.353		From AASHTO Eqs 3.11.5.3-1 and 2 for $\theta = 90$ and $\delta = 0$						
13	Friction Factor, μ	0.36		ΔK_{ae}	0.000		From AASHTO Eq A11.1.1.1-2 for β and $\delta = 0$ (notation is different in equation)						
14	Adhesion, a	0 psf		A_m	0.000 g's		$A_m = (1.45-k_h)*k_h$ for $k_h < 0.45$	Direction of Force		Moment Arms (about toe, horz. component)			
15	Unit Weight Above GWT, $\gamma_{m,mse}$	120 pcf		F_{T1}	3979 lbs/ft		$F_{T1} = 1/2*K_a*(h-H_w)^2*\gamma_{m,r}$	Parallel to β'	y_{T1}	4.57 feet		$H_w+(h-H_w)/3$	
16	Unit Weight Below GWT, $\gamma_{sat,mse}$	120 pcf		F_{T2}	0 lbs/ft		$F_{T2} = K_a*(h-H_w)*H_w*\gamma_{m,r}$	Parallel to β'	y_{T2}	0.00 feet		$H_w/2$	
17	Retained			F_{T3}	0 lbs/ft		$F_{T3} = 1/2*K_a*H_w^2*(\gamma_{sat,r}-62.4)$	Parallel to β'	y_{T3}	0.00 feet		$H_w/3$	
18	Friction Angle, ϕ_r	0.524 rad		F_q	1209 lbs/ft		$F_q = K_a*h*q_r$	Parallel to β'	y_q	6.86 feet		$h/2$	
19	Unit Weight Above GWT, $\gamma_{m,r}$	120 pcf		P_{ir}	0 lbs/ft		$P_{ir} = 0.5*A_m*\gamma_{m,mse}*H_2*H$	Horizontal	y_{ir}	6.00 feet		$H/2$	
20	Unit Weight Below GWT, $\gamma_{sat,r}$	120 pcf		P_{is1} (triangular)	0 lbs/ft		$P_{is} = A_m*\gamma_{m,r}*Area_{is}$	Horizontal	y_{is1}	12.24 feet		$H+(H_2-H)/3$	
21	Surcharge/Seismic			P_{is2} (broken slope)	0 lbs/ft			Horizontal	y_{is2}	12.36 feet		$H+(H_2-H)/2$	
22	Retained Soil Surcharge, q_r	250 psf		$0.5P_{AE}$	0 lbs/ft		$0.5P_{AE} = 0.5*\Delta K_{ae}*\gamma_{m,r}*H_2^2$	Parallel to β'	y_{AE}	7.63 feet		$0.6H_2$	
23	MSE Surcharge, q_{mse}	250 psf		F_{HORZ}	0 lbs/ft		<-Factored		M_{HORZ}	0 ft-lb/ft		<-Factored	
24	k_h	0 g's		F_{βx}	7936 lbs/ft		<-Factored		M_{β+}	41022 ft-lb/ft		<-Factored	
25	theta	0		F_{βy}	1543 lbs/ft		<-Factored		M_{β-}	23145 ft-lb/ft		<-Factored	
26	Passive			PASSIVE FORCES (HORIZONTAL)									
27	Height of Passive, H_p	0 ft		10.8	1.00		$K_p = \tan^2(45+\phi/2)$			Moment Arms (about toe)			
28	Friction Angle, ϕ_p	0 rad		F_{P1}	0 lbs/ft		$F_{P1} = 1/2*K_p*(H_p-H_w)^2*\gamma_{m,p}$		y_{P1}	0.00 feet		$H_w+(H_p-H_w)/3$	
29	Unit Weight Above GWT, $\gamma_{m,p}$	0 pcf		F_{P2}	0 lbs/ft		$F_{P2} = K_p*(H_p-H_w)*H_w*\gamma_{m,p}$		y_{P2}	0.00 feet		$H_w/2$	
30	Unit Weight Below GWT, $\gamma_{sat,p}$	0 pcf		F_{P3}	0 lbs/ft		$F_{P3} = 1/2*K_p*H_w^2*(\gamma_{sat,p}-62.4)$		y_{P3}	0.00 feet		$H_w/3$	
31	Ignore Passive Resistance?	Yes		F_{PASSIVE}	0 lbs/ft				M_{PASSIVE}	0 ft-lb/ft			
32	Ignore Vertical from Inclined?	No											
33													
34	Eccentricity, e	1.04 ft		$e = (J23+J24-J25/2-E4*(J4-B4/2)-E5*(J5-B4/2))/(E8+E25)$						$e = \frac{\sum M_{DRIVING}}{\sum F_{VERT}}$			
35				(Ignores passive resistance but includes vertical shear due to inclined backfill.)									
36	NOTE:												
37	*** TABLE 840.04-1 of ODOT Supplemental Specification 840 (Mechanically Stabilized Earth Wall) specifies 120 pcf as the design unit weight for MSE wall backfill. This value was used for												
38	sliding resistance analyses but a value of 135 pcf (corresponding to Select Granular Backfill) was assumed in Bearing Resistance calculation.												

	A	B	C	D	E	F	G	H	I	J	K	L	
2	Geometry			VERTICAL FORCES (not counting vertical components of driving forces)							Moment Arms (about toe)		
3	Height, H	12 ft		$W_m (\beta=0)$	24300 lbs/ft		$W_m = B*(H-H_w)*\gamma_{m,mse}$		x_m	7.50 feet		B/2	
4	Width, B	15 ft		$W_{\beta1}$ (triangular part)	1539 lbs/ft		$W_{\beta1} = 1/2*\min(x,B)*(h-H)*\gamma_{m,r}$		$x_{\beta1}$	10.00 feet		$2/3*\min(B,x)$	
5	Height of GWT, H_w	0 ft		$W_{\beta2}$ (broken slope)	0 lbs/ft		$W_{\beta2} = (B-x)*(h-H)*\gamma_{m,r}$		$x_{\beta2}$	57.50 feet		$x+(B-x)/2$	
6	Height of Retained Fill, h	13.71 ft		W_{sat}'	0 lbs/ft		$W_{sat}' = B*H_w(\gamma_{sat,mse}-62.4)$		x_{sat}	7.50 feet		B/2	
7	$h = H+B*\tan(\beta)$ $\beta=$	0.113 rad		W_q	3750 lbs/ft		$W_q = B*q_{mse}$		x_q	7.50 feet		B/2	
8	Effective Backslope Angle, β'	0.192 rad		W_{TOTAL}	41445 lbs/ft		<- Factored			316033 ft-lb/ft			
9	Seismic Effective Height, H_2	12.72 ft							11.6				
10	$H_2 = H+0.5*H*\tan(\beta)/[1-0.5\tan(\beta)]$												
11	Broken slope width, x	100 ft		DRIVING FORCES									
12	MSE***			K_a	0.353		From AASHTO Eqs 3.11.5.3-1 and 2 for $\theta = 90$ and $\delta = 0$						
13	Friction Factor, μ	0.36		ΔK_{ae}	0.000		From AASHTO Eq A11.1.1.1-2 for β and $\delta = 0$ (notation is different in equation)						
14	Adhesion, a	0 psf		A_m	0.000 g's		$A_m = (1.45-k_h)*k_h$ for $k_h < 0.45$	Direction of Force		Moment Arms (about toe, horz. component)			
15	Unit Weight Above GWT, $\gamma_{m,mse}$	135 pcf		F_{T1}	3979 lbs/ft		$F_{T1} = 1/2*K_a*(h-H_w)^2*\gamma_{m,r}$	Parallel to β'	y_{T1}	4.57 feet		$H_w+(h-H_w)/3$	
16	Unit Weight Below GWT, $\gamma_{sat,mse}$	135 pcf		F_{T2}	0 lbs/ft		$F_{T2} = K_a*(h-H_w)*H_w*\gamma_{m,r}$	Parallel to β'	y_{T2}	0.00 feet		$H_w/2$	
17	Retained			F_{T3}	0 lbs/ft		$F_{T3} = 1/2*K_a*H_w^2*(\gamma_{sat,r}-62.4)$	Parallel to β'	y_{T3}	0.00 feet		$H_w/3$	
18	Friction Angle, ϕ_r	0.524 rad		F_q	1209 lbs/ft		$F_q = K_a*h*q_r$	Parallel to β'	y_q	6.86 feet		$h/2$	
19	Unit Weight Above GWT, $\gamma_{m,r}$	120 pcf		P_{ir}	0 lbs/ft		$P_{ir} = 0.5*A_m*\gamma_{m,mse}*H_2*H$	Horizontal	y_{ir}	6.00 feet		$H/2$	
20	Unit Weight Below GWT, $\gamma_{sat,r}$	120 pcf		P_{is1} (triangular)	0 lbs/ft		$P_{is} = A_m*\gamma_{m,r}*Area_{is}$	Horizontal	y_{is1}	12.24 feet		$H+(H_2-H)/3$	
21	Surcharge/Seismic			P_{is2} (broken slope)	0 lbs/ft			Horizontal	y_{is2}	12.36 feet		$H+(H_2-H)/2$	
22	Retained Soil Surcharge, q_r	250 psf		$0.5P_{AE}$	0 lbs/ft		$0.5P_{AE} = 0.5*\Delta K_{ae}*\gamma_{m,r}*H_2^2$	Parallel to β'	y_{AE}	7.63 feet		$0.6H_2$	
23	MSE Surcharge, q_{mse}	250 psf		F_{HORZ}	0 lbs/ft		<- Factored		M_{HORZ}	0 ft-lb/ft		<- Factored	
24	k_h	0 g's		F_{βx}	7936 lbs/ft		<- Factored		M_{β+}	41022 ft-lb/ft		<- Factored	
25	theta	0		F_{βy}	1543 lbs/ft		<- Factored		M_{β-}	23145 ft-lb/ft		<- Factored	
26	Passive			PASSIVE FORCES (HORIZONTAL)									
27	Height of Passive, H_p	0 ft		10.8	1.00		$K_p = \tan^2(45+\phi/2)$			Moment Arms (about toe)			
28	Friction Angle, ϕ_p	0 rad		F_{P1}	0 lbs/ft		$F_{P1} = 1/2*K_p*(H_p-H_w)^2*\gamma_{m,p}$		y_{P1}	0.00 feet		$H_w+(H_p-H_w)/3$	
29	Unit Weight Above GWT, $\gamma_{m,p}$	0 pcf		F_{P2}	0 lbs/ft		$F_{P2} = K_p*(H_p-H_w)*H_w*\gamma_{m,p}$		y_{P2}	0.00 feet		$H_w/2$	
30	Unit Weight Below GWT, $\gamma_{sat,p}$	0 pcf		F_{P3}	0 lbs/ft		$F_{P3} = 1/2*K_p*H_w^2*(\gamma_{sat,p}-62.4)$		y_{P3}	0.00 feet		$H_w/3$	
31	Ignore Passive Resistance?	Yes		F_{PASSIVE}	0 lbs/ft				M_{PASSIVE}	0 ft-lb/ft			
32	Ignore Vertical from Inclined?	No											
33													
34	Eccentricity, e	0.60 ft		$e = (J23+J24-J25/2-E4*(J4-B4/2)-E5*(J5-B4/2))/(E8+E25)$						$e = \frac{\sum M_{DRIVING}}{\sum F_{VERT}}$			
35				(Ignores passive resistance but includes vertical shear due to inclined backfill.)									
36	NOTE:												
37	*** TABLE 840.04-1 of ODOT Supplemental Specification 840 (Mechanically Stabilized Earth Wall) specifies 120 pcf as the design unit weight for MSE wall backfill. This value was used for												
38	sliding resistance analyses but a value of 135 pcf (corresponding to Select Granular Backfill) was assumed in Bearing Resistance calculation.												

	A	B	C	D	E	F	G	H	I	J	K			
1	CALC. G1: WALL C1 AT WALL HEIGHT OF 14FT STATIC EXTERNAL STABILITY													
2	ENTER PARAMETERS IN YELLOW CELLS. SEE DIAGRAM TAB FOR CLARIFICATION.													
3	References: AASHTO 2010 LRFD Bridge Manual			for seismic loads, LRFD calcs										
4	NAVFAC DM 7.2 (1986)			for friction properties										
5	Das (1999)			for earth pressures										
6				B/H =		0.8								
7	Retained Soil Properties					Geometry								
8	Retained Friction Angle, ϕ_r		30	degrees	Height, H		14	feet	(above top of leveling pad)					
9	Unit Weight Above GWT, $\gamma_{m,r}$		120	pcf	Width, B		11.6	feet						
10	Unit Weight Below GWT, $\gamma_{sat,r}$		120	pcf	Height of GWT, H_w		0	feet	(0 means below the wall bottom)					
11	Ignore Vertical Component of Inclined Loads for Sliding/Overturning?		No		Backslope Angle, β		6.5	degrees						
12					Distance to Slope Break, X		100	feet	(0 if no slope break)					
13	Ka override (blank for auto-calc using Das, 1999 eqn.)			(autocalc)	Backslope Height, Δy		11.4	feet						
14	MSE Properties				Effective Backslope Angle, β'							11.0	degrees	(0 if $x < B$)
15	Continuous Reinforcement Friction Factor, μ		0.36	(sheets, grids)	Surcharge/Seismic Loads									
16	Discontinuous Reinforcement Friction Factor, μ		0.58	(strips)	Retained Soil Surcharge, q_r		250	psf	(all surcharges ignored for seismic. Surcharge above MSE ignored for sliding/overturning)					
17	Adhesion, a		0	psf	MSE Surcharge, q_{mse}		250	psf						
18	SLIDING Calc: Unit Weight Above GWT, $\gamma_{m,mse}$		120	pcf			k_h	0	g's					
19	SLIDING Calc: Unit Weight Below GWT, $\gamma_{sat,mse}$		120	pcf			ΔK_{ae}	0.00	g's					
20	BEARING Calc: Unit Weight Above GWT, $\gamma_{m,mse}$		135	pcf			ΔK_{ae} override	0	(blank for autocalc)					
21	BEARING Calc: Unit Weight Below GWT, $\gamma_{sat,mse}$		135	pcf										
22														
23	Subgrade/Bearing Properties				Passive Resistance				RESISTANCE FACTORS		LOAD FACTORS			
24	Subgrade Friction Angle, ϕ_s			degrees	Ignore Passive Resistance?		Yes	Resistance		RF	Load	Symbol	LF	
25	Subgrade Cohesion, c			psf	Height of Passive, H_p			feet	Sliding (MSE)	1.0	Earth (Horizontal)	γ_{EH}	1.5	
26	Foundation Depth, D			feet	Passive Friction Angle, ϕ_p			degrees	Passive (MSE)	0.75	Earth (Vertical)	γ_{EV}	1.35	
27	Nominal Bearing Resistance, q_n for B = 11.6 feet		10.5	ksf	Unit Weight Above GWT, $\gamma_{m,p}$			pcf	Bearing (MSE) (Static)	0.65	Live Surcharge	γ_{LS}	1.75	
28	Unit Weight Above GWT, $\gamma_{m,s}$			pcf	Unit Weight Below GWT, $\gamma_{sat,p}$			pcf	Bearing (MSE) (Seismic)	1.0	Earthquake	γ_{EQ}	1	
29	Unit Weight Below GWT, $\gamma_{sat,s}$			pcf										
30														
31	AASHTO LRFD:													
32														
33	FAILURE BY SLIDING		LOAD SIDE		RESISTANCE SIDE			LRFD CHECK						
34		L (lbs/ft)	LF	L*LF (lbs/ft)	R (lbs/ft)	RF	R*RF (lbs/ft)	R*RF > L*LF ?						
35	LOAD													
36	Earth (L_{EH})	4878	1.5	7317				$L_{EH} = ('SL\&OT\ LOADS'\!E15 + 'SL\&OT\ LOADS'\!E16 + 'SL\&OT\ LOADS'\!E17) * \cos('SL\&OT\ LOADS'\!B8)$						
37	Surcharge (L_{LS})	1326	1.75	2321				$L_{LS} = ('SL\&OT\ LOADS'\!E18) * \cos('SL\&OT\ LOADS'\!B8)$						
38	Earthquake (L_{EQ})	0	1	0				$L_{EQ} = 'SL\&OT\ LOADS'\!E19 + 'SL\&OT\ LOADS'\!E20 + 'SL\&OT\ LOADS'\!E21 + 'SL\&OT\ LOADS'\!E22 * \cos('SL\&OT\ LOADS'\!B8)$						
39	RESISTANCE													
40	Base Friction (continuous reinforcement)				8021	1	8021	$R_{friction} = ('SL\&OT\ LOADS'\!E3 + 'SL\&OT\ LOADS'\!E4 + 'SL\&OT\ LOADS'\!E5 + (D36 + D37) * \tan('SL\&OT\ LOADS'\!B8) + 'SL\&OT\ LOADS'\!E22 * \sin('SL\&OT\ LOADS'\!B8)) * D15$						
41	Passive				0	0.75	0	$R_{passive} = \text{IF}(I24 = "YES", 0, 'SL\&OT\ LOADS'\!E31)$						
42	SUM			9637			8021	NO						
43	RESISTANCE													
44	Base Friction (DIScontinuous reinforcement)				12923	1	12923	$R_{friction} = ('SL\&OT\ LOADS'\!E3 + 'SL\&OT\ LOADS'\!E4 + 'SL\&OT\ LOADS'\!E5 + (D36 + D37) * \tan('SL\&OT\ LOADS'\!B8) + 'SL\&OT\ LOADS'\!E22 * \sin('SL\&OT\ LOADS'\!B8)) * D16$						
45	Passive				0	0.75	0	$R_{passive} = \text{IF}(I24 = "YES", 0, 'SL\&OT\ LOADS'\!E31)$						
46	SUM			9637			12923	YES						
47														
48	FAILURE BY BEARING		LOAD SIDE		RESISTANCE SIDE			LRFD CHECK						
49		L (lbs/ft)	LF	L*LF (lbs/ft)	$q_{FACTORED}$ (psf)	$= \sum L * LF / (B - 2e)$		R*RF > L*LF ?						
50	LOAD													
51	Earth (L_{EV})	23791	1.35	32118	$L_{EV} = \sin('BEARING\ LOADS'\!B8) * ('BEARING\ LOADS'\!E15 + 'BEARING\ LOADS'\!E16 + 'BEARING\ LOADS'\!E17) + 'BEARING\ LOADS'\!E3 + 'BEARING\ LOADS'\!E4 + 'BEARING\ LOADS'\!E5 + 'BEARING\ LOADS'\!E6$									
52	Surcharge (L_{LS})	3158	1.75	5526	$L_{LS} = \sin('BEARING\ LOADS'\!B8) * ('BEARING\ LOADS'\!E18) + 'BEARING\ LOADS'\!E7$									
53	Earthquake (L_{EQ})	0	1	0	$L_{EQ} = 'BEARING\ LOADS'\!E22 * \sin('BEARING\ LOADS'\!B8)$									
54	SUM			37644	4027	$q_{factored} = D54 / (I9 - 2 * 'BEARING\ LOADS'\!B34)$								
55	RESISTANCE SIDE				FAILURE BY OVERTURNING									
56	Nominal Bearing Resistance, q_n for B = 11.6 feet		10500		psf			Parameter		Value	Note			
57	Factored Bearnig Resistance = $q_n * RF =$		6825		psf	=IF(I18=0,E56*L27,E56*L28)		e	1.91	ft from center of base reinforcement layer				
58	R*RF > $\sum L * LF / (B - 2e)$?		YES		=IF(E57>E54,"YES","NO")		1/4 B	2.90	ft from center of base reinforcement layer					
59							$e \leq 1/4 B$?	YES	See Sections 11.10.5.5 and 11.6.3.3 in AASHTO 2010					

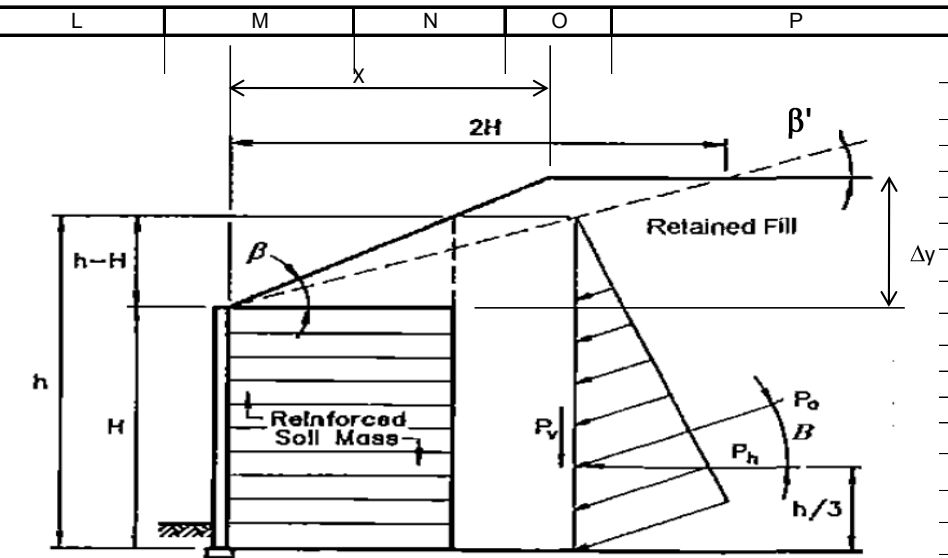


Figure 3.11.5.8.1-3—Earth Pressure Distribution for MSE Wall with Broken Back Backfill Surface

	A	B	C	D	E	F	G	H	I	J	K	L	
2	Geometry			VERTICAL FORCES (not counting vertical components of driving forces)							Moment Arms (about toe)		
3	Height, H	14 ft		$W_m (\beta=0)$	19488 lbs/ft		$W_m = B*(H-H_w)*\gamma_{m,mse}$		x_m	5.80 feet		B/2	
4	Width, B	11.6 ft		$W_{\beta1}$ (triangular part)	919 lbs/ft		$W_{\beta1} = 1/2*\min(x,B)*(h-H)*\gamma_{m,r}$		$x_{\beta1}$	7.73 feet		2/3*min(B,x)	
5	Height of GWT, H_w	0 ft		$W_{\beta2}$ (broken slope)	0 lbs/ft		$W_{\beta2} = (B-x)*(h-H)*\gamma_{m,r}$		$x_{\beta2}$	55.80 feet		$x+(B-x)/2$	
6	Height of Retained Fill, h	15.32 ft		W_{sat}'	0 lbs/ft		$W_{sat}' = B*H_w*(\gamma_{sat,mse}-62.4)$		x_{sat}	5.80 feet		B/2	
7	$h = H+B*\tan(\beta)$ $\beta=$	0.113 rad		W_q	0 lbs/ft		$W_q = 0$ for sliding and overturning		x_q	5.80 feet		B/2	
8	Effective Backslope Angle, β'	0.192 rad		W_{TOTAL}	20407 lbs/ft		<- Factored			120134 ft-lb/ft			
9	Seismic Effective Height, H_2	14.85 ft							11.6				
10	$H_2 = H+0.5*H*\tan(\beta)/[1-0.5\tan(\beta)]$												
11	Broken slope width, x	100 ft		DRIVING FORCES									
12	MSE***			K_a	0.353		From AASHTO Eqs 3.11.5.3-1 and 2 for $\theta = 90$ and $\delta = 0$						
13	Friction Factor, μ	0.36		ΔK_{ae}	0.000		From AASHTO Eq A11.1.1.1-2 for β and $\delta = 0$ (notation is different in equation)						
14	Adhesion, a	0 psf		A_m	0.000 g's		$A_m = (1.45-k_h)*k_h$ for $k_h < 0.45$	Direction of Force		Moment Arms (about toe, horz. component)			
15	Unit Weight Above GWT, $\gamma_{m,mse}$	120 pcf		F_{T1}	4969 lbs/ft		$F_{T1} = 1/2*K_a*(h-H_w)^2*\gamma_{m,r}$	Parallel to β'	y_{T1}	5.11 feet		$H_w+(h-H_w)/3$	
16	Unit Weight Below GWT, $\gamma_{sat,mse}$	120 pcf		F_{T2}	0 lbs/ft		$F_{T2} = K_a*(h-H_w)*H_w*\gamma_{m,r}$	Parallel to β'	y_{T2}	0.00 feet		$H_w/2$	
17	Retained			F_{T3}	0 lbs/ft		$F_{T3} = 1/2*K_a*H_w^2*(\gamma_{sat,r}-62.4)$	Parallel to β'	y_{T3}	0.00 feet		$H_w/3$	
18	Friction Angle, ϕ_r	0.524 rad		F_q	1351 lbs/ft		$F_q = K_a*h*q_r$	Parallel to β'	y_q	7.66 feet		$h/2$	
19	Unit Weight Above GWT, $\gamma_{m,r}$	120 pcf		P_{ir}	0 lbs/ft		$P_{ir} = 0.5*A_m*\gamma_{m,mse}*H_2*H$	Horizontal	y_{ir}	7.00 feet		$H/2$	
20	Unit Weight Below GWT, $\gamma_{sat,r}$	120 pcf		P_{is1} (triangular)	0 lbs/ft		$P_{is} = A_m*\gamma_{m,r}*Area_{is}$	Horizontal	y_{is1}	14.28 feet		$H+(H_2-H)/3$	
21	Surcharge/Seismic			P_{is2} (broken slope)	0 lbs/ft			Horizontal	y_{is2}	14.43 feet		$H+(H_2-H)/2$	
22	Retained Soil Surcharge, q_r	250 psf		$0.5P_{AE}$	0 lbs/ft		$0.5P_{AE} = 0.5*\Delta K_{ae}*\gamma_{m,r}*H_2^2$	Parallel to β'	y_{AE}	8.91 feet		$0.6H_2$	
23	MSE Surcharge, q_{mse}	250 psf		F_{HORIZ}	0 lbs/ft		<-Factored		M_{HORIZ}	0 ft-lb/ft		<-Factored	
24	k_h	0 g's		$F_{\beta x}$	9637 lbs/ft		<-Factored		$M_{\beta+}$	55165 ft-lb/ft		<-Factored	
25	theta	0		$F_{\beta y}$	1873 lbs/ft		<-Factored		$M_{\beta-}$	21727 ft-lb/ft		<-Factored	
26	Passive			PASSIVE FORCES (HORIZONTAL)									
27	Height of Passive, H_p	0 ft		10.8	1.00		$K_p = \tan^2(45+\phi/2)$			Moment Arms (about toe)			
28	Friction Angle, ϕ_p	0 rad		F_{P1}	0 lbs/ft		$F_{P1} = 1/2*K_p*(H_p-H_w)^2*\gamma_{m,p}$		y_{P1}	0.00 feet		$H_w+(H_p-H_w)/3$	
29	Unit Weight Above GWT, $\gamma_{m,p}$	0 pcf		F_{P2}	0 lbs/ft		$F_{P2} = K_p*(H_p-H_w)*H_w*\gamma_{m,p}$		y_{P2}	0.00 feet		$H_w/2$	
30	Unit Weight Below GWT, $\gamma_{sat,p}$	0 pcf		F_{P3}	0 lbs/ft		$F_{P3} = 1/2*K_p*H_w^2*(\gamma_{sat,p}-62.4)$		y_{P3}	0.00 feet		$H_w/3$	
31	Ignore Passive Resistance?	Yes		$F_{PASSIVE}$	0 lbs/ft				$M_{PASSIVE}$	0 ft-lb/ft			
32	Ignore Vertical from Inclined?	No											
33													
34	Eccentricity, e	1.91 ft		$e = (J23+J24-J25/2-E4*(J4-B4/2)-E5*(J5-B4/2))/(E8+E25)$						$e = \frac{\sum M_{DRIVING}}{\sum F_{VERT}}$			
35				(Ignores passive resistance but includes vertical shear due to inclined backfill.)									
36	NOTE:												
37	*** TABLE 840.04-1 of ODOT Supplemental Specification 840 (Mechanically Stabilized Earth Wall) specifies 120 pcf as the design unit weight for MSE wall backfill. This value was used for												
38	sliding resistance analyses but a value of 135 pcf (corresponding to Select Granular Backfill) was assumed in Bearing Resistance calculation.												

	A	B	C	D	E	F	G	H	I	J	K	L	
2	Geometry			VERTICAL FORCES (not counting vertical components of driving forces)							Moment Arms (about toe)		
3	Height, H	14 ft		$W_m (\beta=0)$	21924 lbs/ft		$W_m = B*(H-H_w)*\gamma_{m,mse}$		x_m	5.80 feet		B/2	
4	Width, B	11.6 ft		$W_{\beta1}$ (triangular part)	919 lbs/ft		$W_{\beta1} = 1/2*\min(x,B)*(h-H)*\gamma_{m,r}$		$x_{\beta1}$	7.73 feet		$2/3*\min(B,x)$	
5	Height of GWT, H_w	0 ft		$W_{\beta2}$ (broken slope)	0 lbs/ft		$W_{\beta2} = (B-x)*(h-H)*\gamma_{m,r}$		$x_{\beta2}$	55.80 feet		$x+(B-x)/2$	
6	Height of Retained Fill, h	15.32 ft		W_{sat}'	0 lbs/ft		$W_{sat}' = B*H_w(\gamma_{sat,mse}-62.4)$		x_{sat}	5.80 feet		B/2	
7	$h = H+B*\tan(\beta)$ $\beta=$	0.113 rad		W_q	2900 lbs/ft		$W_q = B*q_{mse}$		x_q	5.80 feet		B/2	
8	Effective Backslope Angle, β'	0.192 rad		W_{TOTAL}	35913 lbs/ft		<- Factored			210690 ft-lb/ft			
9	Seismic Effective Height, H_2	14.85 ft							11.6				
10	$H_2 = H+0.5*H*\tan(\beta)/[1-0.5\tan(\beta)]$												
11	Broken slope width, x	100 ft		DRIVING FORCES									
12	MSE***			K_a	0.353		From AASHTO Eqs 3.11.5.3-1 and 2 for $\theta = 90$ and $\delta = 0$						
13	Friction Factor, μ	0.36		ΔK_{ae}	0.000		From AASHTO Eq A11.1.1.1-2 for β and $\delta = 0$ (notation is different in equation)						
14	Adhesion, a	0 psf		A_m	0.000 g's		$A_m = (1.45-k_h)*k_h$ for $k_h < 0.45$	Direction of Force		Moment Arms (about toe, horz. component)			
15	Unit Weight Above GWT, $\gamma_{m,mse}$	135 pcf		F_{T1}	4969 lbs/ft		$F_{T1} = 1/2*K_a*(h-H_w)^2*\gamma_{m,r}$	Parallel to β'	y_{T1}	5.11 feet		$H_w+(h-H_w)/3$	
16	Unit Weight Below GWT, $\gamma_{sat,mse}$	135 pcf		F_{T2}	0 lbs/ft		$F_{T2} = K_a*(h-H_w)*H_w*\gamma_{m,r}$	Parallel to β'	y_{T2}	0.00 feet		$H_w/2$	
17	Retained			F_{T3}	0 lbs/ft		$F_{T3} = 1/2*K_a*H_w^2*(\gamma_{sat,r}-62.4)$	Parallel to β'	y_{T3}	0.00 feet		$H_w/3$	
18	Friction Angle, ϕ_r	0.524 rad		F_q	1351 lbs/ft		$F_q = K_a*h*q_r$	Parallel to β'	y_q	7.66 feet		$h/2$	
19	Unit Weight Above GWT, $\gamma_{m,r}$	120 pcf		P_{ir}	0 lbs/ft		$P_{ir} = 0.5*A_m*\gamma_{m,mse}*H_2*H$	Horizontal	y_{ir}	7.00 feet		$H/2$	
20	Unit Weight Below GWT, $\gamma_{sat,r}$	120 pcf		P_{is1} (triangular)	0 lbs/ft		$P_{is} = A_m*\gamma_{m,r}*Area_{is}$	Horizontal	y_{is1}	14.28 feet		$H+(H_2-H)/3$	
21	Surcharge/Seismic			P_{is2} (broken slope)	0 lbs/ft			Horizontal	y_{is2}	14.43 feet		$H+(H_2-H)/2$	
22	Retained Soil Surcharge, q_r	250 psf		$0.5P_{AE}$	0 lbs/ft		$0.5P_{AE} = 0.5*\Delta K_{ae}*\gamma_{m,r}*H_2^2$	Parallel to β'	y_{AE}	8.91 feet		$0.6H_2$	
23	MSE Surcharge, q_{mse}	250 psf		F_{HORZ}	0 lbs/ft		<- Factored		M_{HORZ}	0 ft-lb/ft		<- Factored	
24	k_h	0 g's		F_{βx}	9637 lbs/ft		<- Factored		M_{β+}	55165 ft-lb/ft		<- Factored	
25	theta	0		F_{βy}	1873 lbs/ft		<- Factored		M_{β-}	21727 ft-lb/ft		<- Factored	
26	Passive			PASSIVE FORCES (HORIZONTAL)									
27	Height of Passive, H_p	0 ft		10.8	1.00		$K_p = \tan^2(45+\phi/2)$			Moment Arms (about toe)			
28	Friction Angle, ϕ_p	0 rad		F_{P1}	0 lbs/ft		$F_{P1} = 1/2*K_p*(H_p-H_w)^2*\gamma_{m,p}$		y_{P1}	0.00 feet		$H_w+(H_p-H_w)/3$	
29	Unit Weight Above GWT, $\gamma_{m,p}$	0 pcf		F_{P2}	0 lbs/ft		$F_{P2} = K_p*(H_p-H_w)*H_w*\gamma_{m,p}$		y_{P2}	0.00 feet		$H_w/2$	
30	Unit Weight Below GWT, $\gamma_{sat,p}$	0 pcf		F_{P3}	0 lbs/ft		$F_{P3} = 1/2*K_p*H_w^2*(\gamma_{sat,p}-62.4)$		y_{P3}	0.00 feet		$H_w/3$	
31	Ignore Passive Resistance?	Yes		F_{PASSIVE}	0 lbs/ft				M_{PASSIVE}	0 ft-lb/ft			
32	Ignore Vertical from Inclined?	No											
33													
34	Eccentricity, e	1.13 ft		$e = (J23+J24-J25/2-E4*(J4-B4/2)-E5*(J5-B4/2))/(E8+E25)$						$e = \frac{\sum M_{DRIVING}}{\sum F_{VERT}}$			
35				(Ignores passive resistance but includes vertical shear due to inclined backfill.)									
36	NOTE:												
37	*** TABLE 840.04-1 of ODOT Supplemental Specification 840 (Mechanically Stabilized Earth Wall) specifies 120 pcf as the design unit weight for MSE wall backfill. This value was used for												
38	sliding resistance analyses but a value of 135 pcf (corresponding to Select Granular Backfill) was assumed in Bearing Resistance calculation.												

CALC. G: WALL C1 AT WALL STA. 12+25 STATIC EXTERNAL STABILITY													
ENTER PARAMETERS IN YELLOW CELLS. SEE DIAGRAM TAB FOR CLARIFICATION.													
References:		AASHTO 2010 LRFD Bridge Manual			for seismic loads, LRFD calcs								
		NAVFAC DM 7.2 (1986)			for friction properties								
		Das (1999)			for earth pressures								
					B/H = 0.9								
Retained Soil Properties					Geometry								
Retained Friction Angle, ϕ_r		30 degrees			Height, H		22 feet (above top of leveling pad)						
Unit Weight Above GWT, $\gamma_{m,r}$		120 pcf			Width, B		19.8 feet						
Unit Weight Below GWT, $\gamma_{sat,r}$		120 pcf			Height of GWT, H_w		0 feet (0 means below the wall bottom)						
Ignore Vertical Component of Inclined Loads for Sliding/Overturning?		No			Backslope Angle, β		6.5 degrees						
					Distance to Slope Break, X		100 feet (0 if no slope break)						
Ka override (blank for auto-calc using Das, 1999 eqn.)		(autocalc)			Backslope Height, Δy		11.4 feet						
MSE Properties					Effective Backslope Angle, β'								
		11.0 degrees (0 if $x < B$)											
Continuous Reinforcement Friction Factor, μ		0.36 (sheets, grids)			Surcharge/Seismic Loads								
Discontinuous Reinforcement Friction Factor, μ		0.58 (strips)			Retained Soil Surcharge, q_r		250 psf (all surcharges ignored for seismic. Surcharge above MSE ignored for sliding/overturning)						
Adhesion, a		0 psf			MSE Surcharge, q_{mse}		250 psf						
SLIDING Calc: Unit Weight Above GWT, $\gamma_{m,mse}$		120 pcf			k_h		0 g's						
SLIDING Calc: Unit Weight Below GWT, $\gamma_{sat,mse}$		120 pcf			ΔK_{ae}		0.00 g's						
BEARING Calc: Unit Weight Above GWT, $\gamma_{m,mse}$		135 pcf			ΔK_{ae} override								
BEARING Calc: Unit Weight Below GWT, $\gamma_{sat,mse}$		135 pcf			0 (blank for autocalc)								
Subgrade/Bearing Properties					Passive Resistance			RESISTANCE FACTORS		LOAD FACTORS			
Subgrade Friction Angle, ϕ_s					Ignore Passive Resistance?		Yes		Resistance		RF		
Subgrade Cohesion, c					Height of Passive, H_p				Sliding (MSE)		1.0		
Foundation Depth, D					Passive Friction Angle, ϕ_p				Passive (MSE)		0.75		
Nominal Bearing Resistance, q_n for B = 19.8 feet		16.0 ksf			Unit Weight Above GWT, $\gamma_{m,p}$				Bearing (MSE) (Static)		0.65		
Unit Weight Above GWT, $\gamma_{m,s}$					Unit Weight Below GWT, $\gamma_{sat,p}$				Bearing (MSE) (Seismic)		1.0		
Unit Weight Below GWT, $\gamma_{sat,s}$													
AASHTO LRFD:													
FAILURE BY SLIDING		LOAD SIDE		RESISTANCE SIDE		LRFD CHECK							
		L (lbs/ft)	LF	L*LF (lbs/ft)	R (lbs/ft)	RF	R*RF (lbs/ft)	R*RF > L*LF ?					
LOAD													
Earth (L_{EH})		12231	1.5	18347					$L_{EH} = ('SL\&OT\ LOADS'\!E15 + 'SL\&OT\ LOADS'\!E16 + 'SL\&OT\ LOADS'\!E17) * \cos('SL\&OT\ LOADS'\!B8)$				
Surcharge (L_{LS})		2101	1.75	3676					$L_{LS} = ('SL\&OT\ LOADS'\!E18) * \cos('SL\&OT\ LOADS'\!B8)$				
Earthquake (L_{EQ})		0	1	0					$L_{EQ} = 'SL\&OT\ LOADS'\!E19 + 'SL\&OT\ LOADS'\!E20 + 'SL\&OT\ LOADS'\!E21 + 'SL\&OT\ LOADS'\!E22 * \cos('SL\&OT\ LOADS'\!B8)$				
RESISTANCE													
Base Friction (continuous reinforcement)				21326		1		21326		$R_{friction} = ('SL\&OT\ LOADS'\!E3 + 'SL\&OT\ LOADS'\!E4 + 'SL\&OT\ LOADS'\!E5 + (D36 + D37) * \tan('SL\&OT\ LOADS'\!B8) + 'SL\&OT\ LOADS'\!E22 * \sin('SL\&OT\ LOADS'\!B8)) * D15$			
Passive				0		0.75		0		$R_{passive} = \text{IF}(I24 = "YES", 0, 'SL\&OT\ LOADS'\!E31)$			
SUM				22023				21326		NO			
RESISTANCE													
Base Friction (DIScontinuous reinforcement)				34358		1		34358		$R_{friction} = ('SL\&OT\ LOADS'\!E3 + 'SL\&OT\ LOADS'\!E4 + 'SL\&OT\ LOADS'\!E5 + (D36 + D37) * \tan('SL\&OT\ LOADS'\!B8) + 'SL\&OT\ LOADS'\!E22 * \sin('SL\&OT\ LOADS'\!B8)) * D16$			
Passive				0		0.75		0		$R_{passive} = \text{IF}(I24 = "YES", 0, 'SL\&OT\ LOADS'\!E31)$			
SUM				22023				34358		YES			
FAILURE BY BEARING		LOAD SIDE		RESISTANCE SIDE		LRFD CHECK							
B-2e = 16.8 feet		L (lbs/ft)	LF	L*LF (lbs/ft)	$q_{FACTORED}$ (psf)	$= \sum L * LF / (B - 2e)$							
LOAD													
Earth (L_{EV})		63869	1.35	86223					$L_{EV} = \sin('BEARING\ LOADS'\!B8) * ('BEARING\ LOADS'\!E15 + 'BEARING\ LOADS'\!E16 + 'BEARING\ LOADS'\!E17) + 'BEARING\ LOADS'\!E3 + 'BEARING\ LOADS'\!E4 + 'BEARING\ LOADS'\!E5 + 'BEARING\ LOADS'\!E6$				
Surcharge (L_{LS})		5358	1.75	9377					$L_{LS} = \sin('BEARING\ LOADS'\!B8) * ('BEARING\ LOADS'\!E18) + 'BEARING\ LOADS'\!E7$				
Earthquake (L_{EQ})		0	1	0					$L_{EQ} = 'BEARING\ LOADS'\!E22 * \sin('BEARING\ LOADS'\!B8)$				
SUM				95600		5675				$q_{factored} = D54 / (I9 - 2 * 'BEARING\ LOADS'\!B34)$			
RESISTANCE													
Nominal Bearing Resistance, q_n for B = 19.8 feet				16000 psf						FAILURE BY OVERTURNING			
Factored Bearing Resistance = $q_n * RF =$				10400 psf						Parameter Value Note			
R*RF > $\sum L * LF / (B - 2e)$?				YES						e 2.39 ft from center of base reinforcement layer			
										1/4 B 4.95 ft from center of base reinforcement layer			
										e ≤ 1/4 B ? YES See Sections 11.10.5.5 and 11.6.3.3 in AASHTO 2010			

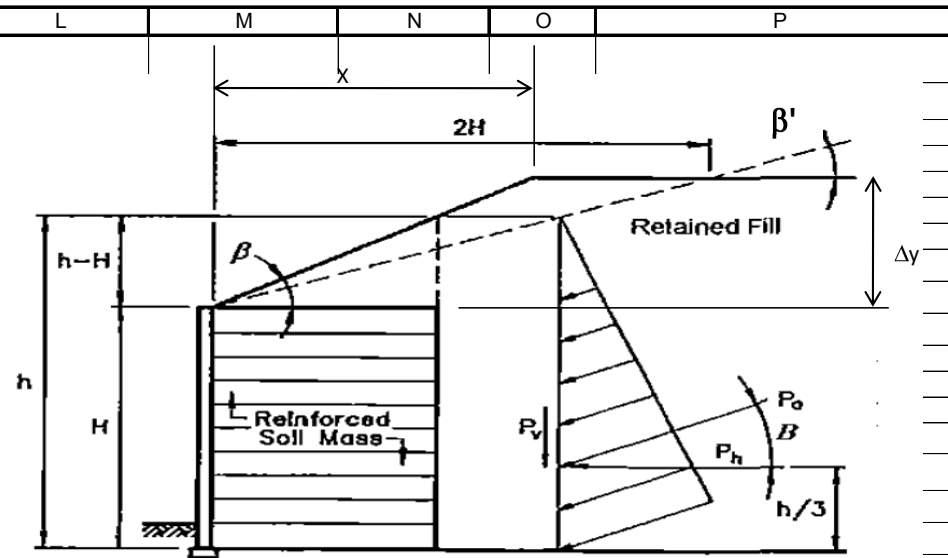


Figure 3.11.5.8.1-3—Earth Pressure Distribution for MSE Wall with Broken Back Backfill Surface

	A	B	C	D	E	F	G	H	I	J	K	L	
2	Geometry			VERTICAL FORCES (not counting vertical components of driving forces)							Moment Arms (about toe)		
3	Height, H	22 ft		$W_m (\beta=0)$	52272 lbs/ft		$W_m = B*(H-H_w)*\gamma_{m,mse}$		x_m	9.90 feet		B/2	
4	Width, B	19.8 ft		$W_{\beta1}$ (triangular part)	2685 lbs/ft		$W_{\beta1} = 1/2*\min(x,B)*(h-H)*\gamma_{m,r}$		$x_{\beta1}$	13.20 feet		$2/3*\min(B,x)$	
5	Height of GWT, H_w	0 ft		$W_{\beta2}$ (broken slope)	0 lbs/ft		$W_{\beta2} = (B-x)*(h-H)*\gamma_{m,r}$		$x_{\beta2}$	59.90 feet		$x+(B-x)/2$	
6	Height of Retained Fill, h	24.26 ft		W_{sat}'	0 lbs/ft		$W_{sat}' = B*H_w(\gamma_{sat,mse}-62.4)$		x_{sat}	9.90 feet		B/2	
7	$h = H+B*\tan(\beta)$ $\beta=$	0.113 rad		W_q	0 lbs/ft		$W_q = 0$ for sliding and overturning		x_q	9.90 feet		B/2	
8	Effective Backslope Angle, β'	0.192 rad		W_{TOTAL}	54957 lbs/ft		<- Factored			552935 ft-lb/ft			
9	Seismic Effective Height, H_2	23.33 ft							11.6				
10	$H_2 = H+0.5*H*\tan(\beta)/[1-0.5\tan(\beta)]$												
11	Broken slope width, x	100 ft		DRIVING FORCES									
12	MSE***			K_a	0.353		From AASHTO Eqs 3.11.5.3-1 and 2 for $\theta = 90$ and $\delta = 0$						
13	Friction Factor, μ	0.36		ΔK_{ae}	0.000		From AASHTO Eq A11.1.1.1-2 for β and $\delta = 0$ (notation is different in equation)						
14	Adhesion, a	0 psf		A_m	0.000 g's		$A_m = (1.45-k_h)*k_h$ for $k_h < 0.45$	Direction of Force		Moment Arms (about toe, horz. component)			
15	Unit Weight Above GWT, $\gamma_{m,mse}$	120 pcf		F_{T1}	12460 lbs/ft		$F_{T1} = 1/2*K_a*(h-H_w)^2*\gamma_{m,r}$	Parallel to β'	y_{T1}	8.09 feet		$H_w+(h-H_w)/3$	
16	Unit Weight Below GWT, $\gamma_{sat,mse}$	120 pcf		F_{T2}	0 lbs/ft		$F_{T2} = K_a*(h-H_w)*H_w*\gamma_{m,r}$	Parallel to β'	y_{T2}	0.00 feet		$H_w/2$	
17	Retained			F_{T3}	0 lbs/ft		$F_{T3} = 1/2*K_a*H_w^2*(\gamma_{sat,r}-62.4)$	Parallel to β'	y_{T3}	0.00 feet		$H_w/3$	
18	Friction Angle, ϕ_r	0.524 rad		F_q	2140 lbs/ft		$F_q = K_a*h*q_r$	Parallel to β'	y_q	12.13 feet		$h/2$	
19	Unit Weight Above GWT, $\gamma_{m,r}$	120 pcf		P_{ir}	0 lbs/ft		$P_{ir} = 0.5*A_m*\gamma_{m,mse}*H_2*H$	Horizontal	y_{ir}	11.00 feet		$H/2$	
20	Unit Weight Below GWT, $\gamma_{sat,r}$	120 pcf		P_{is1} (triangular)	0 lbs/ft		$P_{is} = A_m*\gamma_{m,r}*Area_{is}$	Horizontal	y_{is1}	22.44 feet		$H+(H_2-H)/3$	
21	Surcharge/Seismic			P_{is2} (broken slope)	0 lbs/ft			Horizontal	y_{is2}	22.67 feet		$H+(H_2-H)/2$	
22	Retained Soil Surcharge, q_r	250 psf		$0.5P_{AE}$	0 lbs/ft		$0.5P_{AE} = 0.5*\Delta K_{ae}*\gamma_{m,r}*H_2^2$	Parallel to β'	y_{AE}	14.00 feet		$0.6H_2$	
23	MSE Surcharge, q_{mse}	250 psf		F_{HORZ}	0 lbs/ft		<-Factored		M_{HORZ}	0 ft-lb/ft		<-Factored	
24	k_h	0 g's		F_{βx}	22023 lbs/ft		<-Factored		M_{β+}	193016 ft-lb/ft		<-Factored	
25	theta	0		F_{βy}	4281 lbs/ft		<-Factored		M_{β-}	84764 ft-lb/ft		<-Factored	
26	Passive			PASSIVE FORCES (HORIZONTAL)									
27	Height of Passive, H_p	0 ft		10.8	1.00		$K_p = \tan^2(45+\phi/2)$			Moment Arms (about toe)			
28	Friction Angle, ϕ_p	0 rad		F_{P1}	0 lbs/ft		$F_{P1} = 1/2*K_p*(H_p-H_w)^2*\gamma_{m,p}$		y_{P1}	0.00 feet		$H_w+(H_p-H_w)/3$	
29	Unit Weight Above GWT, $\gamma_{m,p}$	0 pcf		F_{P2}	0 lbs/ft		$F_{P2} = K_p*(H_p-H_w)*H_w*\gamma_{m,p}$		y_{P2}	0.00 feet		$H_w/2$	
30	Unit Weight Below GWT, $\gamma_{sat,p}$	0 pcf		F_{P3}	0 lbs/ft		$F_{P3} = 1/2*K_p*H_w^2*(\gamma_{sat,p}-62.4)$		y_{P3}	0.00 feet		$H_w/3$	
31	Ignore Passive Resistance?	Yes		F_{PASSIVE}	0 lbs/ft				M_{PASSIVE}	0 ft-lb/ft			
32	Ignore Vertical from Inclined?	No											
33													
34	Eccentricity, e	2.39 ft		$e = (J23+J24-J25/2-E4*(J4-B4/2)-E5*(J5-B4/2))/(E8+E25)$						$e = \frac{\sum M_{DRIVING}}{\sum F_{VERT}}$			
35				(Ignores passive resistance but includes vertical shear due to inclined backfill.)									
36	NOTE:												
37	*** TABLE 840.04-1 of ODOT Supplemental Specification 840 (Mechanically Stabilized Earth Wall) specifies 120 pcf as the design unit weight for MSE wall backfill. This value was used for												
38	sliding resistance analyses but a value of 135 pcf (corresponding to Select Granular Backfill) was assumed in Bearing Resistance calculation.												

	A	B	C	D	E	F	G	H	I	J	K	L	
2	Geometry			VERTICAL FORCES (not counting vertical components of driving forces)							Moment Arms (about toe)		
3	Height, H	22 ft		$W_m (\beta=0)$	58806 lbs/ft		$W_m = B*(H-H_w)*\gamma_{m,mse}$		x_m	9.90 feet		B/2	
4	Width, B	19.8 ft		$W_{\beta1}$ (triangular part)	2685 lbs/ft		$W_{\beta1} = 1/2*\min(x,B)*(h-H)*\gamma_{m,r}$		$x_{\beta1}$	13.20 feet		$2/3*\min(B,x)$	
5	Height of GWT, H_w	0 ft		$W_{\beta2}$ (broken slope)	0 lbs/ft		$W_{\beta2} = (B-x)*(h-H)*\gamma_{m,r}$		$x_{\beta2}$	59.90 feet		$x+(B-x)/2$	
6	Height of Retained Fill, h	24.26 ft		W_{sat}'	0 lbs/ft		$W_{sat}' = B*H_w(\gamma_{sat,mse}-62.4)$		x_{sat}	9.90 feet		B/2	
7	$h = H+B*\tan(\beta)$ $\beta=$	0.113 rad		W_q	4950 lbs/ft		$W_q = B*q_{mse}$		x_q	9.90 feet		B/2	
8	Effective Backslope Angle, β'	0.192 rad		W_{TOTAL}	91675 lbs/ft		<- Factored			919548 ft-lb/ft			
9	Seismic Effective Height, H_2	23.33 ft							11.6				
10	$H_2 = H+0.5*H*\tan(\beta)/[1-0.5\tan(\beta)]$												
11	Broken slope width, x	100 ft		DRIVING FORCES									
12	MSE***			K_a	0.353		From AASHTO Eqs 3.11.5.3-1 and 2 for $\theta = 90$ and $\delta = 0$						
13	Friction Factor, μ	0.36		ΔK_{ae}	0.000		From AASHTO Eq A11.1.1.1-2 for β and $\delta = 0$ (notation is different in equation)						
14	Adhesion, a	0 psf		A_m	0.000 g's		$A_m = (1.45-k_h)*k_h$ for $k_h < 0.45$	Direction of Force		Moment Arms (about toe, horz. component)			
15	Unit Weight Above GWT, $\gamma_{m,mse}$	135 pcf		F_{T1}	12460 lbs/ft		$F_{T1} = 1/2*K_a*(h-H_w)^2*\gamma_{m,r}$	Parallel to β'	y_{T1}	8.09 feet		$H_w+(h-H_w)/3$	
16	Unit Weight Below GWT, $\gamma_{sat,mse}$	135 pcf		F_{T2}	0 lbs/ft		$F_{T2} = K_a*(h-H_w)*H_w*\gamma_{m,r}$	Parallel to β'	y_{T2}	0.00 feet		$H_w/2$	
17	Retained			F_{T3}	0 lbs/ft		$F_{T3} = 1/2*K_a*H_w^2*(\gamma_{sat,r}-62.4)$	Parallel to β'	y_{T3}	0.00 feet		$H_w/3$	
18	Friction Angle, ϕ_r	0.524 rad		F_q	2140 lbs/ft		$F_q = K_a*h*q_r$	Parallel to β'	y_q	12.13 feet		$h/2$	
19	Unit Weight Above GWT, $\gamma_{m,r}$	120 pcf		P_{ir}	0 lbs/ft		$P_{ir} = 0.5*A_m*\gamma_{m,mse}*H_2*H$	Horizontal	y_{ir}	11.00 feet		$H/2$	
20	Unit Weight Below GWT, $\gamma_{sat,r}$	120 pcf		P_{is1} (triangular)	0 lbs/ft		$P_{is} = A_m*\gamma_{m,r}*Area_{is}$	Horizontal	y_{is1}	22.44 feet		$H+(H_2-H)/3$	
21	Surcharge/Seismic			P_{is2} (broken slope)	0 lbs/ft			Horizontal	y_{is2}	22.67 feet		$H+(H_2-H)/2$	
22	Retained Soil Surcharge, q_r	250 psf		$0.5P_{AE}$	0 lbs/ft		$0.5P_{AE} = 0.5*\Delta K_{ae}*\gamma_{m,r}*H_2^2$	Parallel to β'	y_{AE}	14.00 feet		$0.6H_2$	
23	MSE Surcharge, q_{mse}	250 psf		F_{HORZ}	0 lbs/ft		<- Factored		M_{HORZ}	0 ft-lb/ft		<- Factored	
24	k_h	0 g's		F_{βx}	22023 lbs/ft		<- Factored		M_{β+}	193016 ft-lb/ft		<- Factored	
25	theta	0		F_{βy}	4281 lbs/ft		<- Factored		M_{β-}	84764 ft-lb/ft		<- Factored	
26	Passive			PASSIVE FORCES (HORIZONTAL)									
27	Height of Passive, H_p	0 ft		10.8	1.00		$K_p = \tan^2(45+\phi/2)$			Moment Arms (about toe)			
28	Friction Angle, ϕ_p	0 rad		F_{P1}	0 lbs/ft		$F_{P1} = 1/2*K_p*(H_p-H_w)^2*\gamma_{m,p}$		y_{P1}	0.00 feet		$H_w+(H_p-H_w)/3$	
29	Unit Weight Above GWT, $\gamma_{m,p}$	0 pcf		F_{P2}	0 lbs/ft		$F_{P2} = K_p*(H_p-H_w)*H_w*\gamma_{m,p}$		y_{P2}	0.00 feet		$H_w/2$	
30	Unit Weight Below GWT, $\gamma_{sat,p}$	0 pcf		F_{P3}	0 lbs/ft		$F_{P3} = 1/2*K_p*H_w^2*(\gamma_{sat,p}-62.4)$		y_{P3}	0.00 feet		$H_w/3$	
31	Ignore Passive Resistance?	Yes		F_{PASSIVE}	0 lbs/ft				M_{PASSIVE}	0 ft-lb/ft			
32	Ignore Vertical from Inclined?	No											
33													
34	Eccentricity, e	1.48 ft		$e = (J23+J24-J25/2-E4*(J4-B4/2)-E5*(J5-B4/2))/(E8+E25)$						$e = \frac{\sum M_{DRIVING}}{\sum F_{VERT}}$			
35				(Ignores passive resistance but includes vertical shear due to inclined backfill.)									
36	NOTE:												
37	*** TABLE 840.04-1 of ODOT Supplemental Specification 840 (Mechanically Stabilized Earth Wall) specifies 120 pcf as the design unit weight for MSE wall backfill. This value was used for												
38	sliding resistance analyses but a value of 135 pcf (corresponding to Select Granular Backfill) was assumed in Bearing Resistance calculation.												

	A	B	C	D	E	F	G	H	I	J	K			
1	CALC. H: WALL C1 AT STA. 12+70 SEISMIC EXTERNAL STABILITY													
2	ENTER PARAMETERS IN YELLOW CELLS. SEE DIAGRAM TAB FOR CLARIFICATION.													
3	References: AASHTO 2010 LRFD Bridge Manual			for seismic loads, LRFD calcs										
4	NAVFAC DM 7.2 (1986)			for friction properties										
5	Das (1999)			for earth pressures										
6				B/H =		0.9								
7	Retained Soil Properties					Geometry								
8	Retained Friction Angle, ϕ_r		30	degrees	Height, H		42	feet	(above top of leveling pad)					
9	Unit Weight Above GWT, $\gamma_{m,r}$		120	pcf	Width, B		39.6	feet						
10	Unit Weight Below GWT, $\gamma_{sat,r}$		120	pcf	Height of GWT, H_w		0	feet	(0 means below the wall bottom)					
11	Ignore Vertical Component of Inclined Loads for Sliding/Overturning?		No		Backslope Angle, β		0	degrees						
12					Distance to Slope Break, X		0	feet	(0 if no slope break)					
13	Ka override (blank for auto-calc using Das, 1999 eqn.)			(autocalc)	Backslope Height, Δy		0.0	feet						
14	MSE Properties				Effective Backslope Angle, β'									
15	Continuous Reinforcement Friction Factor, μ		0.36	(sheets, grids)	Surcharge/Seismic Loads									
16	Discontinuous Reinforcement Friction Factor, μ		0.58	(strips)	Retained Soil Surcharge, q_r		0	psf	(all surcharges ignored for seismic. Surcharge above MSE ignored for sliding/overturning)					
17	Adhesion, a		0	psf	MSE Surcharge, q_{mse}		0	psf						
18	SLIDING Calc: Unit Weight Above GWT, $\gamma_{m,mse}$		120	pcf			k_h	0.029	g's					
19	SLIDING Calc: Unit Weight Below GWT, $\gamma_{sat,mse}$		120	pcf			ΔK_{ae}	0.02	g's					
20	BEARING Calc: Unit Weight Above GWT, $\gamma_{m,mse}$		135	pcf			ΔK_{ae} override	0.017	(blank for autocalc)					
21	BEARING Calc: Unit Weight Below GWT, $\gamma_{sat,mse}$		135	pcf										
22														
23	Subgrade/Bearing Properties				Passive Resistance				RESISTANCE FACTORS		LOAD FACTORS			
24	Subgrade Friction Angle, ϕ_s			degrees	Ignore Passive Resistance?		Yes		Resistance		RF	Load	Symbol	LF
25	Subgrade Cohesion, c			psf	Height of Passive, H_p			feet	Sliding (MSE)		1.0	Earth (Horizontal)	γ_{EH}	1.5
26	Foundation Depth, D			feet	Passive Friction Angle, ϕ_p			degrees	Passive (MSE)		0.75	Earth (Vertical)	γ_{EV}	1.35
27	Nominal Bearing Resistance, q_n for B = 39.6 feet		25.0	ksf	Unit Weight Above GWT, $\gamma_{m,p}$			pcf	Bearing (MSE) (Static)		0.65	Live Surcharge	γ_{LS}	1.75
28	Unit Weight Above GWT, $\gamma_{m,s}$			pcf	Unit Weight Below GWT, $\gamma_{sat,p}$			pcf	Bearing (MSE) (Seismic)		1.0	Earthquake	γ_{EQ}	1
29	Unit Weight Below GWT, $\gamma_{sat,s}$			pcf										
30														
31	AASHTO LRFD:													
32														
33	FAILURE BY SLIDING		LOAD SIDE		RESISTANCE SIDE			LRFD CHECK						
34		L (lbs/ft)	LF	L*LF (lbs/ft)	R (lbs/ft)	RF	R*RF (lbs/ft)	R*RF > L*LF ?						
35	LOAD													
36	Earth (L_{EH})	35247	1.5	52871						$L_{EH} = ('SL\&OT\ LOADS'\!E15 + 'SL\&OT\ LOADS'\!E16 + 'SL\&OT\ LOADS'\!E17) * \cos('SL\&OT\ LOADS'\!B8)$				
37	Surcharge (L_{LS})	0	1.75	0						$L_{LS} = ('SL\&OT\ LOADS'\!E18) * \cos('SL\&OT\ LOADS'\!B8)$				
38	Earthquake (L_{EQ})	6138	1	6138						$L_{EQ} = 'SL\&OT\ LOADS'\!E19 + 'SL\&OT\ LOADS'\!E20 + 'SL\&OT\ LOADS'\!E21 + 'SL\&OT\ LOADS'\!E22 * \cos('SL\&OT\ LOADS'\!B8)$				
39	RESISTANCE													
40	Base Friction (continuous reinforcement)				71850	1	71850			$R_{friction} = ('SL\&OT\ LOADS'\!E3 + 'SL\&OT\ LOADS'\!E4 + 'SL\&OT\ LOADS'\!E5 + (D36 + D37) * \tan('SL\&OT\ LOADS'\!B8) + 'SL\&OT\ LOADS'\!E22 * \sin('SL\&OT\ LOADS'\!B8)) * D15$				
41	Passive				0	0.75	0			$R_{passive} = \text{IF}(I24 = "YES", 0, 'SL\&OT\ LOADS'\!E31)$				
42	SUM			59009			71850	YES						
43	RESISTANCE													
44	Base Friction (DIScontinuous reinforcement)				115759	1	115759			$R_{friction} = ('SL\&OT\ LOADS'\!E3 + 'SL\&OT\ LOADS'\!E4 + 'SL\&OT\ LOADS'\!E5 + (D36 + D37) * \tan('SL\&OT\ LOADS'\!B8) + 'SL\&OT\ LOADS'\!E22 * \sin('SL\&OT\ LOADS'\!B8)) * D16$				
45	Passive				0	0.75	0			$R_{passive} = \text{IF}(I24 = "YES", 0, 'SL\&OT\ LOADS'\!E31)$				
46	SUM			59009			115759	YES						
47														
48	FAILURE BY BEARING		LOAD SIDE		RESISTANCE SIDE			LRFD CHECK						
49		L (lbs/ft)	LF	L*LF (lbs/ft)	$q_{FACTORED}$ (psf)	$= \sum L * LF / (B - 2e)$								
50	LOAD													
51	Earth (L_{EV})	224532	1.35	303118						$L_{EV} = \sin('BEARING\ LOADS'\!B8) * ('BEARING\ LOADS'\!E15 + 'BEARING\ LOADS'\!E16 + 'BEARING\ LOADS'\!E17) + 'BEARING\ LOADS'\!E3 + 'BEARING\ LOADS'\!E4 + 'BEARING\ LOADS'\!E5 + 'BEARING\ LOADS'\!E6$				
52	Surcharge (L_{LS})	0	1.75	0						$L_{LS} = \sin('BEARING\ LOADS'\!B8) * ('BEARING\ LOADS'\!E18) + 'BEARING\ LOADS'\!E7$				
53	Earthquake (L_{EQ})	0	1	0						$L_{EQ} = 'BEARING\ LOADS'\!E22 * \sin('BEARING\ LOADS'\!B8)$				
54	SUM			303118	8984					$q_{factored} = D54 / (I9 - 2 * 'BEARING\ LOADS'\!B34)$				
55	RESISTANCE SIDE				RESISTANCE SIDE			FAILURE BY OVERTURNING						
56	Nominal Bearing Resistance, q_n for B = 39.6 feet		25000		psf									
57	Factored Bearing Resistance = $q_n * RF =$		25000		psf									
58	R*RF > $\sum L * LF / (B - 2e)$?		YES											
59														

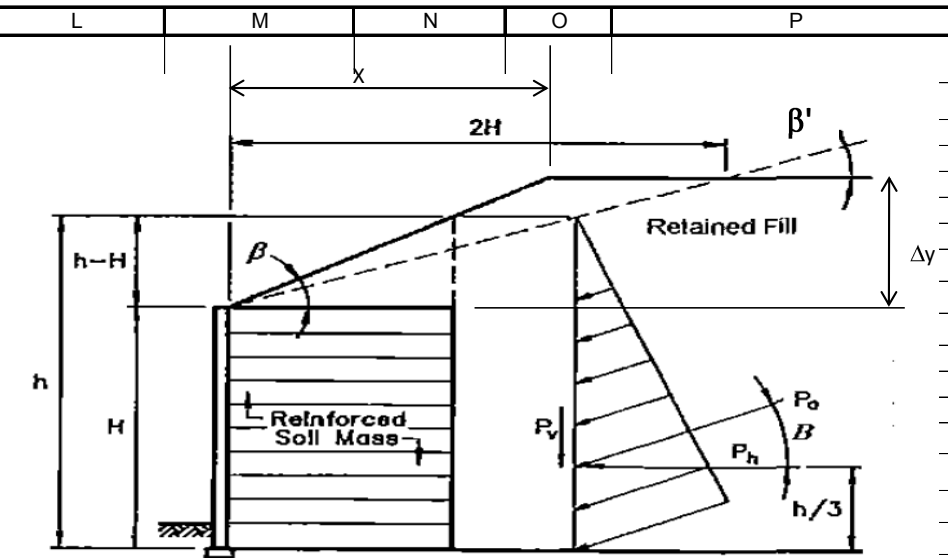


Figure 3.11.5.8.1-3—Earth Pressure Distribution for MSE Wall with Broken Back Backfill Surface

	A	B	C	D	E	F	G	H	I	J	K	L
2	Geometry			VERTICAL FORCES (not counting vertical components of driving forces)							Moment Arms (about toe)	
3	Height, H	42 ft		$W_m (\beta=0)$	199584 lbs/ft		$W_m = B*(H-H_w)*\gamma_{m,mse}$		x_m	19.80 feet		B/2
4	Width, B	39.6 ft		$W_{\beta1}$ (triangular part)	0 lbs/ft		$W_{\beta1} = 1/2*\min(x,B)*(h-H)*\gamma_{m,r}$		$x_{\beta1}$	26.40 feet		2/3*min(B,x)
5	Height of GWT, H_w	0 ft		$W_{\beta2}$ (broken slope)	0 lbs/ft		$W_{\beta2} = (B-x)*(h-H)*\gamma_{m,r}$		$x_{\beta2}$	69.80 feet		$x+(B-x)/2$
6	Height of Retained Fill, h	42 ft		W_{sat}'	0 lbs/ft		$W_{sat}' = B*H_w(\gamma_{sat,mse}-62.4)$		x_{sat}	19.80 feet		B/2
7	$h = H+B*\tan(\beta)$ $\beta=$	0 rad		W_q	0 lbs/ft		$W_q = 0$ for sliding and overturning		x_q	19.80 feet		B/2
8	Effective Backslope Angle, β'	0 rad		W_{TOTAL}	199584 lbs/ft		<- Factored			3951763 ft-lb/ft		
9	Seismic Effective Height, H_2	42 ft										
10	$H_2 = H+0.5*H*\tan(\beta)/[1-0.5\tan(\beta)]$											
11	Broken slope width, x	100 ft		DRIVING FORCES								
12	MSE***			K_a	0.333		From AASHTO Eqs 3.11.5.3-1 and 2 for $\theta = 90$ and $\delta = 0$					
13	Friction Factor, μ	0.36		ΔK_{ae}	0.017		From AASHTO Eq A11.1.1.1-2 for β and $\delta = 0$ (notation is different in equation)					
14	Adhesion, a	0 psf		A_m	0.041 g's		$A_m = (1.45-k_h)*k_h$ for $k_h < 0.45$	Direction of Force		Moment Arms (about toe, horz. component)		
15	Unit Weight Above GWT, $\gamma_{m,mse}$	120 pcf		F_{T1}	35247 lbs/ft		$F_{T1} = 1/2*K_a*(h-H_w)^2*\gamma_{m,r}$	Parallel to β'	y_{T1}	14.00 feet		$H_w+(h-H_w)/3$
16	Unit Weight Below GWT, $\gamma_{sat,mse}$	120 pcf		F_{T2}	0 lbs/ft		$F_{T2} = K_a*(h-H_w)*H_w*\gamma_{m,r}$	Parallel to β'	y_{T2}	0.00 feet		$H_w/2$
17	Retained			F_{T3}	0 lbs/ft		$F_{T3} = 1/2*K_a*H_w^2*(\gamma_{sat,r}-62.4)$	Parallel to β'	y_{T3}	0.00 feet		$H_w/3$
18	Friction Angle, ϕ_r	0.524 rad		F_q	0 lbs/ft		$F_q = K_a*h*q_r$	Parallel to β'	y_q	21.00 feet		$h/2$
19	Unit Weight Above GWT, $\gamma_{m,r}$	120 pcf		P_{ir}	4339 lbs/ft		$P_{ir} = 0.5*A_m*\gamma_{m,mse}*H_2*H$	Horizontal	y_{ir}	21.00 feet		$H/2$
20	Unit Weight Below GWT, $\gamma_{sat,r}$	120 pcf		P_{is1} (triangular)	0 lbs/ft		$P_{is} = A_m*\gamma_{m,r}*Area_{is}$	Horizontal	y_{is1}	42.00 feet		$H+(H_2-H)/3$
21	Surcharge/Seismic			P_{is2} (broken slope)	0 lbs/ft			Horizontal	y_{is2}	42.00 feet		$H+(H_2-H)/2$
22	Retained Soil Surcharge, q_r	0 psf		$0.5P_{AE}$	1799 lbs/ft		$0.5P_{AE} = 0.5*\Delta K_{ae}*\gamma_{m,r}*H_2^2$	Parallel to β'	y_{AE}	25.20 feet		$0.6H_2$
23	MSE Surcharge, q_{mse}	0 psf		F_{HORIZ}	4339 lbs/ft		<-Factored		M_{HORIZ}	91119 ft-lb/ft		<-Factored
24	k_h	0.029 g's		$F_{\beta x}$	54670 lbs/ft		<-Factored		$M_{\beta+}$	785522 ft-lb/ft		<-Factored
25	theta	0.029		$F_{\beta y}$	0 lbs/ft		<-Factored		$M_{\beta-}$	0 ft-lb/ft		<-Factored
26	Passive			PASSIVE FORCES (HORIZONTAL)								
27	Height of Passive, H_p	0 ft		K_p	1.00		$K_p = \tan^2(45+\phi/2)$			Moment Arms (about toe)		
28	Friction Angle, ϕ_p	0 rad		F_{P1}	0 lbs/ft		$F_{P1} = 1/2*K_p*(H_p-H_w)^2*\gamma_{m,p}$		y_{P1}	0.00 feet		$H_w+(H_p-H_w)/3$
29	Unit Weight Above GWT, $\gamma_{m,p}$	0 pcf		F_{P2}	0 lbs/ft		$F_{P2} = K_p*(H_p-H_w)*H_w*\gamma_{m,p}$		y_{P2}	0.00 feet		$H_w/2$
30	Unit Weight Below GWT, $\gamma_{sat,p}$	0 pcf		F_{P3}	0 lbs/ft		$F_{P3} = 1/2*K_p*H_w^2*(\gamma_{sat,p}-62.4)$		y_{P3}	0.00 feet		$H_w/3$
31	Ignore Passive Resistance?	Yes		$F_{PASSIVE}$	0 lbs/ft				$M_{PASSIVE}$	0 ft-lb/ft		
32	Ignore Vertical from Inclined?	No										
33												
34	Eccentricity, e	4.39 ft		$e = (J23+J24-J25/2-E4*(J4-B4/2)-E5*(J5-B4/2))/(E8+E25)$						$e = \frac{\sum M_{DRIVING}}{\sum F_{VERT}}$		
35				(Ignores passive resistance but includes vertical shear due to inclined backfill.)								
36	NOTE:											
37	*** TABLE 840.04-1 of ODOT Supplemental Specification 840 (Mechanically Stabilized Earth Wall) specifies 120 pcf as the design unit weight for MSE wall backfill. This value was used for											
38	sliding resistance analyses but a value of 135 pcf (corresponding to Select Granular Backfill) was assumed in Bearing Resistance calculation.											

	A	B	C	D	E	F	G	H	I	J	K	L	
2	Geometry			VERTICAL FORCES (not counting vertical components of driving forces)							Moment Arms (about toe)		
3	Height, H	42 ft		$W_m (\beta=0)$	224532 lbs/ft		$W_m = B*(H-H_w)*\gamma_{m,mse}$		x_m	19.80 feet		B/2	
4	Width, B	39.6 ft		$W_{\beta1}$ (triangular part)	0 lbs/ft		$W_{\beta1} = 1/2*\min(x,B)*(h-H)*\gamma_{m,r}$		$x_{\beta1}$	26.40 feet		$2/3*\min(B,x)$	
5	Height of GWT, H_w	0 ft		$W_{\beta2}$ (broken slope)	0 lbs/ft		$W_{\beta2} = (B-x)*(h-H)*\gamma_{m,r}$		$x_{\beta2}$	69.80 feet		$x+(B-x)/2$	
6	Height of Retained Fill, h	42 ft		W_{sat}'	0 lbs/ft		$W_{sat}' = B*H_w(\gamma_{sat,mse}-62.4)$		x_{sat}	19.80 feet		B/2	
7	$h = H+B*\tan(\beta)$ $\beta=$	0 rad		W_q	0 lbs/ft		$W_q = B*q_{mse}$		x_q	19.80 feet		B/2	
8	Effective Backslope Angle, β'	0 rad		W_{TOTAL}	303118 lbs/ft		<- Factored			6001740 ft-lb/ft			
9	Seismic Effective Height, H_2	42 ft											
10	$H_2 = H+0.5*H*\tan(\beta)/[1-0.5\tan(\beta)]$												
11	Broken slope width, x	100 ft		DRIVING FORCES									
12	MSE***			K_a	0.333		From AASHTO Eqs 3.11.5.3-1 and 2 for $\theta = 90$ and $\delta = 0$						
13	Friction Factor, μ	0.36		ΔK_{ae}	0.017		From AASHTO Eq A11.1.1.1-2 for β and $\delta = 0$ (notation is different in equation)						
14	Adhesion, a	0 psf		A_m	0.041 g's		$A_m = (1.45-k_h)*k_h$ for $k_h < 0.45$	Direction of Force	Moment Arms (about toe, horz. component)				
15	Unit Weight Above GWT, $\gamma_{m,mse}$	135 pcf		F_{T1}	35247 lbs/ft		$F_{T1} = 1/2*K_a*(h-H_w)^2*\gamma_{m,r}$	Parallel to β'	y_{T1}	14.00 feet		$H_w+(h-H_w)/3$	
16	Unit Weight Below GWT, $\gamma_{sat,mse}$	135 pcf		F_{T2}	0 lbs/ft		$F_{T2} = K_a*(h-H_w)*H_w*\gamma_{m,r}$	Parallel to β'	y_{T2}	0.00 feet		$H_w/2$	
17	Retained			F_{T3}	0 lbs/ft		$F_{T3} = 1/2*K_a*H_w^2*(\gamma_{sat,r}-62.4)$	Parallel to β'	y_{T3}	0.00 feet		$H_w/3$	
18	Friction Angle, ϕ_r	0.524 rad		F_q	0 lbs/ft		$F_q = K_a*h*q_r$	Parallel to β'	y_q	21.00 feet		$h/2$	
19	Unit Weight Above GWT, $\gamma_{m,r}$	120 pcf		P_{ir}	4882 lbs/ft		$P_{ir} = 0.5*A_m*\gamma_{m,mse}*H_2*H$	Horizontal	y_{ir}	21.00 feet		$H/2$	
20	Unit Weight Below GWT, $\gamma_{sat,r}$	120 pcf		P_{is1} (triangular)	0 lbs/ft		$P_{is} = A_m*\gamma_{m,r}*Area_{is}$	Horizontal	y_{is1}	42.00 feet		$H+(H_2-H)/3$	
21	Surcharge/Seismic			P_{is2} (broken slope)	0 lbs/ft			Horizontal	y_{is2}	42.00 feet		$H+(H_2-H)/2$	
22	Retained Soil Surcharge, q_r	0 psf		$0.5P_{AE}$	1799 lbs/ft		$0.5P_{AE} = 0.5*\Delta K_{ae}*\gamma_{m,r}*H_2^2$	Parallel to β'	y_{AE}	25.20 feet		$0.6H_2$	
23	MSE Surcharge, q_{mse}	0 psf		F_{HORZ}	4882 lbs/ft		<- Factored		M_{HORZ}	102522 ft-lb/ft		<- Factored	
24	k_h	0.029 g's		F_{βx}	54670 lbs/ft		<- Factored		M_{β+}	785522 ft-lb/ft		<- Factored	
25	theta	0.029		F_{βy}	0 lbs/ft		<- Factored		M_{β-}	0 ft-lb/ft		<- Factored	
26	Passive			PASSIVE FORCES (HORIZONTAL)									
27	Height of Passive, H_p	0 ft		K_p	1.00		$K_p = \tan^2(45+\phi/2)$			Moment Arms (about toe)			
28	Friction Angle, ϕ_p	0 rad		F_{P1}	0 lbs/ft		$F_{P1} = 1/2*K_p*(H_p-H_w)^2*\gamma_{m,p}$		y_{P1}	0.00 feet		$H_w+(H_p-H_w)/3$	
29	Unit Weight Above GWT, $\gamma_{m,p}$	0 pcf		F_{P2}	0 lbs/ft		$F_{P2} = K_p*(H_p-H_w)*H_w*\gamma_{m,p}$		y_{P2}	0.00 feet		$H_w/2$	
30	Unit Weight Below GWT, $\gamma_{sat,p}$	0 pcf		F_{P3}	0 lbs/ft		$F_{P3} = 1/2*K_p*H_w^2*(\gamma_{sat,p}-62.4)$		y_{P3}	0.00 feet		$H_w/3$	
31	Ignore Passive Resistance?	Yes		F_{PASSIVE}	0 lbs/ft				M_{PASSIVE}	0 ft-lb/ft			
32	Ignore Vertical from Inclined?	No											
33													
34	Eccentricity, e	2.93 ft		$e = (J23+J24-J25/2-E4*(J4-B4/2)-E5*(J5-B4/2))/(E8+E25)$						$e = \frac{\sum M_{DRIVING}}{\sum F_{VERT}}$			
35				(Ignores passive resistance but includes vertical shear due to inclined backfill.)									
36	NOTE:												
37	*** TABLE 840.04-1 of ODOT Supplemental Specification 840 (Mechanically Stabilized Earth Wall) specifies 120 pcf as the design unit weight for MSE wall backfill. This value was used for												
38	sliding resistance analyses but a value of 135 pcf (corresponding to Select Granular Backfill) was assumed in Bearing Resistance calculation.												

CALC. G: WALL C1 AT WALL STA. 13+90 STATIC EXTERNAL STABILITY												
ENTER PARAMETERS IN YELLOW CELLS. SEE DIAGRAM TAB FOR CLARIFICATION.												
References: AASHTO 2010 LRFD Bridge Manual for seismic loads, LRFD calcs												
NAVFAC DM 7.2 (1986) for friction properties												
Das (1999) for earth pressures												
B/H = 1.0												
Retained Soil Properties						Geometry						
Retained Friction Angle, ϕ_r			30	degrees		Height, H			25	feet (above top of leveling pad)		
Unit Weight Above GWT, $\gamma_{m,r}$			120	pcf		Width, B			25.3	feet		
Unit Weight Below GWT, $\gamma_{sat,r}$			120	pcf		Height of GWT, H_w			0	feet (0 means below the wall bottom)		
Ignore Vertical Component of Inclined Loads for Sliding/Overturning?			No			Backslope Angle, β			6.5	degrees		
Distance to Slope Break, X			100	feet		(0 if no slope break)						
Backslope Height, Δy			11.4	feet								
Effective Backslope Angle, β'			11.0	degrees		(0 if $x < B$)						
MSE Properties						Surcharge/Seismic Loads						
Continuous Reinforcement Friction Factor, μ			0.36	(sheets, grids)		Retained Soil Surcharge, q_r			250	psf (all surcharges ignored for seismic. Surcharge above MSE ignored for sliding/overturning)		
Discontinuous Reinforcement Friction Factor, μ			0.58	(strips)		MSE Surcharge, q_{mse}			250	psf		
Adhesion, a			0	psf								
SLIDING Calc: Unit Weight Above GWT, $\gamma_{m,mse}$			120	pcf								
SLIDING Calc: Unit Weight Below GWT, $\gamma_{sat,mse}$			120	pcf								
BEARING Calc: Unit Weight Above GWT, $\gamma_{m,mse}$			135	pcf								
BEARING Calc: Unit Weight Below GWT, $\gamma_{sat,mse}$			135	pcf								
Subgrade/Bearing Properties						Passive Resistance						
Subgrade Friction Angle, ϕ_s				degrees		Ignore Passive Resistance?			Yes			
Subgrade Cohesion, c				psf		Height of Passive, H_p				feet		
Foundation Depth, D				feet		Passive Friction Angle, ϕ_p				degrees		
Nominal Bearing Resistance, q_n for B = 25.3 feet			19.0	ksf		Unit Weight Above GWT, $\gamma_{m,p}$				pcf		
Unit Weight Above GWT, $\gamma_{m,s}$				pcf		Unit Weight Below GWT, $\gamma_{sat,p}$				pcf		
Unit Weight Below GWT, $\gamma_{sat,s}$				pcf								
AASHTO LRFD:												
FAILURE BY SLIDING												
		LOAD SIDE			RESISTANCE SIDE			LRFD CHECK				
		L (lbs/ft)	LF	L*LF (lbs/ft)	R (lbs/ft)	RF	R*RF (lbs/ft)	R*RF > L*LF ?				
LOAD												
Earth (L_{EH})		16154	1.5	24230						$L_{EH} = (SL\&OT\ LOADS\!E15 + SL\&OT\ LOADS\!E16 + SL\&OT\ LOADS\!E17) * \cos(SL\&OT\ LOADS\!B8)$		
Surcharge (L_{LS})		2414	1.75	4224						$L_{LS} = (SL\&OT\ LOADS\!E18) * \cos(SL\&OT\ LOADS\!B8)$		
Earthquake (L_{EQ})		0	1	0						$L_{EQ} = (SL\&OT\ LOADS\!E19 + SL\&OT\ LOADS\!E20 + SL\&OT\ LOADS\!E21 + SL\&OT\ LOADS\!E22) * \cos(SL\&OT\ LOADS\!B8)$		
RESISTANCE												
Base Friction (continuous reinforcement)					30889	1	30889			$R_{friction} = (SL\&OT\ LOADS\!E3 + SL\&OT\ LOADS\!E4 + SL\&OT\ LOADS\!E5 + (D36 + D37) * \tan(SL\&OT\ LOADS\!B8) + SL\&OT\ LOADS\!E22 * \sin(SL\&OT\ LOADS\!B8)) * D15$		
Passive					0	0.75	0			$R_{passive} = IF(I24 = "YES", 0, SL\&OT\ LOADS\!E31)$		
SUM		28455			30889			YES				
RESISTANCE												
Base Friction (DIScontinuous reinforcement)					49766	1	49766			$R_{friction} = (SL\&OT\ LOADS\!E3 + SL\&OT\ LOADS\!E4 + SL\&OT\ LOADS\!E5 + (D36 + D37) * \tan(SL\&OT\ LOADS\!B8) + SL\&OT\ LOADS\!E22 * \sin(SL\&OT\ LOADS\!B8)) * D16$		
Passive					0	0.75	0			$R_{passive} = IF(I24 = "YES", 0, SL\&OT\ LOADS\!E31)$		
SUM		28455			49766			YES				
FAILURE BY BEARING												
		LOAD SIDE			RESISTANCE SIDE							
		L (lbs/ft)	LF	L*LF (lbs/ft)	$q_{FACTORED}$ (psf)	$= \sum L * LF / (B - 2e)$						
LOAD												
Earth (L_{EV})		92900	1.35	125415						$L_{EV} = \sin(BEARING\ LOADS\!B8) * (BEARING\ LOADS\!E15 + BEARING\ LOADS\!E16 + BEARING\ LOADS\!E17) + BEARING\ LOADS\!E3 + BEARING\ LOADS\!E4 + BEARING\ LOADS\!E5 + BEARING\ LOADS\!E6$		
Surcharge (L_{LS})		6794	1.75	11890						$L_{LS} = \sin(BEARING\ LOADS\!B8) * (BEARING\ LOADS\!E18) + BEARING\ LOADS\!E7$		
Earthquake (L_{EQ})		0	1	0						$L_{EQ} = BEARING\ LOADS\!E22 * \sin(BEARING\ LOADS\!B8)$		
SUM		137305			6113					$q_{factored} = D54 / (I9 - 2 * BEARING\ LOADS\!B34)$		
RESISTANCE SIDE												
Nominal Bearing Resistance, q_n for B = 25.3 feet			19000	psf								
Factored Bearing Resistance = $q_n * RF$			12350	psf		=IF(I18=0,E56*L27,E56*L28)						
R*RF > $\sum L * LF / (B - 2e)$?			YES		=IF(E57>E54,"YES","NO")							
FAILURE BY OVERTURNING												
		Parameter	Value	Note								
		e	2.28	ft from center of base reinforcement layer								
		1/4 B	6.33	ft from center of base reinforcement layer								
		$e \leq 1/4 B$?	YES		See Sections 11.10.5.5 and 11.6.3.3 in AASHTO 2010							

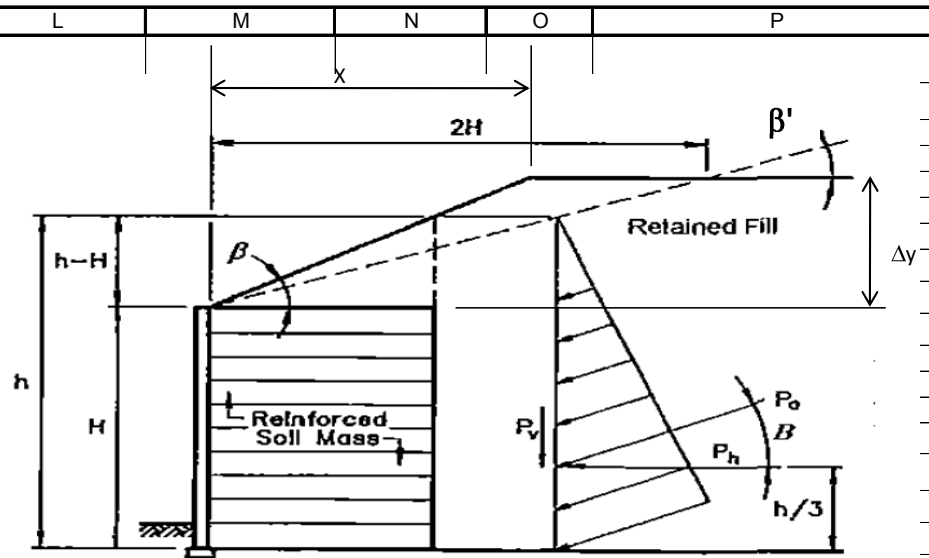


Figure 3.11.5.8.1-3—Earth Pressure Distribution for MSE Wall with Broken Back Backfill Surface

	A	B	C	D	E	F	G	H	I	J	K	L	
2	Geometry			VERTICAL FORCES (not counting vertical components of driving forces)							Moment Arms (about toe)		
3	Height, H	25 ft		$W_m (\beta=0)$	75900 lbs/ft		$W_m = B*(H-H_w)*\gamma_{m,mse}$		x_m	12.65 feet		B/2	
4	Width, B	25.3 ft		$W_{\beta 1}$ (triangular part)	4372 lbs/ft		$W_{\beta 1} = 1/2*\min(x,B)*(h-H)*\gamma_{m,r}$		$x_{\beta 1}$	16.87 feet		2/3*min(B,x)	
5	Height of GWT, H_w	0 ft		$W_{\beta 2}$ (broken slope)	0 lbs/ft		$W_{\beta 2} = (B-x)*(h-H)*\gamma_{m,r}$		$x_{\beta 2}$	62.65 feet		$x+(B-x)/2$	
6	Height of Retained Fill, h	27.88 ft		W_{sat}'	0 lbs/ft		$W_{sat}' = B*H_w(\gamma_{sat,mse}-62.4)$		x_{sat}	12.65 feet		B/2	
7	$h = H+B*\tan(\beta)$ $\beta=$	0.113 rad		W_q	0 lbs/ft		$W_q = 0$ for sliding and overturning		x_q	12.65 feet		B/2	
8	Effective Backslope Angle, β'	0.192 rad		W_{TOTAL}	80272 lbs/ft		<- Factored			1033891 ft-lb/ft			
9	Seismic Effective Height, H_2	26.51 ft							11.6				
10	$H_2 = H+0.5*H*\tan(\beta)/[1-0.5\tan(\beta)]$												
11	Broken slope width, x	100 ft		DRIVING FORCES									
12	MSE***			K_a	0.353		From AASHTO Eqs 3.11.5.3-1 and 2 for $\theta = 90$ and $\delta = 0$						
13	Friction Factor, μ	0.36		ΔK_{ae}	0.000		From AASHTO Eq A11.1.1.1-2 for β and $\delta = 0$ (notation is different in equation)						
14	Adhesion, a	0 psf		A_m	0.000 g's		$A_m = (1.45-k_h)*k_h$ for $k_h < 0.45$	Direction of Force		Moment Arms (about toe, horz. component)			
15	Unit Weight Above GWT, $\gamma_{m,mse}$	120 pcf		F_{T1}	16456 lbs/ft		$F_{T1} = 1/2*K_a*(h-H_w)^2*\gamma_{m,r}$	Parallel to β'	y_{T1}	9.29 feet		$H_w+(h-H_w)/3$	
16	Unit Weight Below GWT, $\gamma_{sat,mse}$	120 pcf		F_{T2}	0 lbs/ft		$F_{T2} = K_a*(h-H_w)*H_w*\gamma_{m,r}$	Parallel to β'	y_{T2}	0.00 feet		$H_w/2$	
17	Retained			F_{T3}	0 lbs/ft		$F_{T3} = 1/2*K_a*H_w^2*(\gamma_{sat,r}-62.4)$	Parallel to β'	y_{T3}	0.00 feet		$H_w/3$	
18	Friction Angle, ϕ_r	0.524 rad		F_q	2459 lbs/ft		$F_q = K_a*h*q_r$	Parallel to β'	y_q	13.94 feet		$h/2$	
19	Unit Weight Above GWT, $\gamma_{m,r}$	120 pcf		P_{ir}	0 lbs/ft		$P_{ir} = 0.5*A_m*\gamma_{m,mse}*H_2*H$	Horizontal	y_{ir}	12.50 feet		$H/2$	
20	Unit Weight Below GWT, $\gamma_{sat,r}$	120 pcf		P_{is1} (triangular)	0 lbs/ft		$P_{is} = A_m*\gamma_{m,r}*Area_{is}$	Horizontal	y_{is1}	25.50 feet		$H+(H_2-H)/3$	
21	Surcharge/Seismic			P_{is2} (broken slope)	0 lbs/ft			Horizontal	y_{is2}	25.76 feet		$H+(H_2-H)/2$	
22	Retained Soil Surcharge, q_r	250 psf		$0.5P_{AE}$	0 lbs/ft		$0.5P_{AE} = 0.5*\Delta K_{ae}*\gamma_{m,r}*H_2^2$	Parallel to β'	y_{AE}	15.91 feet		$0.6H_2$	
23	MSE Surcharge, q_{mse}	250 psf		F_{HORZ}	0 lbs/ft		<-Factored		M_{HORZ}	0 ft-lb/ft		<-Factored	
24	k_h	0 g's		F_{βx}	28455 lbs/ft		<-Factored		M_{β+}	283986 ft-lb/ft		<-Factored	
25	theta	0		F_{βy}	5531 lbs/ft		<-Factored		M_{β-}	139934 ft-lb/ft		<-Factored	
26	Passive			PASSIVE FORCES (HORIZONTAL)									
27	Height of Passive, H_p	0 ft		10.8	1.00		$K_p = \tan^2(45+\phi/2)$			Moment Arms (about toe)			
28	Friction Angle, ϕ_p	0 rad		F_{P1}	0 lbs/ft		$F_{P1} = 1/2*K_p*(H_p-H_w)^2*\gamma_{m,p}$		y_{P1}	0.00 feet		$H_w+(H_p-H_w)/3$	
29	Unit Weight Above GWT, $\gamma_{m,p}$	0 pcf		F_{P2}	0 lbs/ft		$F_{P2} = K_p*(H_p-H_w)*H_w*\gamma_{m,p}$		y_{P2}	0.00 feet		$H_w/2$	
30	Unit Weight Below GWT, $\gamma_{sat,p}$	0 pcf		F_{P3}	0 lbs/ft		$F_{P3} = 1/2*K_p*H_w^2*(\gamma_{sat,p}-62.4)$		y_{P3}	0.00 feet		$H_w/3$	
31	Ignore Passive Resistance?	Yes		F_{PASSIVE}	0 lbs/ft				M_{PASSIVE}	0 ft-lb/ft			
32	Ignore Vertical from Inclined?	No											
33													
34	Eccentricity, e	2.28 ft		$e = (J23+J24-J25/2-E4*(J4-B4/2)-E5*(J5-B4/2))/(E8+E25)$						$e = \frac{\sum M_{DRIVING}}{\sum F_{VERT}}$			
35				(Ignores passive resistance but includes vertical shear due to inclined backfill.)									
36	NOTE:												
37	*** TABLE 840.04-1 of ODOT Supplemental Specification 840 (Mechanically Stabilized Earth Wall) specifies 120 pcf as the design unit weight for MSE wall backfill. This value was used for												
38	sliding resistance analyses but a value of 135 pcf (corresponding to Select Granular Backfill) was assumed in Bearing Resistance calculation.												

	A	B	C	D	E	F	G	H	I	J	K	L	
2	Geometry			VERTICAL FORCES (not counting vertical components of driving forces)							Moment Arms (about toe)		
3	Height, H	25 ft		$W_m (\beta=0)$	85388 lbs/ft		$W_m = B*(H-H_w)*\gamma_{m,mse}$		x_m	12.65 feet		B/2	
4	Width, B	25.3 ft		$W_{\beta1}$ (triangular part)	4372 lbs/ft		$W_{\beta1} = 1/2*\min(x,B)*(h-H)*\gamma_{m,r}$		$x_{\beta1}$	16.87 feet		$2/3*\min(B,x)$	
5	Height of GWT, H_w	0 ft		$W_{\beta2}$ (broken slope)	0 lbs/ft		$W_{\beta2} = (B-x)*(h-H)*\gamma_{m,r}$		$x_{\beta2}$	62.65 feet		$x+(B-x)/2$	
6	Height of Retained Fill, h	27.88 ft		W_{sat}'	0 lbs/ft		$W_{sat}' = B*H_w(\gamma_{sat,mse}-62.4)$		x_{sat}	12.65 feet		B/2	
7	$h = H+B*\tan(\beta)$ $\beta=$	0.113 rad		W_q	6325 lbs/ft		$W_q = B*q_{mse}$		x_q	12.65 feet		B/2	
8	Effective Backslope Angle, β'	0.192 rad		W_{TOTAL}	132245 lbs/ft		<- Factored			1697803 ft-lb/ft			
9	Seismic Effective Height, H_2	26.51 ft							11.6				
10	$H_2 = H+0.5*H*\tan(\beta)/[1-0.5\tan(\beta)]$												
11	Broken slope width, x	100 ft		DRIVING FORCES									
12	MSE***			K_a	0.353		From AASHTO Eqs 3.11.5.3-1 and 2 for $\theta = 90$ and $\delta = 0$						
13	Friction Factor, μ	0.36		ΔK_{ae}	0.000		From AASHTO Eq A11.1.1.1-2 for β and $\delta = 0$ (notation is different in equation)						
14	Adhesion, a	0 psf		A_m	0.000 g's		$A_m = (1.45-k_h)*k_h$ for $k_h < 0.45$	Direction of Force		Moment Arms (about toe, horz. component)			
15	Unit Weight Above GWT, $\gamma_{m,mse}$	135 pcf		F_{T1}	16456 lbs/ft		$F_{T1} = 1/2*K_a*(h-H_w)^2*\gamma_{m,r}$	Parallel to β'	y_{T1}	9.29 feet		$H_w+(h-H_w)/3$	
16	Unit Weight Below GWT, $\gamma_{sat,mse}$	135 pcf		F_{T2}	0 lbs/ft		$F_{T2} = K_a*(h-H_w)*H_w*\gamma_{m,r}$	Parallel to β'	y_{T2}	0.00 feet		$H_w/2$	
17	Retained			F_{T3}	0 lbs/ft		$F_{T3} = 1/2*K_a*H_w^2*(\gamma_{sat,r}-62.4)$	Parallel to β'	y_{T3}	0.00 feet		$H_w/3$	
18	Friction Angle, ϕ_r	0.524 rad		F_q	2459 lbs/ft		$F_q = K_a*h*q_r$	Parallel to β'	y_q	13.94 feet		$h/2$	
19	Unit Weight Above GWT, $\gamma_{m,r}$	120 pcf		P_{ir}	0 lbs/ft		$P_{ir} = 0.5*A_m*\gamma_{m,mse}*H_2*H$	Horizontal	y_{ir}	12.50 feet		$H/2$	
20	Unit Weight Below GWT, $\gamma_{sat,r}$	120 pcf		P_{is1} (triangular)	0 lbs/ft		$P_{is} = A_m*\gamma_{m,r}*Area_{is}$	Horizontal	y_{is1}	25.50 feet		$H+(H_2-H)/3$	
21	Surcharge/Seismic			P_{is2} (broken slope)	0 lbs/ft			Horizontal	y_{is2}	25.76 feet		$H+(H_2-H)/2$	
22	Retained Soil Surcharge, q_r	250 psf		$0.5P_{AE}$	0 lbs/ft		$0.5P_{AE} = 0.5*\Delta K_{ae}*\gamma_{m,r}*H_2^2$	Parallel to β'	y_{AE}	15.91 feet		$0.6H_2$	
23	MSE Surcharge, q_{mse}	250 psf		F_{HORZ}	0 lbs/ft		<- Factored		M_{HORZ}	0 ft-lb/ft		<- Factored	
24	k_h	0 g's		F_{βx}	28455 lbs/ft		<- Factored		M_{β+}	283986 ft-lb/ft		<- Factored	
25	theta	0		F_{βy}	5531 lbs/ft		<- Factored		M_{β-}	139934 ft-lb/ft		<- Factored	
26	Passive			PASSIVE FORCES (HORIZONTAL)									
27	Height of Passive, H_p	0 ft		10.8	1.00		$K_p = \tan^2(45+\phi/2)$			Moment Arms (about toe)			
28	Friction Angle, ϕ_p	0 rad		F_{P1}	0 lbs/ft		$F_{P1} = 1/2*K_p*(H_p-H_w)^2*\gamma_{m,p}$		y_{P1}	0.00 feet		$H_w+(H_p-H_w)/3$	
29	Unit Weight Above GWT, $\gamma_{m,p}$	0 pcf		F_{P2}	0 lbs/ft		$F_{P2} = K_p*(H_p-H_w)*H_w*\gamma_{m,p}$		y_{P2}	0.00 feet		$H_w/2$	
30	Unit Weight Below GWT, $\gamma_{sat,p}$	0 pcf		F_{P3}	0 lbs/ft		$F_{P3} = 1/2*K_p*H_w^2*(\gamma_{sat,p}-62.4)$		y_{P3}	0.00 feet		$H_w/3$	
31	Ignore Passive Resistance?	Yes		F_{PASSIVE}	0 lbs/ft				M_{PASSIVE}	0 ft-lb/ft			
32	Ignore Vertical from Inclined?	No											
33													
34	Eccentricity, e	1.42 ft		$e = (J23+J24-J25/2-E4*(J4-B4/2)-E5*(J5-B4/2))/(E8+E25)$						$e = \frac{\sum M_{DRIVING}}{\sum F_{VERT}}$			
35				(Ignores passive resistance but includes vertical shear due to inclined backfill.)									
36	NOTE:												
37	*** TABLE 840.04-1 of ODOT Supplemental Specification 840 (Mechanically Stabilized Earth Wall) specifies 120 pcf as the design unit weight for MSE wall backfill. This value was used for												
38	sliding resistance analyses but a value of 135 pcf (corresponding to Select Granular Backfill) was assumed in Bearing Resistance calculation.												