


"Paul Fatica"
<faticap@ksassociates.com>
03/11/2011 02:54 PM

To <curtice.malone@dot.state.oh.us>
cc <kfertal@hntb.com>, <mhedrick@walshgroup.com>,
<thomas.hyland@dot.state.oh.us>,
<ornette.gibson@dot.state.oh.us>,
bcc

Subject CIB - Utilities - AT&T West 3rd Relocation

History:  This message has been replied to.

Curt,

Attached are the limits that AT&T will need to relocate at West 3rd. I believe the Fiber Optic crossing West 3rd at Sta. 35+00 is theirs. We'll confirm when we meet with Eric.

Paul


PS. AT&T will not need to jump to the east side of Canal north of Lorain Carnegie. CEI is going to be in ducts, but the poles can remain.

Paul



AT&T West 3rd Street Demo (R1).pdf

ATTN NEEDS TO REMOVE
OVERHEADS IN THIS AREA
EAST OF WEST 3RD ST. 2200 LF
COP POLES TO BE DEMO'D

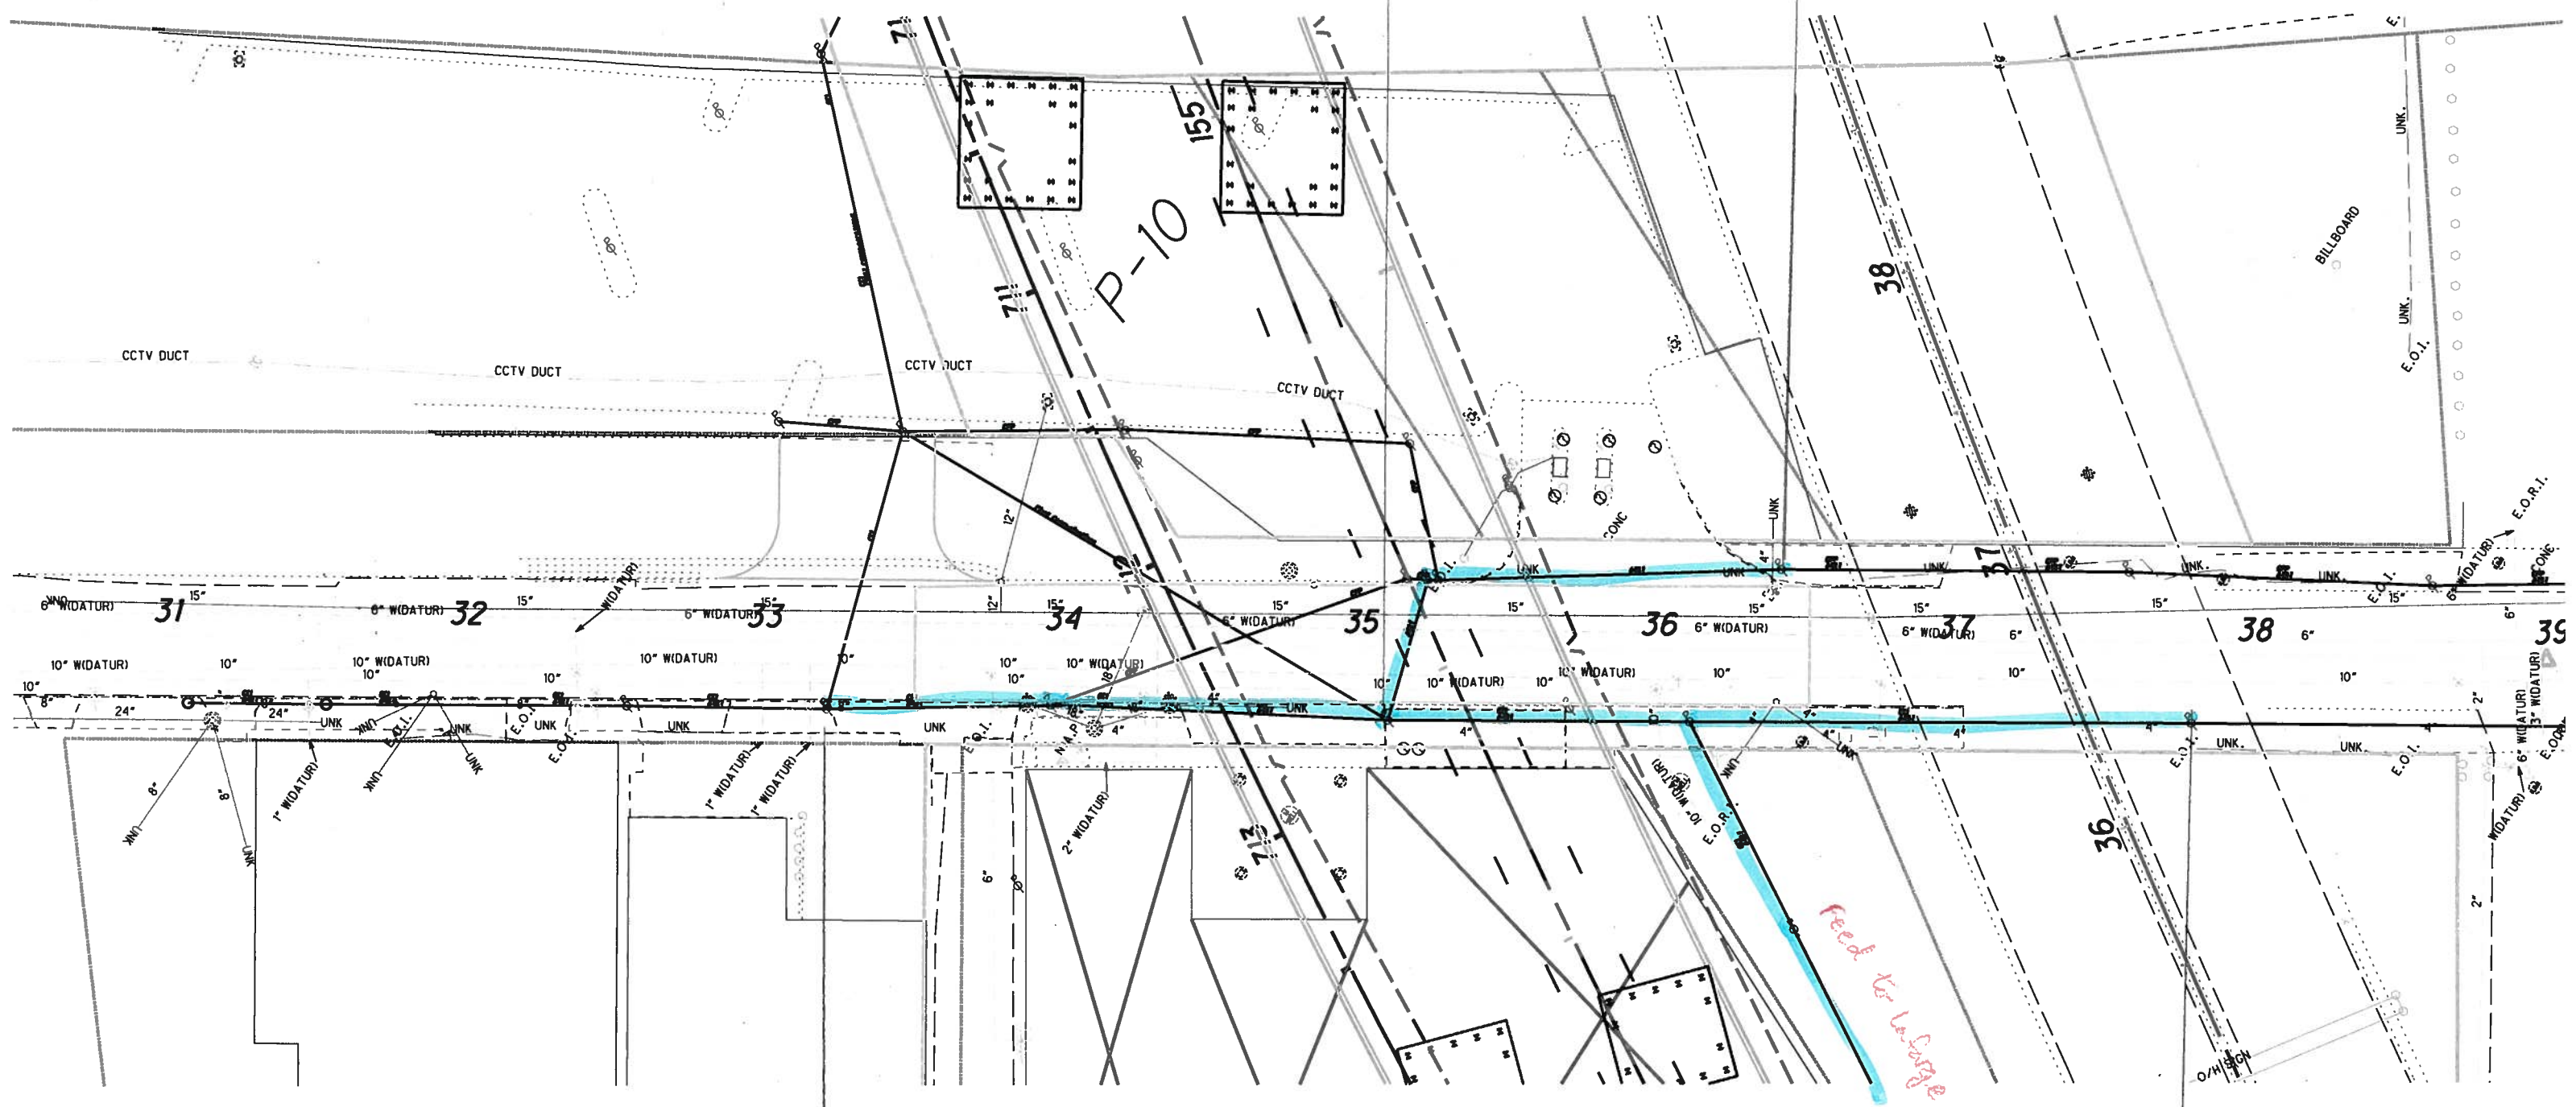

ATTN NEEDS TO REMOVE OVERHEAD
IN THIS AREA WEST OF WEST 3RD ST: 2 460 LF
(PLUS OVERHEAD FEED TO LAFARGE)
ATTN ON CFI POLES ON WEST SIDE OF W. 3RD ST. TO BE DEMO'D