



Date: 11/24/2010  
 Model: \$models  
 File: 49633-S-RD-PLN1.dgn

CHECK PRINT (INITIAL & DATE)    CHECKED BY:    CORRECTED BY:  
 MADE BY:    BACKCHECKED BY:    VERIFIED BY:

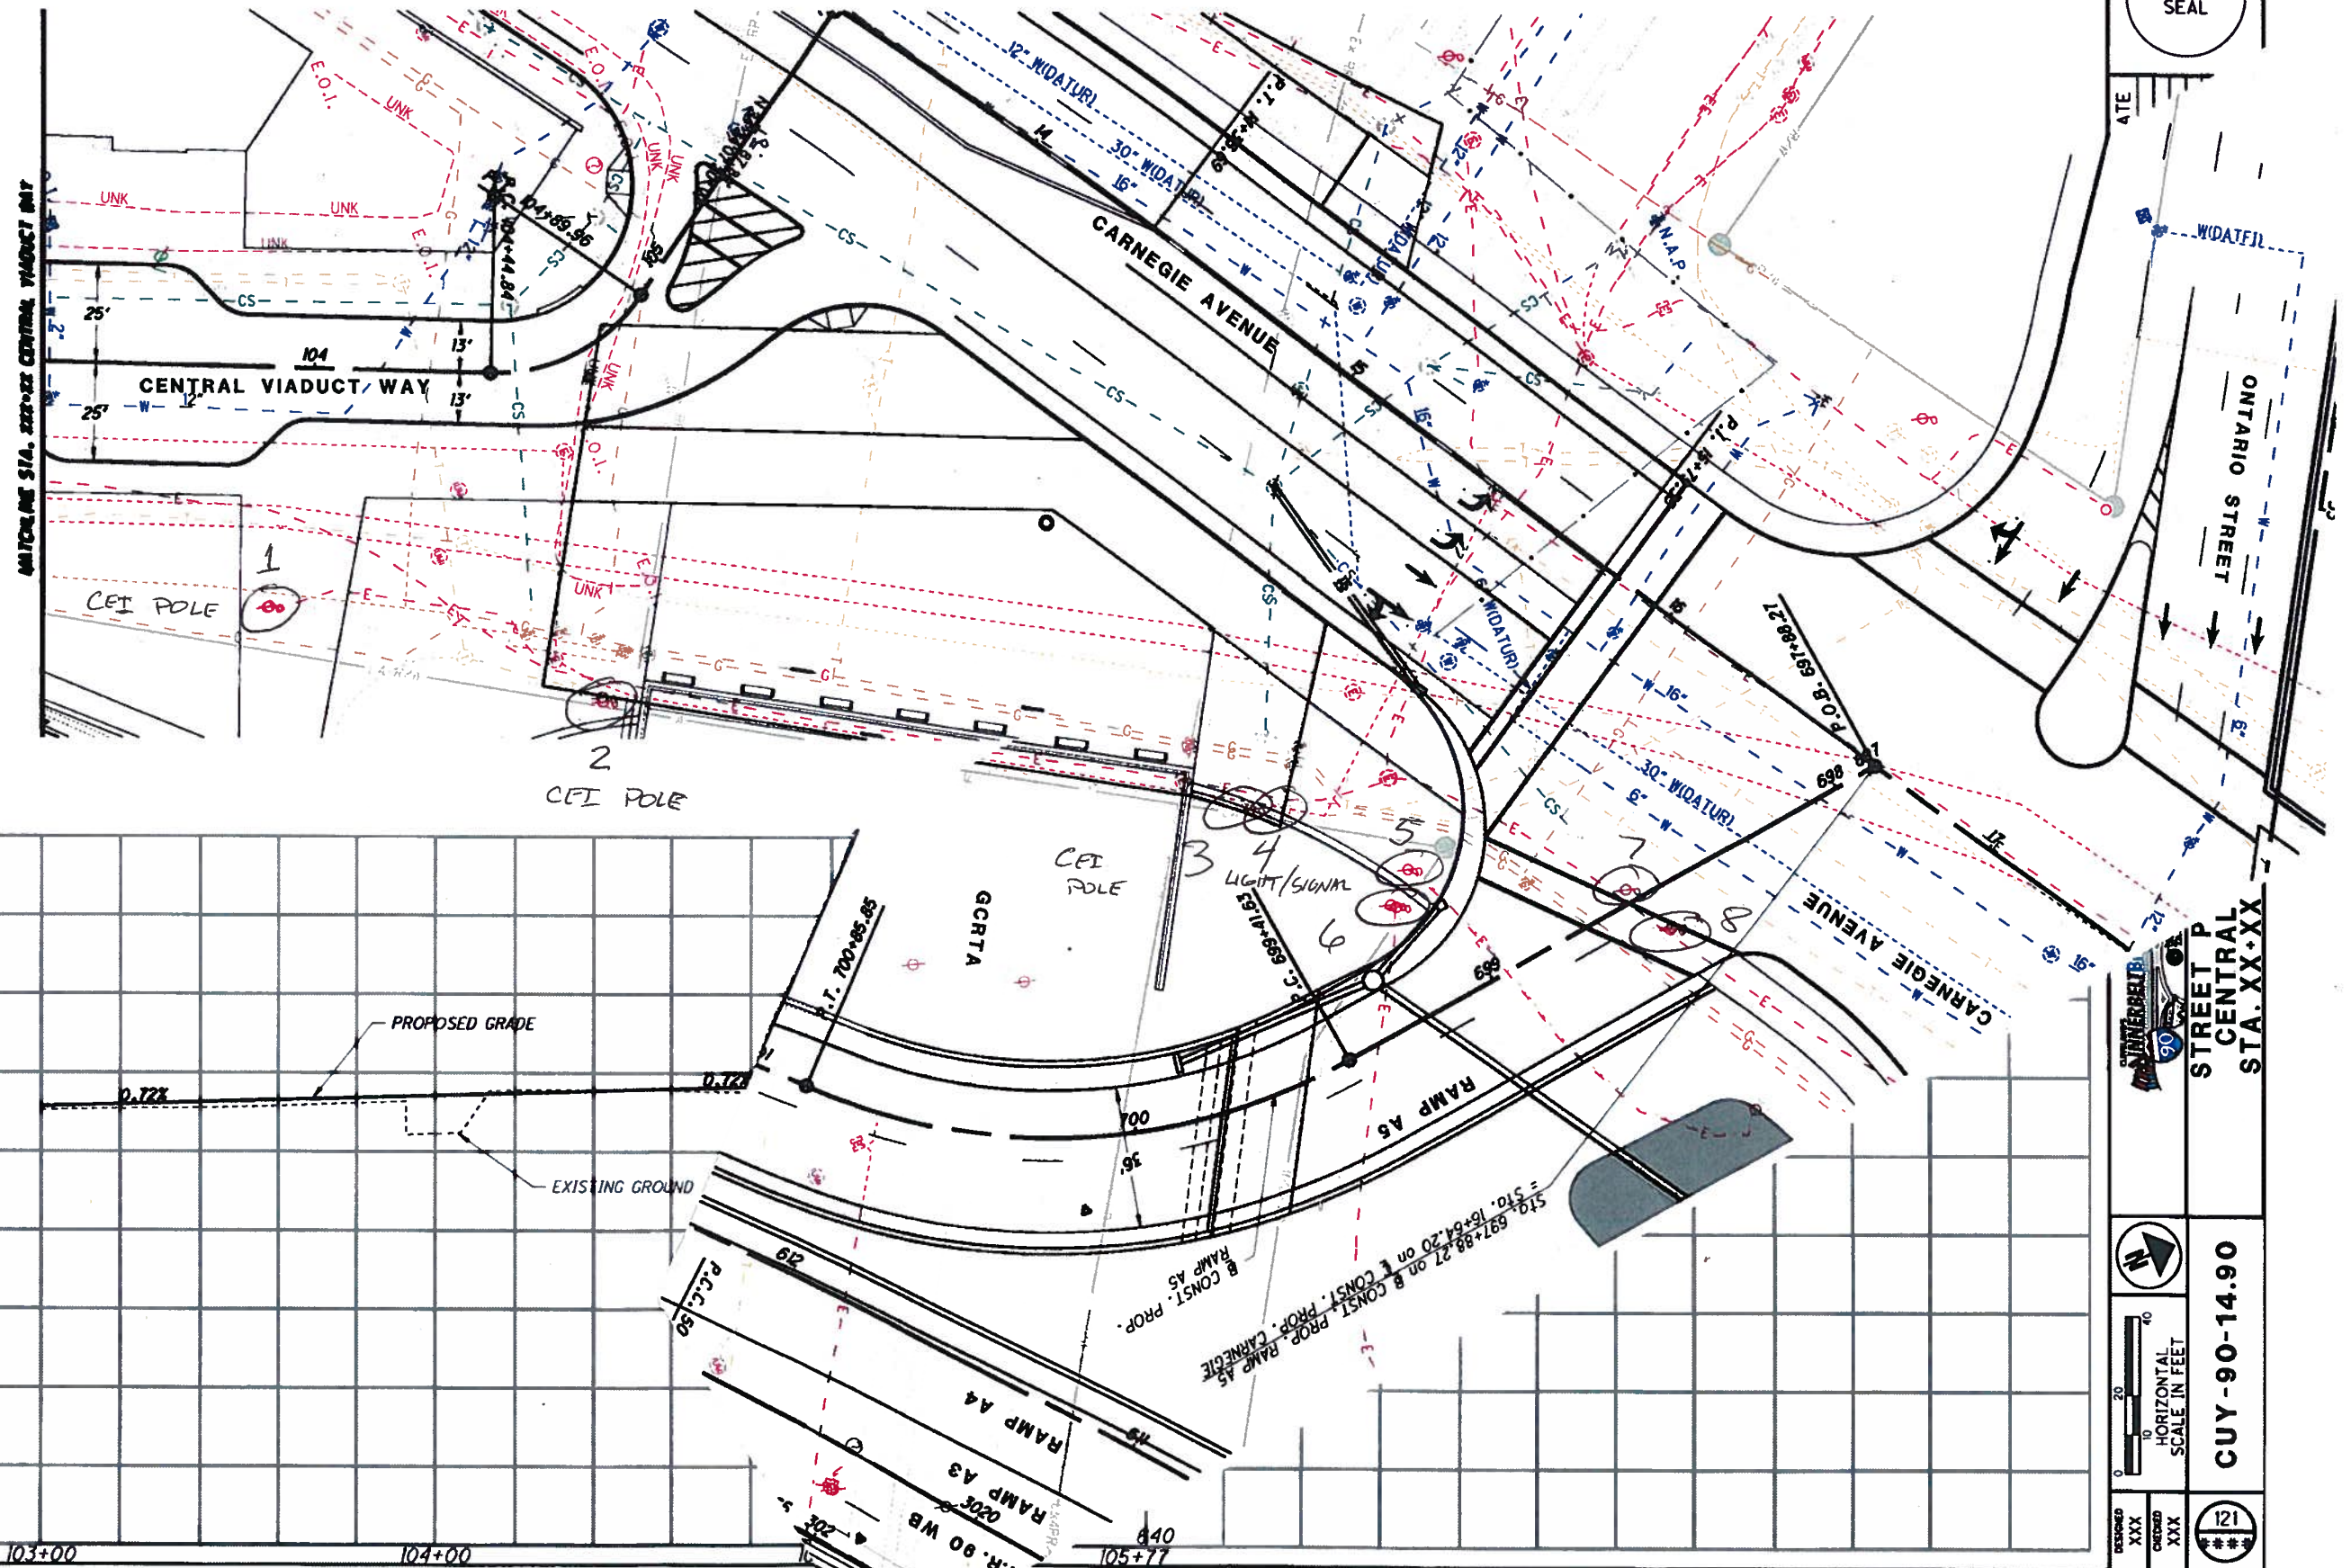

ENGINEER'S SEAL

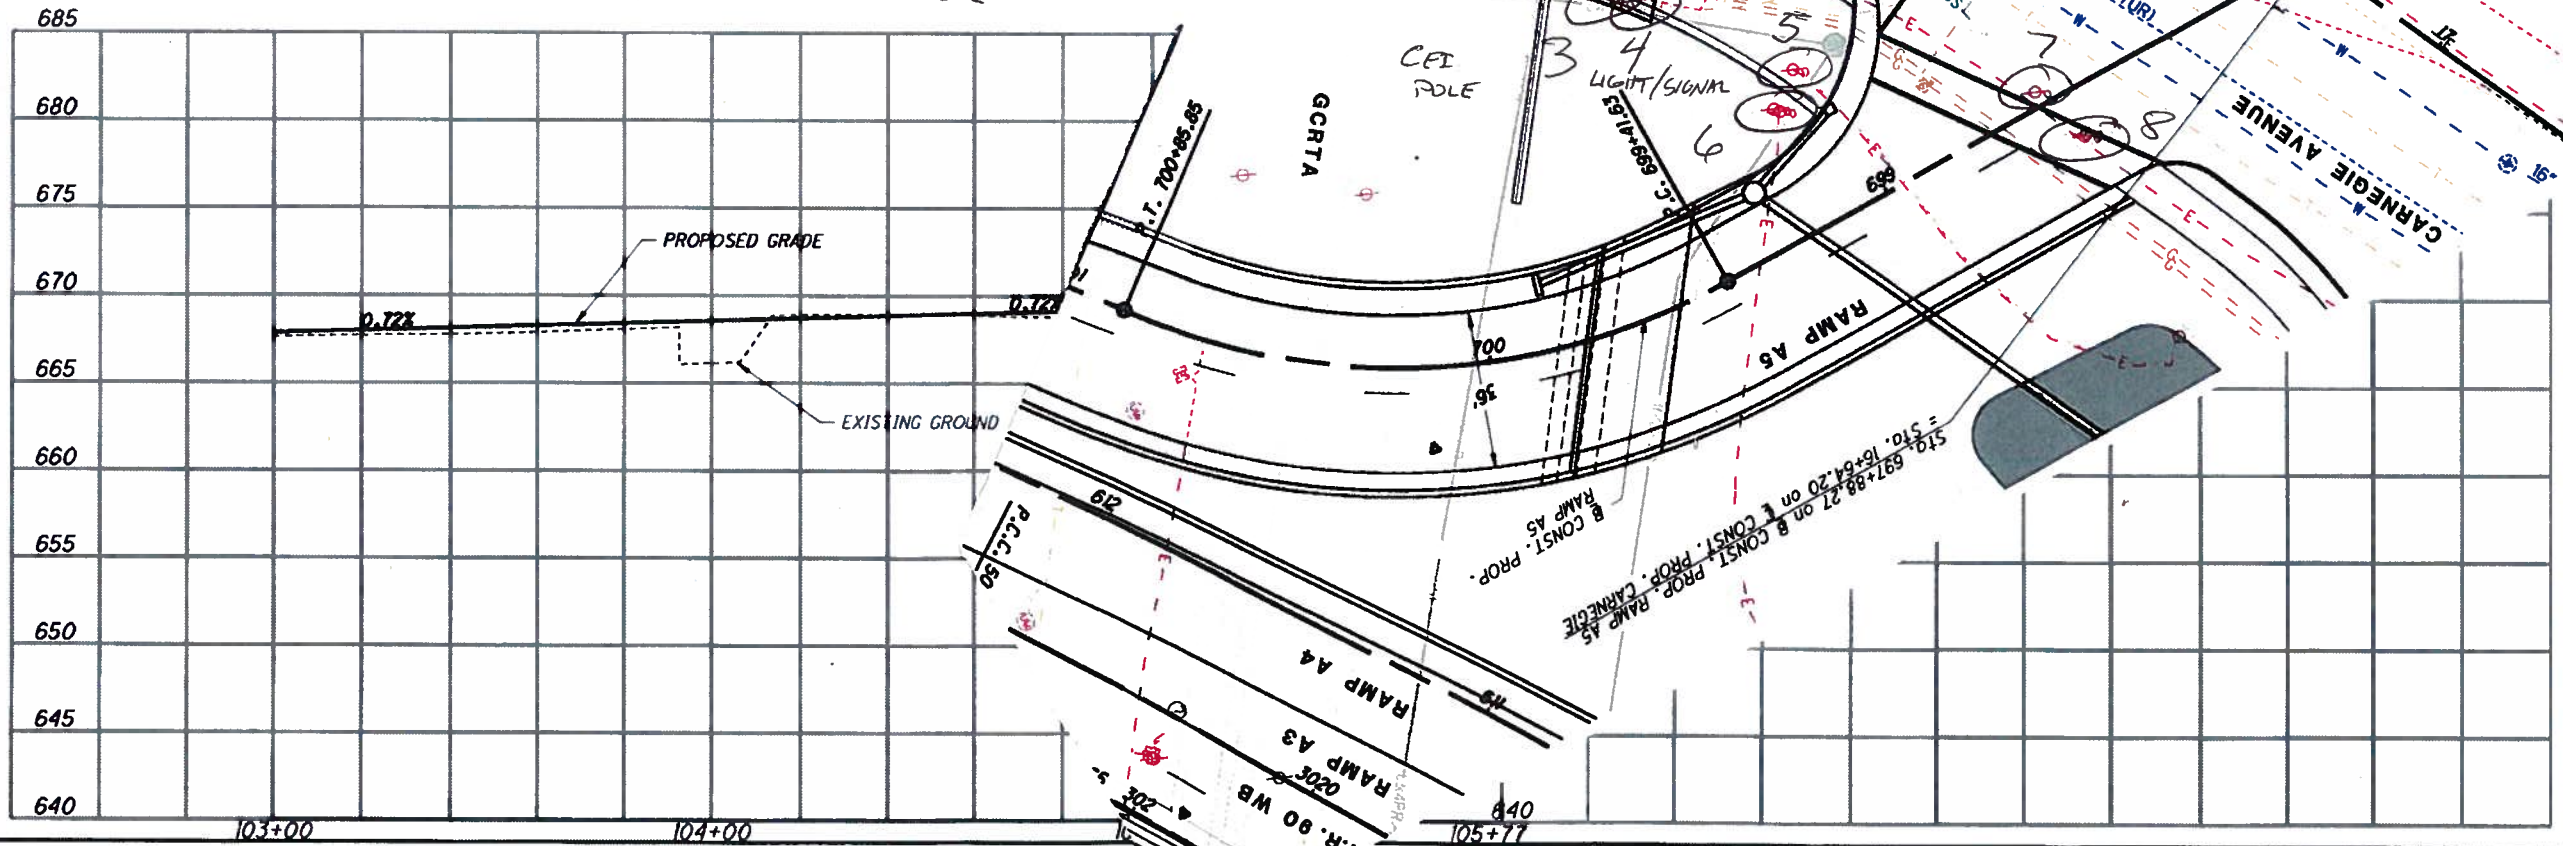

HORIZONTAL SCALE IN FEET  
 0 10 20

CUY-90-14.90

121

- ⑦ STRAIN POLE (SIGNING)
- ⑧ LIGHT POLE
- ⑤ CEI POLE - FEEDS AMPHITHEATER SIGN
- ⑥ CEI POLE - FEEDS ODOT 171-MAST LIGHTING

STREET P  
 CENTRAL  
 STA. XX.XX