


GRID 4722
ID-030

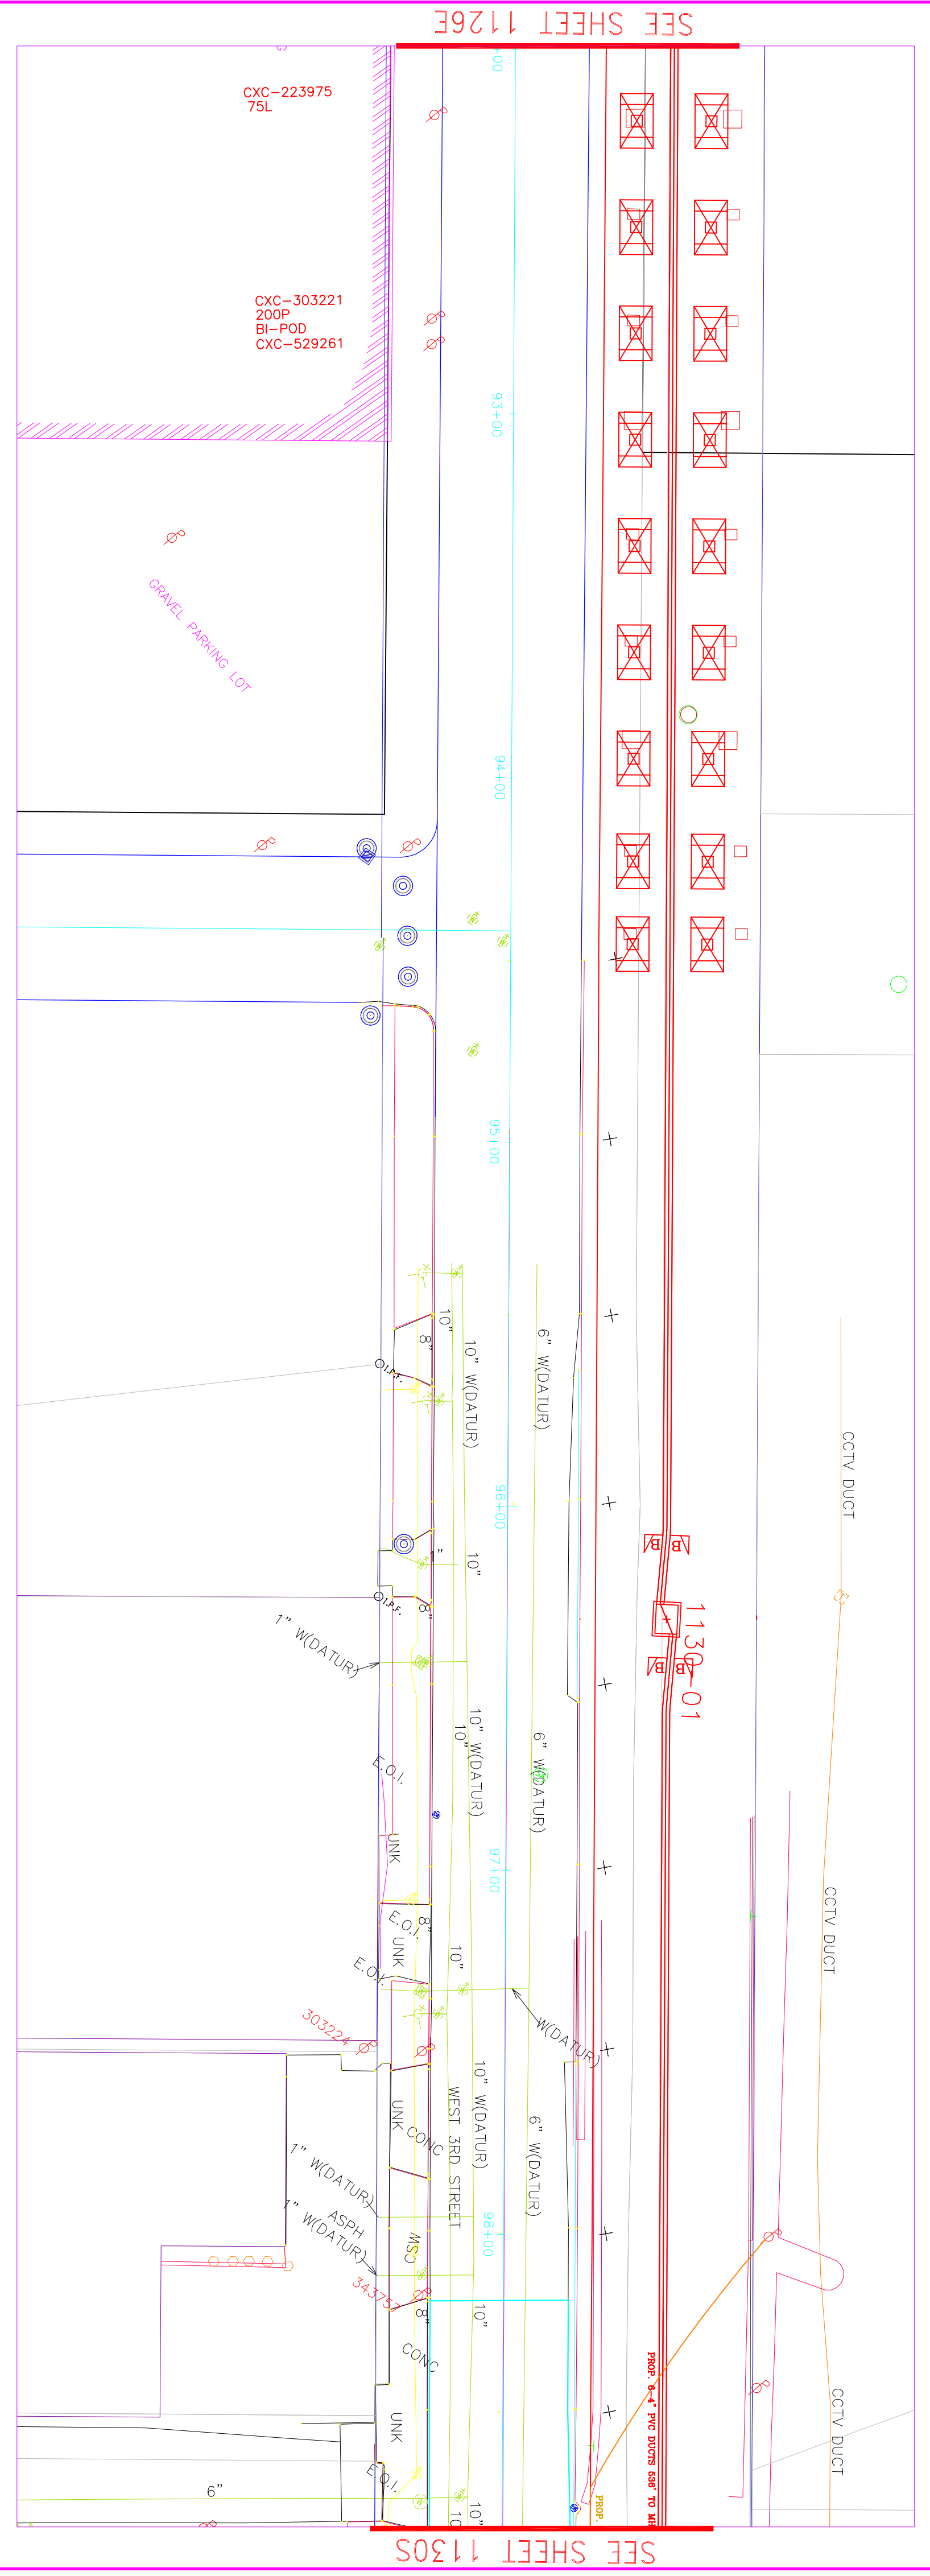

SEE SHEET 1126E

SEE SHEET 1130S

NO.	DATE	DESCRIPTION

NOTE: --- SUBWAY DISTANCES ARE GIVEN TO CENTER OF MANHOLES
VENTS, CURBS & SERVICES ARE GIVEN TO CENTER OF COVERS

THE CLEVELAND
ELECTRIC ILLUMINATING CO.
WEST 3RD ST.
OHIO 44113-1111

SMS SHEET 1130M
DATE: 05-01-11

ND/E/11