

wsnyder @firstenergycorp .co $\ensuremath{\mathsf{m}}$

06/30/2011 03:17 PM

- To "Curtis Malone" < Curtice. Malone@dot.state.oh.us>
- cc Thomas.Hyland@dot.state.oh.us, dmchatfield@firstenergycorp.com, clrandall@firstenergycorp.com

bcc

Subject Overhead removal of single span in vicinity of pier 11

History:


This message has been replied to.

Curt,

Weather permitting, the feeder tie, which will provide for the removal of the single span of overhead primary wire, in the vicinity of pier 11, and specifically between poles CXC-608796 and CXC-545866 (highlighted in blue) is anticipated to be completed July 23. The design should be complete mid-next week (~7/6), and upon your written approval will be released to the field for construction As agreed, one caveat: while the primaries can be removed, the poles need to remain so we may temporarily restore service by replacing and re-energizing the overhead wire in the event we experience issues with our UG

Regards,

Bill Snyder

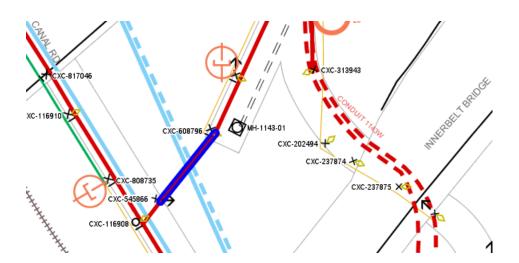

----- The information contained in this message is intended only for the personal and confidential use of the recipient(s) named above. If the reader of this message is not the intended recipient or an agent responsible for delivering it to the intended recipient, you are hereby notified that you have received this document in error and that any review, dissemination, distribution, or copying of this message is strictly prohibited. If you have received this communication in error, please notify us immediately, and delete the original message.