

SURVEY FOR: INNERBELT BRIDGE PROJECT - CANAL RD. PROJECT
 ADDRESS: CANAL RD. - W. EAGLE AVE. TO COMMERCIAL RD.
 MUNICIPALITY: CITY OF CLEVELAND SCALE: NONE
 ORDER FOR: OHIO DEPARTMENT OF TRANSPORTATION
 PREPARED BY: SURVEY OFFICE DRAWN BY: CHATFIELD PHONE: 440.717.6846

DESCRIPTION: CIRCUIT RELOCATION WORK - OH TO UG

CONST. PLANS APPROVED: JOINT PROPOSAL: MARKETING: SAPDR: 13002553 J.D.

CONSUMER'S CHARGE:

DATE	REC.	FOR-EST	DM	SUB-VAY	CABLE	SERV	RDD	DMC3	WES3	DEBI	RJS1	TOTAL
4/15/11	2		1		2		1	1	1	1	1	10

RETURN TO RIGHT-OF-WAY BEFORE SCHEDULING: JOINT POLE RELEASE: GANG MEET: TREE WORK: MUNICIPAL PERMIT INFO: DATE CLEARED:

DATE	DESCRIPTION	APPROVED BY

DATE	DESCRIPTION	APPROVED BY

A CHECK MARK NEXT TO EACH ITEM ON THE SKETCH, INCLUDING CHANGES, INDICATES THAT THE WORK HAS BEEN COMPLETED	UNITS OF WORK COMPLETED			
	ITEMS	INSTALLED	REMOVED	SHIFTED
POLES				
WIRES				
TRUNKS				
ANCHORS				

KIND OF POLE(S) INSTALLED BY SYMBOL: POLES LEFT FOR TEL. TO REMOVE:

DATE WORK COMPLETED: SUPERVISOR'S SIGNATURE:

UNDERGROUND FACILITIES WARNING: SPECIAL INSTRUCTIONS:

HIGH PRESSURE PIPELINE AT CHECKED BY: TELEPHONE:


D.H. TRANSMISSION CLEARANCE WARNING: FT. MIN. CLEARANCE REQUIRED AT DEGREES F. AT SYMBOLS:

ENGINEERING CHECKED BY: DATE: CONSTRUCTION CHECKED BY: DATE:


CONFIDENTIAL
FIRSTENERGY CORP.

INFORMATION IN THIS DOCUMENT IS PROPRIETARY AND SHALL NOT BE USED, COPIED, REPRODUCED OR DISCLOSED IN WHOLE OR IN PART WITHOUT THE WRITTEN CONSENT OF FIRSTENERGY CORP.

WBS: CE-000246-DU
 CIRCUITS: H-5-CN-P
 H-98-CN-P
 SEE WR# 54297014

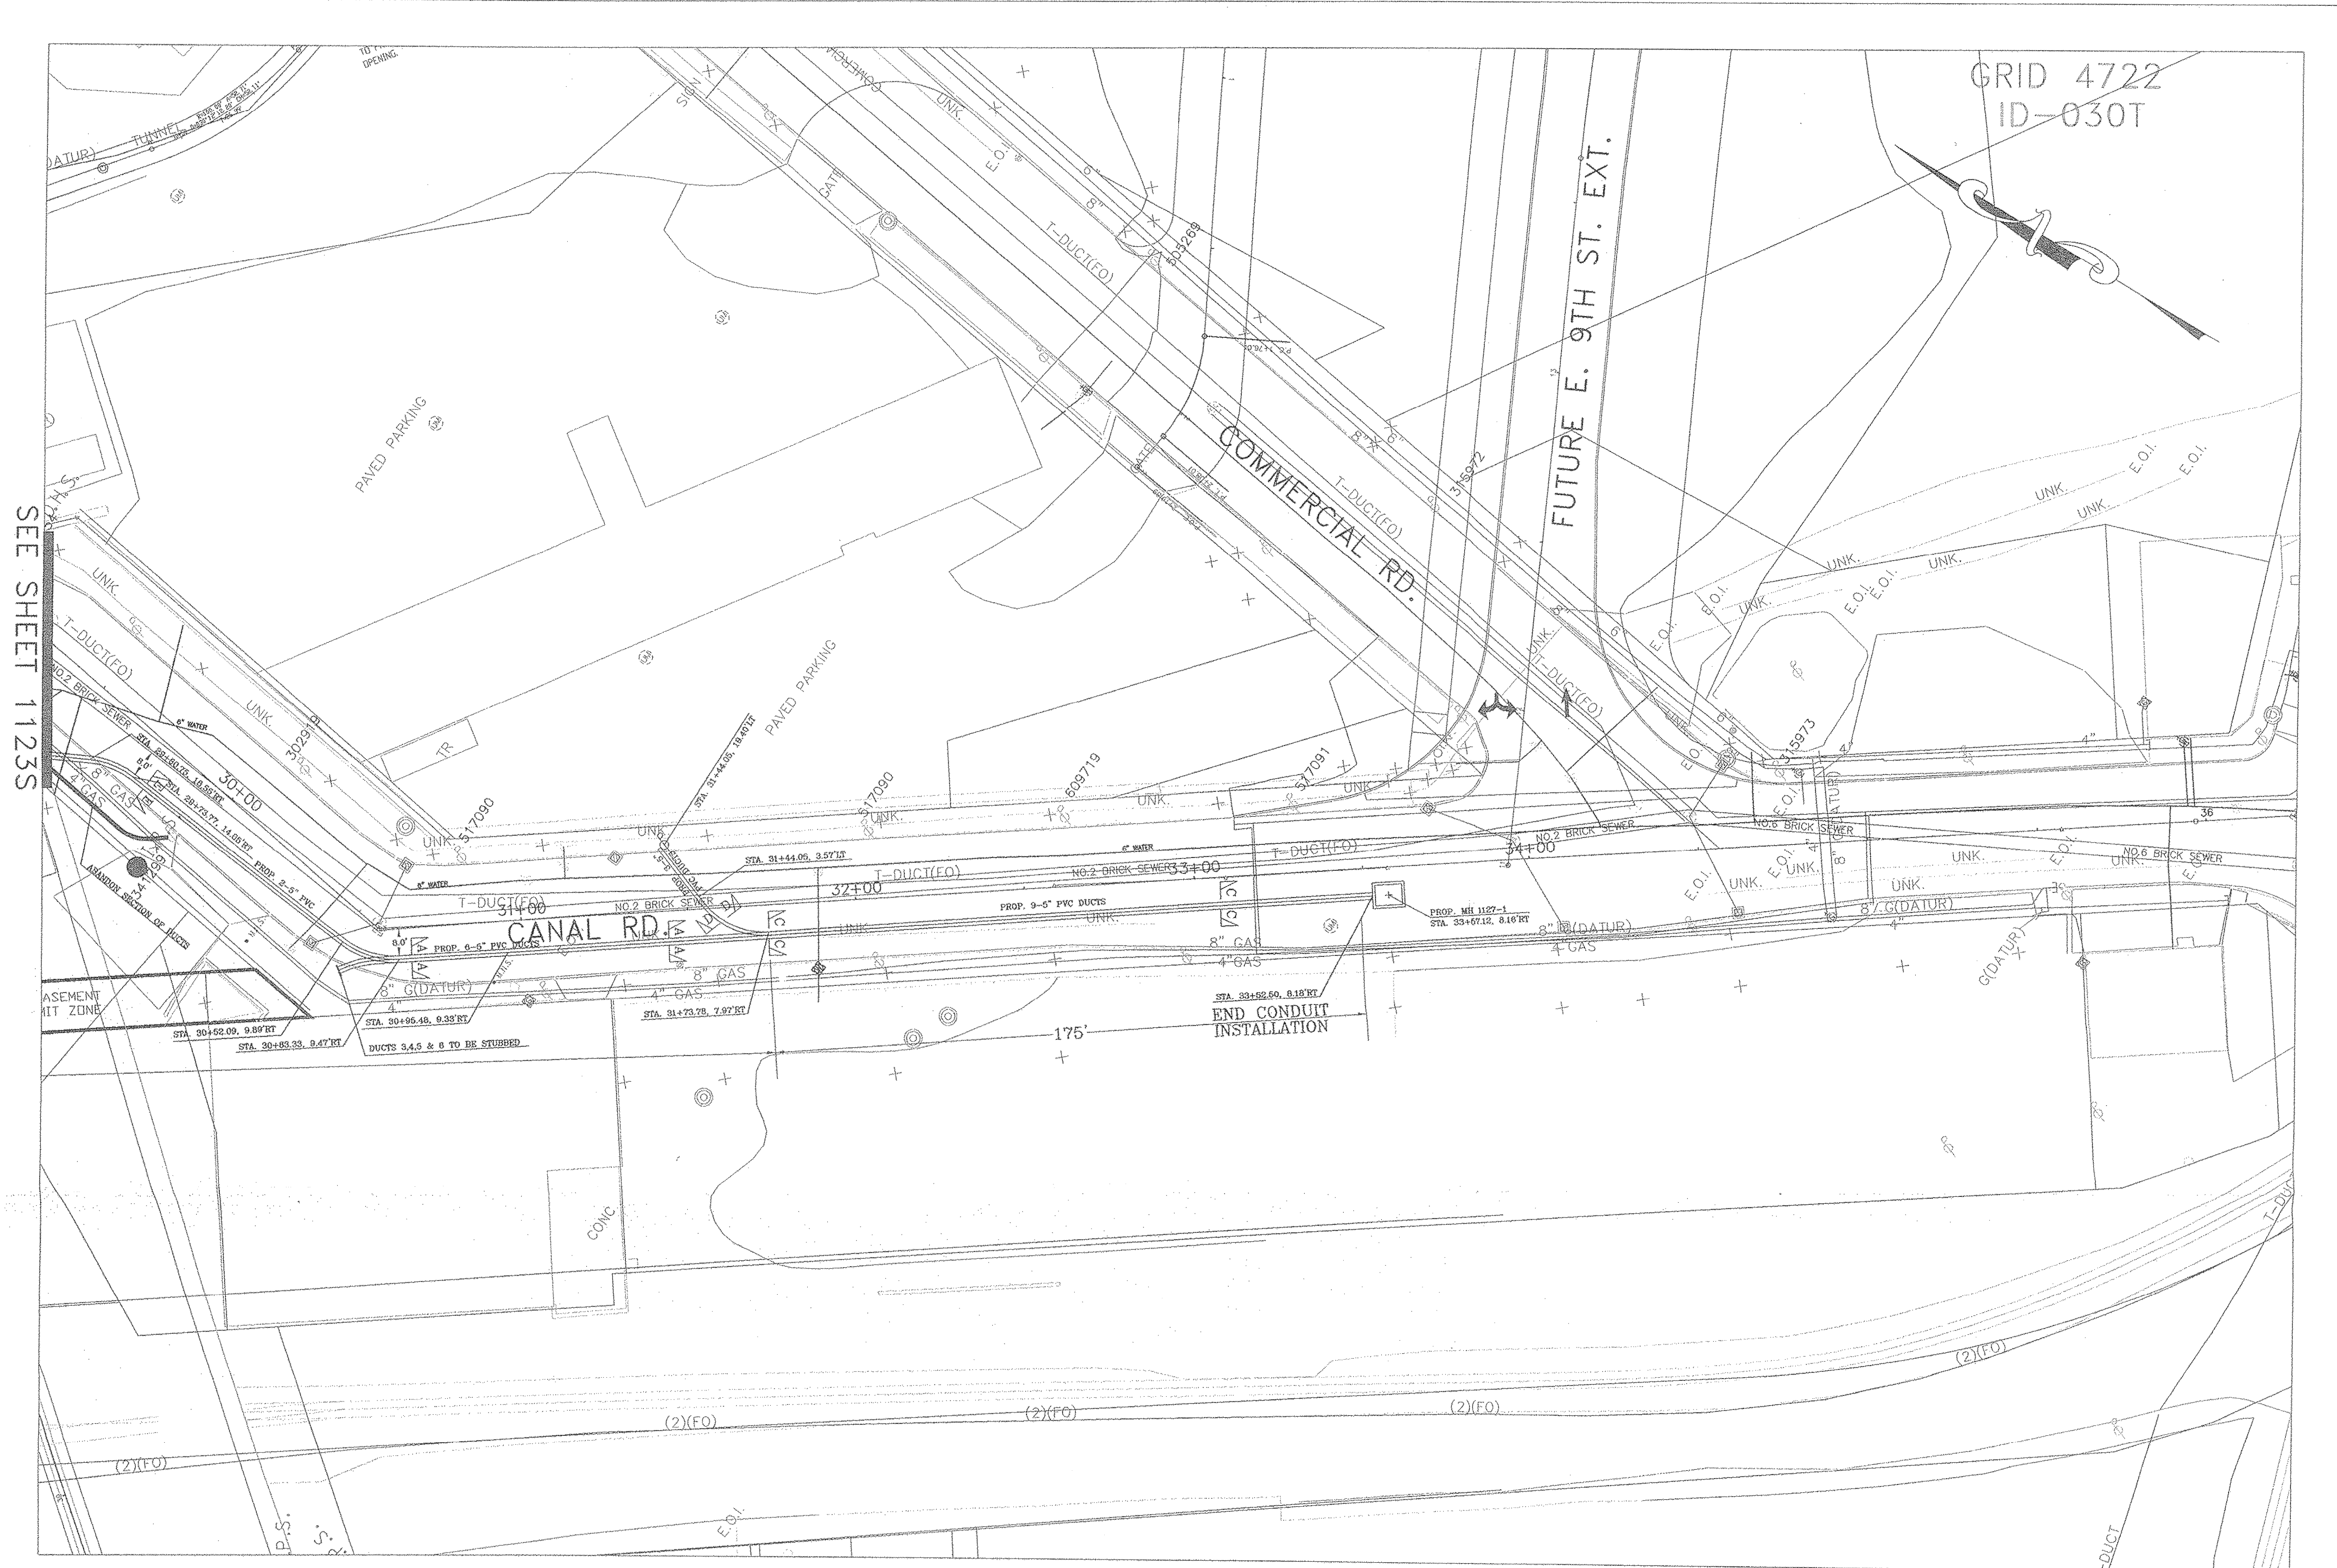

CORRECTIONS	DATE	BY
INSTALL CONDUIT AND MH ALONG CANAL RD.	4-15-11	SMG

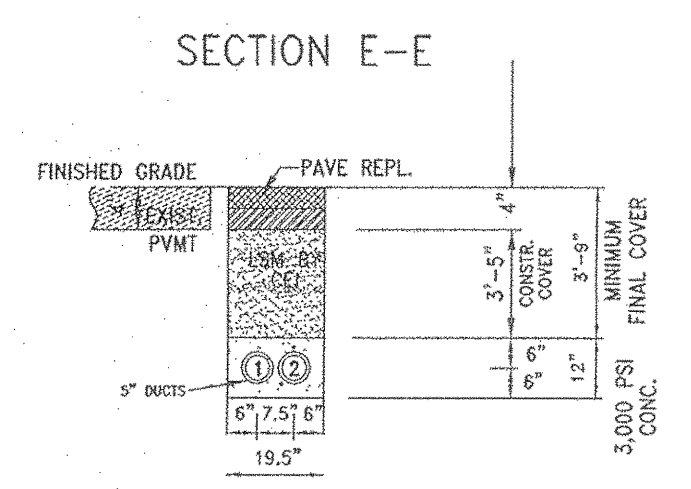

TYP 3-5" PVC DUCT SECT.
 CANAL RD. PERMANENT PAVEMENT REPLACEMENT

NOTE -- SUBWAY DISTANCES ARE GIVEN TO CENTER OF MANHOLES VENTS, CURBS & SERVICES ARE GIVEN TO CENTER OF COVERS

THE CLEVELAND ELECTRIC ILLUMINATING CO.
CANAL RD.
 DRAWN 4-15-11
 SMG SHEET 1127