

REQUESTED BY DATE 09-30-11 04-08-11	GRID # 4722											
FILE # WR-54160945	SHEET 1 OF 1											
SURVEY FOR ST OF OH-ODOT #12												
ADDRESS 2338 CANAL RD.												
CITY CLEVELAND	SCALE 0" = 0'											
ORDER FOR SET CBL POLE FOR INNERBELT PROJECT												
PREPARED BY W. BYRNE	PHONE 440-546-8704											
SET CBL POLE FOR INNERBELT PROJECT												
CONSE. PLANS APPROVED SAP ORDER 13094263												
JOINT PROPOSAL Y PROPOSAL NO. 6896 MILLER RD												
CUSTOMER'S CHARGE \$												
DATE 4/08	J.P. 2	R/S 1	O.H. 2	NET WORK 1	ELEC SERV 1	NRDO 1	WMB 1	REC. 1	CATV 1	FIBER 1	EMC 1	TOTAL 11
RETURN TO RIGHT-OF-WAY BEFORE SCHEDULING		JOINT POLE RELEASE		GANG MEET		TREE WORK		MUNICIPAL PERMIT		INFO		
DATE CLEARED		NAME		PHONE NO.		CEI PLANNER		NAME		PHONE NO.		
REVISION HISTORY		DATE		DESCRIPTION		APPROVED BY						
CONSTRUCTION		A CHECK MARK NEXT TO EACH ITEM ON THE SKETCH, INCLUDING CHANGES, INDICATES THAT THE WORK HAS BEEN COMPLETED		ITEMS		UNITS OF WORK COMPLETED						
				POLES		INSTALLED		REMOVED		SHIFTED		
				WIRE								
				FIBER								
				ANCHERS								
				KIND OF POLES INSTALLED BY SYMBOL								
				POLES LEFT FOR TEL. TO REMOVE								
				DATE WORK COMPLETED								
				SUPERVISORS SIGNATURE								
CAUTION		UNDERGROUND FACILITIES WARNING		HIGH PRESSURE PIPELINE AT _____ CHECKED BY _____		SPECIAL INSTRUCTIONS						
				D.H. TRANSMISSION CLEARANCE WARNING								
				_____ FT. MIN. CLEARANCE REQUIRED AT _____ DEGREES F.								
				AT SYMBOLS								
				ENGINEERING CHECKED BY: _____ DATE _____								
				CONSTRUCTION CHECKED BY: _____ DATE _____								

2 WORKING DAYS BEFORE YOU DIG "IT'S THE LAW"  
CALL TOLL FREE 800-362-2764  
OHIO UTILITIES PROTECTION SERVICE  
OGPUPS CONTACT: 800-925-0988


FULL SET OF PLANS PROVIDED?  
 YES  NO  
DATE OF PLANS 00-00-00

H-05-CN-P  
5KV

UD-XXXX  
SUBDIVISION NAME  
PHASE


CUST. CONTACT:  
NAME  
PHONE NO.

CEI PLANNER  
NAME  
PHONE NO.

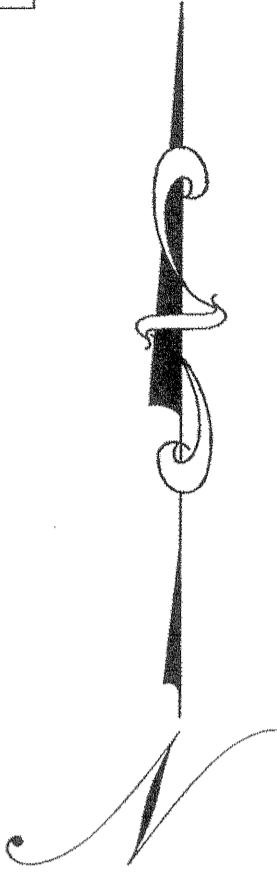

- ① P#60809 45'1'60  
SUB TO 55'3  
CUT 10' OFF TOP  
SET IN SAME HOLE  
REM D10'X,3-V8'S(ST SD OF X)& TRSF  
3#1/0 PRI((N & S)FLD SD OF X),  
3#1/0 PRI((S)ST SD OF X)  
REM 10'HX  
REM 10'HX BOARD#603(H-05-CN),  
BOARD#817(H-98-CN)  
REM 10'X,6-LPD'S  
REM 2-G & W POT HEADS  
REM EF & TRSF 1#1/0 TRI SEC(N & S)  
INST D10'X,6-STL PINS(FLD SD OF X)  
3-V8'S((S) ST SD OF X)  
FAULT IND.H-05-CN  
INST 10'HX,BOARD#603((H-05-CN)FLD SD OF X)  
BOARD#817((H-98-CN)ST SD OF X)  
INST D10'X,6-LPD'S(H-98-CN OPEN)  
INST 6#500 TERM  
INST EF  
EX FIBER/OPTIC

CONFIDENTIAL  
FIRST ENERGY CORP.  
INFORMATION IN THIS DOCUMENT IS PROPRIETARY  
AND SHALL NOT BE USED, COPIED, REPRODUCED OR  
DISCLOSED IN WHOLE OR PART WITHOUT THE  
WRITTEN CONSENT OF FIRSTENERGY CORP.

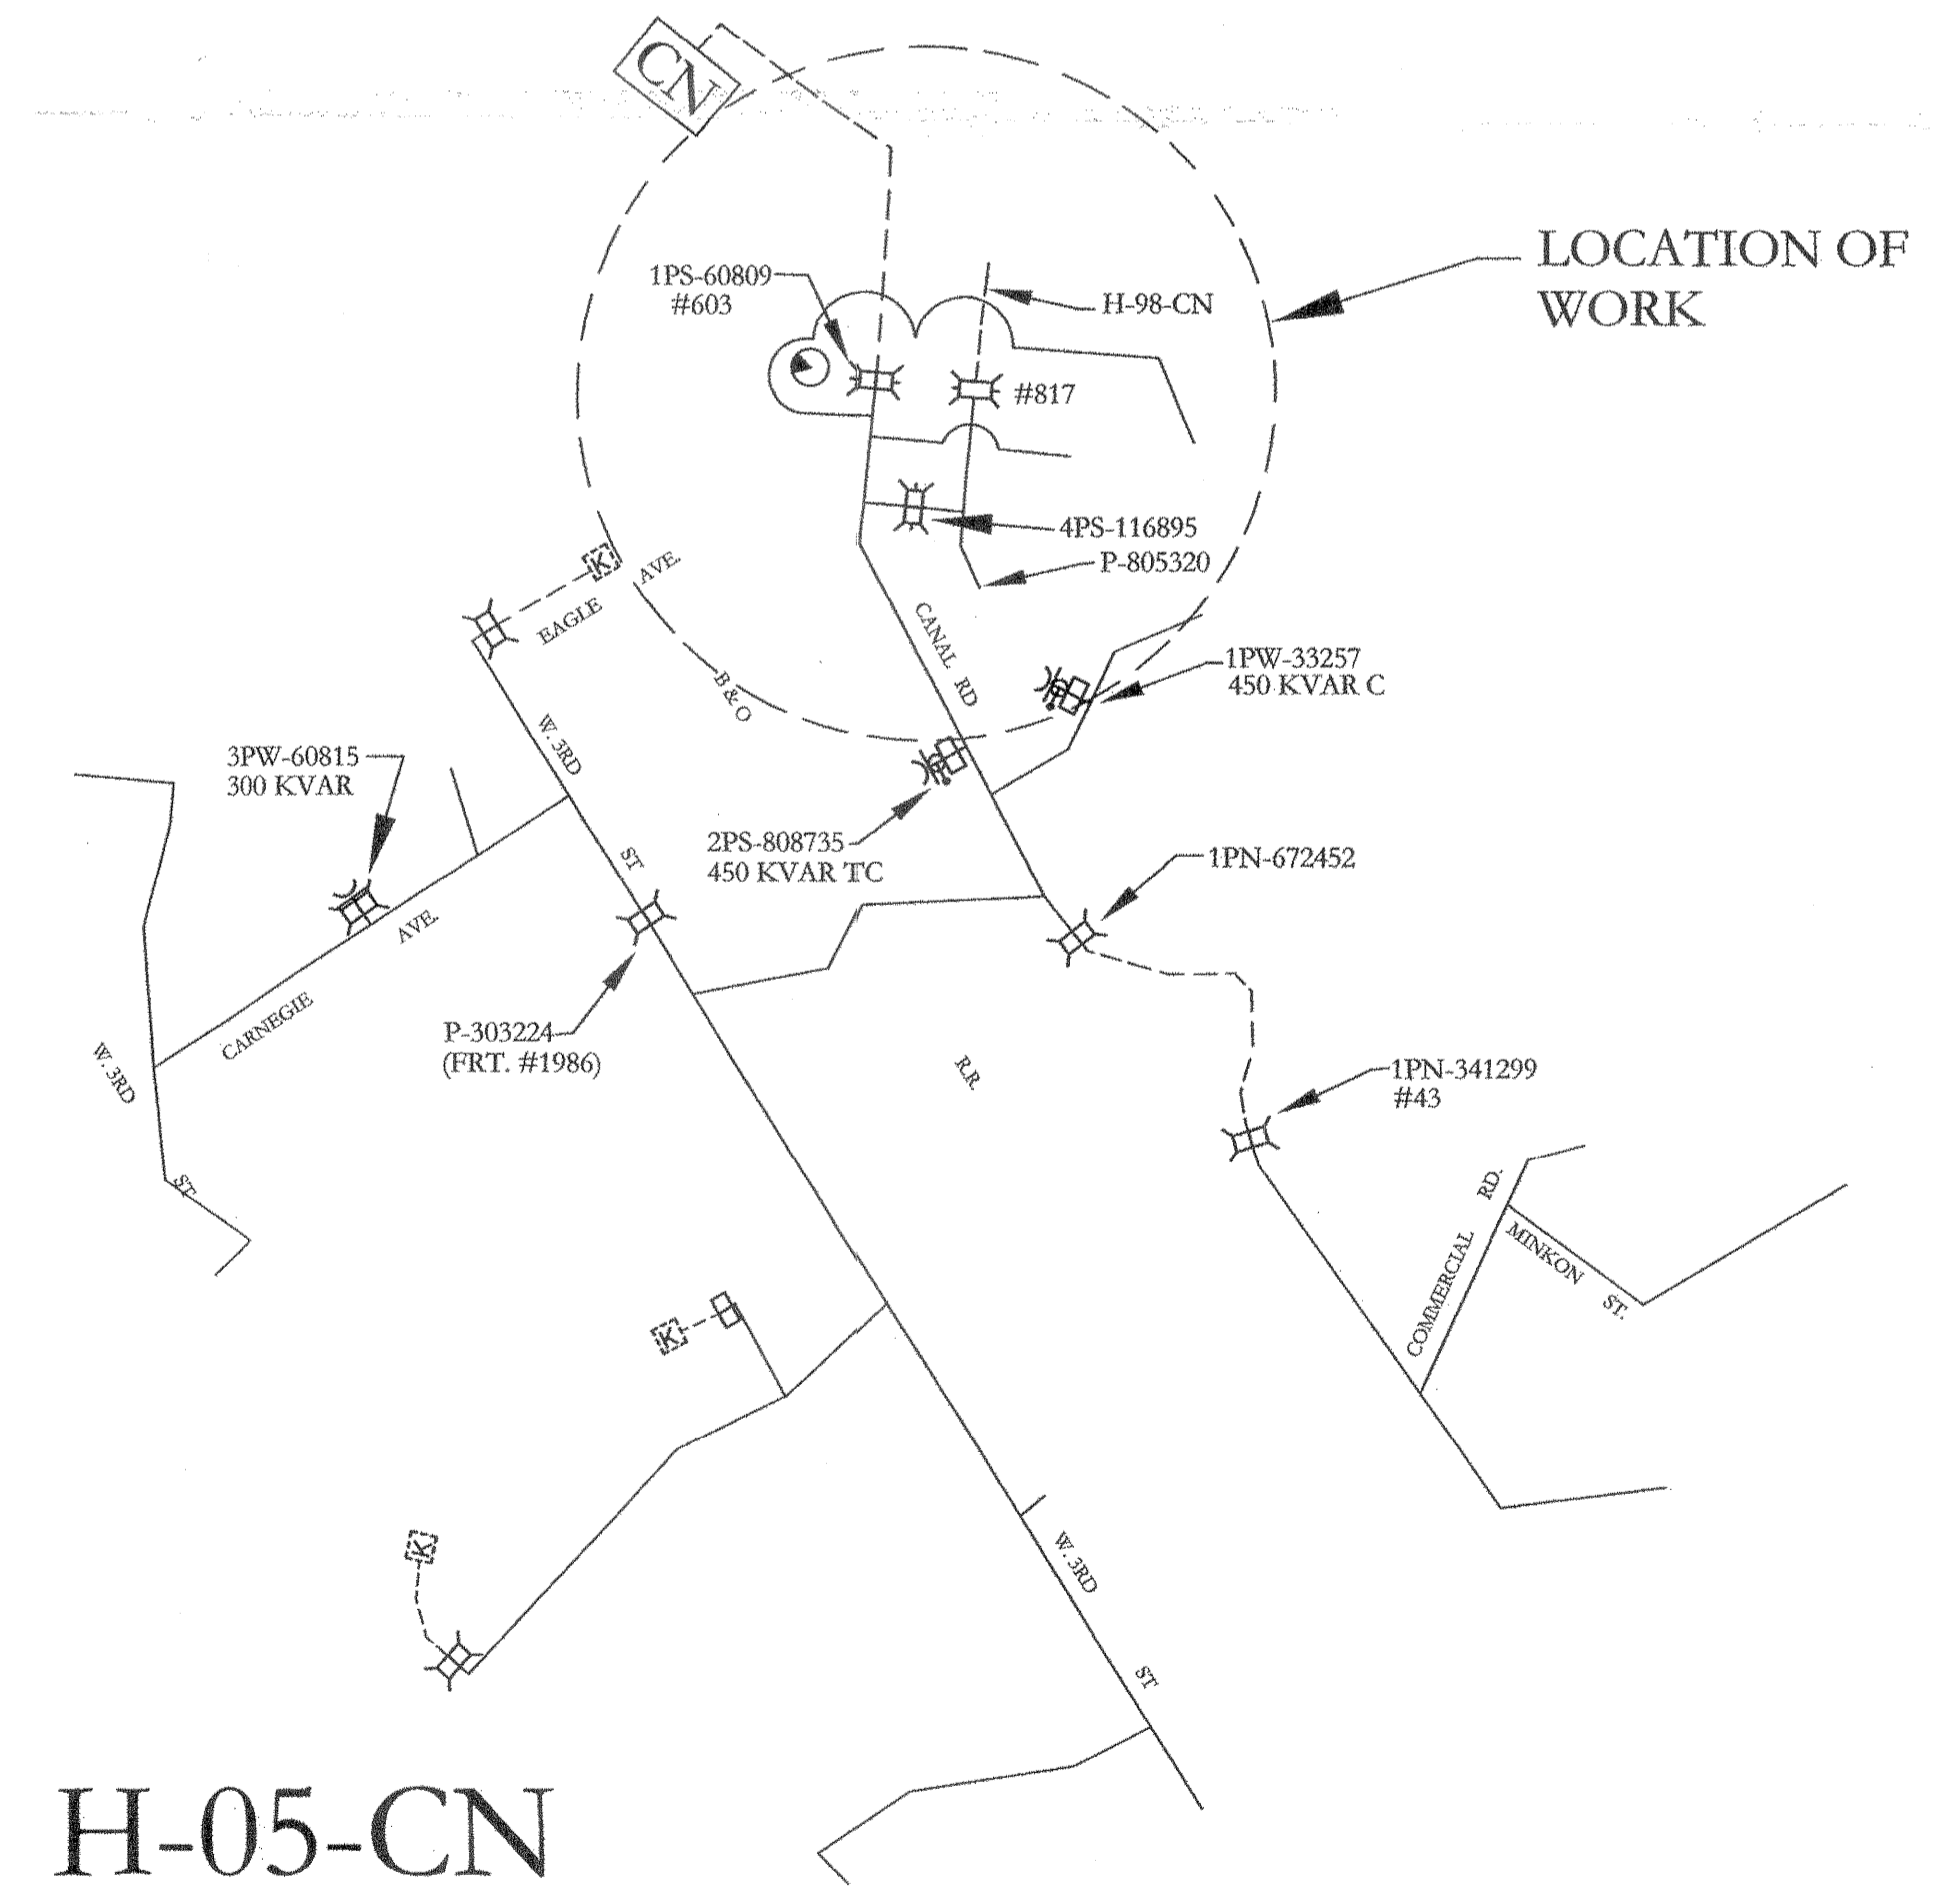

H-05-CN

