


BETWEEN ① & ③ INST. - 3- #2 ALJCN U/G PRIMARY - 935' EACH

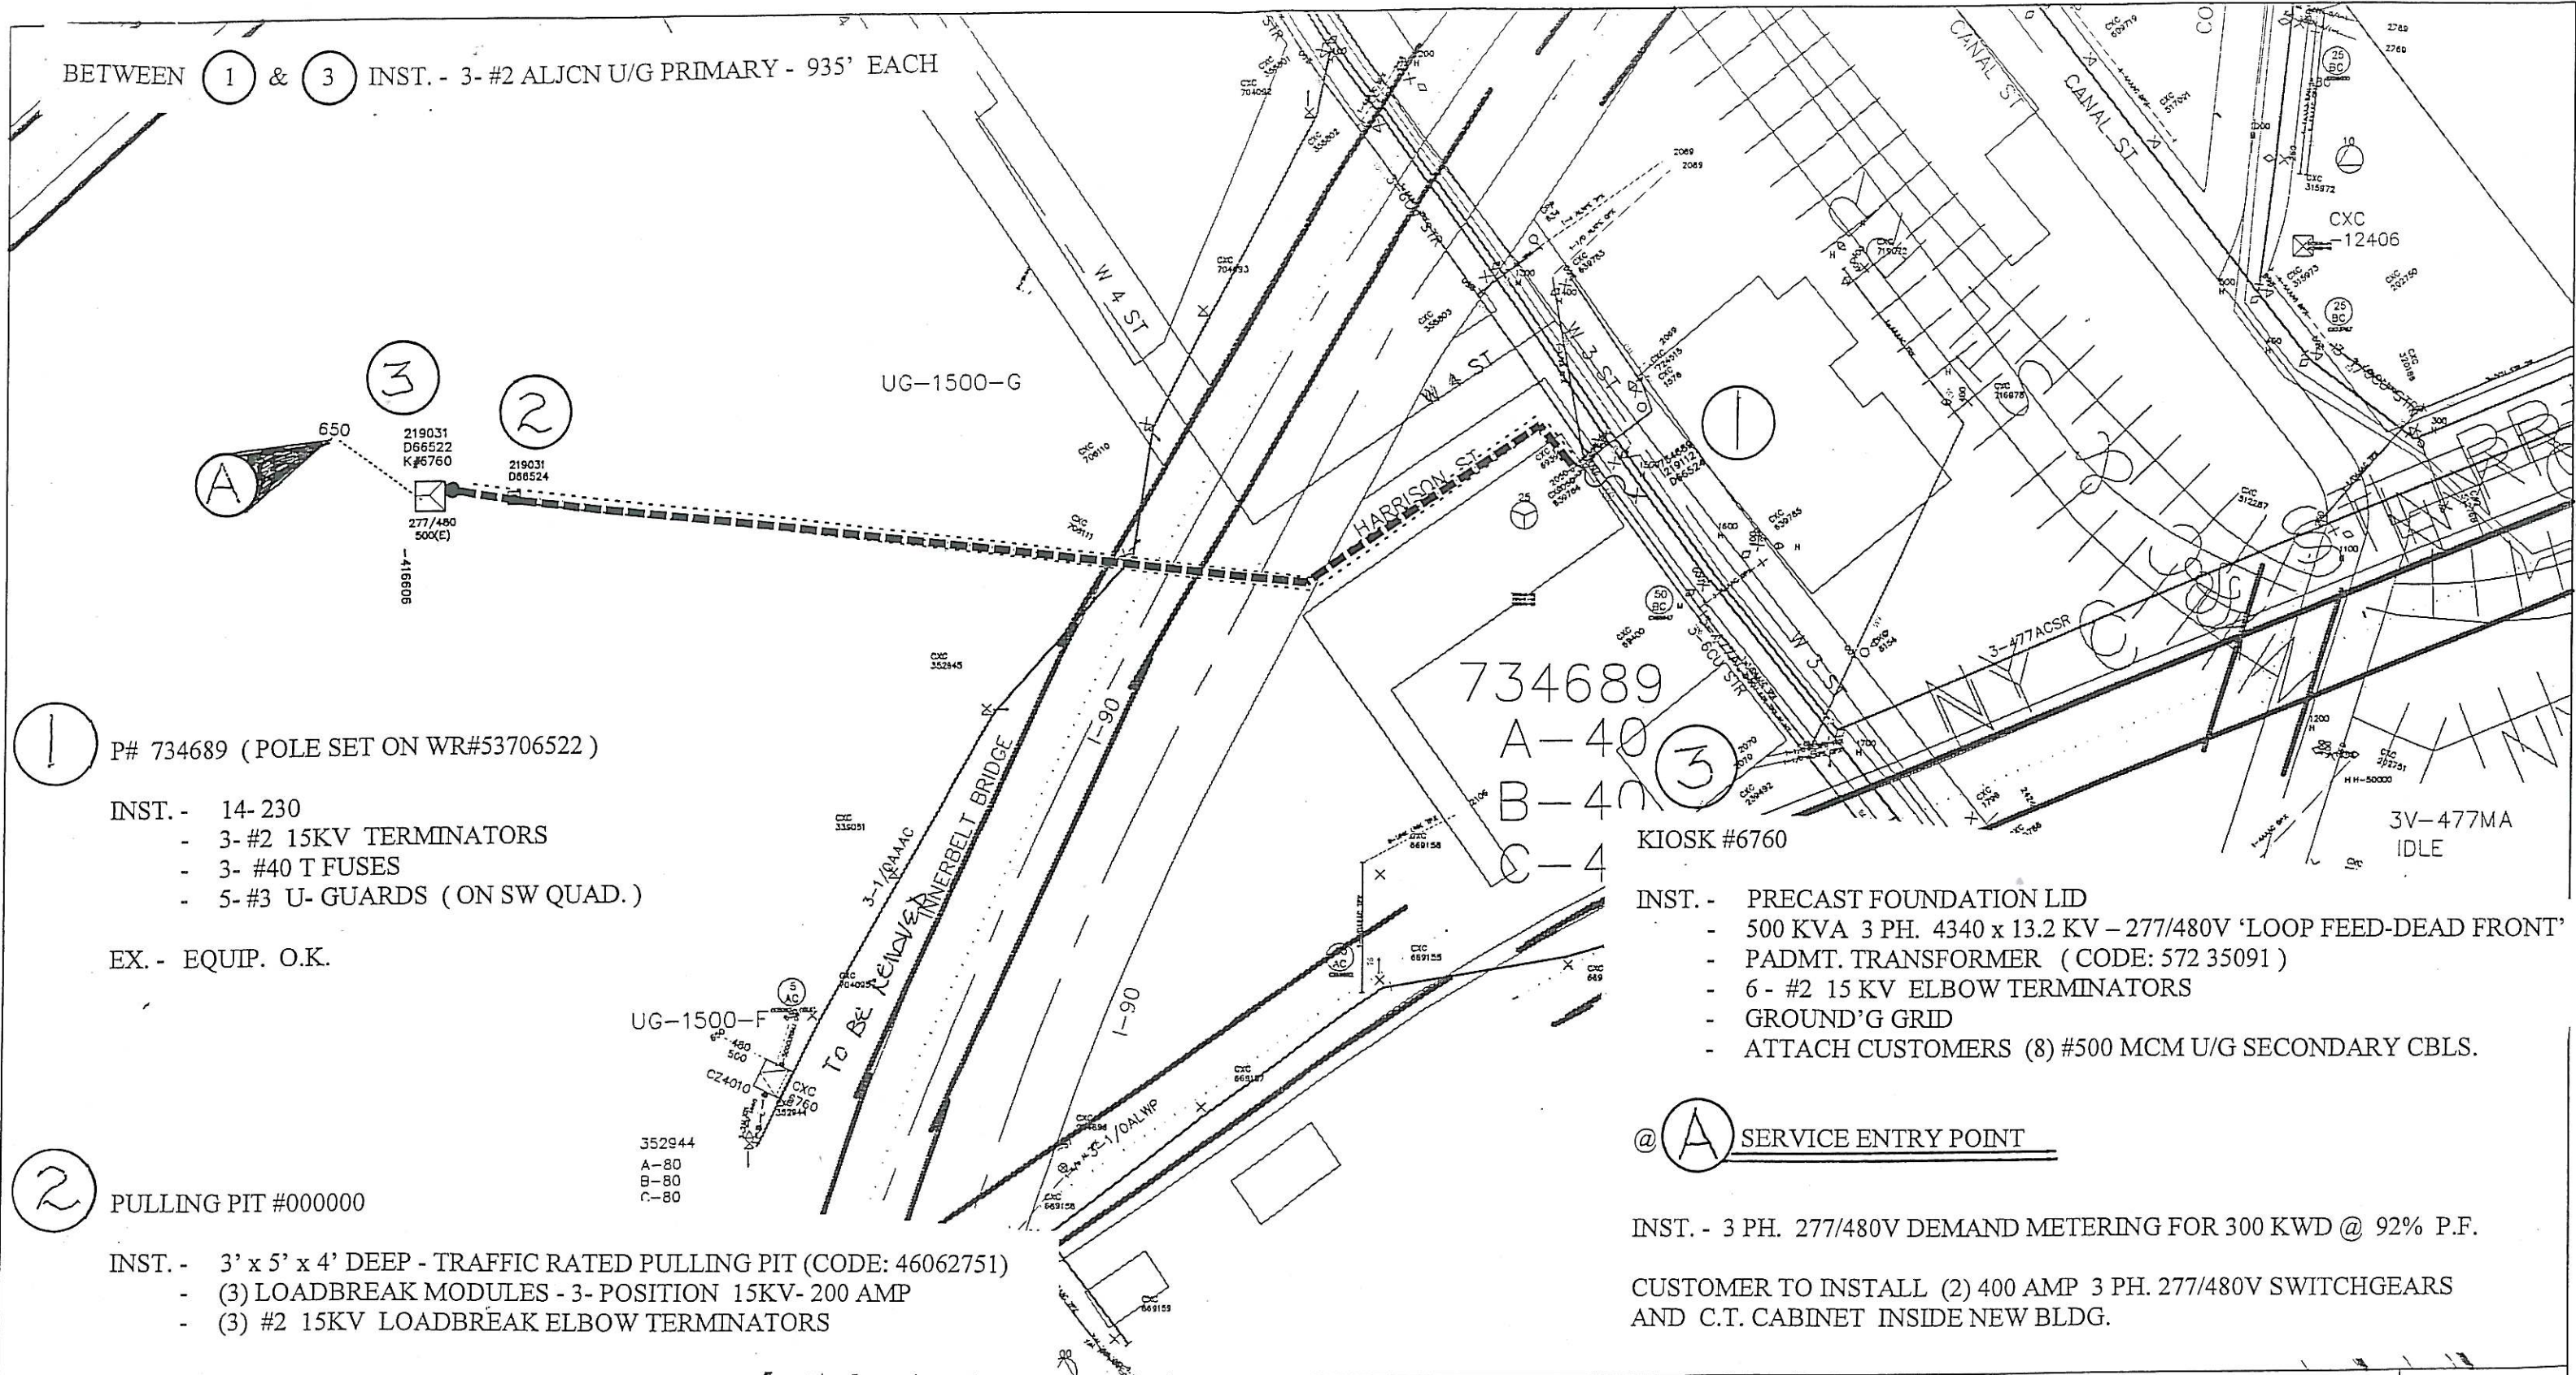

① P# 734689 (POLE SET ON WR#53706522)
 INST. - 14-230
 - 3- #2 15KV TERMINATORS
 - 3- #40 T FUSES
 - 5- #3 U- GUARDS (ON SW QUAD.)
 EX. - EQUIP. O.K.

② PULLING PIT #000000
 INST. - 3' x 5' x 4' DEEP - TRAFFIC RATED PULLING PIT (CODE: 46062751)
 - (3) LOADBREAK MODULES - 3- POSITION 15KV- 200 AMP
 - (3) #2 15KV LOADBREAK ELBOW TERMINATORS

734689
 A-40
 B-40
 C-4

③ KIOSK #6760
 INST. - PRECAST FOUNDATION LID
 - 500 KVA 3 PH. 4340 x 13.2 KV - 277/480V 'LOOP FEED-DEAD FRONT'
 - PADMT. TRANSFORMER (CODE: 572 35091)
 - 6- #2 15 KV ELBOW TERMINATORS
 - GROUND'G GRID
 - ATTACH CUSTOMERS (8) #500 MCM U/G SECONDARY CBLs.

@ A SERVICE ENTRY POINT

INST. - 3 PH. 277/480V DEMAND METERING FOR 300 KWD @ 92% P.F.
 CUSTOMER TO INSTALL (2) 400 AMP 3 PH. 277/480V SWITCHGEARS AND C.T. CABINET INSIDE NEW BLDG.

Designer : RANDALL,CHARLES L	Phone : (440)546-8705	WR Name :54449248	FirstEnergy Region : N/A
Sales Rep : SCHNIEGENBERG,MICHAEL R	Phone : (440)546-8813	Township - County: ----	Tax District: BK
Scheduler : ZEDNIK,BRIAN R	Phone : (216)634-7308 ext.	Cust/Elect Name: ----	Cusr/Elect Phone: ----
Work Request: 54449248	SAP Order # : 13126837	Customer: LAFARGE CORPORATION,FINANCIAL SERVICES CENTER #798-4486	Substation : CN
Apprvl: _____ Date:_____	Apprvl: _____ Date:_____	Street No : 650	Street Name : HARRISON ST
City : CLEVELAND	Zip : 44113	Upstream Device: N	Forestry Req: N
		Foreman's Signature:	Easement: N
			Const. Comp. Date:

Scale : 1:112

1