



WBS: CE-000246-DU
CIRCUITS: H-5-CN-P
SEE WR# 53706728
FOR RELATED OVERHEAD WORK

PROPOSED INNERBELT
BRIDGE OVERPASS

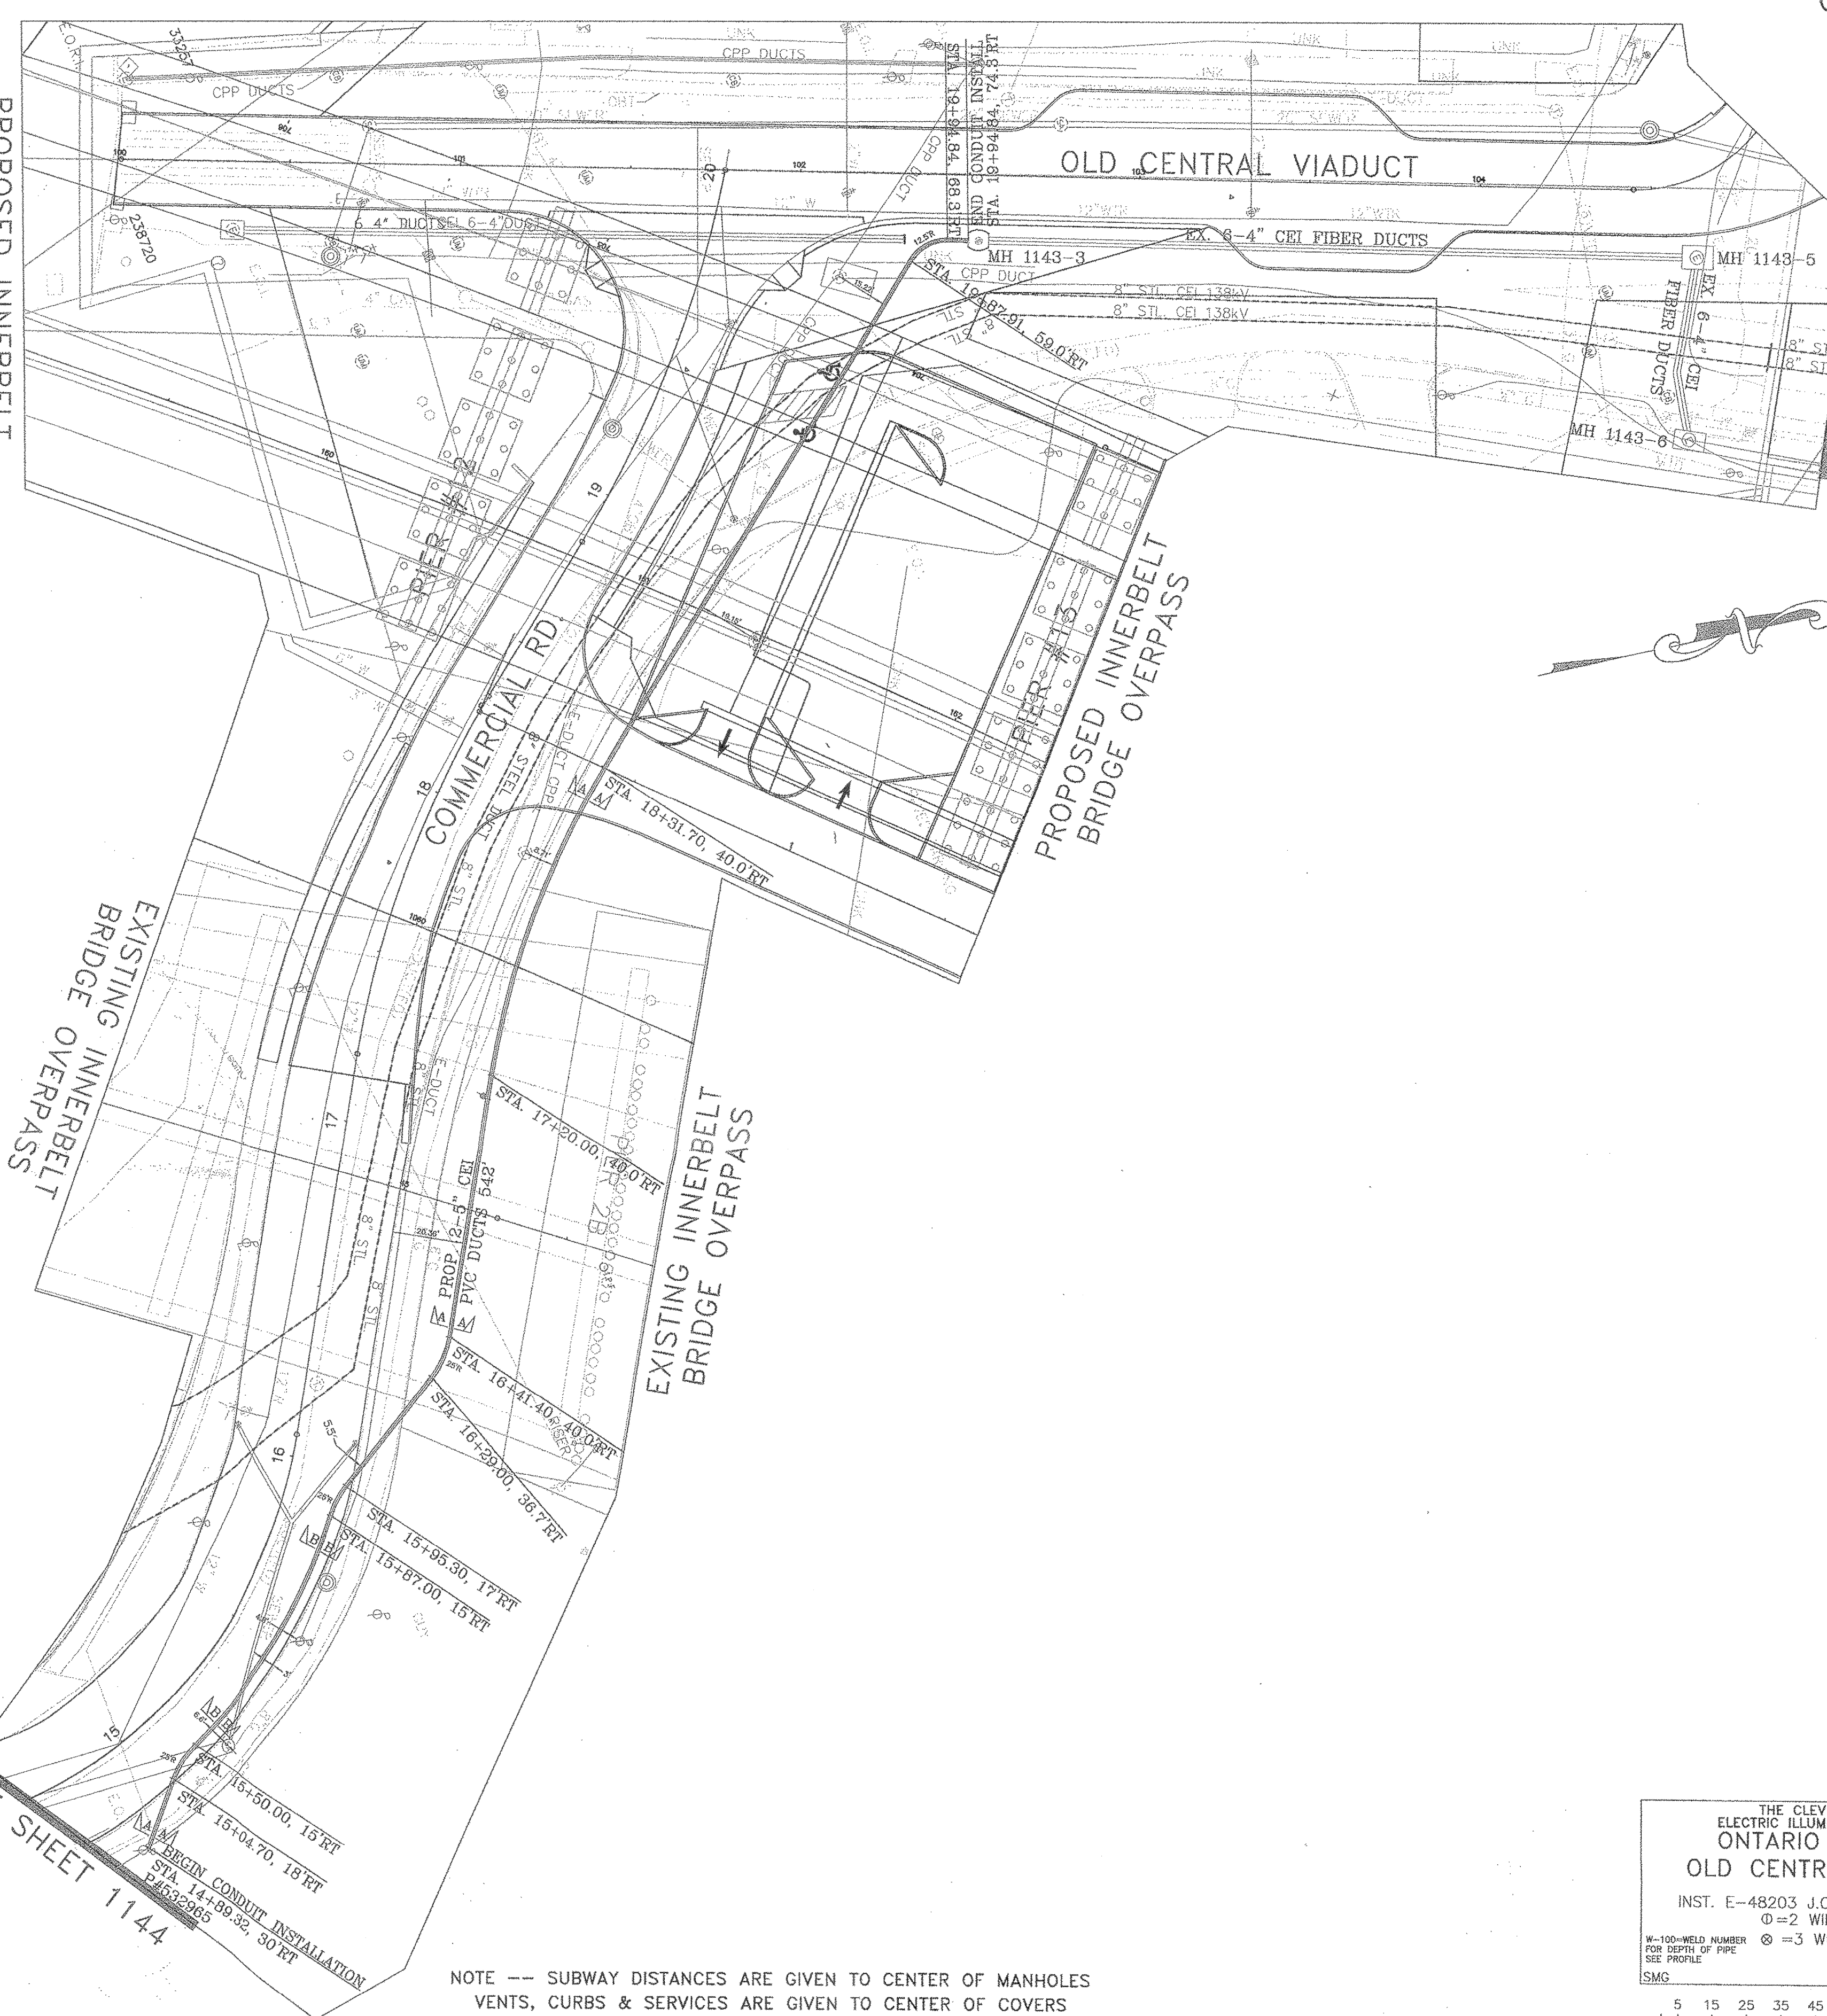


SEE SHEET 1143E

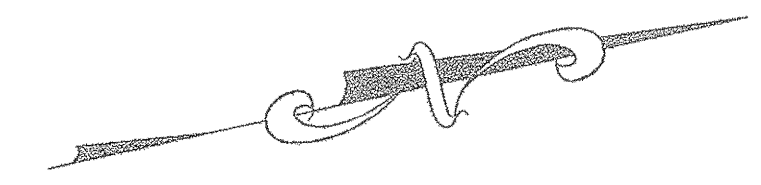

THE C.E.I. CO.	REQUESTED JSD 8/15/11	FAC. MAPPING REFERENCE #	GRID # 4722
FILE 53724361	DATE 5/19/11	SHEET 1 OF 3	
SURVEY FOR INNERBELT BRIDGE - COMMERCIAL RD. PROJECT			
ADDRESS COMMERCIAL RD. TO CENTRAL AVE			
MUNICIPALITY CITY OF CLEVELAND	SCALE	NONE	
ORDER FOR OHIO DEPARTMENT OF TRANSPORTATION			
PREPARED BY SURVEY OFFICE	DRAWN BY CHATFIELD	PHONE	440.717.6846
H-5-CN-P CABLE POLE RELOCATION WORK - OH TO UG (KNOWN AS ODOT PHASE 3)			
CNST. PLANS APPROVED	JOINT PROPOSAL		
MARKETING	SAPOR	13002553	J.D.
CONSUMER'S CHARGE			
DATE	REC.	FDR-EST	Q.M.
5/19/11	2	1	2
CABLE SERV	RDD	DMCS	MCR3
1	1	1	1
DEBI	RJS1	TOTAL	
1	1	10	
RETURN TO RIGHT-OF-WAY BEFORE SCHEDULING			
JOINT POLE RELEASE			
GANG MEET			
TREE WORK			
MUNICIPAL PERMIT INFO			
DATE CLEARED			
DATE	DESCRIPTION		APPROVED BY
A CHECK MARK NEXT TO EACH ITEM ON THE SKETCH, INCLUDING CHANGES, INDICATES THAT THE WORK HAS BEEN COMPLETED			
KIND OF POLES INSTALLED BY SYMBOL	ITEMS	UNITS OF WORK COMPLETED	
	POLES	INSTALLED	REMOVED
	WIRE		
	ANCHORS		
DATE WORK COMPLETED			
SUPERVISOR'S SIGNATURE			
UNDERGROUND FACILITIES WARNING			
HIGH PRESSURE PIPELINE	AT SYMBOL	CHECKED BY	SPECIAL INSTRUCTIONS
CEI			
TELEPHONE			
D. H. TRANSMISSION CLEARANCE WARNING			
AT SYMBOLS			
ENGINEERING CHECKED BY	DATE		
CONSTRUCTION CHECKED BY	DATE		

CONFIDENTIAL
FIRSTENERGY CORP.

INFORMATION IN THIS DOCUMENT IS PROPRIETARY AND SHALL NOT BE USED, COPIED, REPRODUCED OR DISCLOSED IN WHOLE OR IN PART WITHOUT THE WRITTEN CONSENT OF FIRSTENERGY CORP.

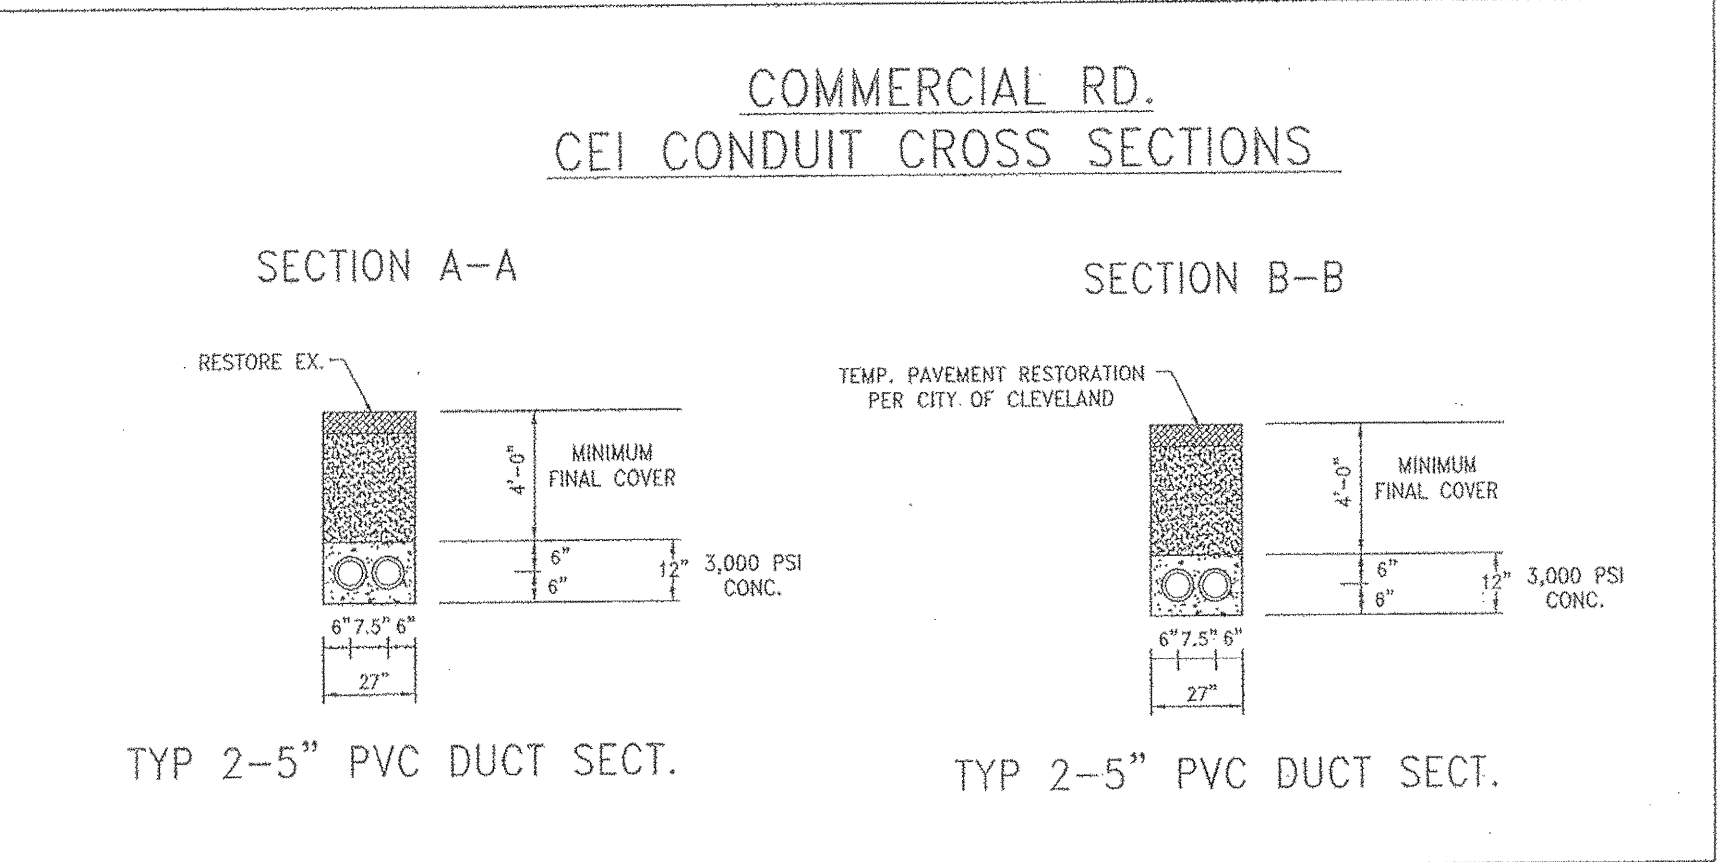

CORRECTIONS	DATE	BY
FOR PREVIOUS CORR SEE OLD DRAWINGS	JAN 30 67	
REM VENT NO. 6 RESE CASTINGS 5 & 6 E-45204 J-33384	5-4-84	W.S.S.
INNERBELT BRIDGE RELD.	5-9-11	SMG

THE CLEVELAND
ELECTRIC ILLUMINATING CO.
ONTARIO STREET
OLD CENTRAL VIADUCT
INST. E-48203 J.O.-14921 12-4-58
REDRAWN 12-01-11
Ø=2 WIRE #14 THERMOCOUPLE
Ø=3 WIRE #14 THERMOCOUPLE
W-100-WELD NUMBER FOR DEPTH OF PIPE
SEE PROFILE
SMG
SHEET 1143-W

