

PROJECT: INNERBELT BR PROJ - OH TO UG  
 ADDRESS: FAIRFIELD AVE & SCRANTON RD  
 MUNICIPALITY: CITY OF CLEVELAND  
 DRAWN BY: GILL  
 SURVEY OFFICE: OHIO DEPARTMENT OF TRANSPORTATION  
 PHONE: 440.717.6846

CONSTRUCTION: CIRCUIT RELOCATION WORK - OH TO UG

DATE	REC.	FOR-EST	OH	SUB-WAY	CABLE	SERV	RDD	DMC3	BET2	DEBI	RJS1	TOTAL
8/19/11	2		1		2		1	1	1	1	1	10

CONSUMER'S CHARGE: ---

MARKETING: SAPDH 12769676 J.D.

DATE	DESCRIPTION	APPROVED BY

ITEMS	UNITS OF WORK COMPLETED		
	INSTALLED	REMOVED	SHIFTED
POLES			
WIRE			
ANCHORS			

DATE WORK COMPLETED: \_\_\_\_\_  
 SUPERVISORS SIGNATURE: \_\_\_\_\_


UNDERGROUND FACILITIES WARNING  
 HIGH PRESSURE PIPELINE AT \_\_\_\_\_ CHECKED BY \_\_\_\_\_  
 TELEPHONE AT \_\_\_\_\_

D.H. TRANSMISSION CLEARANCE WARNING  
 FT. MIN. CLEARANCE REQUIRED AT \_\_\_\_\_ DEGREES F.  
 ENGINEERING CHECKED BY: \_\_\_\_\_ DATE: \_\_\_\_\_  
 CONSTRUCTION CHECKED BY: \_\_\_\_\_ DATE: \_\_\_\_\_

**CONFIDENTIAL**  
 FIRSTENERGY CORP.


INFORMATION IN THIS DOCUMENT IS PROPRIETARY AND SHALL NOT BE USED, COPIED, REPRODUCED OR DISCLOSED IN WHOLE OR IN PART WITHOUT THE WRITTEN CONSENT OF FIRSTENERGY CORP.

SEE SHEET 9306

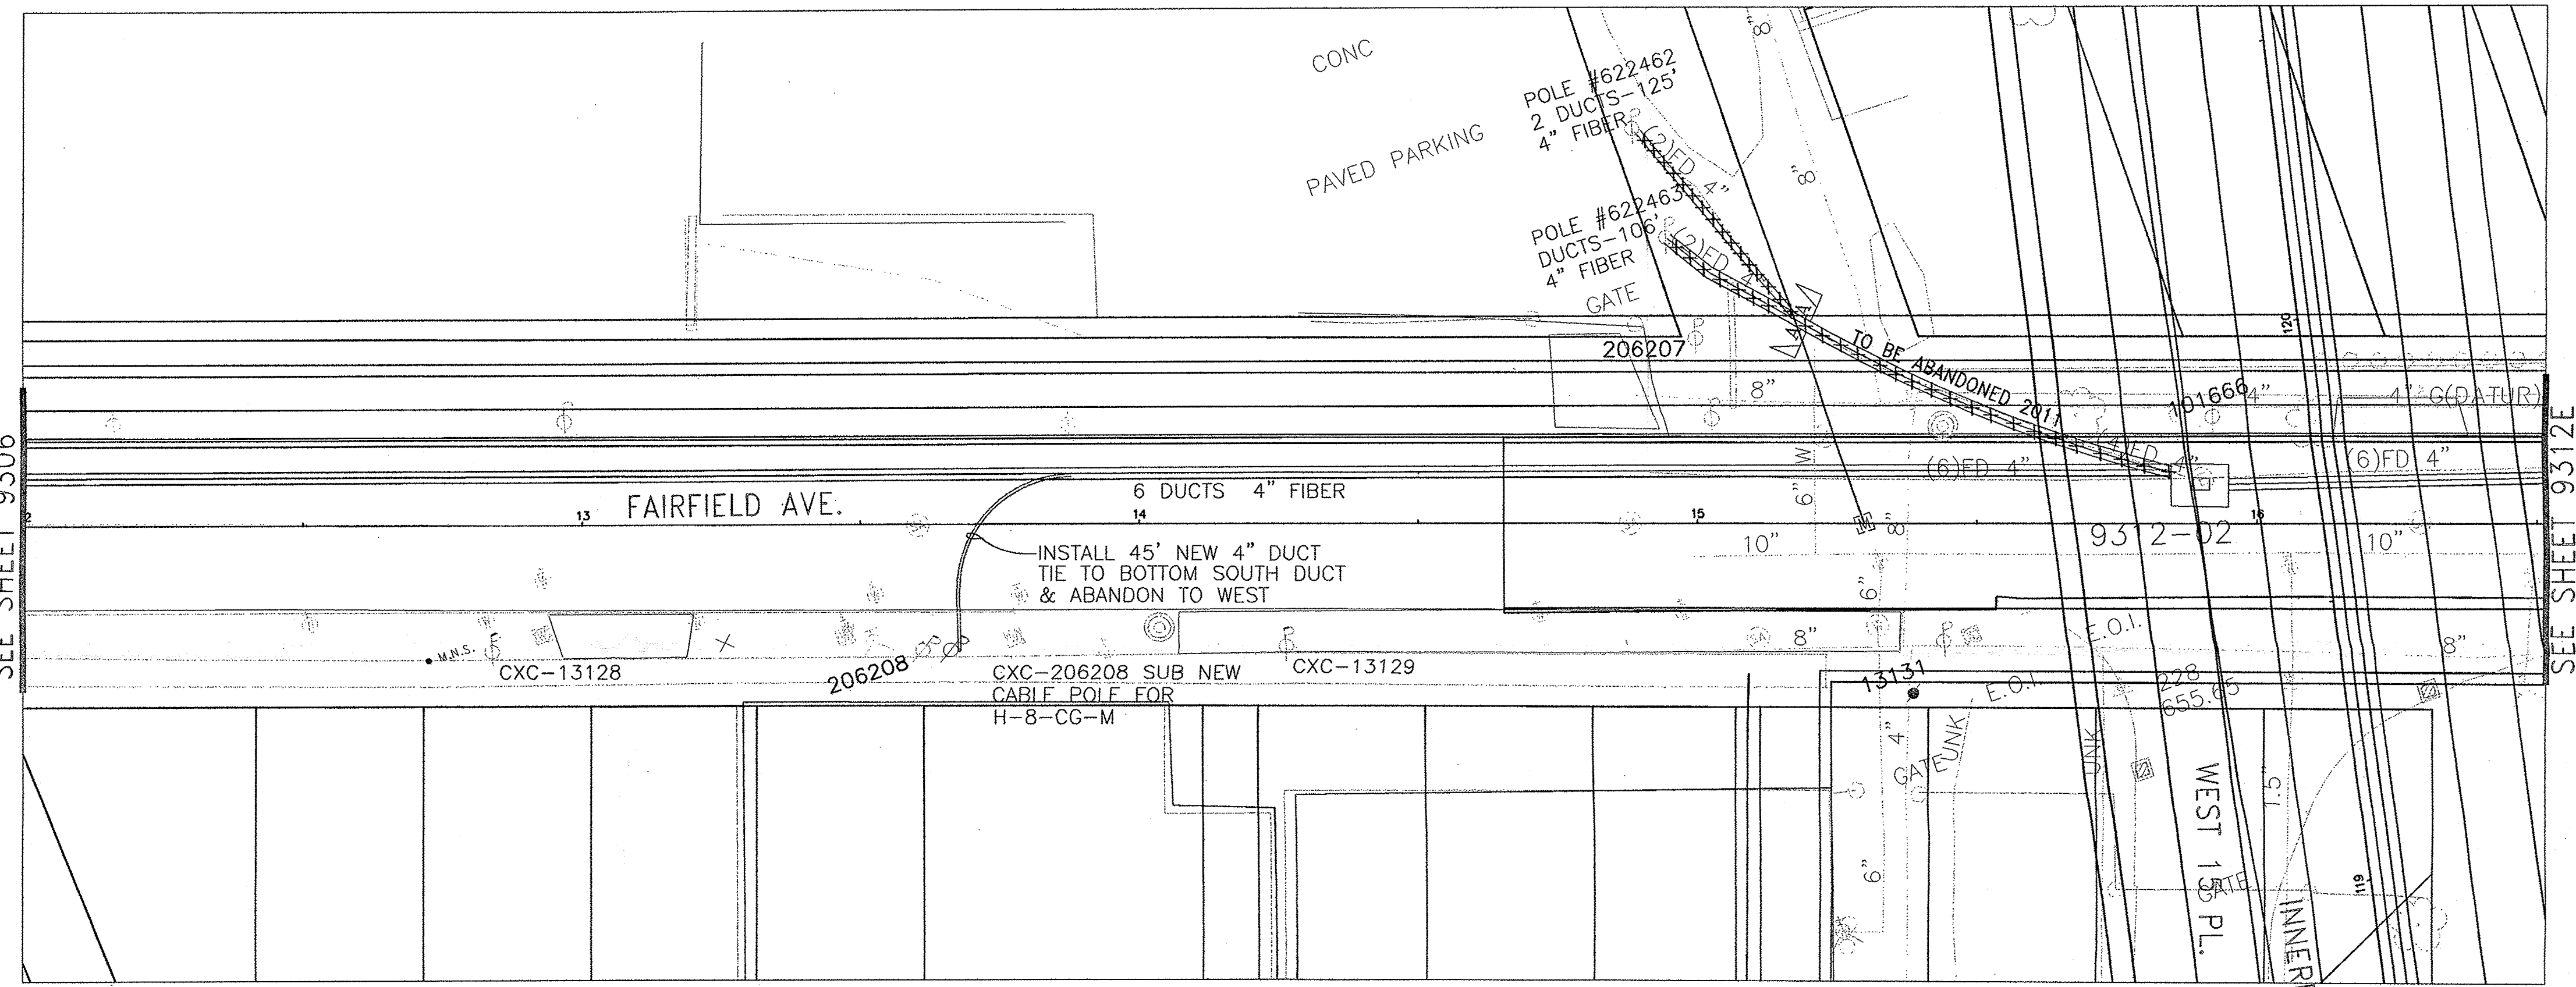

SEE SHEET 9312E


SECTION A-A

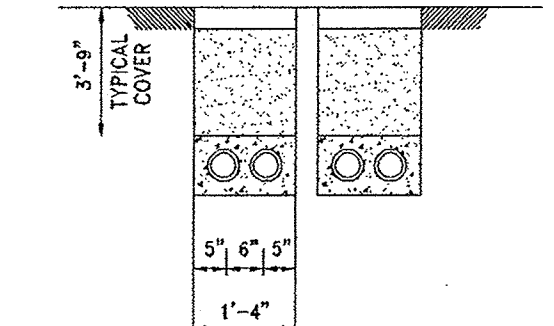

TYP 4-4" PVC DUCT SECT.  
 TO BE ABANDONED IN NOVEMBER 2011

CORRECTIONS	DATE	BY
REVISIONS		
FOR PREVIOUS CORR. SEE OLD DRAWING	8-19-11	SMG

THE CLEVELAND ELECTRIC ILLUMINATING CO.  
 FAIRFIELD  
 RE-DRAWN 8-19-11  
 SMG SHEET 9312W

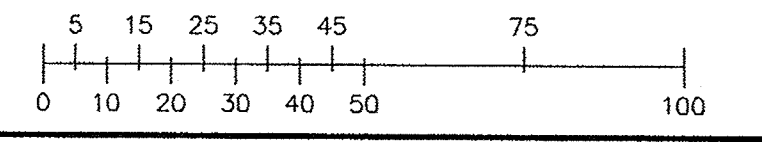

MZ126

NOTE -- SUBWAY DISTANCES ARE GIVEN TO CENTER OF MANHOLES VENTS, CURBS & SERVICES ARE GIVEN TO CENTER OF COVERS