


THE C.E.I. CO.	REQUESTED 11/15/11	FAC. MAPPING REFERENCE #	GRID # 4722									
FILE 52060694	DATE 8/19/11	SHEET 3 OF 6										
SURVEY FOR	INNERBELT BR PROJ - OH TO UG											
ADDRESS	FAIRFIELD AVE & SCRANTON RD											
MUNICIPALITY	CITY OF CLEVELAND											
ORDER FOR	OHIO DEPARTMENT OF TRANSPORTATION											
PREPARED BY	SURVEY OFFICE	DRAWN BY GILL	PHONE 440.717.6846									
DESCRIPTION	CIRCUIT RELOCATION WORK - OH TO UG											
CONST. PLANS APPROVED	JOINT PROPOSAL											
MARKETING	SAPM# 12769676	J.D.										
CONSUMER'S CHARGE												
DATE	REC.	FDR-EST	DM.	SUB-WAY	CABLE	SERV	RDD	DMCS	BETS	DEB1	RJS1	TOTAL
8/19/11	2	1	2	1	1	1	1	1	1	1	1	10
RETURN TO RIGHT-OF-WAY BEFORE SCHEDULING				JOINT POLE RELEASE		GANG MEET		TREE WORK		MUNICIPAL PERMIT INFO		
DATE CLEARED												
REVISION HISTORY				DATE		DESCRIPTION		APPROVED BY				
CONSTRUCTION				A CHECK MARK NEXT TO EACH ITEM ON THE SKETCH, INCLUDING CHANGES, INDICATES THAT THE WORK HAS BEEN COMPLETED		ITEMS		UNITS OF WORK COMPLETED				
						POLES		INSTALLED		REMOVED		SHIFTED
						WIRE						
						FRAMES						
						ANCHORS						
				KIND OF POLES INSTALLED BY SYMBOL								
				POLES LEFT FOR TEL. TO REMOVE								
				DATE WORK COMPLETED		SUPERVISOR'S SIGNATURE						
CAUTION				UNDERGROUND FACILITIES WARNING		HIGH PRESSURE PIPELINE		AT SYMBOL		CHECKED BY		SPECIAL INSTRUCTIONS
				D.H. TRANSMISSION CLEARANCE WARNING		AT SYMBOLS		FT. MIN. CLEARANCE REQUIRED AT		DEGREES F.		
				ENGINEERING CHECKED BY		DATE						
				CONSTRUCTION CHECKED BY		DATE						

**CONFIDENTIAL**  
FIRSTENERGY CORP.

INFORMATION IN THIS DOCUMENT IS PROPRIETARY AND SHALL NOT BE USED, COPIED, REPRODUCED OR DISCLOSED IN WHOLE OR IN PART WITHOUT THE WRITTEN CONSENT OF FIRSTENERGY CORP.


GRID 4822  
ID-032

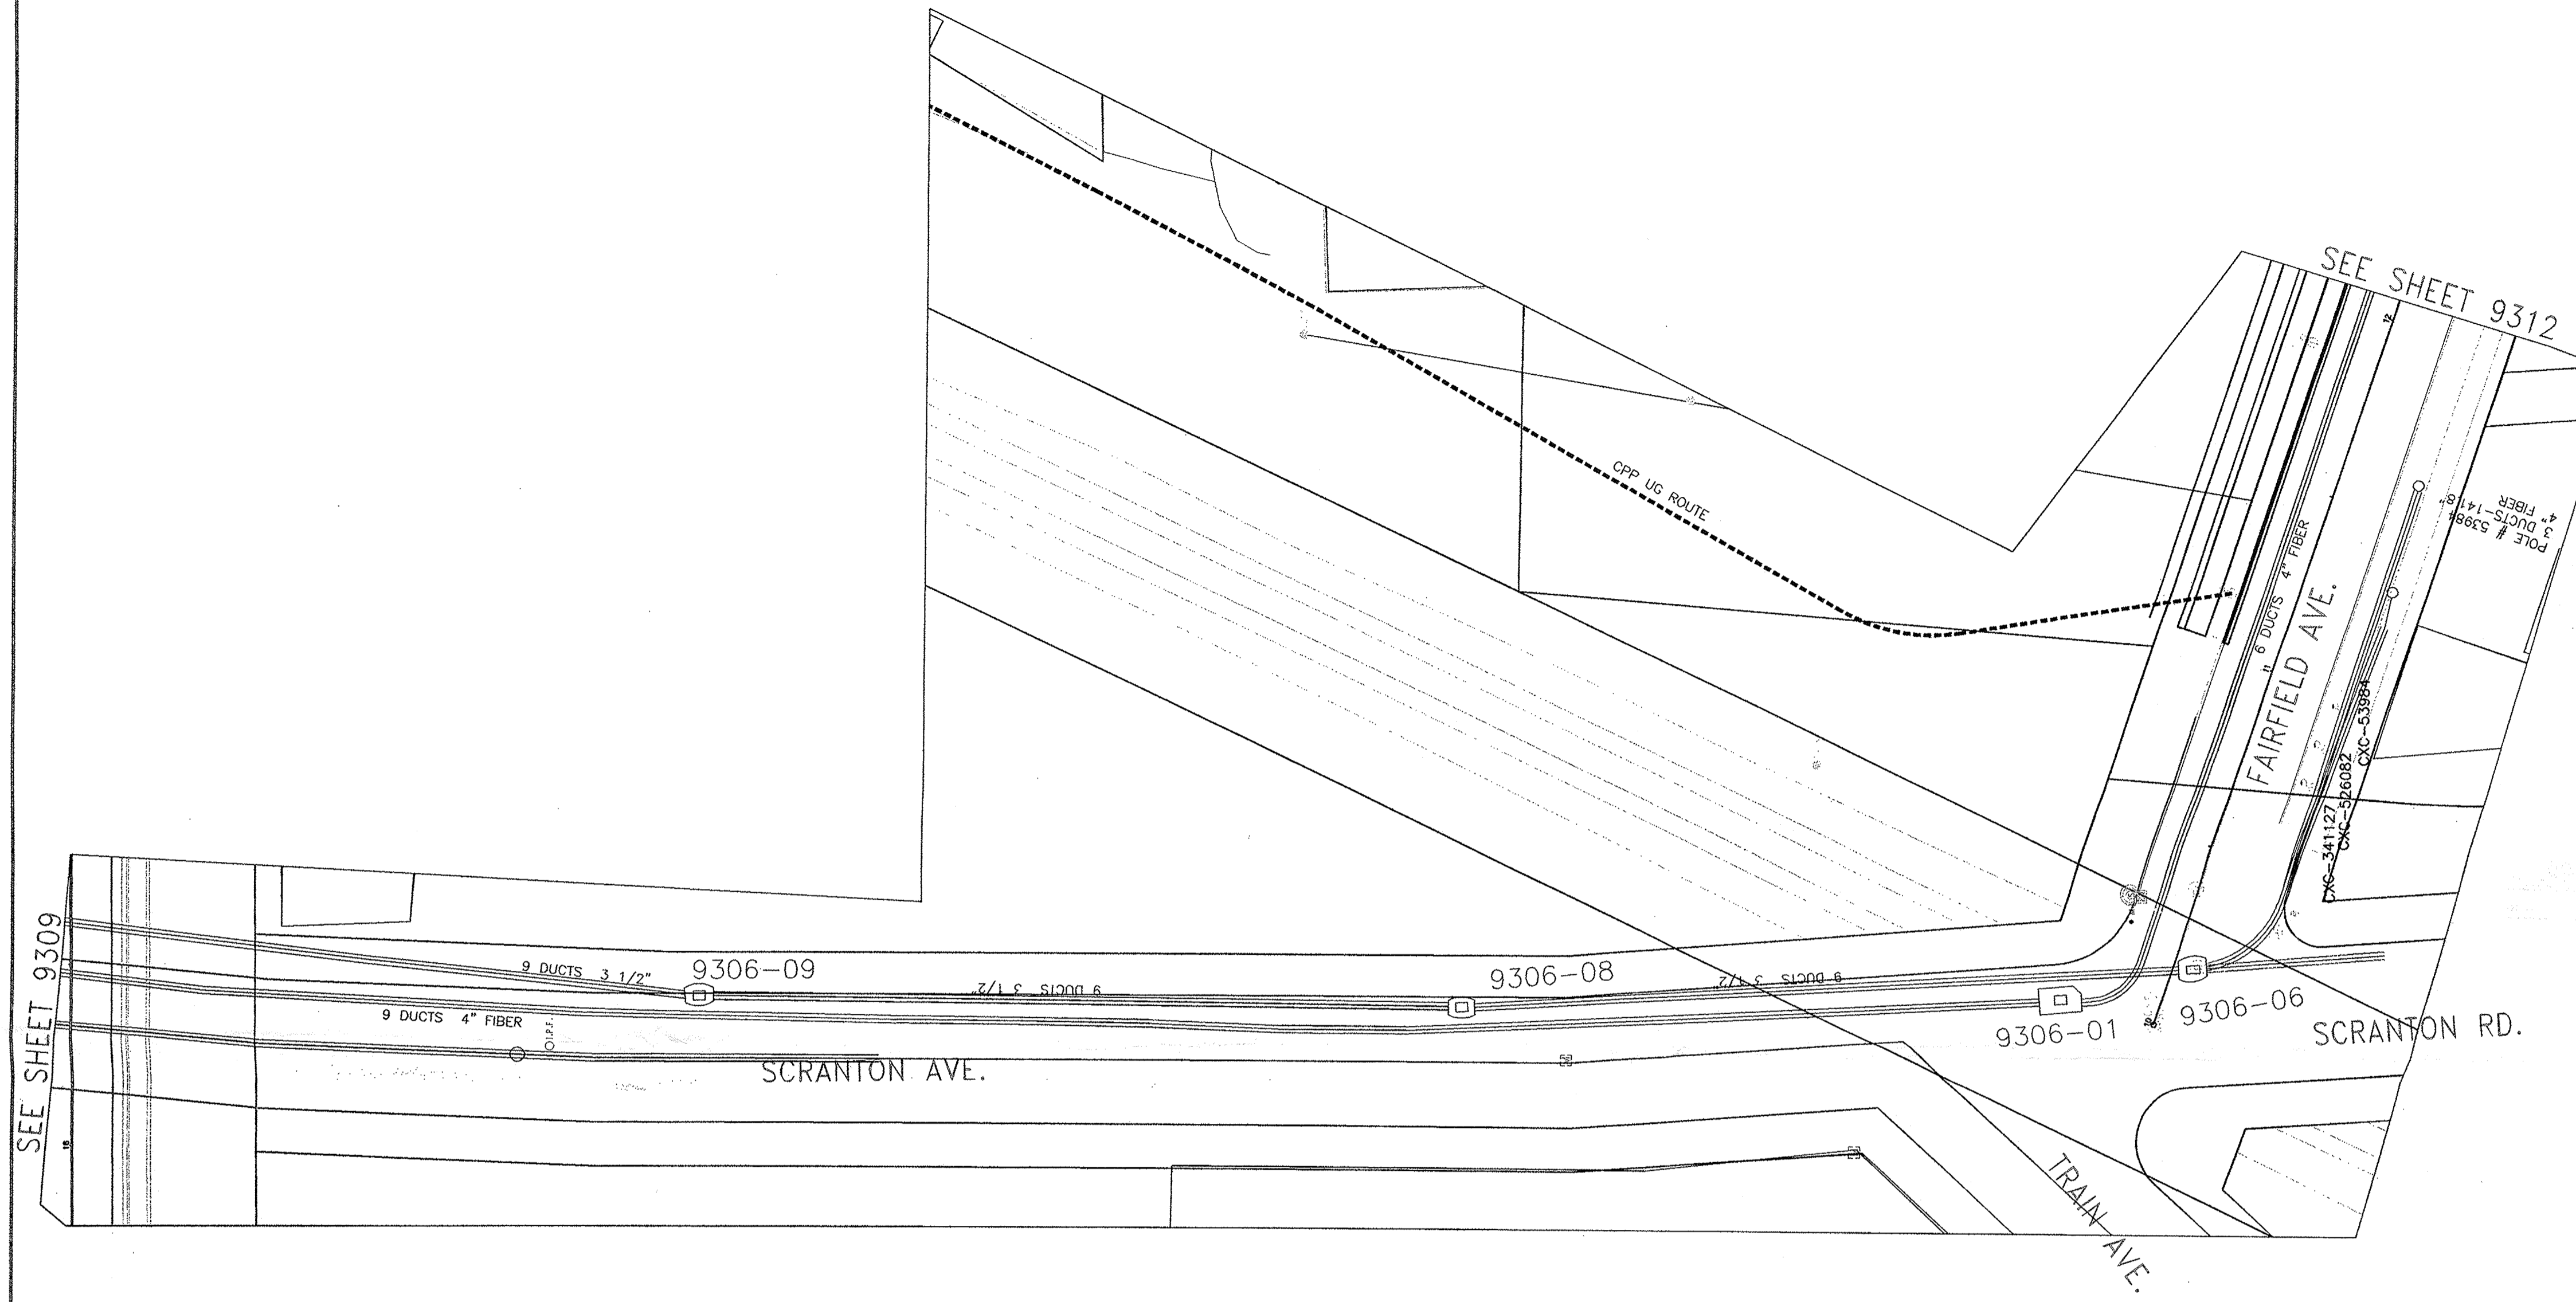

CORRECTIONS	DATE	BY
REVISIONS FOR PREVIOUS CORR. SEE OLD DRAWINGS		
FROM SHEET TO #25436 ABAND 3 DUCTS E-30491 J-47967	9-25-75	AGA
FROM SHEET TO #25436 ABAND 3 DUCTS E-30491 J-47967	3-15-78	TRT
REN. VENT NO.6	10-10-84	DS
	8-19-11	SMG

NOTE -- SUBWAY DISTANCES ARE GIVEN TO CENTER OF MANHOLES  
VENTS, CURBS & SERVICES ARE GIVEN TO CENTER OF COVERS

THE CLEVELAND ELECTRIC ILLUMINATING CO.  
**SCRANTON**  
RE-DRAWN 8-19-11  
SMG SHEET 9306N

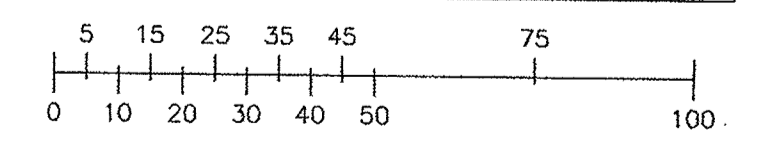

N9026