


THE C.E.I. CO.	REQUESTED 11/15/11	FAC. MAPPING REFERENCE #	GRID # 4722
FILE 52060694	DATE 8/19/11	SHEET 4 OF 6	
SURVEY FOR: INNERBELT BR PROJ -- OH TO UG	ADDRESS: FAIRFIELD AVE & SCRANTON RD		
MUNICIPALITY: CITY OF CLEVELAND	SCALE: NONE		
ORDER FOR: OHIO DEPARTMENT OF TRANSPORTATION	PREPARED BY: SURVEY OFFICE		
DRAWN BY: GILL	PHONE: 440.717.6846		
DESCRIPTION: CIRCUIT RELOCATION WORK -- OH TO UG			
CONST. PLANS APPROVED	JOINT PROPOSAL		
MARKETING	SAPOM 12769676	J.D.	
CONSUMER'S CHARGE			
DATE REC. FOR-EST	OH	SUB-WAY	CABLE
19 11 2	1	2	1
SERV	RDD	DMC3	BET2
1	1	1	1
BE1	RJS1	TOTAL	
1	1	10	
RETURN TO RIGHT-OF-WAY BEFORE SCHEDULING			
DATE CLEARED			
DATE	DESCRIPTION	APPROVED BY	
REVISION HISTORY			
A CHECK MARK NEXT TO EACH ITEM ON THE SKETCH, INCLUDING CHANGES, INDICATES THAT THE WORK HAS BEEN COMPLETED			
ITEMS	UNITS OF WORK COMPLETED		
POLES	INSTALLED	REMOVED	SHIFTED
WIRE			
ANCHORS			
KIND OF POLES INSTALLED BY SYMBOL			
POLES LEFT FOR TEL. TO REMOVE			
DATE WORK COMPLETED			
SUPERVISORS SIGNATURE			
UNDERGROUND FACILITIES WARNING			
HIGH PRESSURE PIPELINE	AT SYMBOL	CHECKED BY	SPECIAL INSTRUCTIONS
CEI			
TELEPHONE			
D.H. TRANSMISSION CLEARANCE WARNING			
AT SYMBOLS			
ENGINEERING CHECKED BY	DATE		
CONSTRUCTION CHECKED BY	DATE		

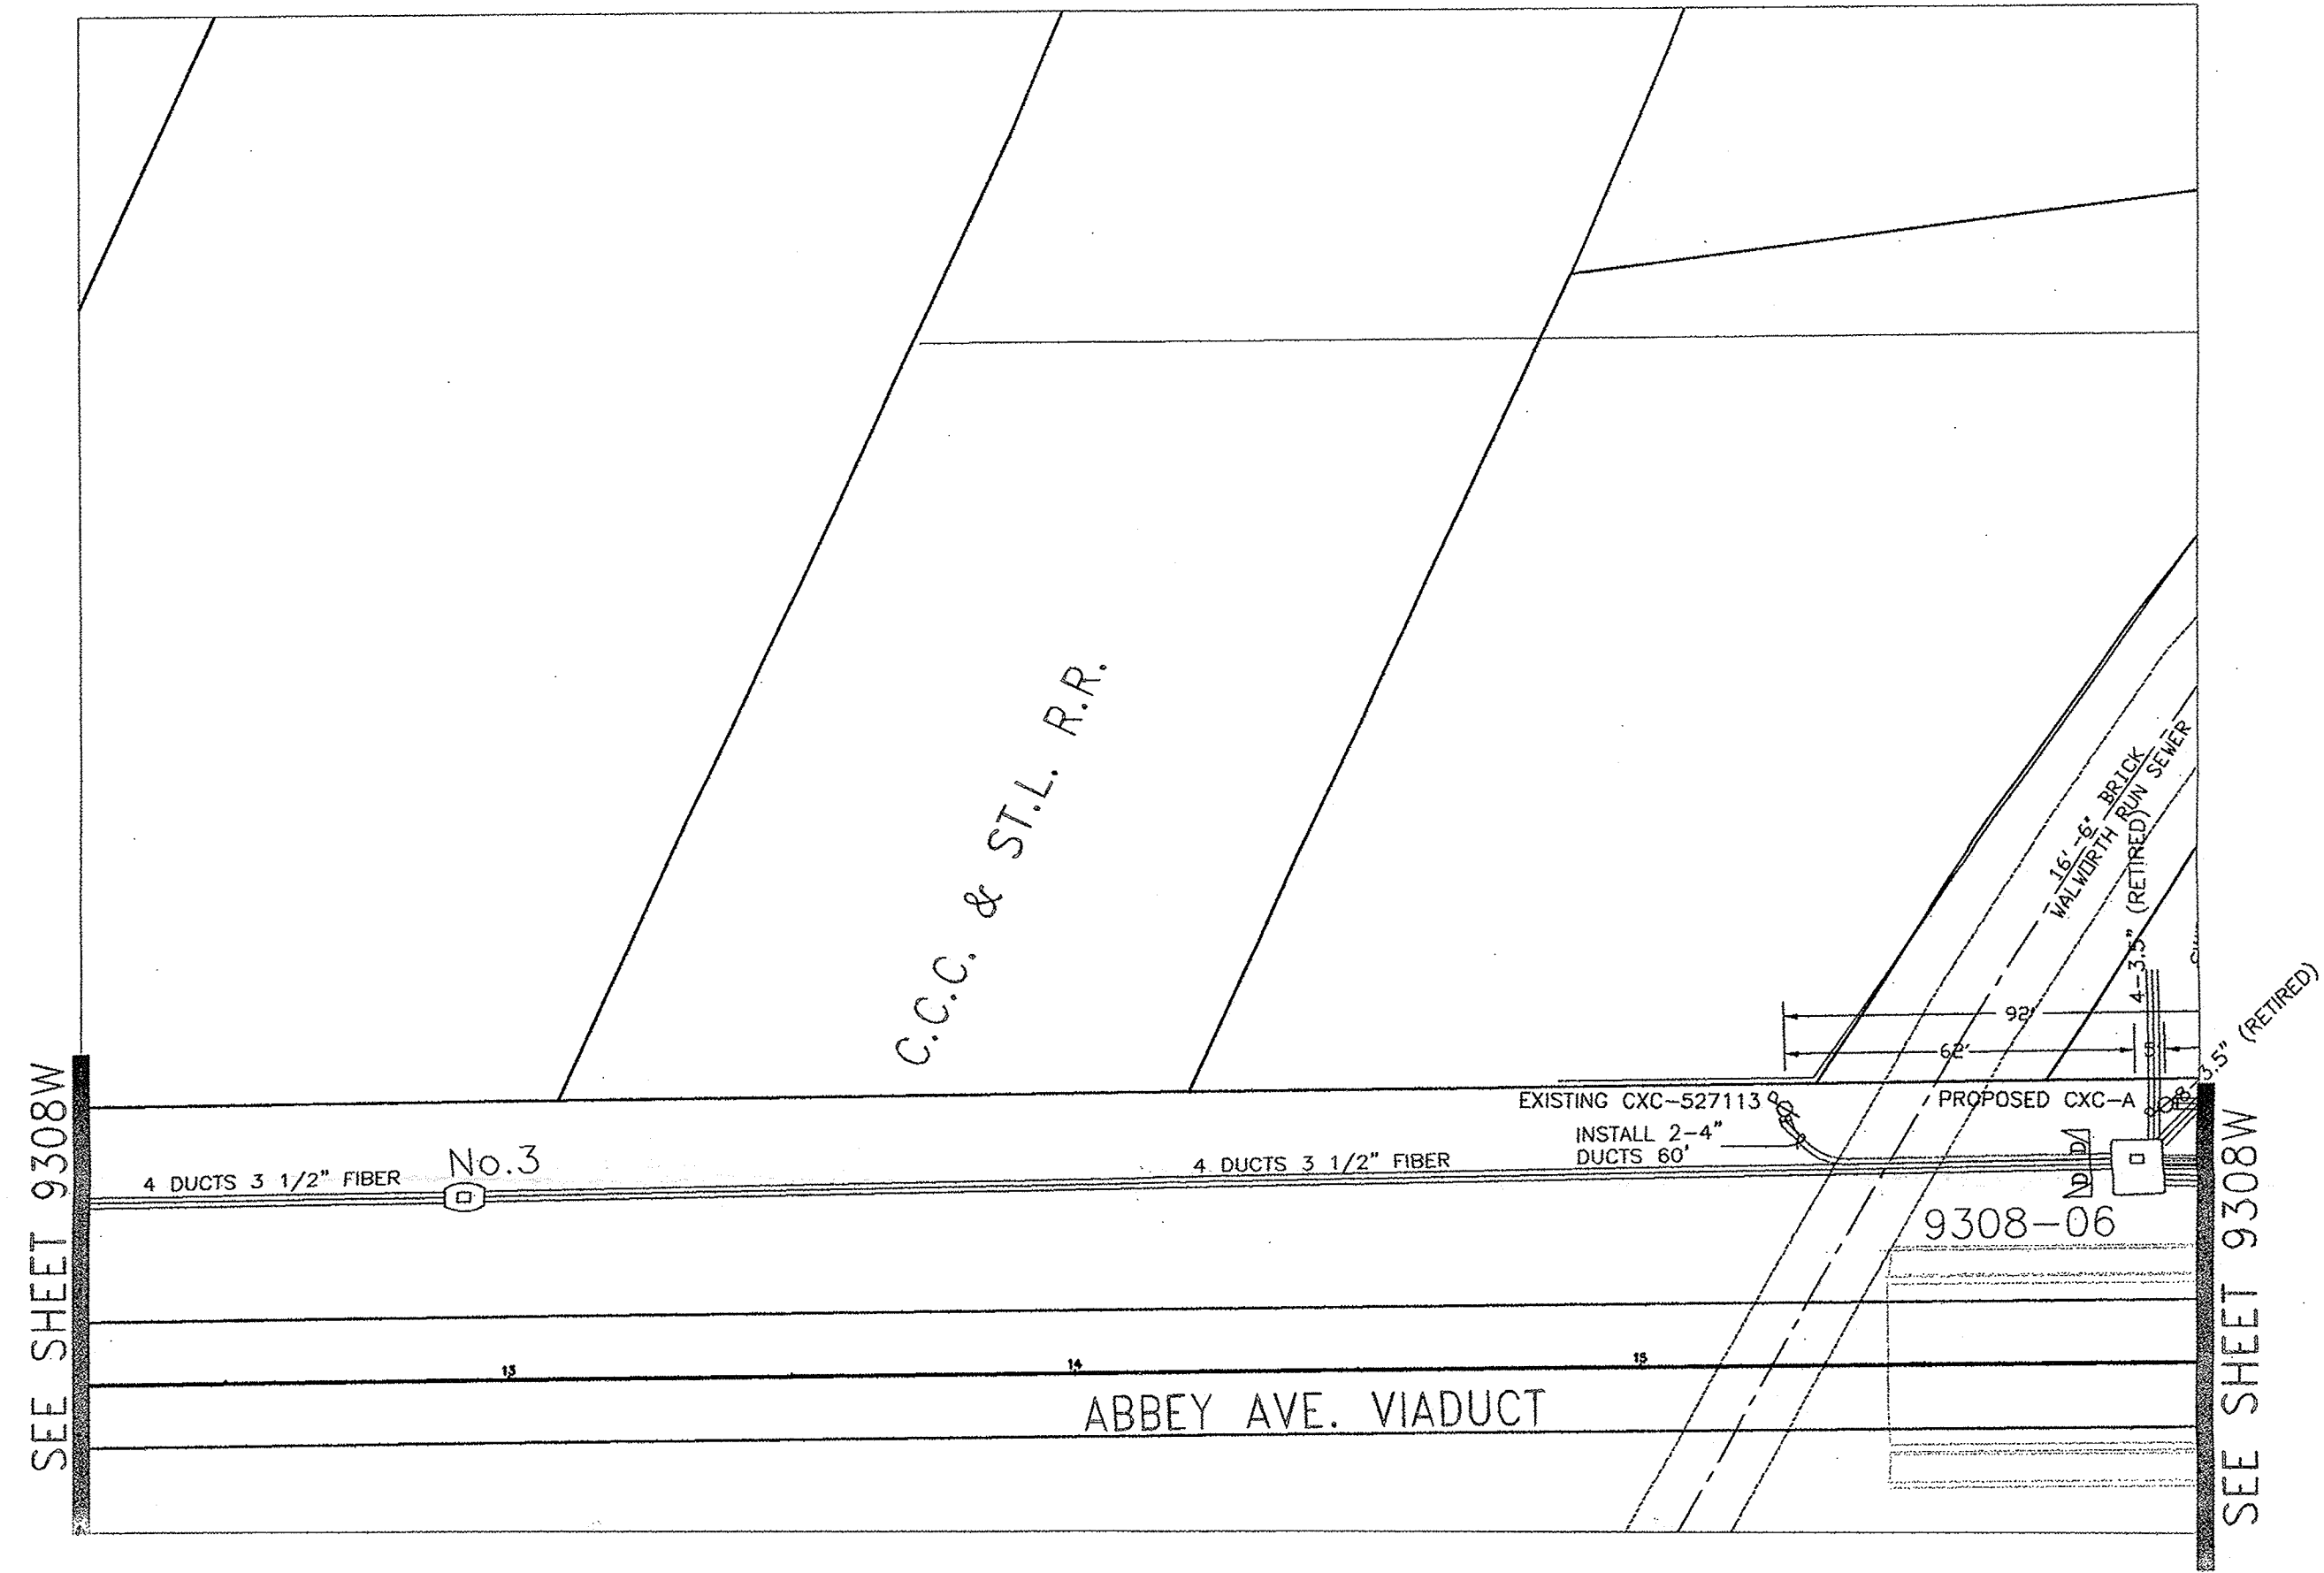

CORRECTIONS	DATE	BY
REVISIONS FOR PREVIOUS CORR. SEE OLD DRAWINGS	8-19-11	SMG

NOTE --- SUBWAY DISTANCES ARE GIVEN TO CENTER OF MANHOLES
VENTS, CURBS & SERVICES ARE GIVEN TO CENTER OF COVERS

THE CLEVELAND ELECTRIC ILLUMINATING CO.
ABBEE AVE. UNDER VIA.
RE-DRAWN 8-19-11
SMG SHEET 9308E

CONFIDENTIAL
FIRSTENERGY CORP.

INFORMATION IN THIS DOCUMENT IS PROPRIETARY AND SHALL NOT BE USED, COPIED, REPRODUCED OR DISCLOSED IN WHOLE OR IN PART WITHOUT THE WRITTEN CONSENT OF FIRSTENERGY CORP.