


THE C.E.I. CO.	REQUESTED ISSD 11/15/11	FAC. MAPPING REFERENCE #	GRID # 4722
FILE 52060694	DATE 8/19/11	SHEET 5 OF 6	
DESIGN			
SURVEY FOR INNERBELT BR PROJ - OH TO UG			
ADDRESS FAIRFIELD AVE & SCRANTON RD			
MUNICIPALITY CITY OF CLEVELAND SCALE: NONE			
ORDER FOR OHIO DEPARTMENT OF TRANSPORTATION			
PREPARED BY	SURVEY OFFICE	DRAWN BY GILL	PHONE 440.717.6846
DESCRIPTION			
CIRCUIT RELOCATION WORK - OH TO UG			
CONST. PLANS APPROVED			
MARKETING SAPDM 12769676 J.D.			
CONSUMER'S CHARGE			
DATE	REC. FOR EST.	DM. SUB-WAY	CABLE SERV. RDD DMC3
8/19/11	2	1	2 1 1 1 1 1 1 1 10
RETURN TO RIGHT-OF-WAY BEFORE SCHEDULING			
DATE CLEARED			
REVISION HISTORY			
DATE	DESCRIPTION		APPROVED BY


CONSTRUCTION			
A CHECK MARK NEXT TO EACH ITEM ON THE SKETCH, INCLUDING CHANGES, INDICATES THAT THE WORK HAS BEEN COMPLETED			
ITEMS	UNITS OF WORK COMPLETED		
POLES	INSTALLED	REMOVED	SHIFTED
WIRES			
BRACKETS			
ANCHORS			
KIND OF POLES INSTALLED BY SYMBOL			
POLES LEFT FOR TEL. TO REMOVE			
DATE WORK COMPLETED	SUPERVISORS SIGNATURE		
UNDERGROUND FACILITIES WARNING			
HIGH PRESSURE PIPELINE	AT SYMBOL	CHECKED BY	SPECIAL INSTRUCTIONS
CEI			
TELEPHONE			
D.H. TRANSMISSION CLEARANCE WARNING			
FT. MIN. CLEARANCE REQUIRED AT DEGREES F.			
AT SYMBOLS			
ENGINEERING CHECKED BY:		DATE	
CONSTRUCTION CHECKED BY:		DATE	

CONFIDENTIAL
FIRSTENERGY CORP.


INFORMATION IN THIS DOCUMENT IS PROPRIETARY AND SHALL NOT BE USED, COPIED, REPRODUCED OR DISCLOSED IN WHOLE OR IN PART WITHOUT THE WRITTEN CONSENT OF FIRSTENERGY CORP.

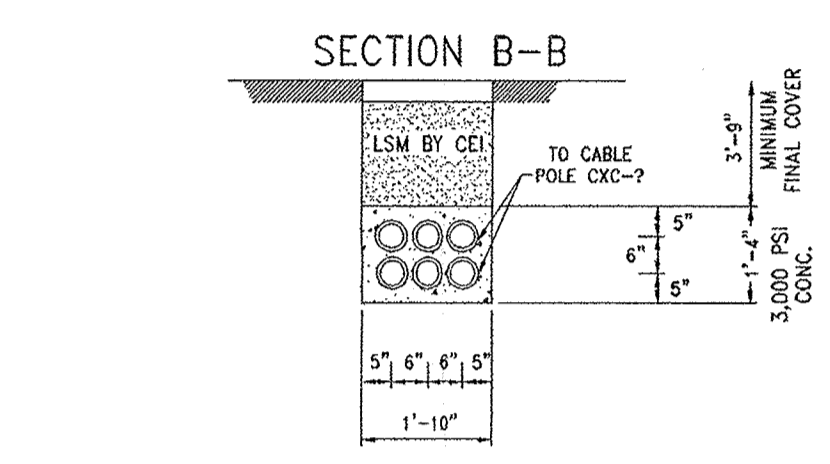


TYP 6-4" PVC DUCT SECT.
LOOKING SOUTH FROM 9309-2

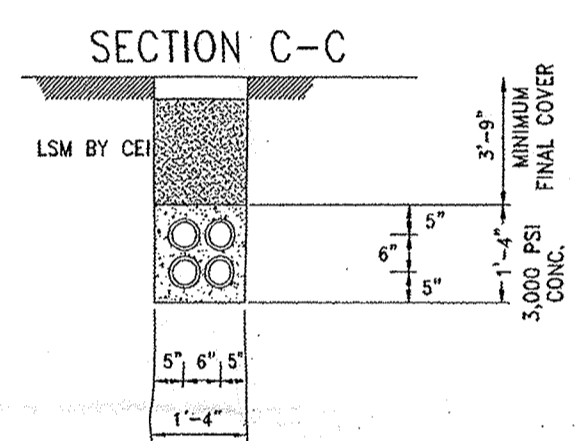

TYP 6-4" PVC DUCT SECT.
LOOKING SOUTH FROM 9309-2

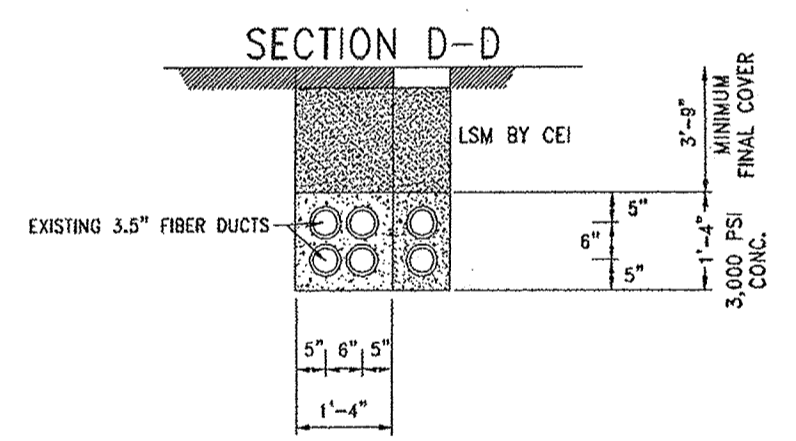

TYP 2-4" PVC DUCT SECT.
LOOKING EAST FROM 9308-6

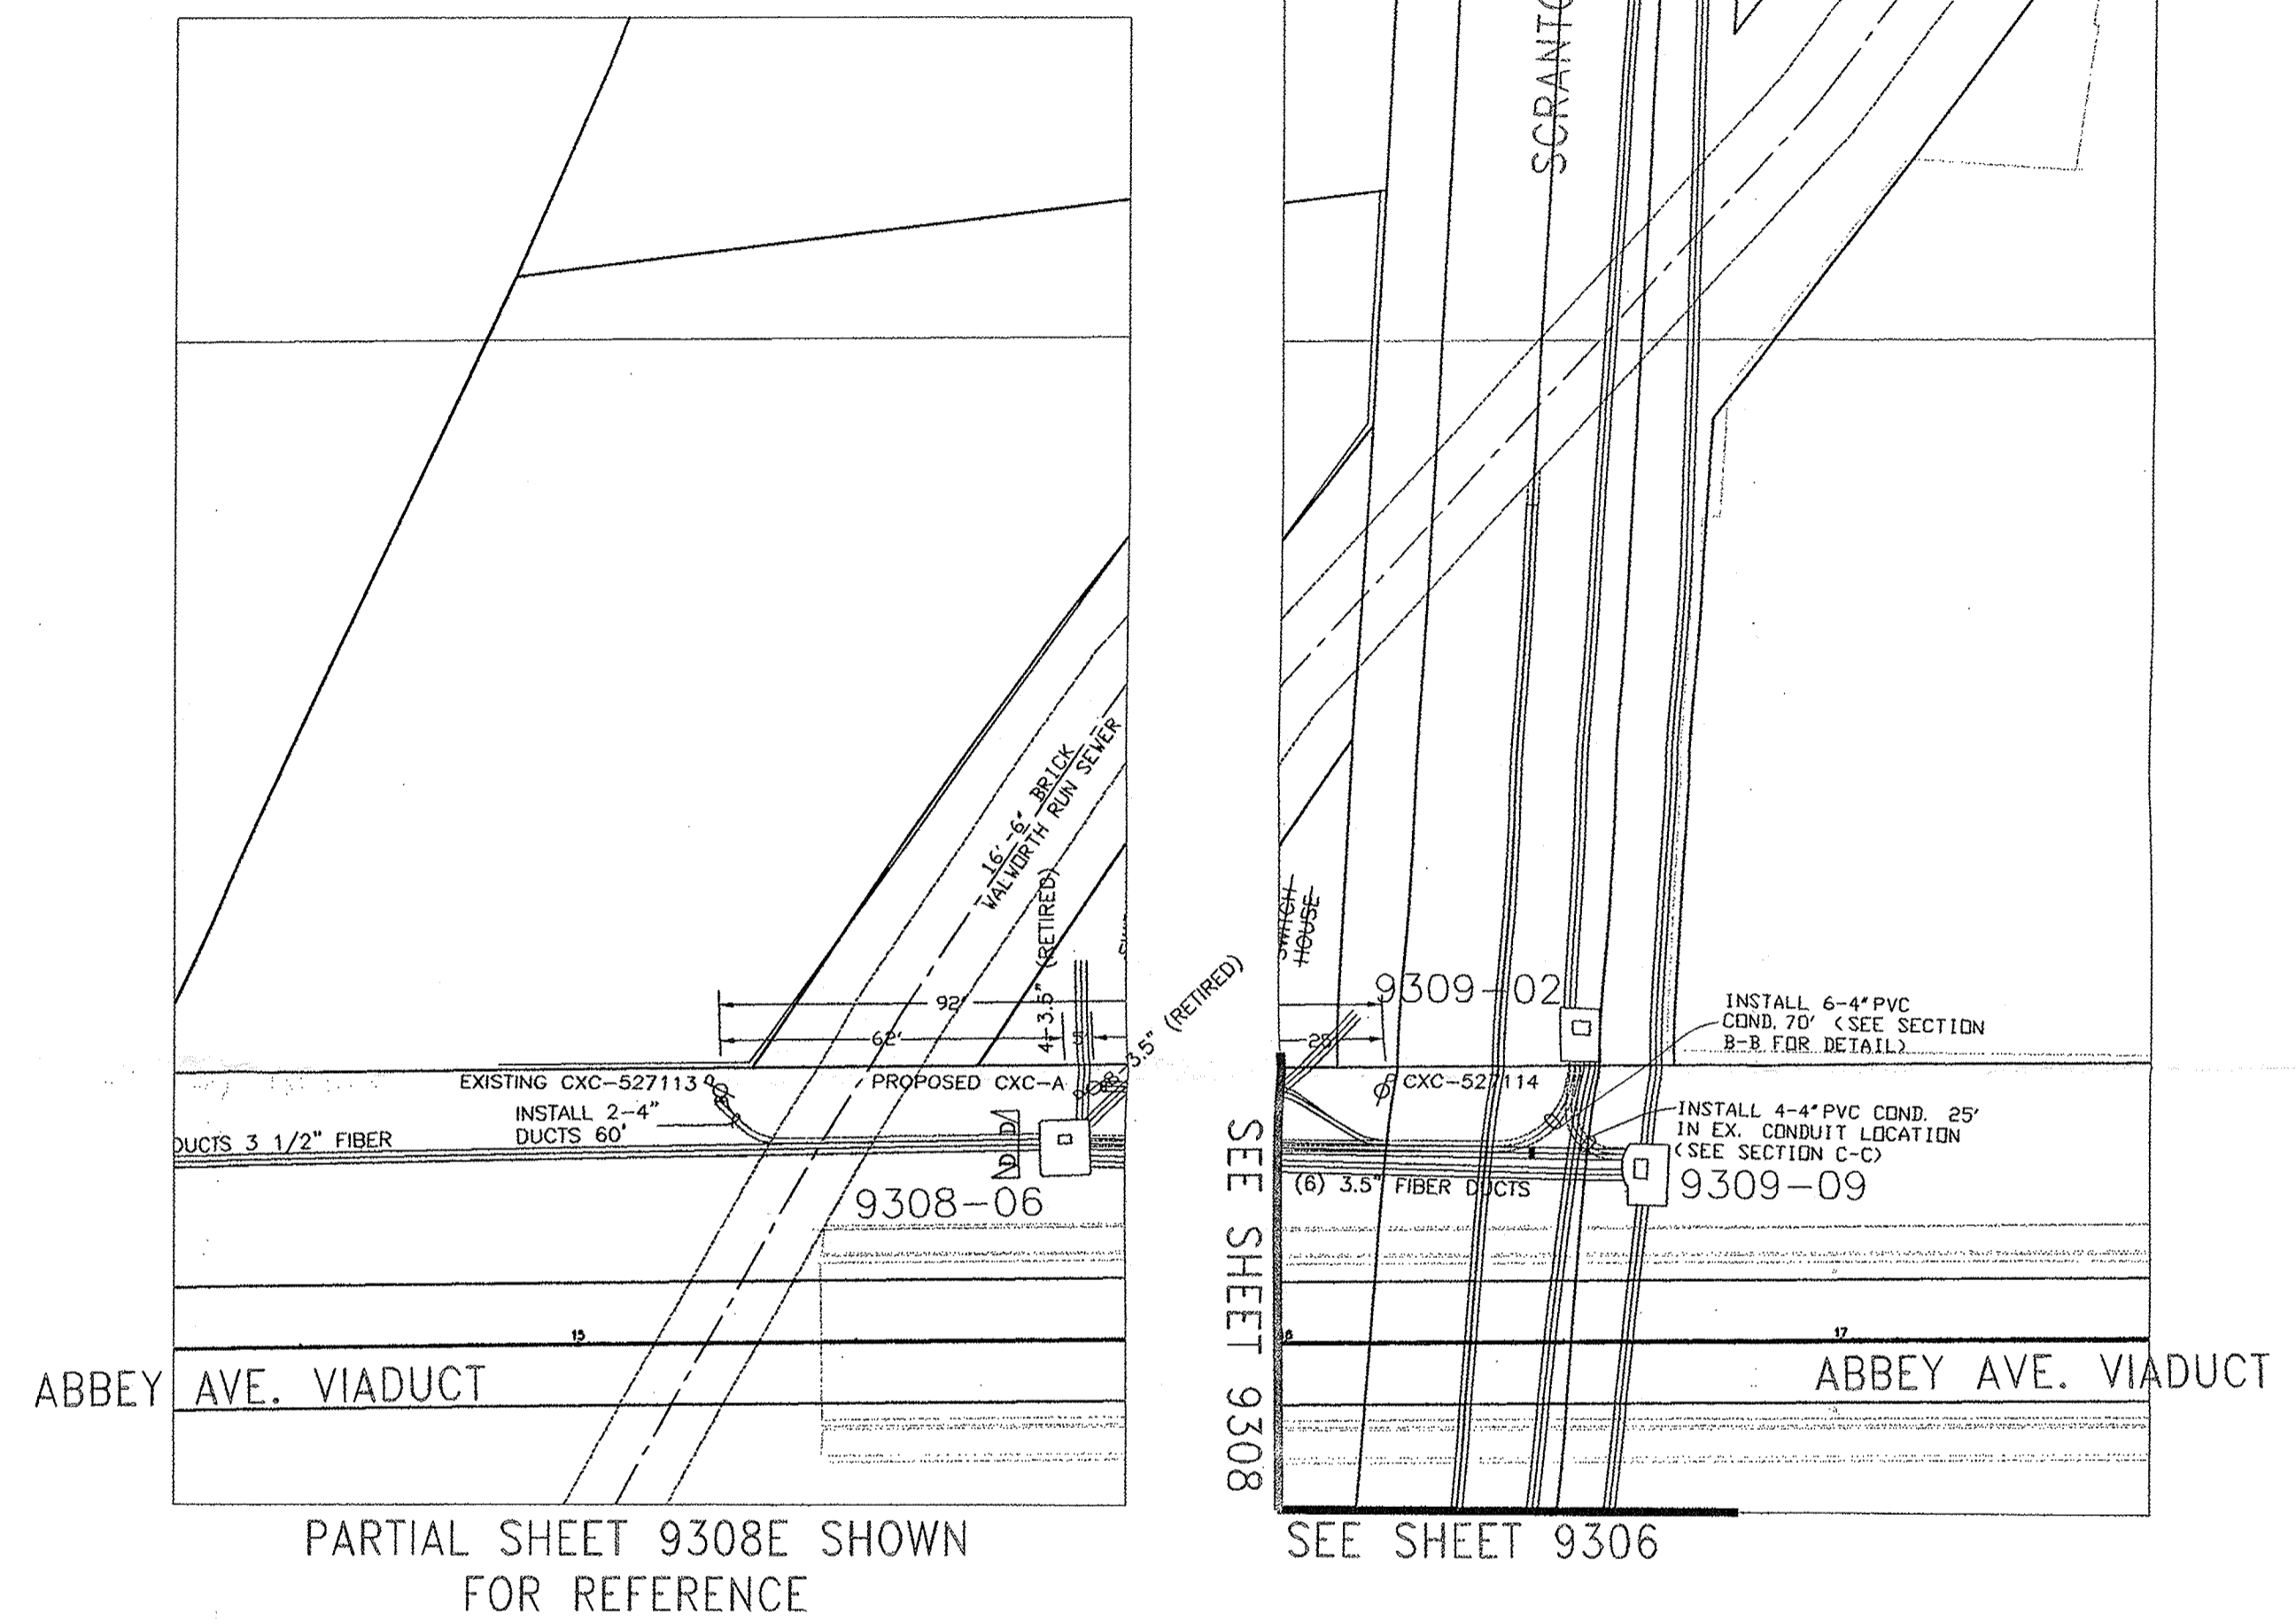


PARTIAL SHEET 9308E SHOWN FOR REFERENCE

CORRECTIONS	DATE	BY
REVISIONS		
FOR PREVIOUS CORR. SEE OLD DRAWING	8-19-11	SMG

NOTE -- SUBWAY DISTANCES ARE GIVEN TO CENTER OF MANHOLES VENTS, CURBS & SERVICES ARE GIVEN TO CENTER OF COVERS

THE CLEVELAND
ELECTRIC ILLUMINATING CO.
SCRANTON
RE-DRAWN 8-19-11
SMG SHEET 9309S

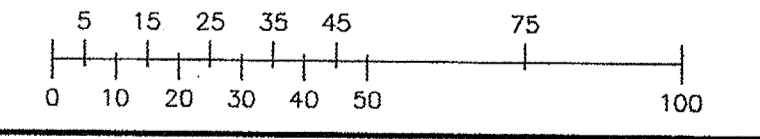

S6096