


CONTRACTOR TO INSTALL 2" BYPASS, BAG, AND TIE EX. 12" STEEL TO NEW 12" POWERCRETE W/711 DRESSER COUPLINGS. CONTRACTOR TO USE 4-12" 90° ELLS TO OFFSET L#1894 UNDER PROPOSED UNDERDRAIN (L#1894 TO HAVE 5' COVER, MIN.)

CONTRACTOR TO INSTALL 2" BYPASS, BAG, AND TIE EX. 12" STEEL TO NEW 12" POWERCRETE W/711 DRESSER COUPLINGS. CONTRACTOR TO USE 4-12" 45° ELLS TO OFFSET L#1894 AROUND PROPOSED CATCH BASIN

W.S. E22ND ST.
 REM & ABD 35'-12" LP STEEL
 RELOCATE 44'-12", .375W, X42, F.B.E
 WITH POWERCRETE COATING
 L#1894 - W#1W07350163

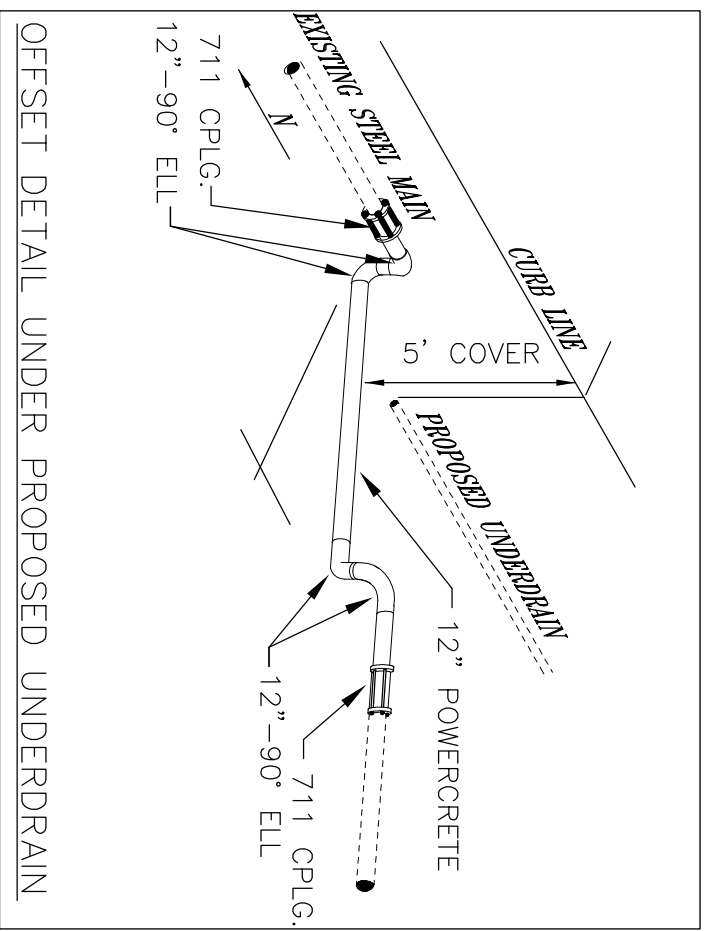

OFFSET DETAIL UNDER PROPOSED UNDERDRAIN