



AS-BUILT

Intelifiber Networks Commercial Road & Canal Road

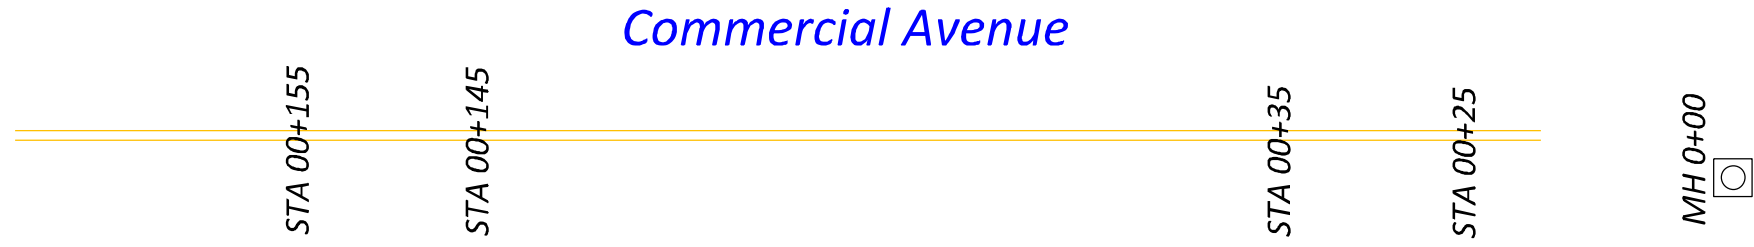

Covered (8) - 2" Conduits between MH 0+00 to STA 0+155 on Commercial Ave

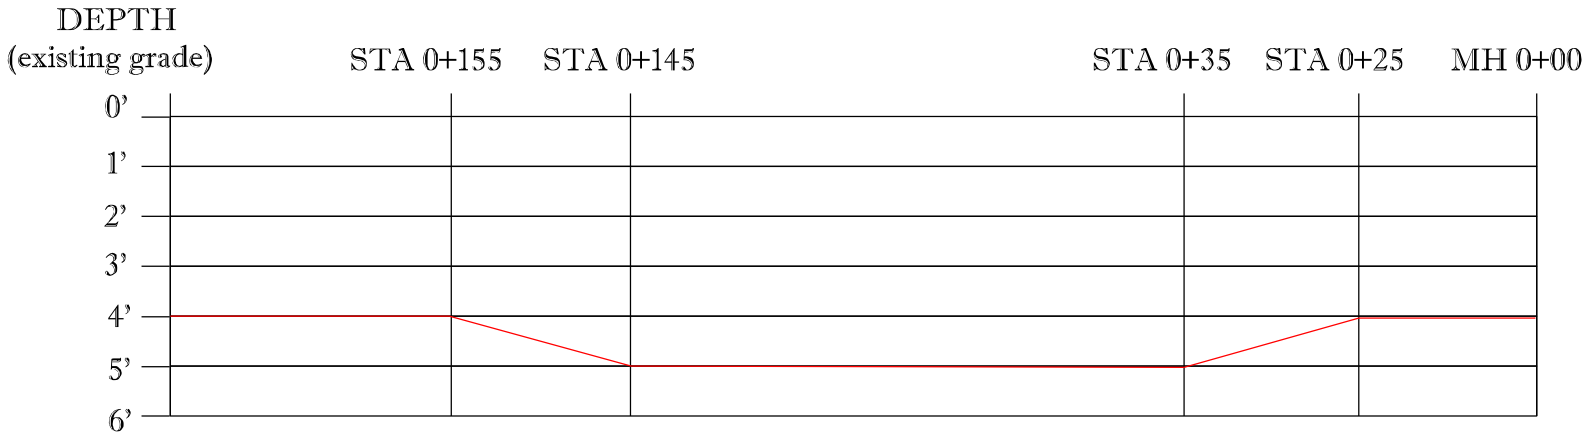


Utilities Construction Co.
 645 South Green Road
 South Euclid, Ohio 44121
 Office: (216) 381-8100 Fax: (216) 381-5422
 utilities@ohio.net

Company Name:

Intelifiber Networks

Job Description & Location:

Commercial Rd & Canal Rd

No Scale