
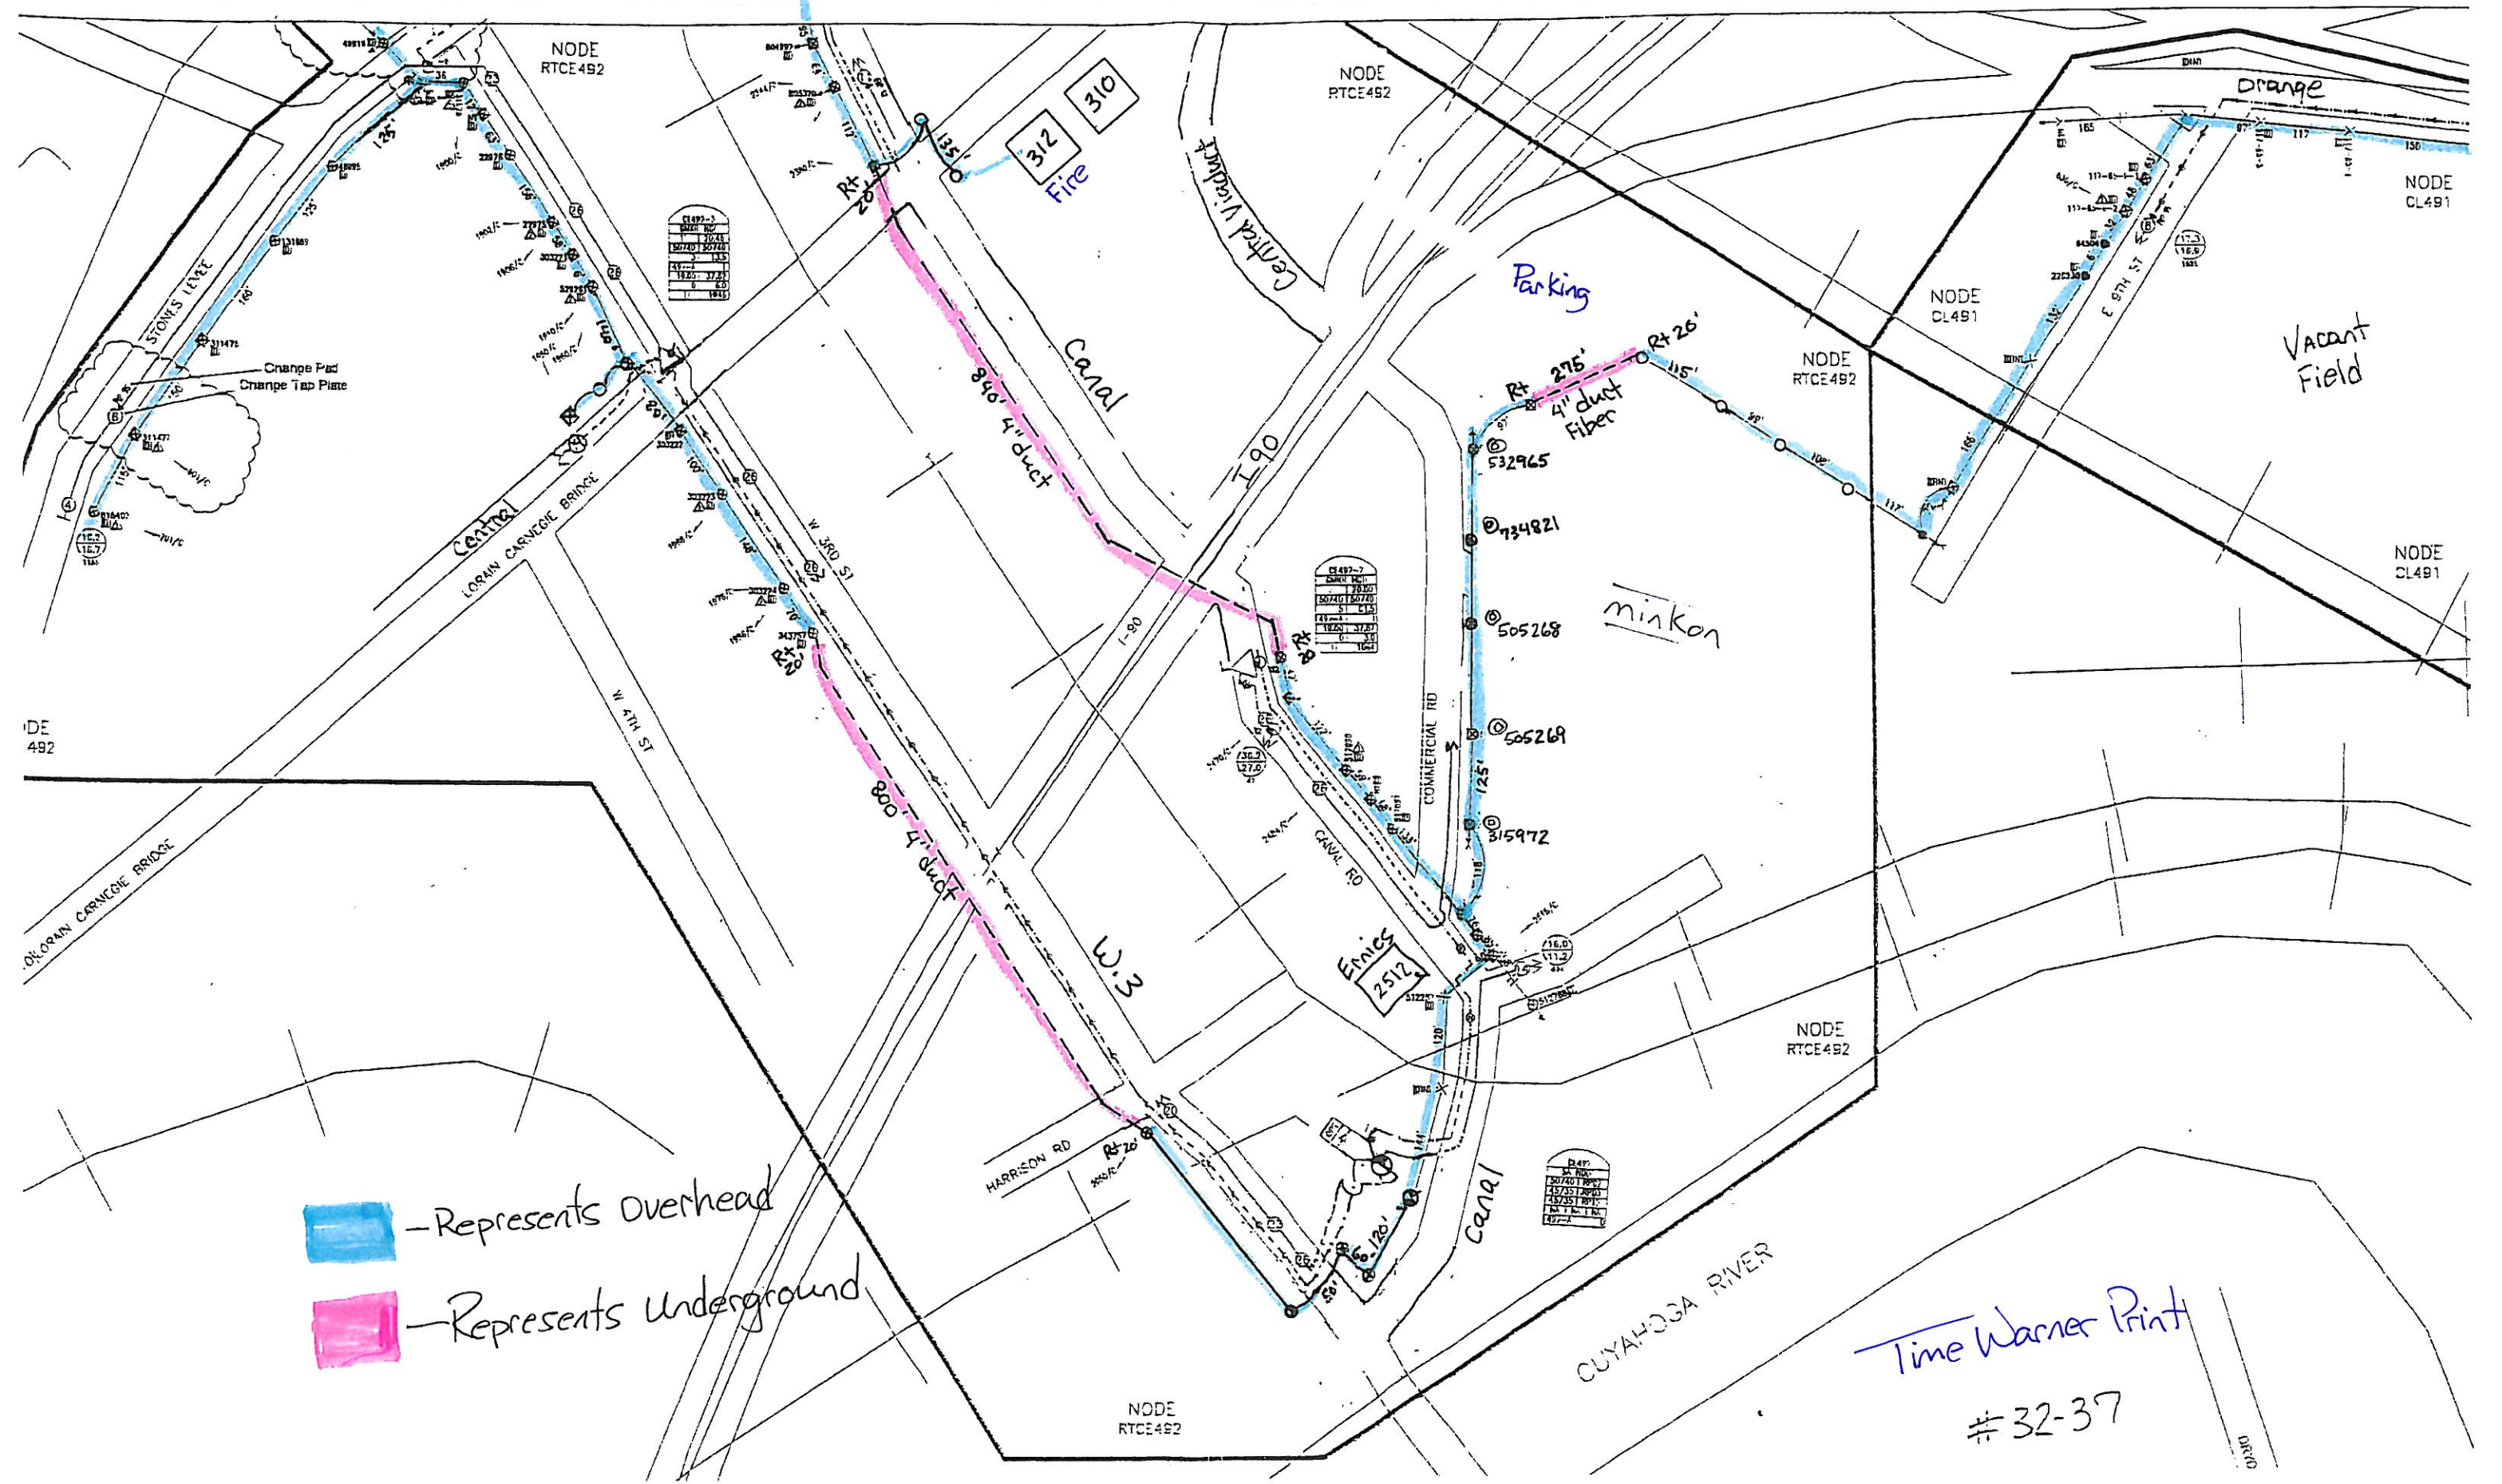
 - Represents Overhead  
 - Represents Underground



Time Warner Print  
 # 32-37

DATE

