


DESIGNED
EJK
CHECKED
JRC
SCALE IN FEET
HORIZONTAL
10
20
40
0

PP-031
DWG. NO.
CUY-90-14.90

ROADWAY
GATEWAY



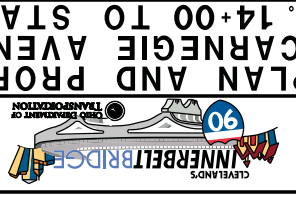


DESIGN AGENCY
WILSH HNTB

**PLAN AND PROFILE
CARNegie AVENUE
STA. 14+00 TO STA. 19+00**

REVISIONS

NO.	DATE	REVISIONS
A	12/09/2010	INTERIM SUBMITTAL
B	08/03/2011	FINAL SUBMITTAL ADDITIONAL INFORMATION
C	08/17/2011	FINAL SUBMITTAL TO ODOT
D	09/30/2011	FINAL SUBMITTAL TO ODOT
E	11/03/2011	FINAL COMPLIANCE
F	11/30/2011	FINAL RESUBMITTAL TO ODOT - DRAINAGE
1	01/06/2012	APPROVED FOR CONSTRUCTION

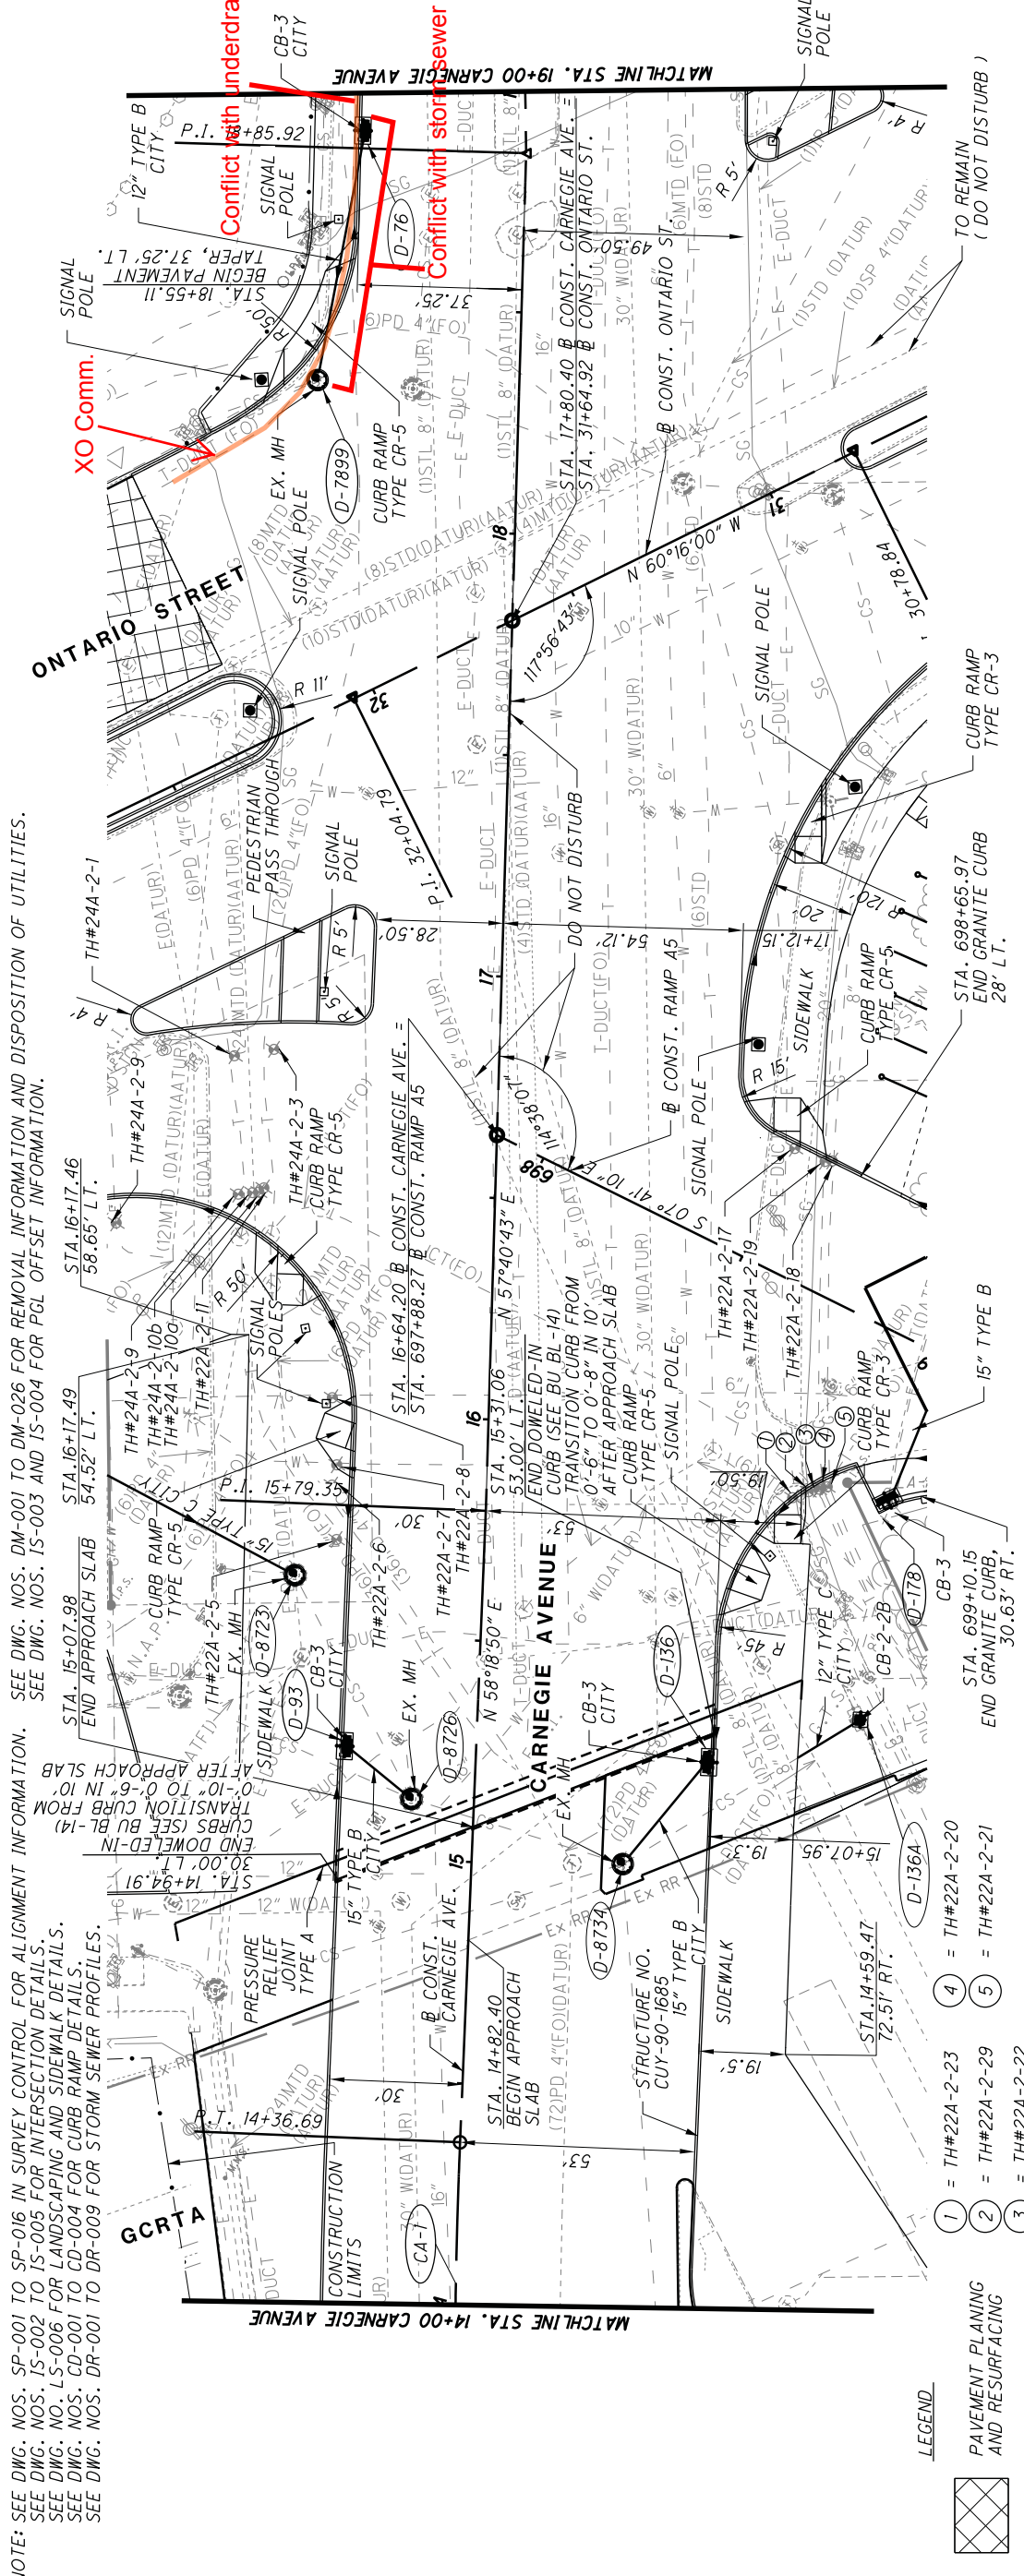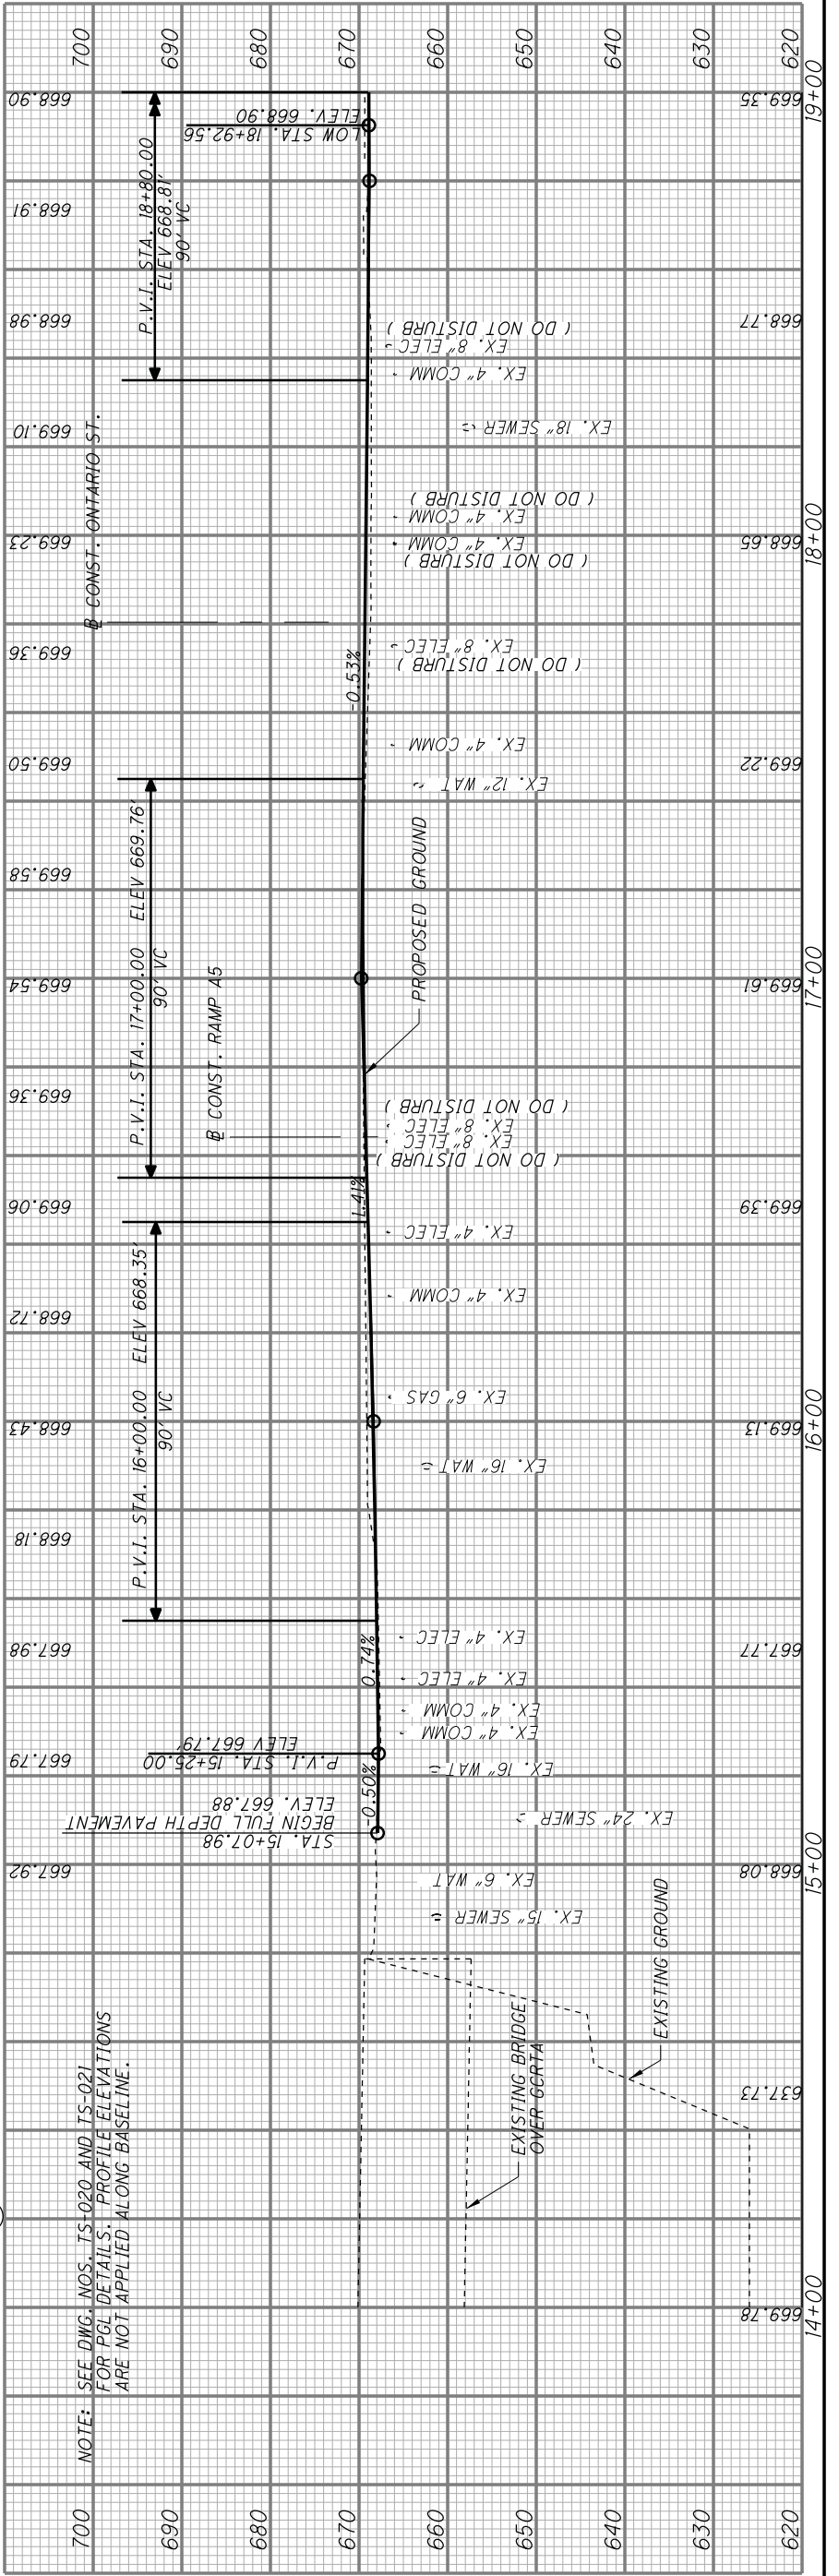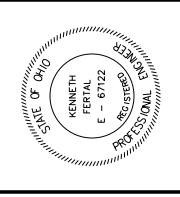

NOTE: SEE DWG. NOS. SP-001 TO SP-016 IN SURVEY CONTROL FOR ALIGNMENT INFORMATION. SEE DWG. NOS. DM-001 TO DM-026 FOR REMOVAL INFORMATION AND DISPOSITION OF UTILITIES. SEE DWG. NOS. IS-002 TO IS-005 FOR INTERSECTION DETAILS. SEE DWG. NOS. LS-006 FOR LANDSCAPING AND SIDEWALK DETAILS. SEE DWG. NOS. CD-001 TO CD-004 FOR CURB RAMP DETAILS. SEE DWG. NOS. DR-001 TO DR-009 FOR STORM SEWER PROFILES.

LEGEND
 PAVEMENT PLANING AND RESURFACING

- 1 = TH#224-2-23
- 2 = TH#224-2-29
- 3 = TH#224-2-22
- 4 = TH#224-2-20
- 5 = TH#224-2-21

STA. 699+10.15
END GRANITE CURB,
30.63' RT.

STA. 698+65.97
END GRANITE CURB
28' LT.

STA. 699+65.97
END GRANITE CURB
28' LT.

STA. 698+65.97
END GRANITE CURB
28' LT.

STA. 699+65.97
END GRANITE CURB
28' LT.

STA. 698+65.97
END GRANITE CURB
28' LT.

STA. 699+65.97
END GRANITE CURB
28' LT.

STA. 698+65.97
END GRANITE CURB
28' LT.

STA. 699+65.97
END GRANITE CURB
28' LT.

STA. 698+65.97
END GRANITE CURB
28' LT.

MATCHLINE STA. 14+00 CARNegie AVENUE

MATCHLINE STA. 19+00 CARNegie AVENUE

TO REMAIN
(DO NOT DISTURB)

TO REMAIN
(DO NOT DISTURB)

NO.	REVISIONS	DATE
1	APPROVED FOR CONSTRUCTION	01/06/2012
F	FINAL RESUBMITTAL TO ODOT - DRAINAGE	11/30/2011
E	FINAL COMPLIANCE	11/30/2011
D	FINAL SUBMITTAL TO ODOT	09/30/2011
C	FINAL SUBMITTAL ADDITIONAL INFORMATION	08/17/2011
B	INTERIM SUBMITTAL	12/09/2010
A		

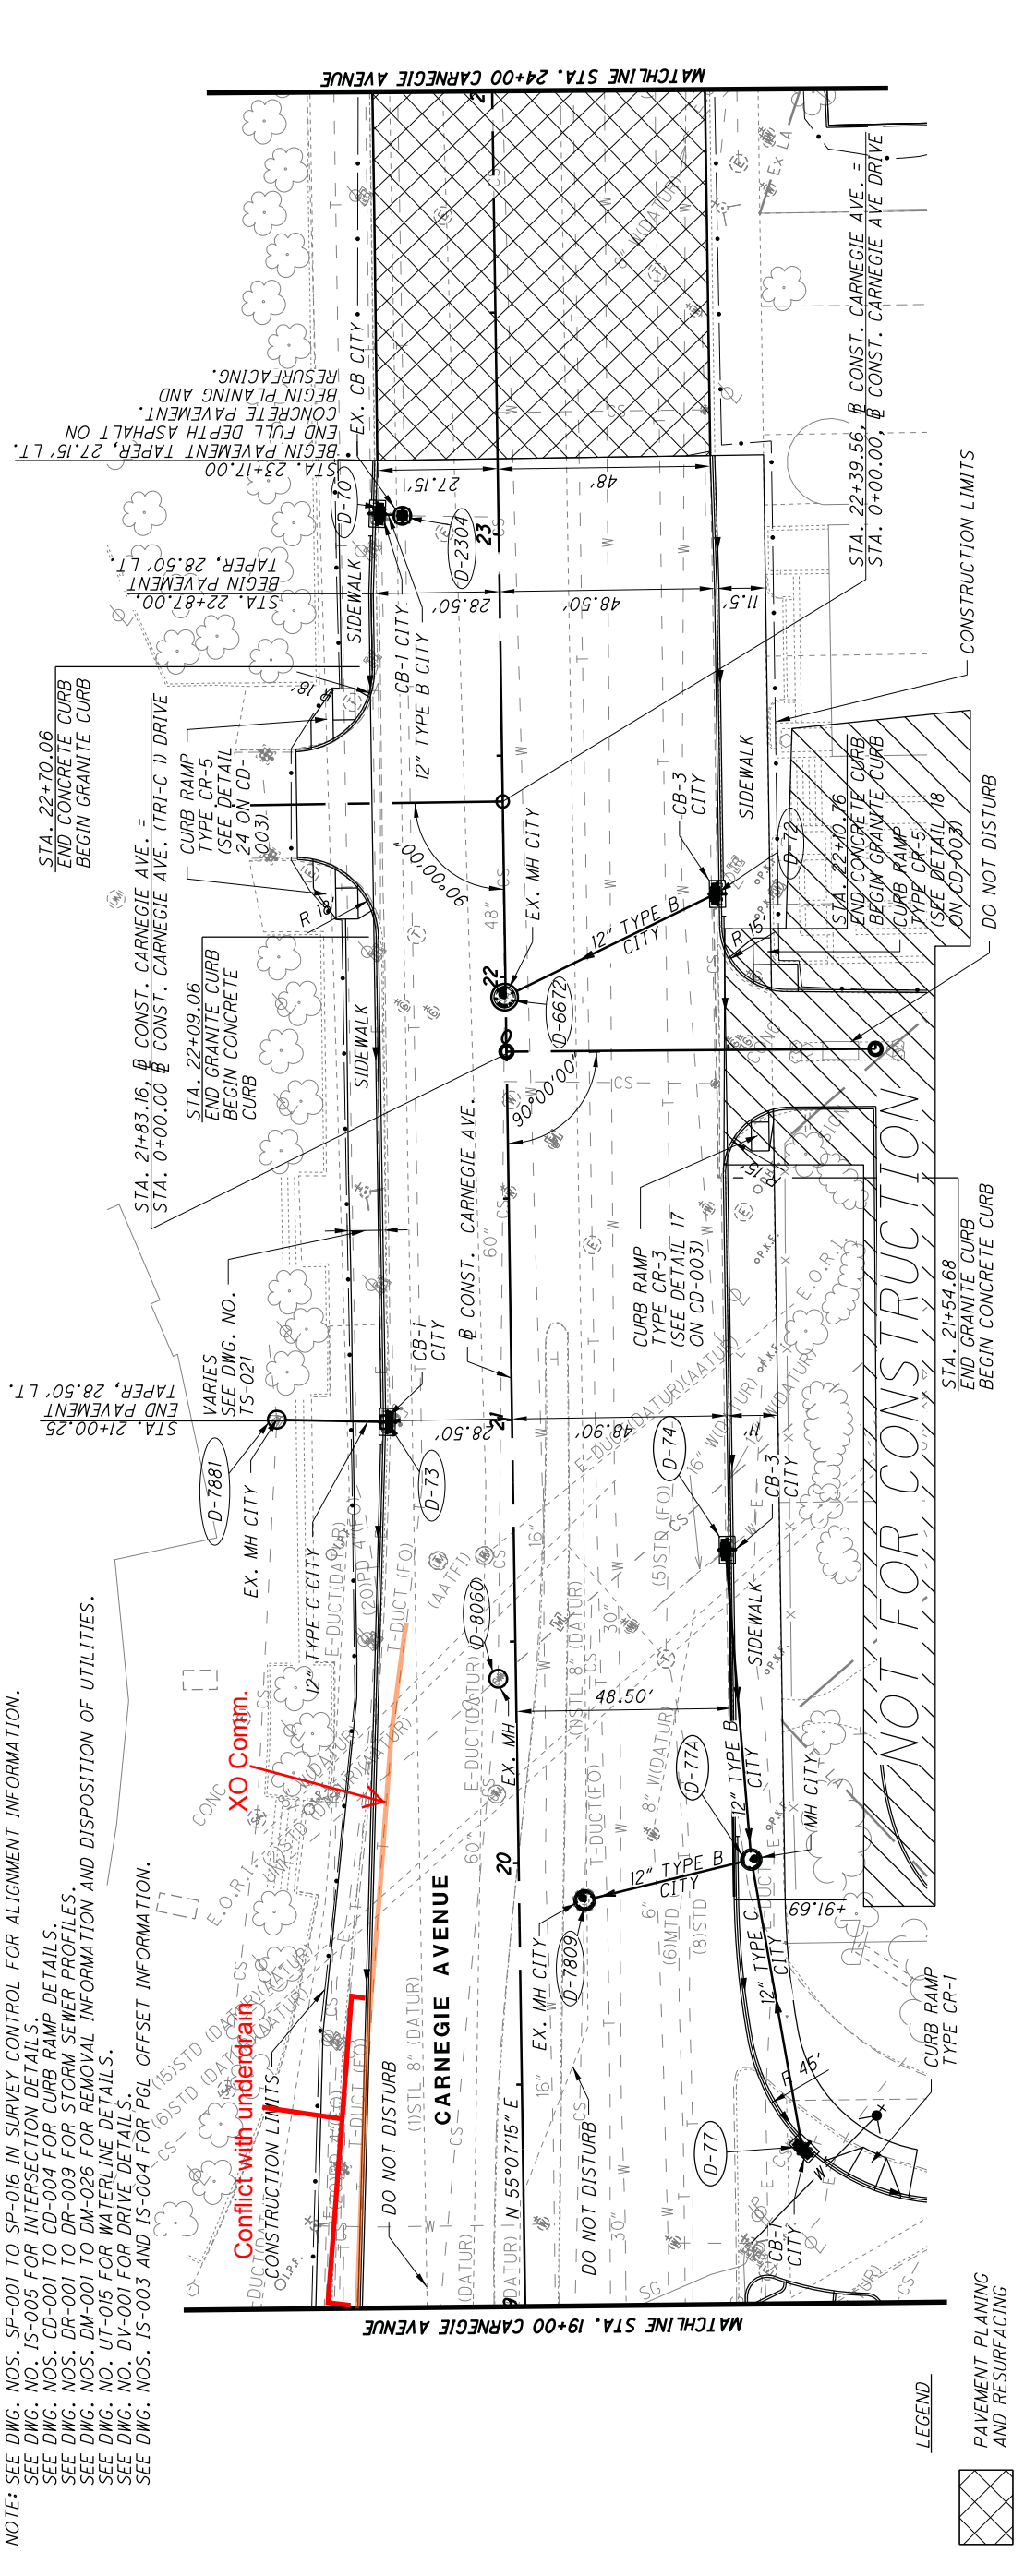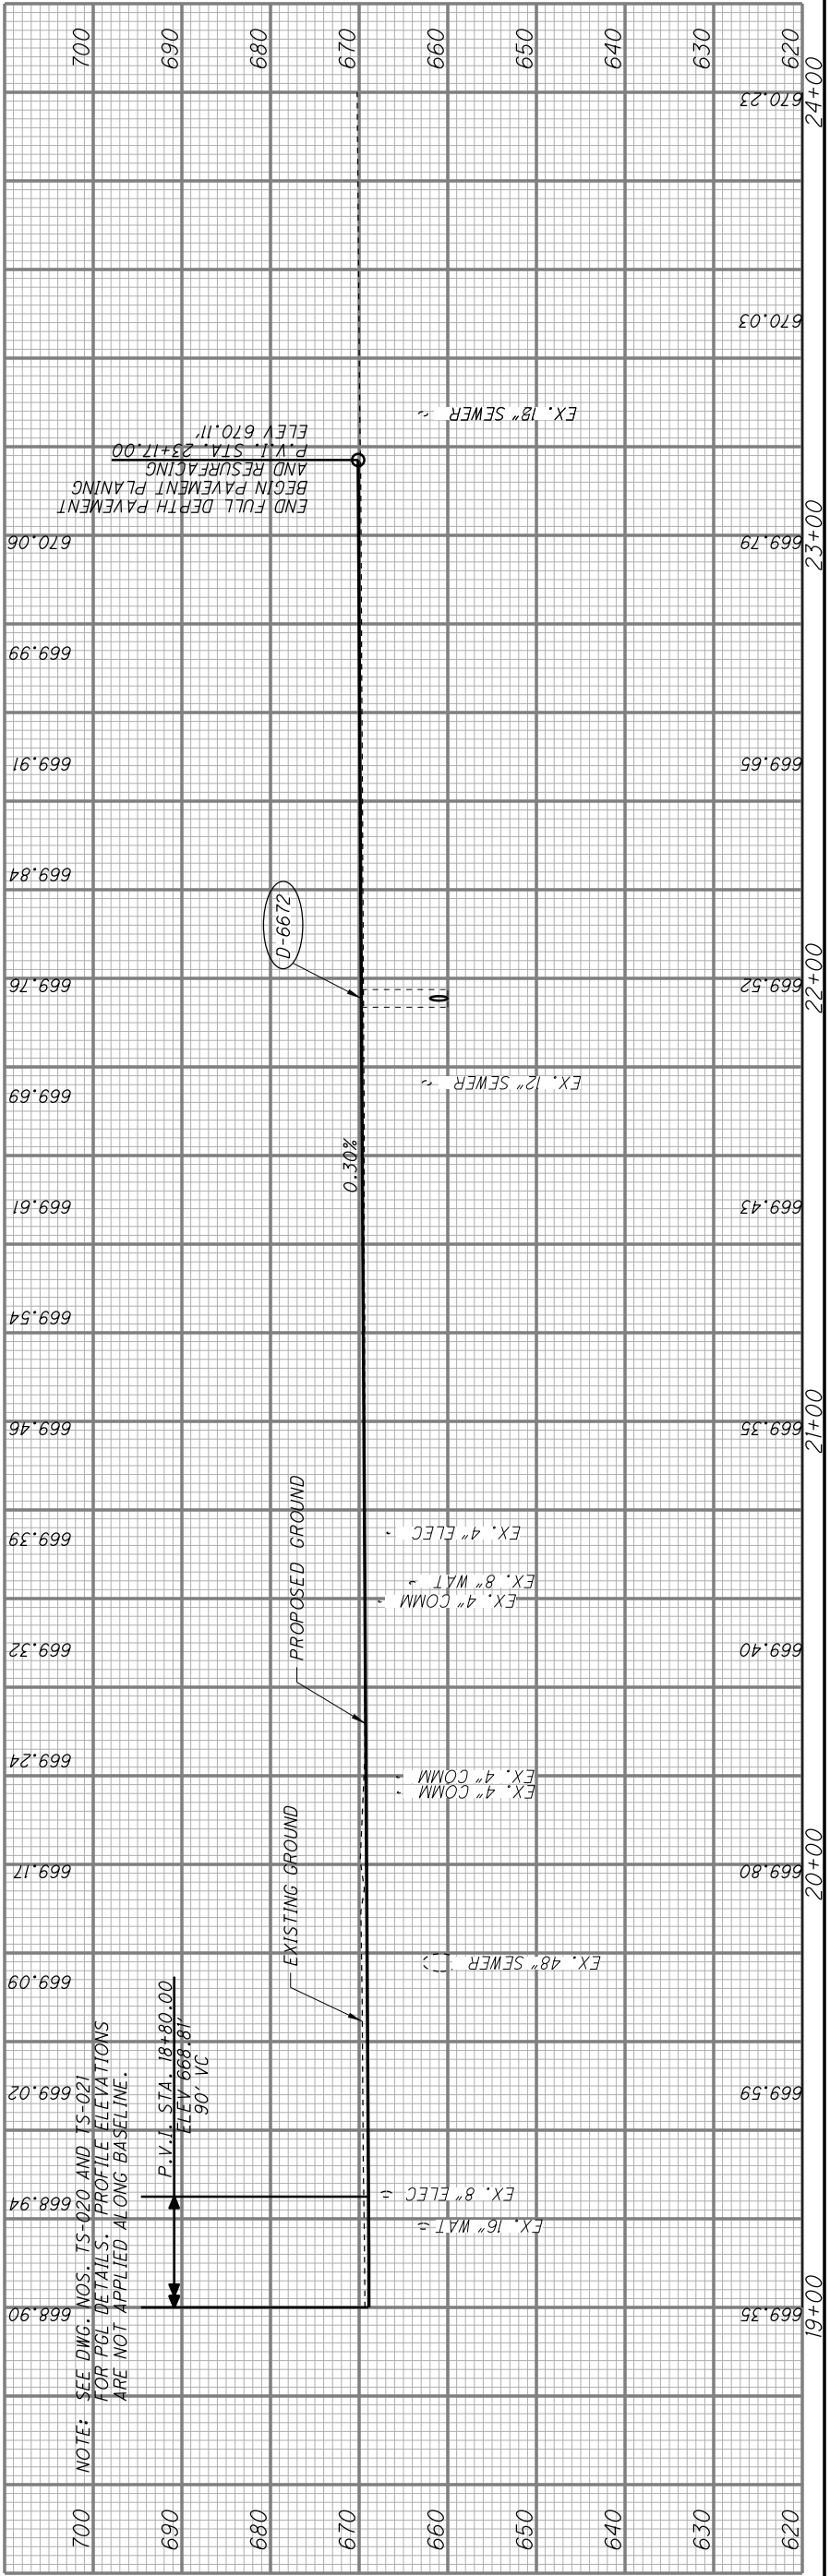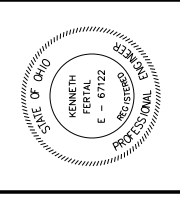

NOTE: SEE DWG. NOS. SP-001 TO SP-016 IN SURVEY CONTROL FOR ALIGNMENT INFORMATION.
 SEE DWG. NO. IS-005 FOR INTERSECTION DETAILS.
 SEE DWG. NOS. CD-001 TO CD-004 FOR CURB RAMP DETAILS.
 SEE DWG. NOS. DR-001 TO DR-003 FOR STORM SEWER PROFILES.
 SEE DWG. NOS. DM-001 TO DM-026 FOR REMOVAL INFORMATION AND DISPOSITION OF UTILITIES.
 SEE DWG. NO. UT-015 FOR WATERLINE DETAILS.
 SEE DWG. NO. DV-001 FOR DRIVE DETAILS.
 SEE DWG. NOS. IS-003 AND IS-004 FOR PGL OFFSET INFORMATION.

Conflict with underdrain
 XO Comm.

NOT FOR CONSTRUCTION

LEGEND
 PAVEMENT PLANNING AND RESURFACING