


3 @ JEFFERSON

7A & ASSOCIATES INC.  
Engineers & Surveyors  
Columbus Road, #100  
COLUMBUS, OHIO 44141  
(440) 526-4206  
FAX (440) 546-2691

JOB CLEVELAND STREETSCAPE  
SHEET NO. \_\_\_\_\_ OF \_\_\_\_\_  
CALCULATED BY RCN DATE 11/8/12  
CHECKED BY \_\_\_\_\_ DATE \_\_\_\_\_  
SCALE NONE (ES90A)

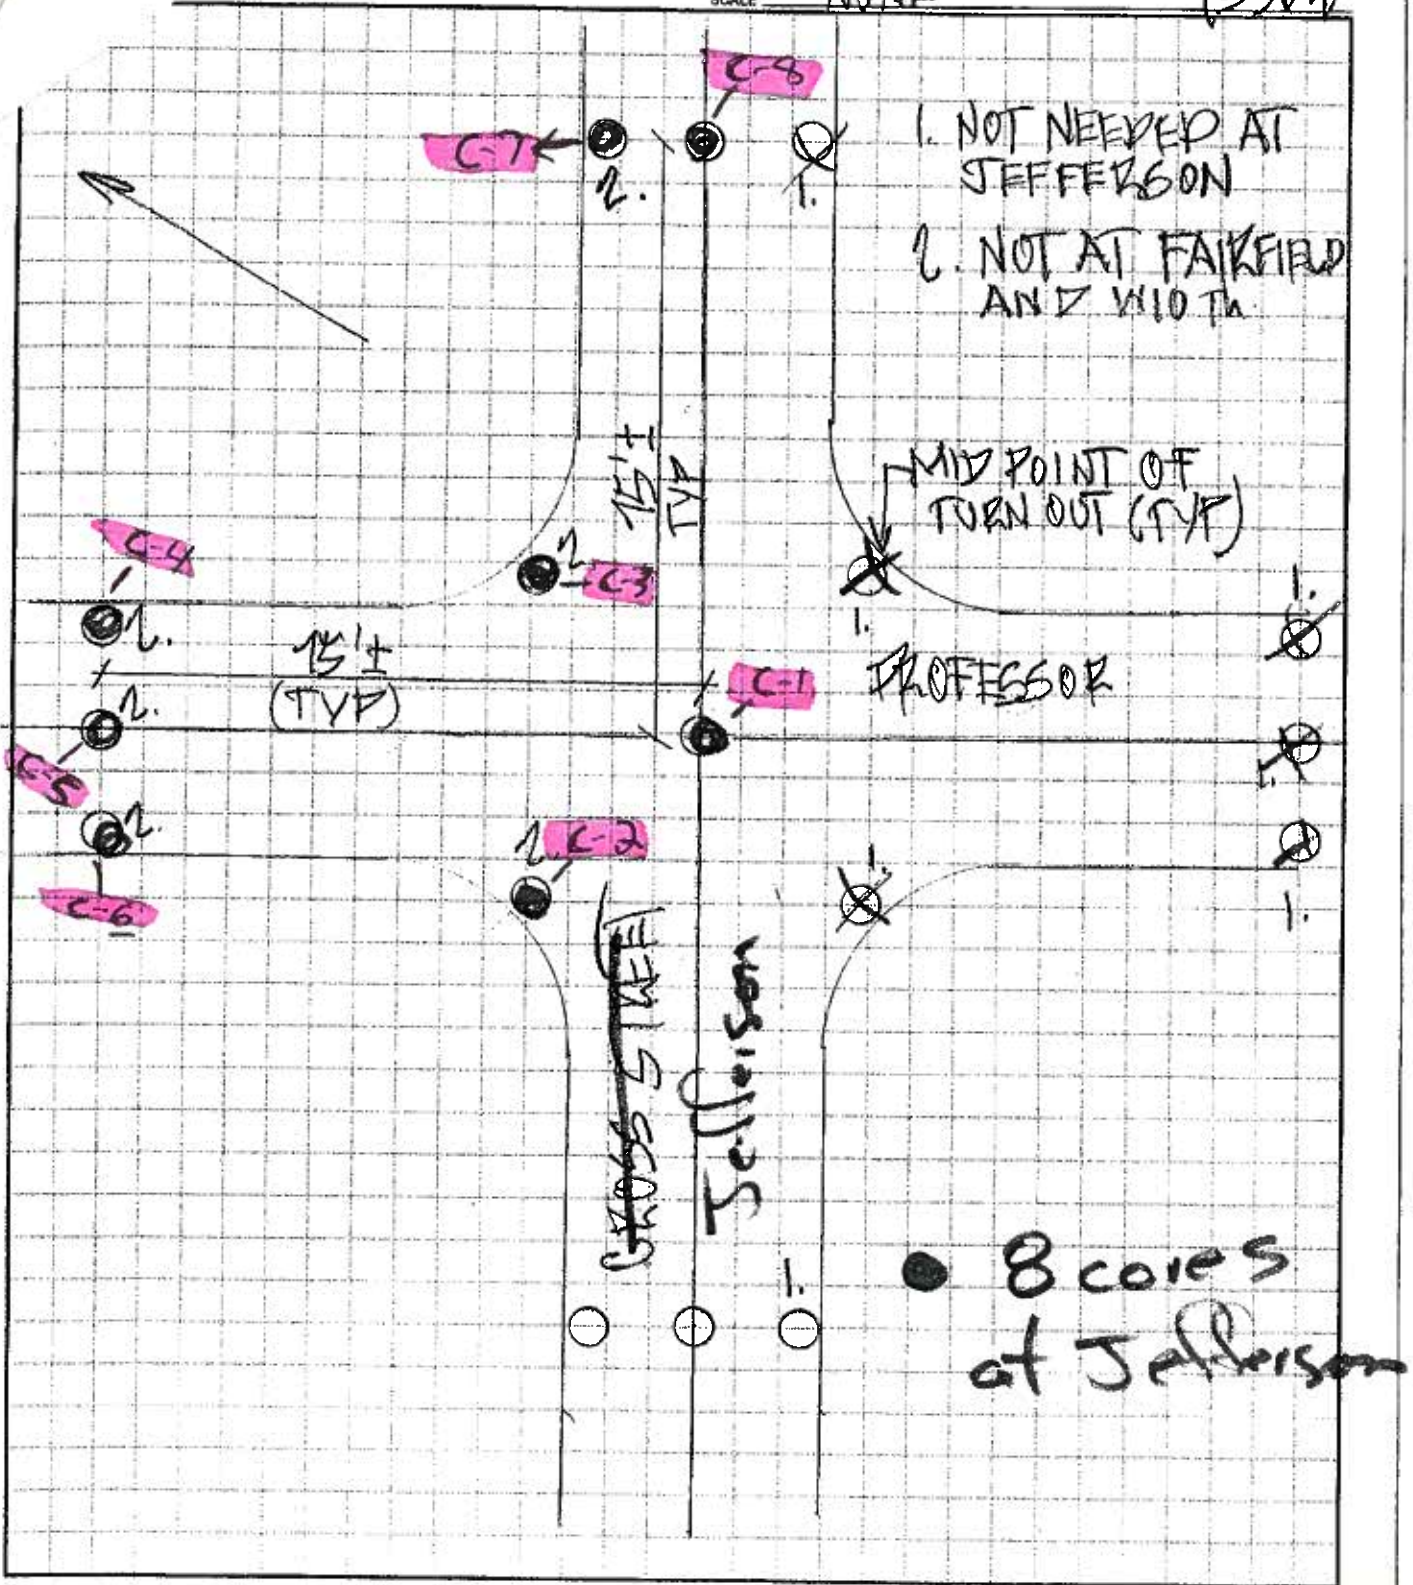


Dave



9-25 @ ~~LITERARY~~ COLLEGE

MICHAEL BENZA & ASSOCIATES INC.  
Consulting Engineers & Surveyors  
6860 West Snowville Road, #100  
BRECKSVILLE, OHIO 44141  
(440) 526-4206  
FAX (440) 546-2691

JOB CLEVELAND STREETSCAPE  
SHEET NO. 1 OF 1  
CALCULATED BY RGN DATE 11/18/10  
CHECKED BY NONE DATE (530A)  
SCALE NONE

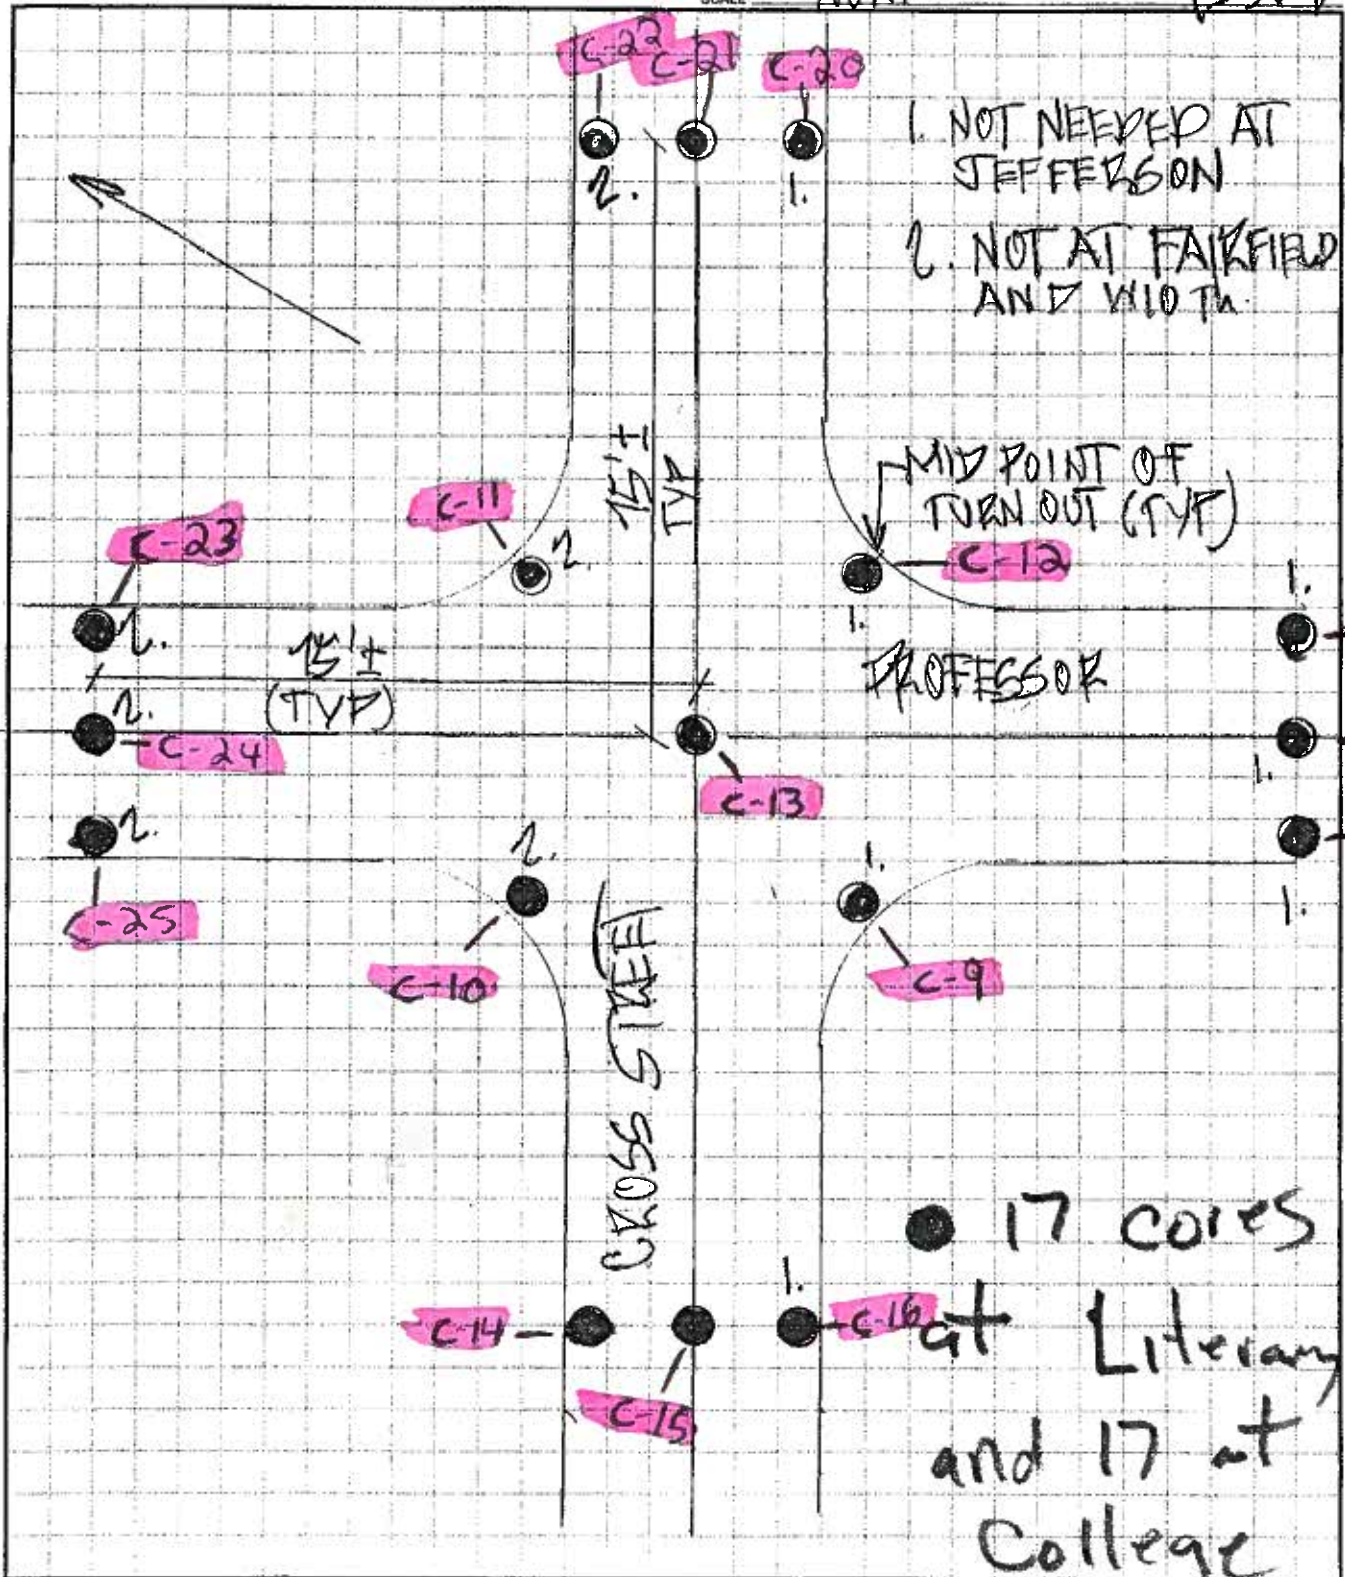

PROFESOR and college

C-22 CORE sample came out of bit in pieces


C-24 8" OF concrete fell into void could not retrieve  
**NONE**



26-42 @ LITERARY

MICHAEL BENZA & ASSOCIATES INC.  
Consulting Engineers & Surveyors  
6860 West Snowville Road, #100  
BRECKSVILLE, OHIO 44141  
(440) 526-4206  
FAX (440) 546-2691

JOB CLEVELAND STREETSCAPE  
SHEET NO. \_\_\_\_\_ OF \_\_\_\_\_  
CALCULATED BY R.C.N. DATE 11/18/12  
CHECKED BY \_\_\_\_\_ DATE \_\_\_\_\_  
SCALE NONE (530A)

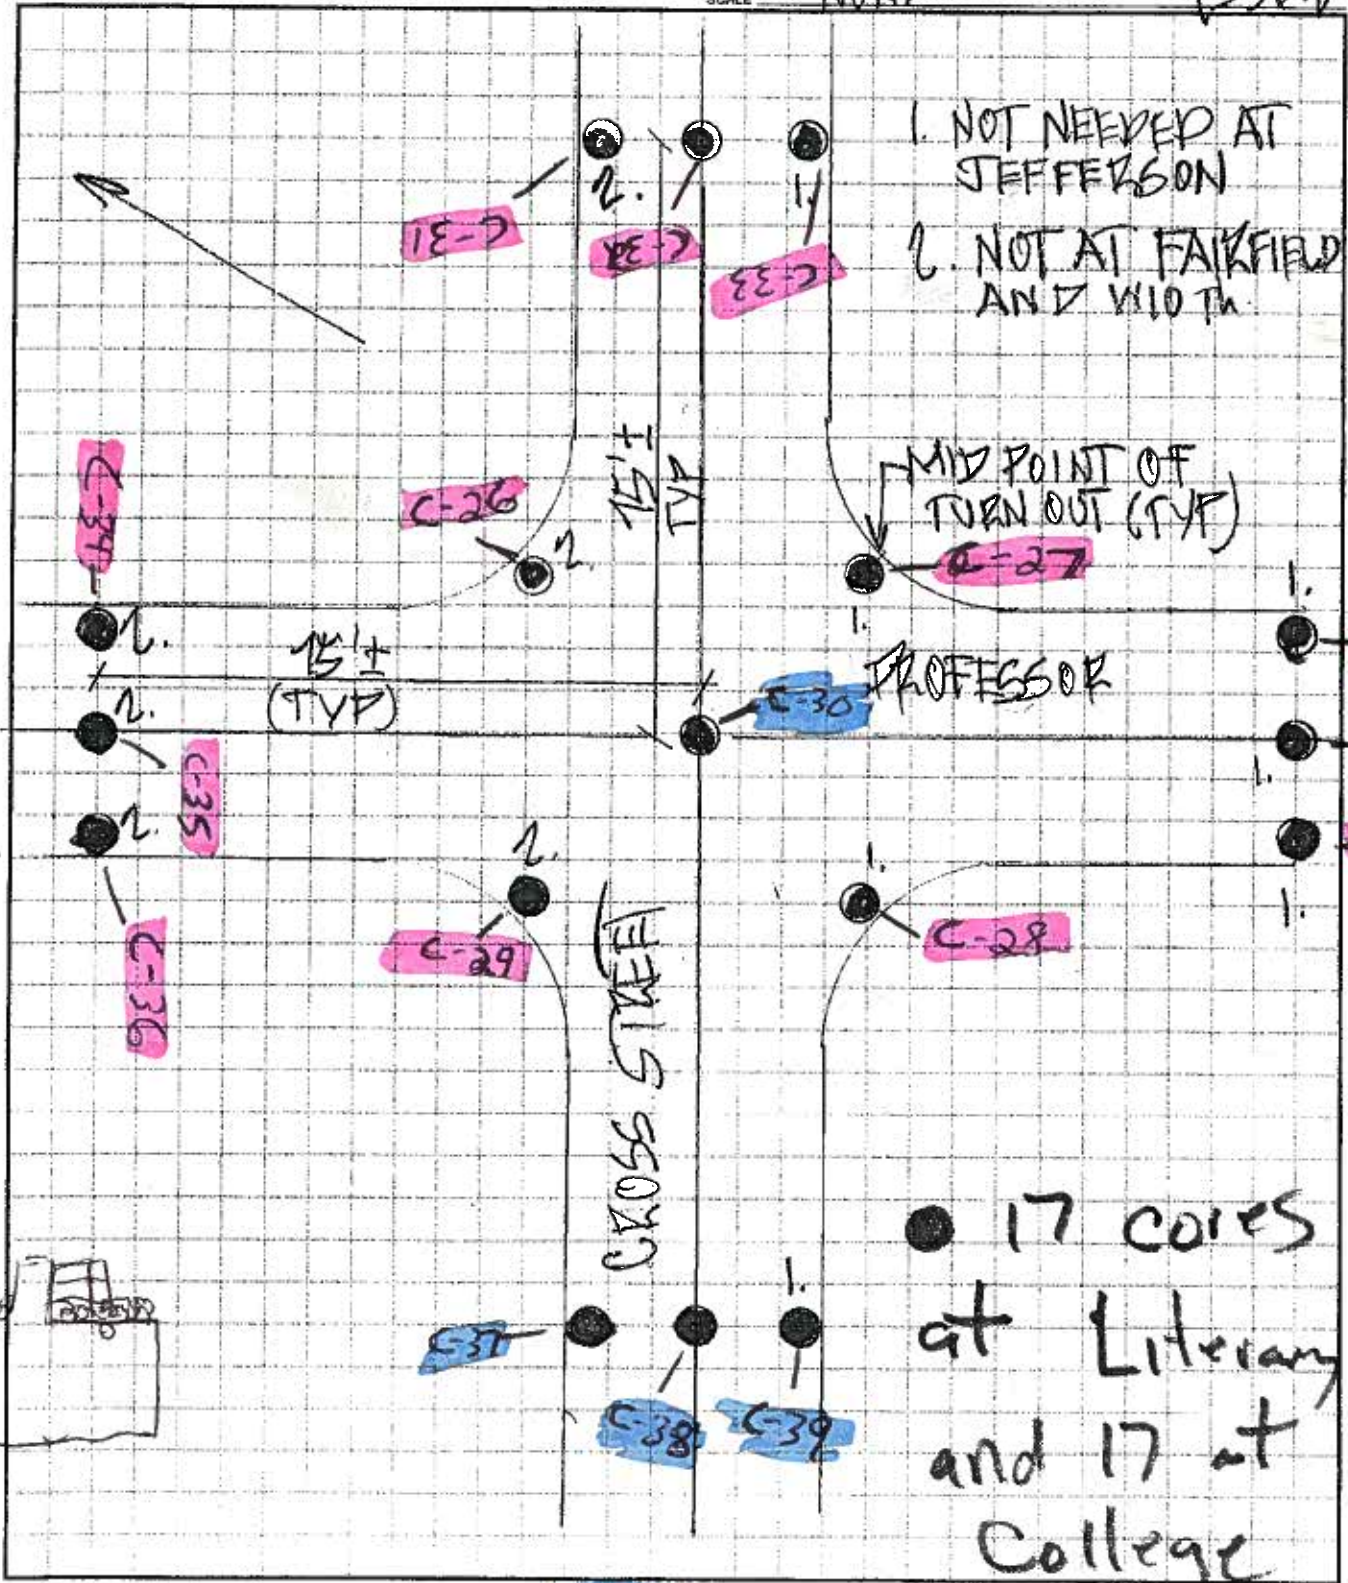

PROFESOR  
and  
Literary

Done

17 CORES  
at Literary  
and 17 at  
College


C-70 8' OFF center line  
Due to vault. Also  
Huge Void under



43-53 @ FAIRFIELD

MICHAEL BENZA & ASSOCIATES INC.  
Consulting Engineers & Surveyors  
6860 West Snowville Road, #100  
BRECKSVILLE, OHIO 44141  
(440) 526-4206  
FAX (440) 546-2691


JOB CLEVELAND STREETSCAPE  
SHEET NO. \_\_\_\_\_ OF \_\_\_\_\_  
CALCULATED BY RCN DATE 11/8/12  
CHECKED BY \_\_\_\_\_ DATE \_\_\_\_\_  
SCALE NONE (530A)

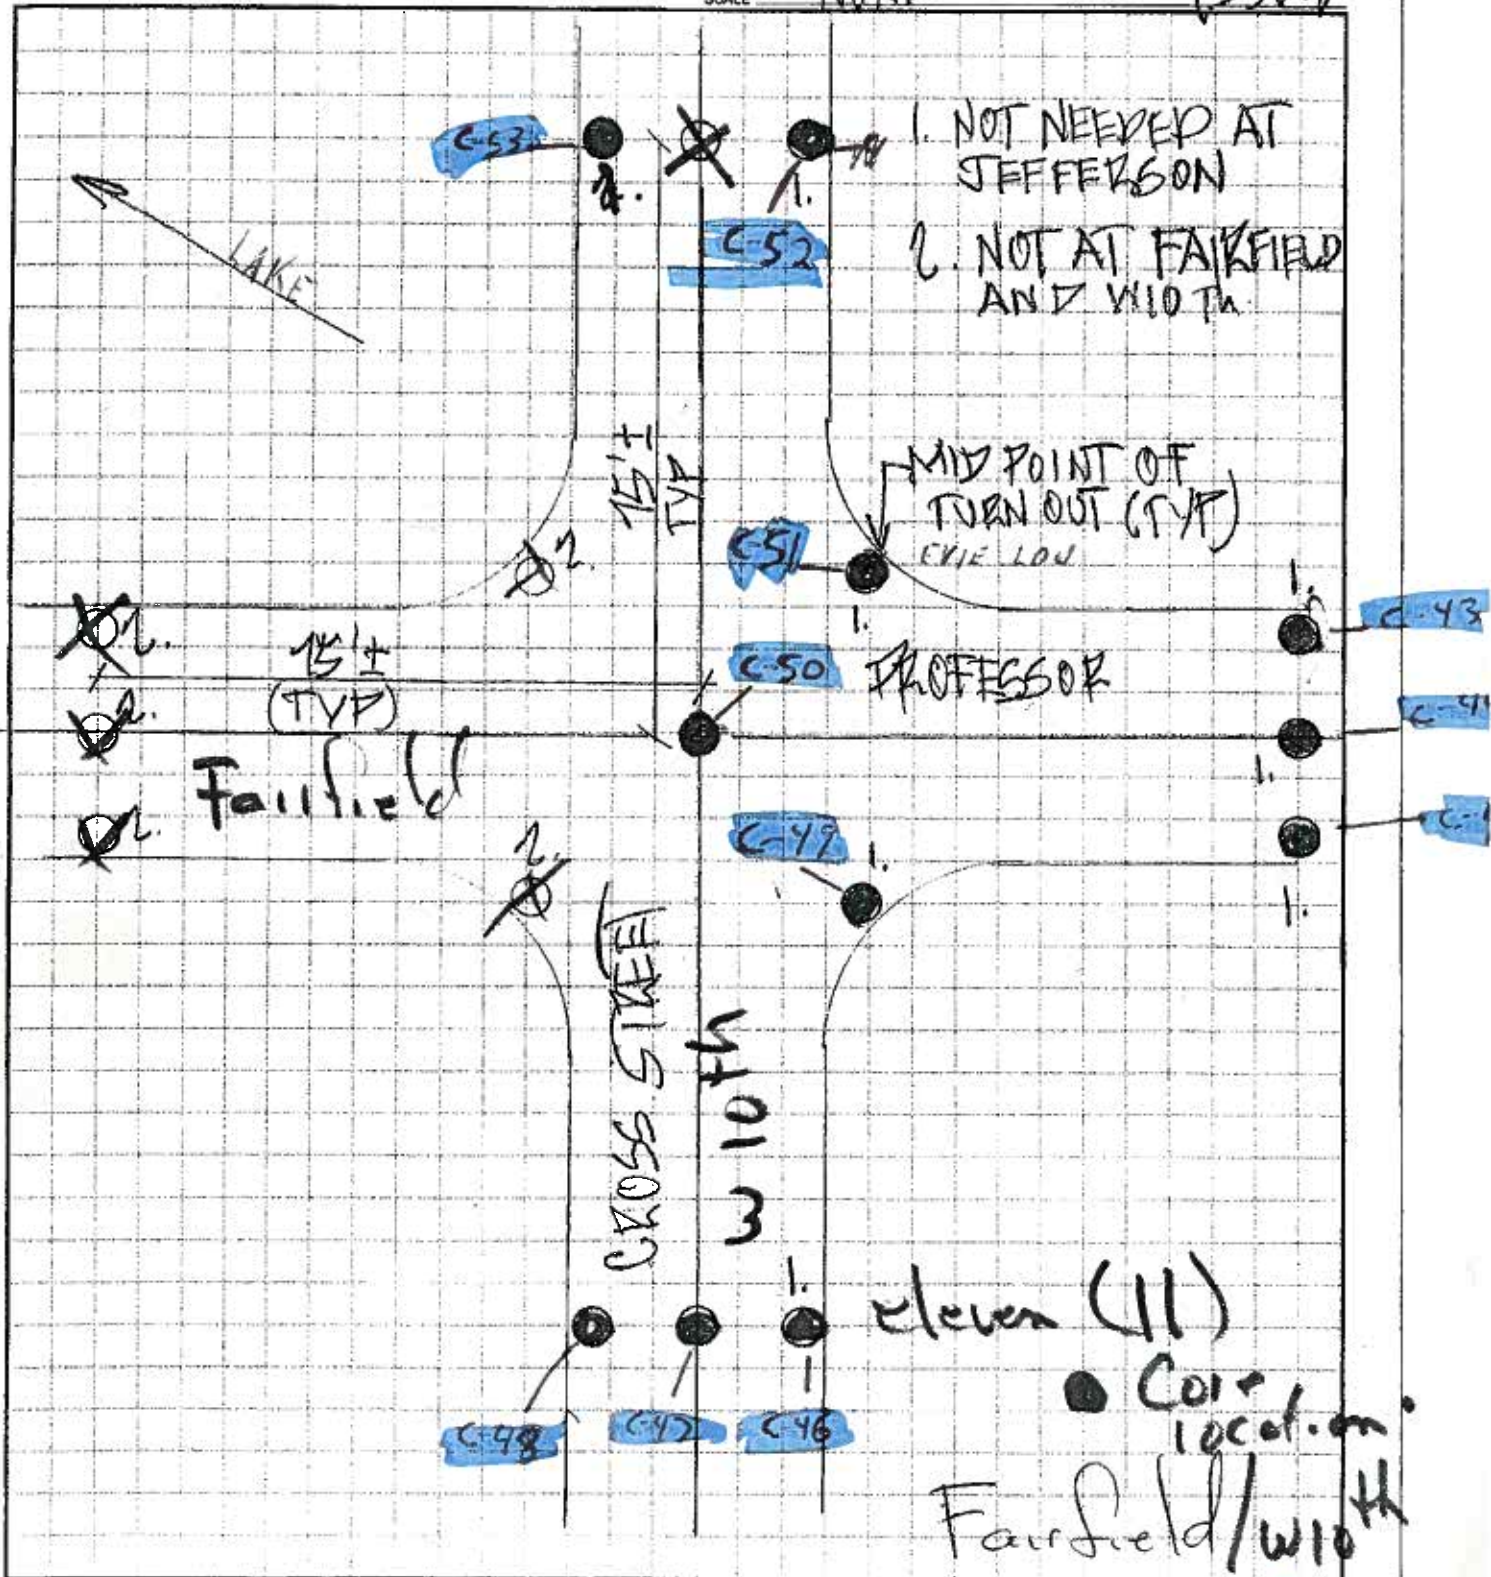

**DONE**

54-65 @ W 6<sup>TH</sup>

Cleveland, Ohio, United States

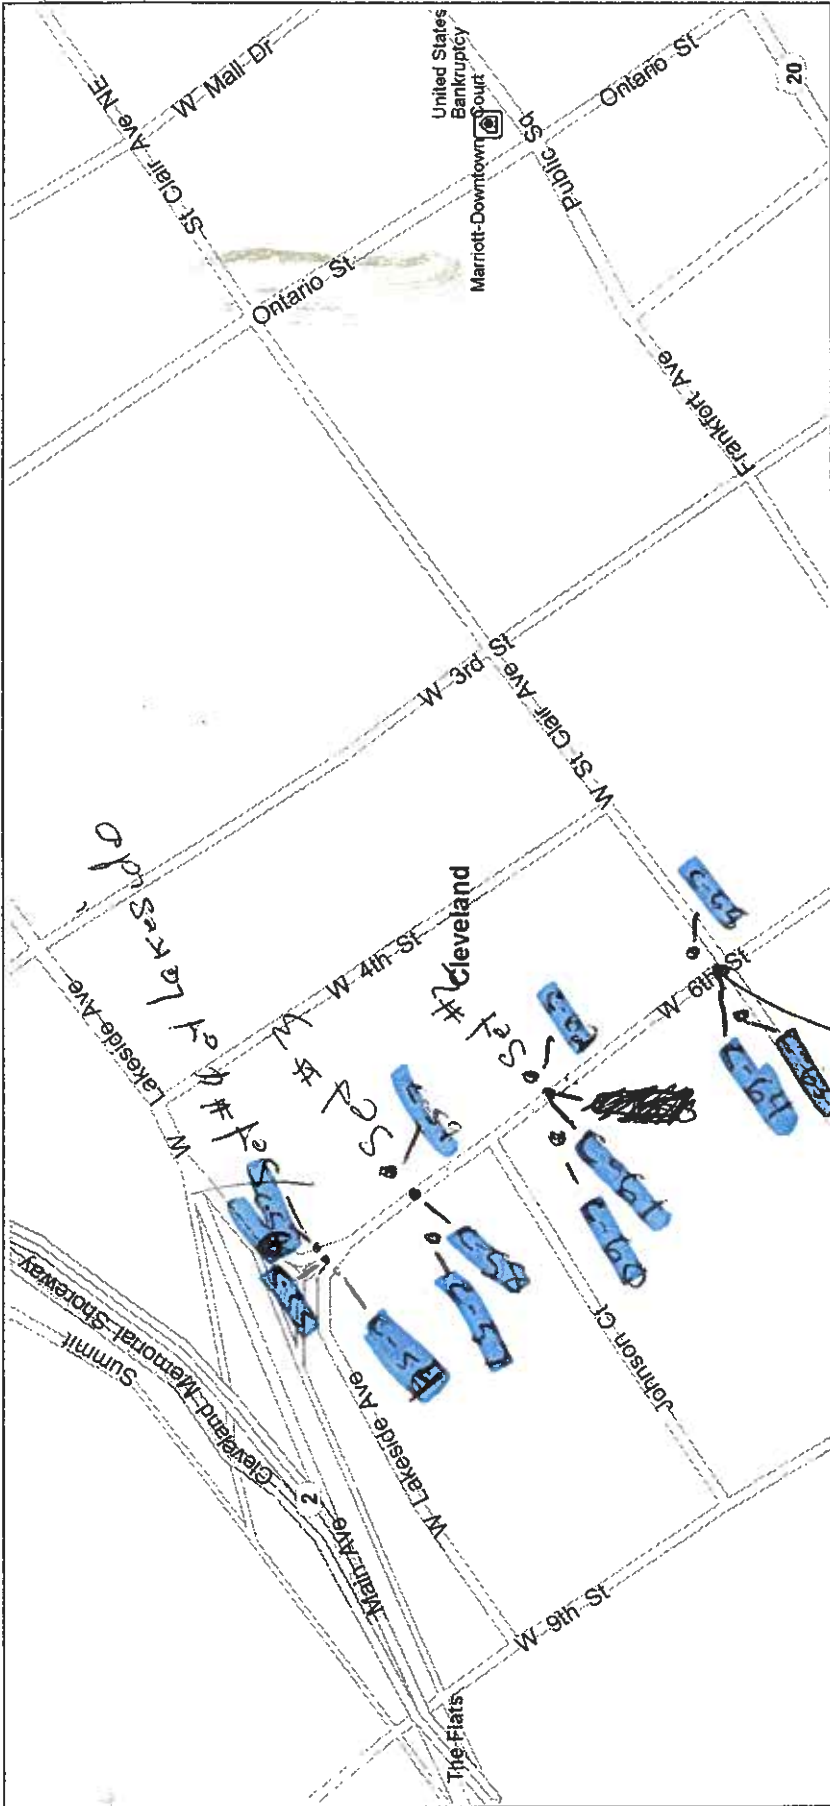

Set #1 at St. Clair

Starting at LK  
Looking South



Lakeside ENB  
Right center LEFT  
C-56 C-55 C-54