

GUARD RAIL		
Reference No.	Item I-15 Guard Rail Removed and Disposed of Lin. Ft.	Item I-15 Guard Rail Lin. Ft.
1-G	80	
2-G		375.76
3-G		308.55
4-G	470	
5-G	331	
6-G		137.50
7-G	175	
8-G		187.50
TOTAL	1056	1009.31

DRIVES						
Ref. No.	Station	Side	Item E-1 Cu. Yds.		Item T-35 2" Asphalt Conc. Surf. Cu. Yds.	B-119 5" Aggregate Base Cu. Yds.
			Excavation	Embankment		
1-D	216+00	Left	76	887	12	31
2-D	226+00	RT.	309	71	20	50
TOTALS			385	958	32	81

TRAFFIC MAINTENANCE			
Station	Item T-10	Item M-10	
From To	Cu. Yds.	Tons	
224+70 Bk. 228+50 Ex.	433	9	
TOTALS	433	9	

REMOVE WEARING COURSE		
Ref. No.	STATION	E-8 Sq. Yds. Removal & Disposal Wearing Course
1-R	228+00 228+50	62
TOTAL		62

APPROACH SLABS		
Station	Item I-7 Reinf. Conc. Approach Slabs	Sq. Yds.
217+14.38 217+29.38	40	
218+28.42 218+43.62	40	
TOTALS	80	


SEEDING SUMMARY			
Station	Item I-9 Seeding	Item L-9 Fertilizer	
From To	Sq. Yds.	Tons	
216+00 228+50	12,154	0.737	
TOTALS	12,154	0.737	

MONUMENT BOXES		
Item No.	Station	Item I-8 Monument Boxes Type B
1-M	221+54.94	1
TOTAL		1

STORM SEWERS				
Ref. No.	Sta.	Side	Item I-2 Pipe	Item I-3 Standard No. 1-3 Catch Basin
			Lin. Ft.	Each
1-S	226+06 To 226+28	Left	16 12"	1
TOTALS			16 6	1

STRUCTURES 20' AND UNDER										
Ref. No.	Sta.	SIZE	SKEW	Length		Item E-7 Excavation for Structures Cu. Yds.	Item S-1 Concrete for Structures Cu. Yds.	Item S-4 Reinf. Steel Lbs.	Item S-24 Removal and Disposal of Existing Structures Lump Sum	Item I-10 Dumped Rock Fill Cu. Yds.
				North of ϕ	South of ϕ					
1-C	216+26	18"	33° 33'	31.5	54.5	42" 18"	194	2.9	0.6	
2-C	215+76 To 216+56 (New)	18"	None	52'		78	1	0.6		
3-C	226+27.5	42"	37°	32'	40'	90	119	2.8	64	Lump Sum 15
TOTALS				90	182	149	1.2	2.8	64	Lump Sum 15

Trees To Be Removed 12" and Over ----- 95 Each
Cost of the removal of trees and stumps is to be included in the cost of Roadway Excavation Item E-1. This summary is for the benefit of the contractor and the State of Ohio does not guarantee its accuracy.

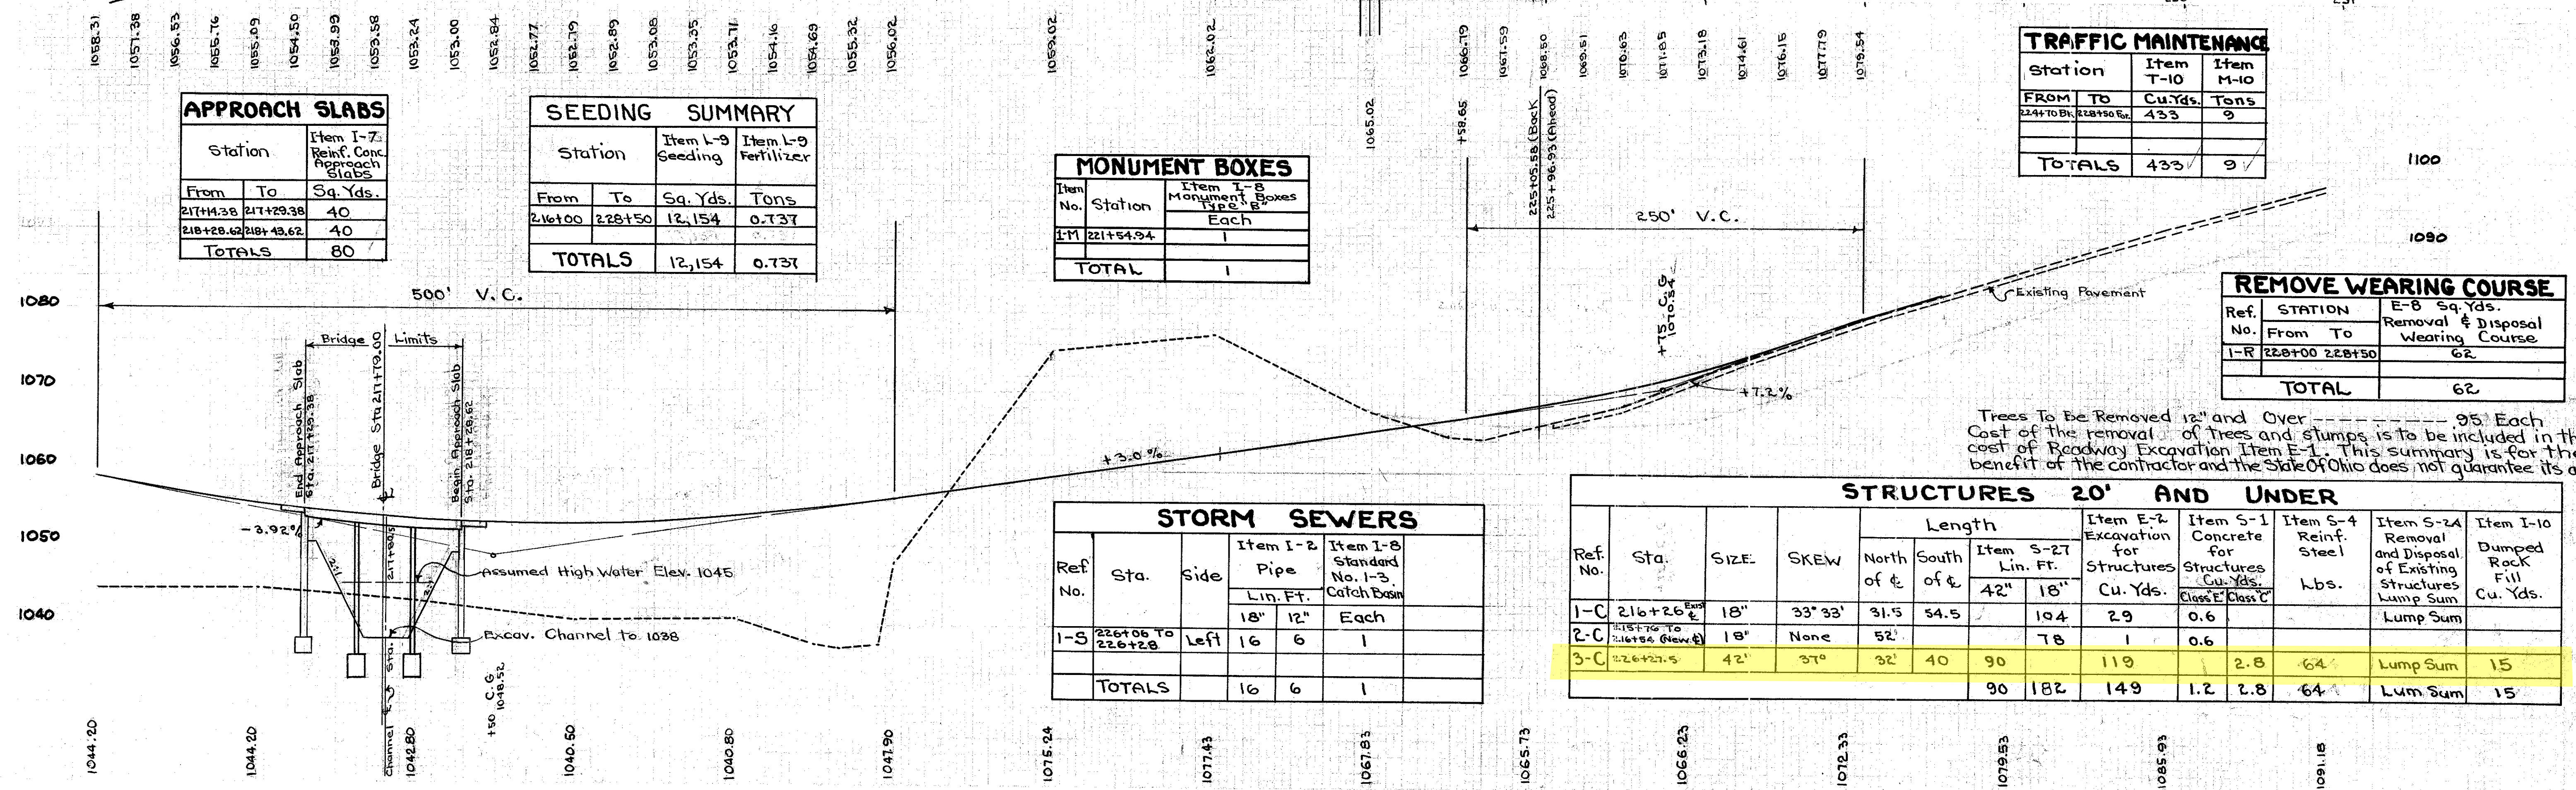

PROFILE & PLAN STA. 216+0 TO STA. 230+0