


CUYAHOGA COUNTY
CITY OF CLEVELAND
MEDINA-CLARK INTERCHANGE
CUY-71-18.54
CUY-90-13.81

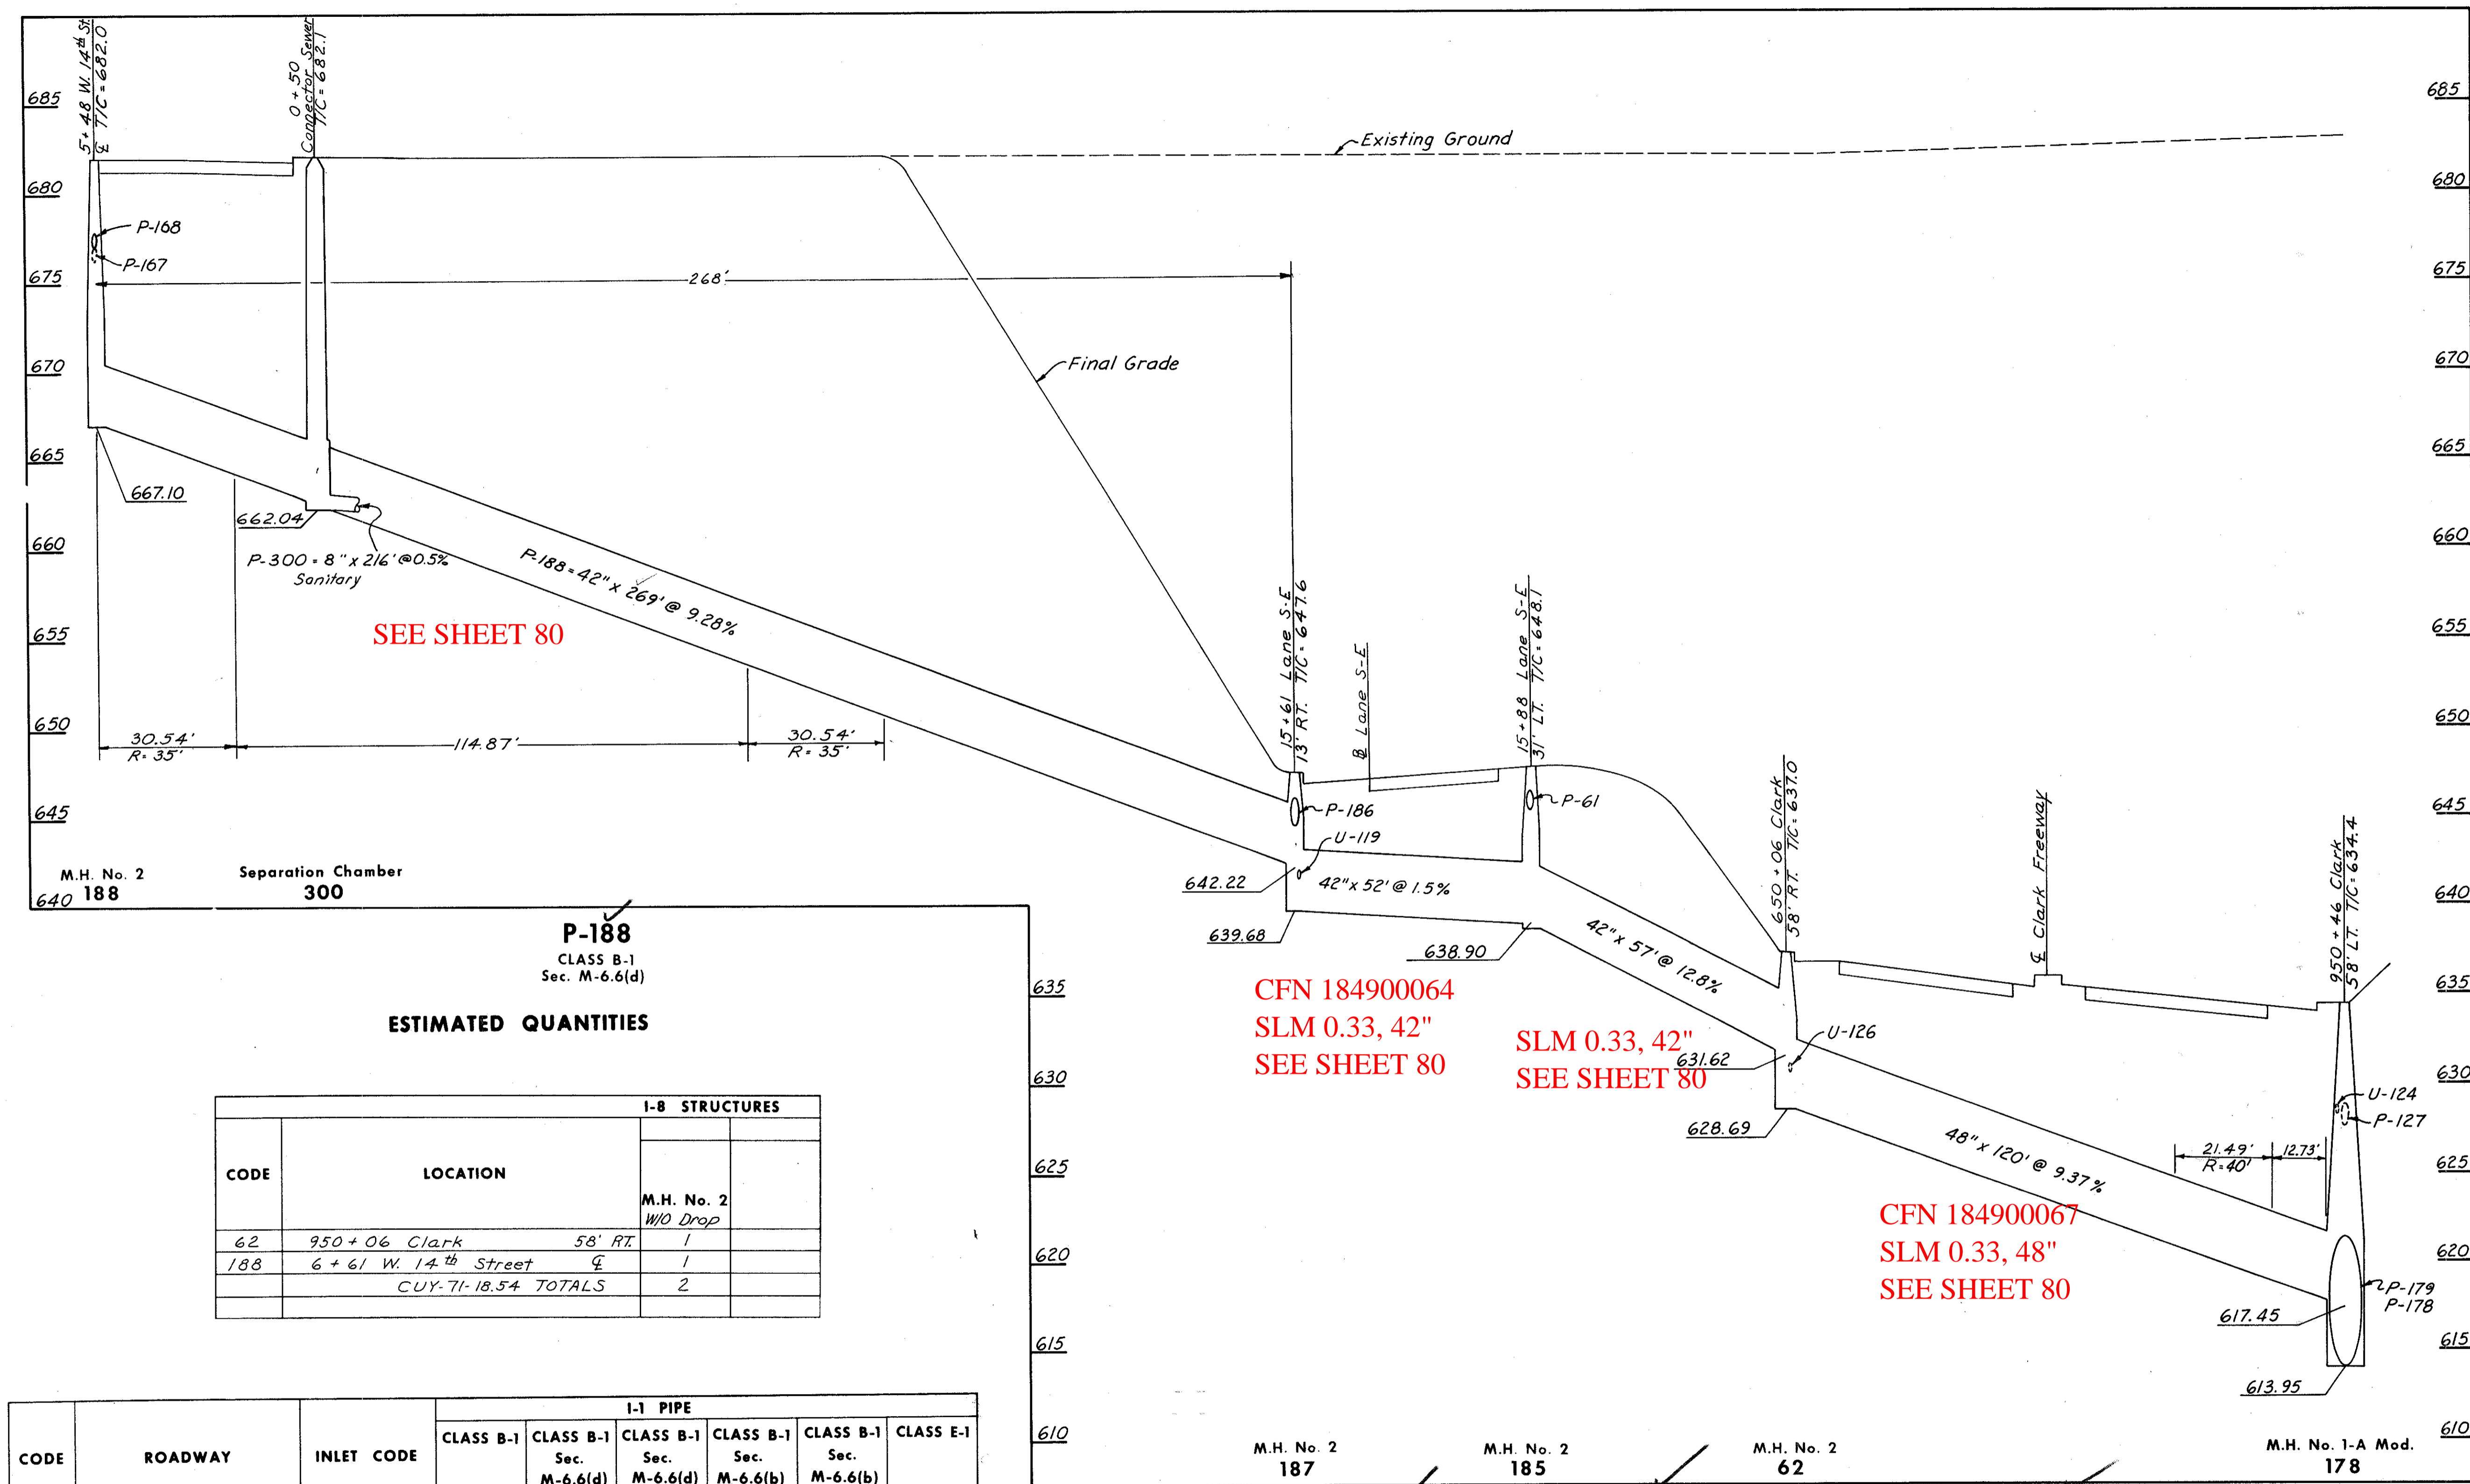

SEE SHEET 80

CFN 18490064
SLM 0.33, 42"
SEE SHEET 80

SLM 0.33, 42"
SEE SHEET 80

CFN 18490067
SLM 0.33, 48"
SEE SHEET 80

ESTIMATED QUANTITIES

I-B STRUCTURES			
CODE	LOCATION	M.H. No. 2	W/O Drop
62	950+06 Clark	58' RT	1
188	6+61 W. 14 th Street	4	1
CUY-71-18.54 TOTALS			2

CODE	ROADWAY	INLET CODE		I-1 PIPE					
		FROM	TO	CLASS B-1	CLASS B-1	CLASS B-1	CLASS B-1	CLASS B-1	CLASS E-1
P-62	Clark Freeway	62	178	42"	42"	42" R=35'	48"	48" R=40'	42"
P-185	LANE S-E	185	62						57"
P-187	LANE S-E	187	185	52"					
P-188	W 14 th Street	188	187		205'	64"			
CUY-71-18.54 TOTALS				52"	205'	64"	100'	20"	57"

P-62, P-185,
P-187, and P-188
SEWER PROFILES