
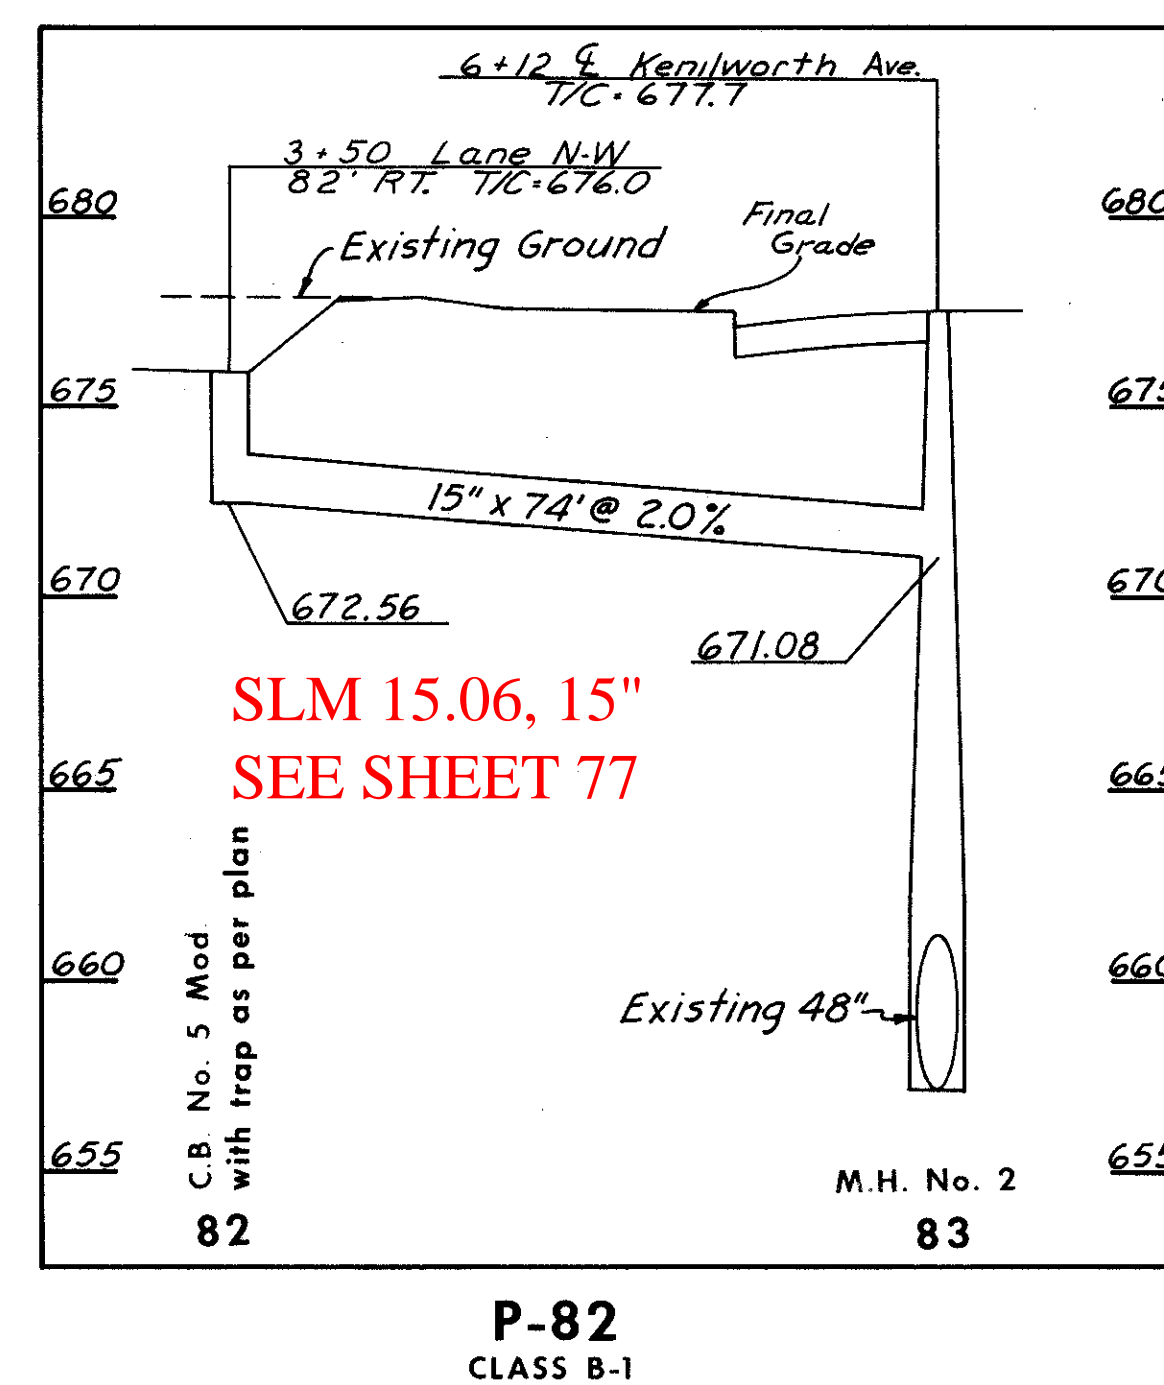
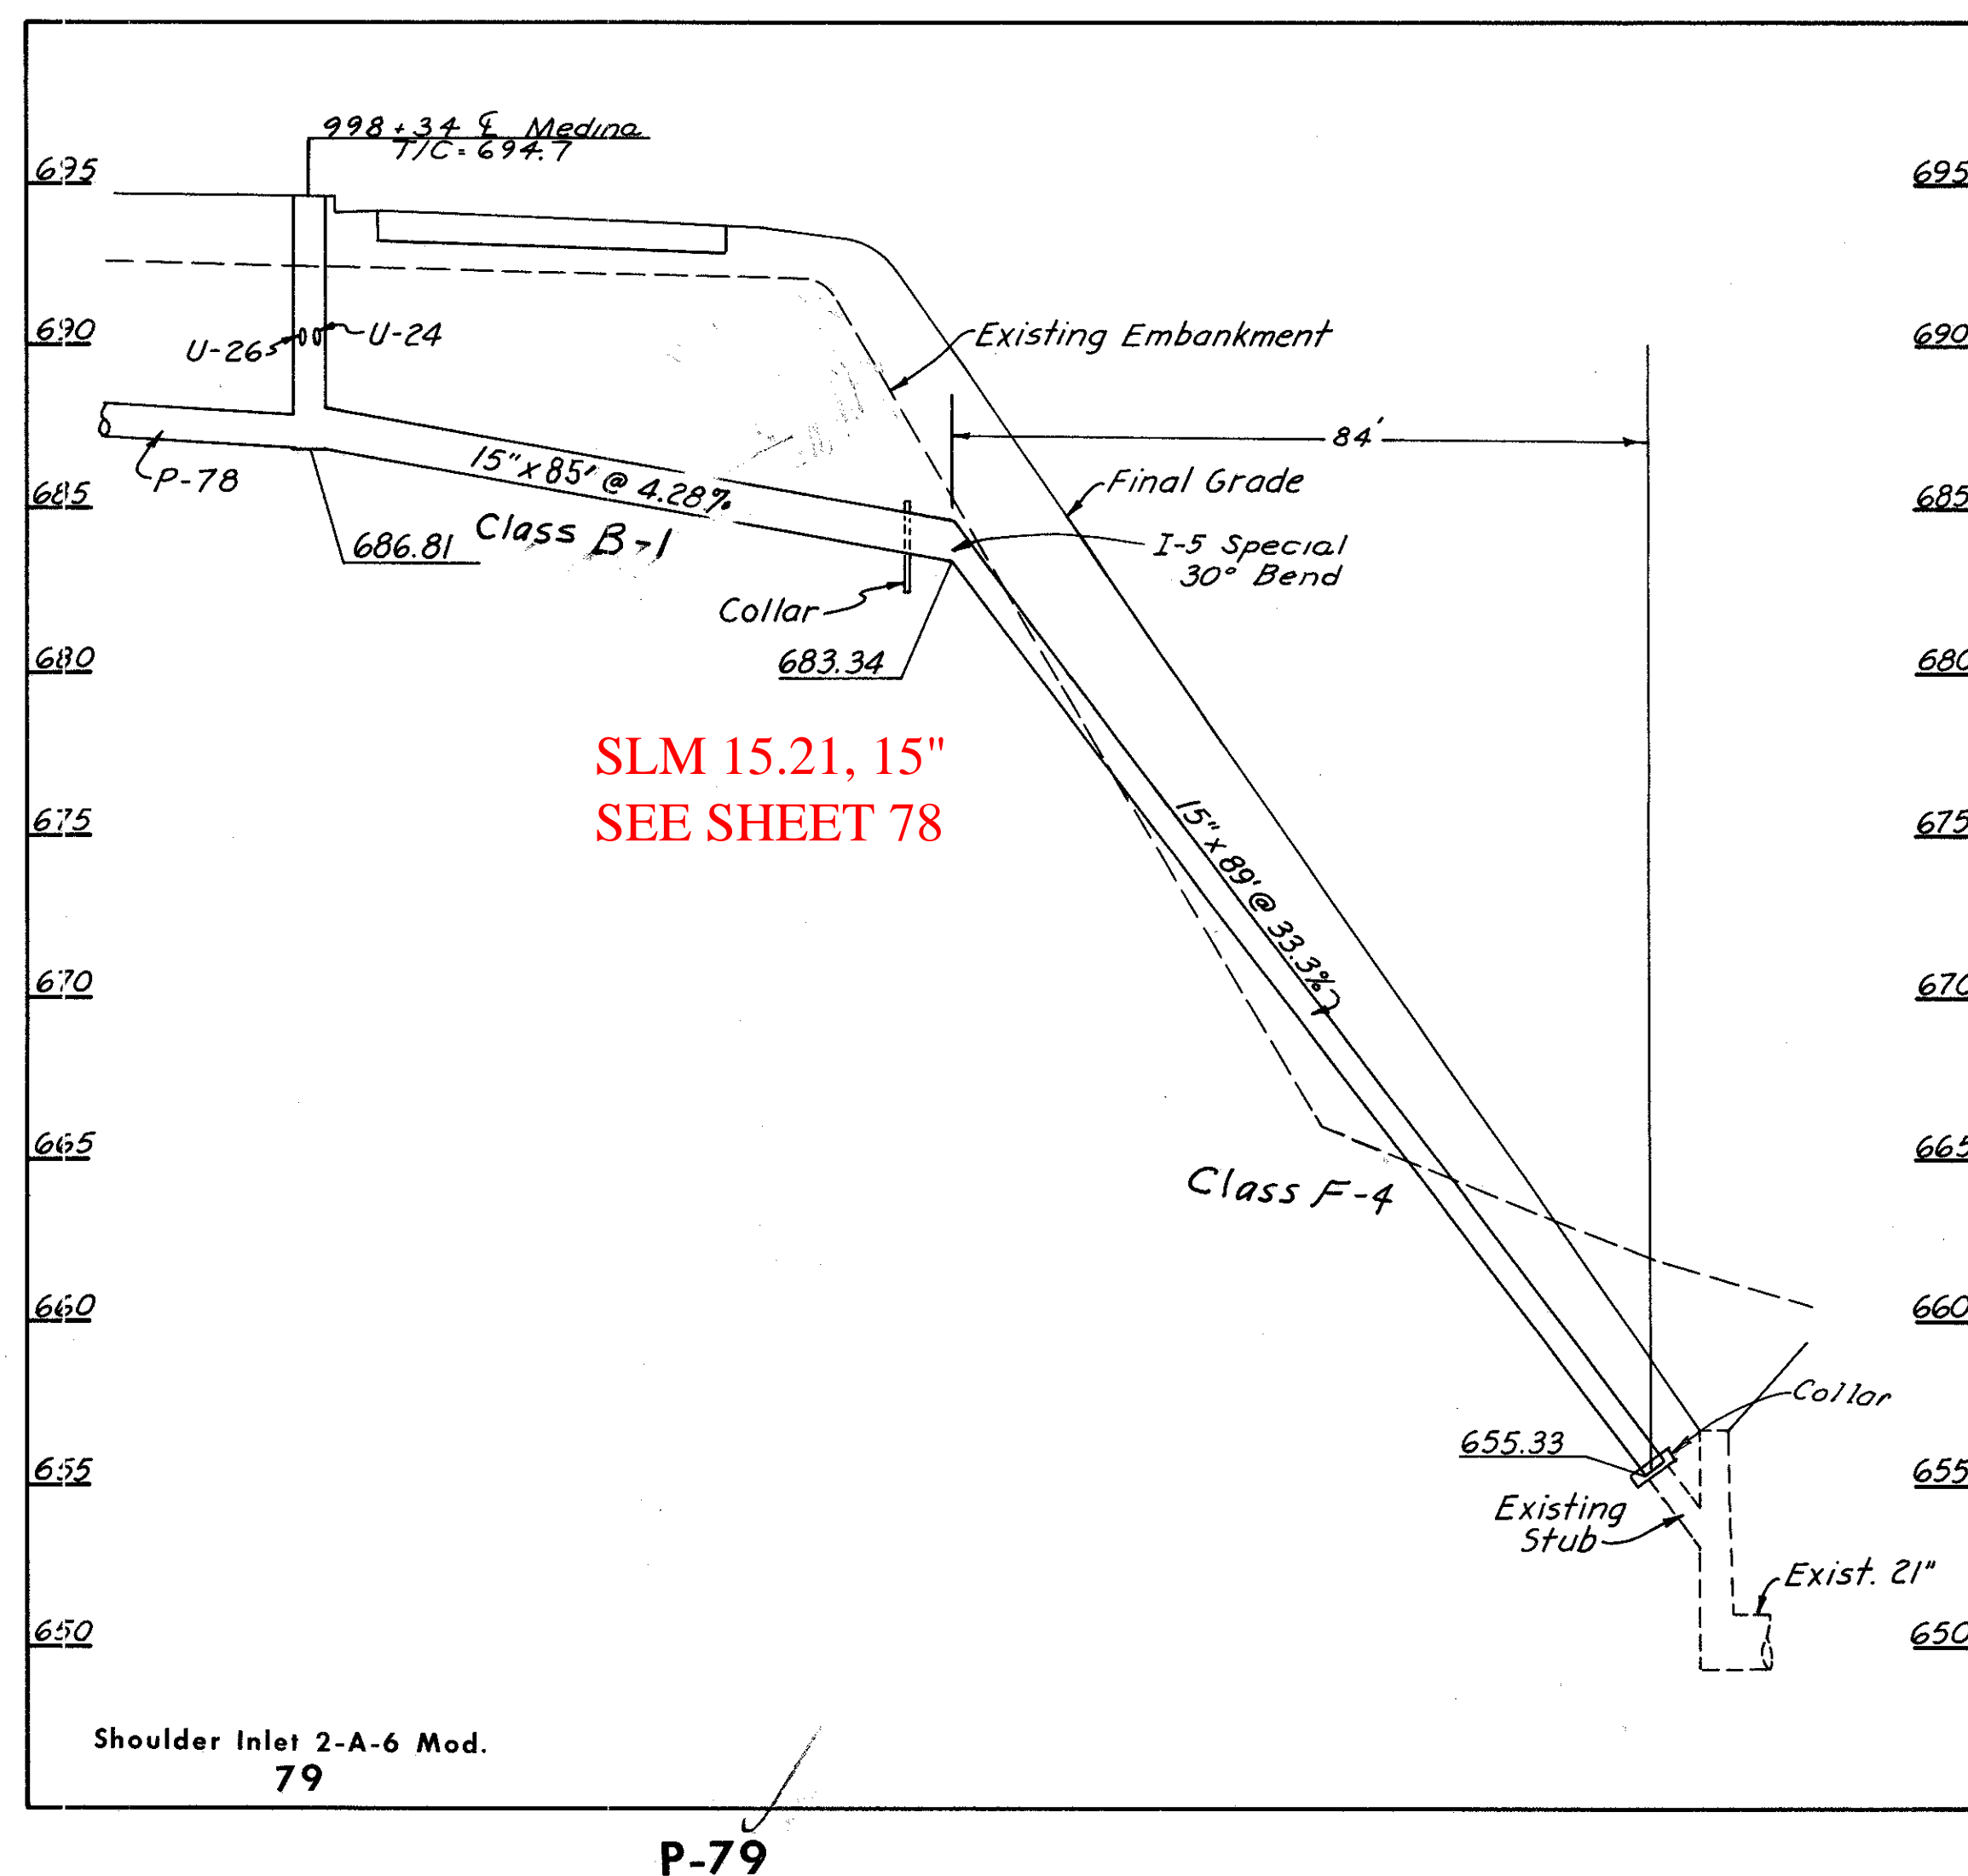


CUYAHOGA COUNTY
CITY OF CLEVELAND
MEDINA-CLARK INTERCHANGE
CUY-71-18.54
CUY-90-13.81

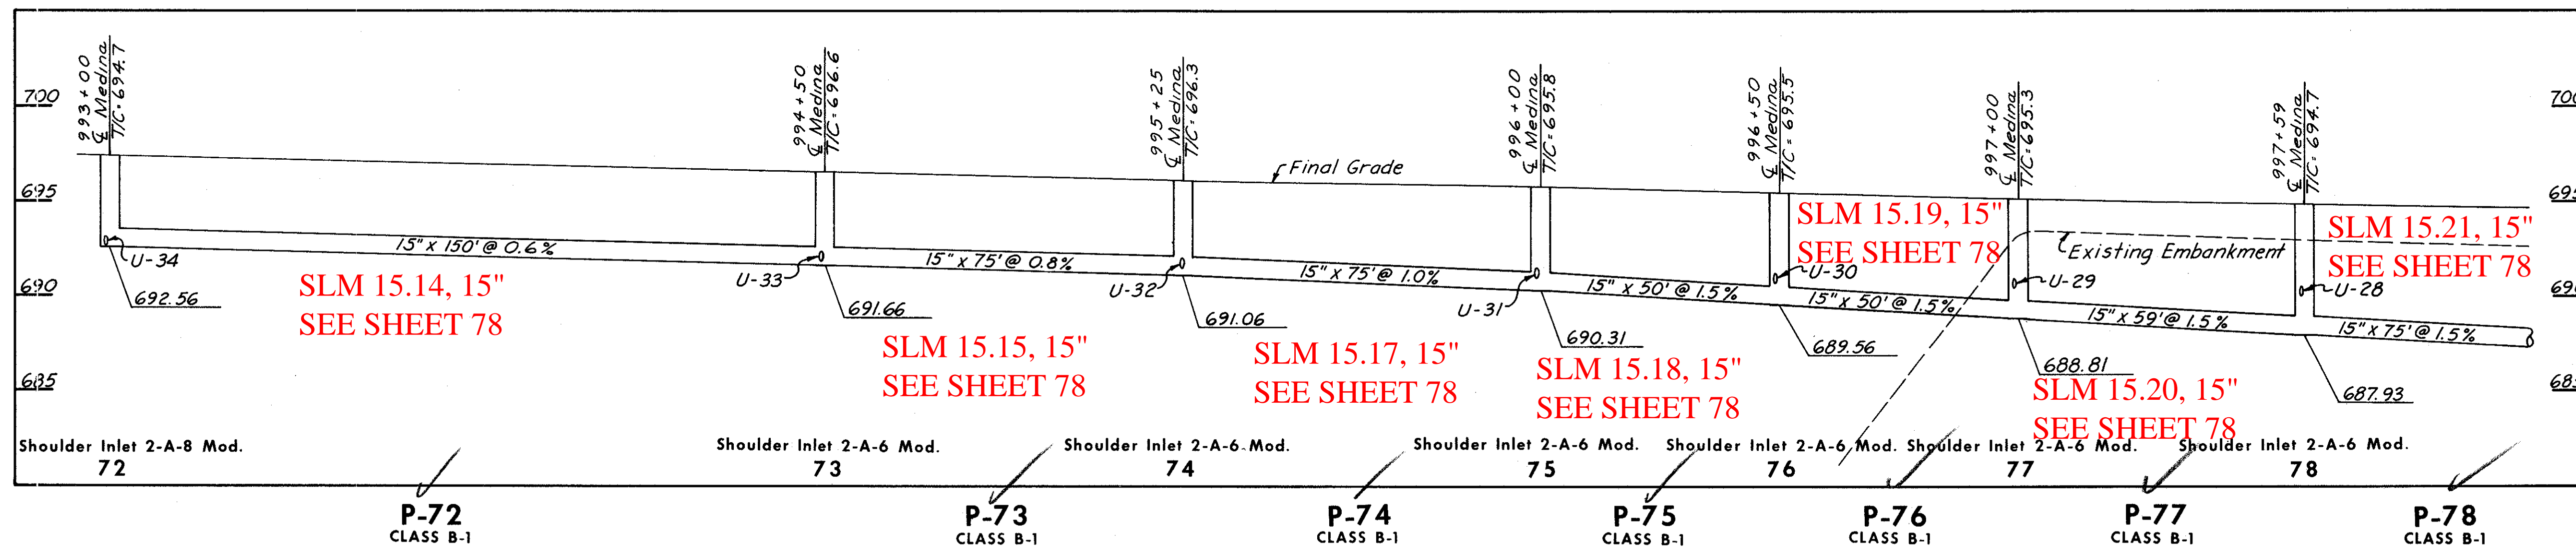

ESTIMATED QUANTITIES

I-8 STRUCTURES					
CODE	LOCATION	Shoulder Inlet 2-A-6 Mod.	Shoulder Inlet 2-A-8 Mod.	C.B. 5 Mod. with trap	M.H. No. 2
72	993+00 Medina Freeway	1 *			
73	994+50 Medina Freeway	1 *			
74	995+25 Medina Freeway	1 *			
75	996+00 Medina Freeway	1 *			
76	996+50 Medina Freeway	1 *			
77	997+00 Medina Freeway	1 *			
78	997+59 Medina Freeway	1 *			
79	998+34 Medina Freeway	1 *			
82	3+50 Lane N-W 82' RT *			1 *	
83	6+12 Kenilworth Avenue				1 *
CUY-90-13.81 TOTALS		7 *	1 *	1 *	1 *

CODE	ROADWAY	INLET CODE		I-1 Pipe	I-5 Pipe	I-1 Pipe
		FROM	TO	CLASS B-1	Class F-4 Sec. M-6.4(c) Special 15" x 30"	Class F-4 M-6.4(c) 15"
P-72	Medina Freeway *	72	73	150' *		
P-73	Medina Freeway *	73	74	75' *		
P-74	Medina Freeway *	74	75	75' *		
P-75	Medina Freeway *	75	76	50' *		
P-76	Medina Freeway *	76	77	50' *		
P-77	Medina Freeway *	77	78	59' *		
P-78	Medina Freeway *	78	79	75' *		
P-79	Medina Freeway *	79	Ditch	85' *	1 *	89' *
P-82	Lane N-W *	82	83	74' *		
CUY-90-13.81 Totals				693' *	1 *	89' *