
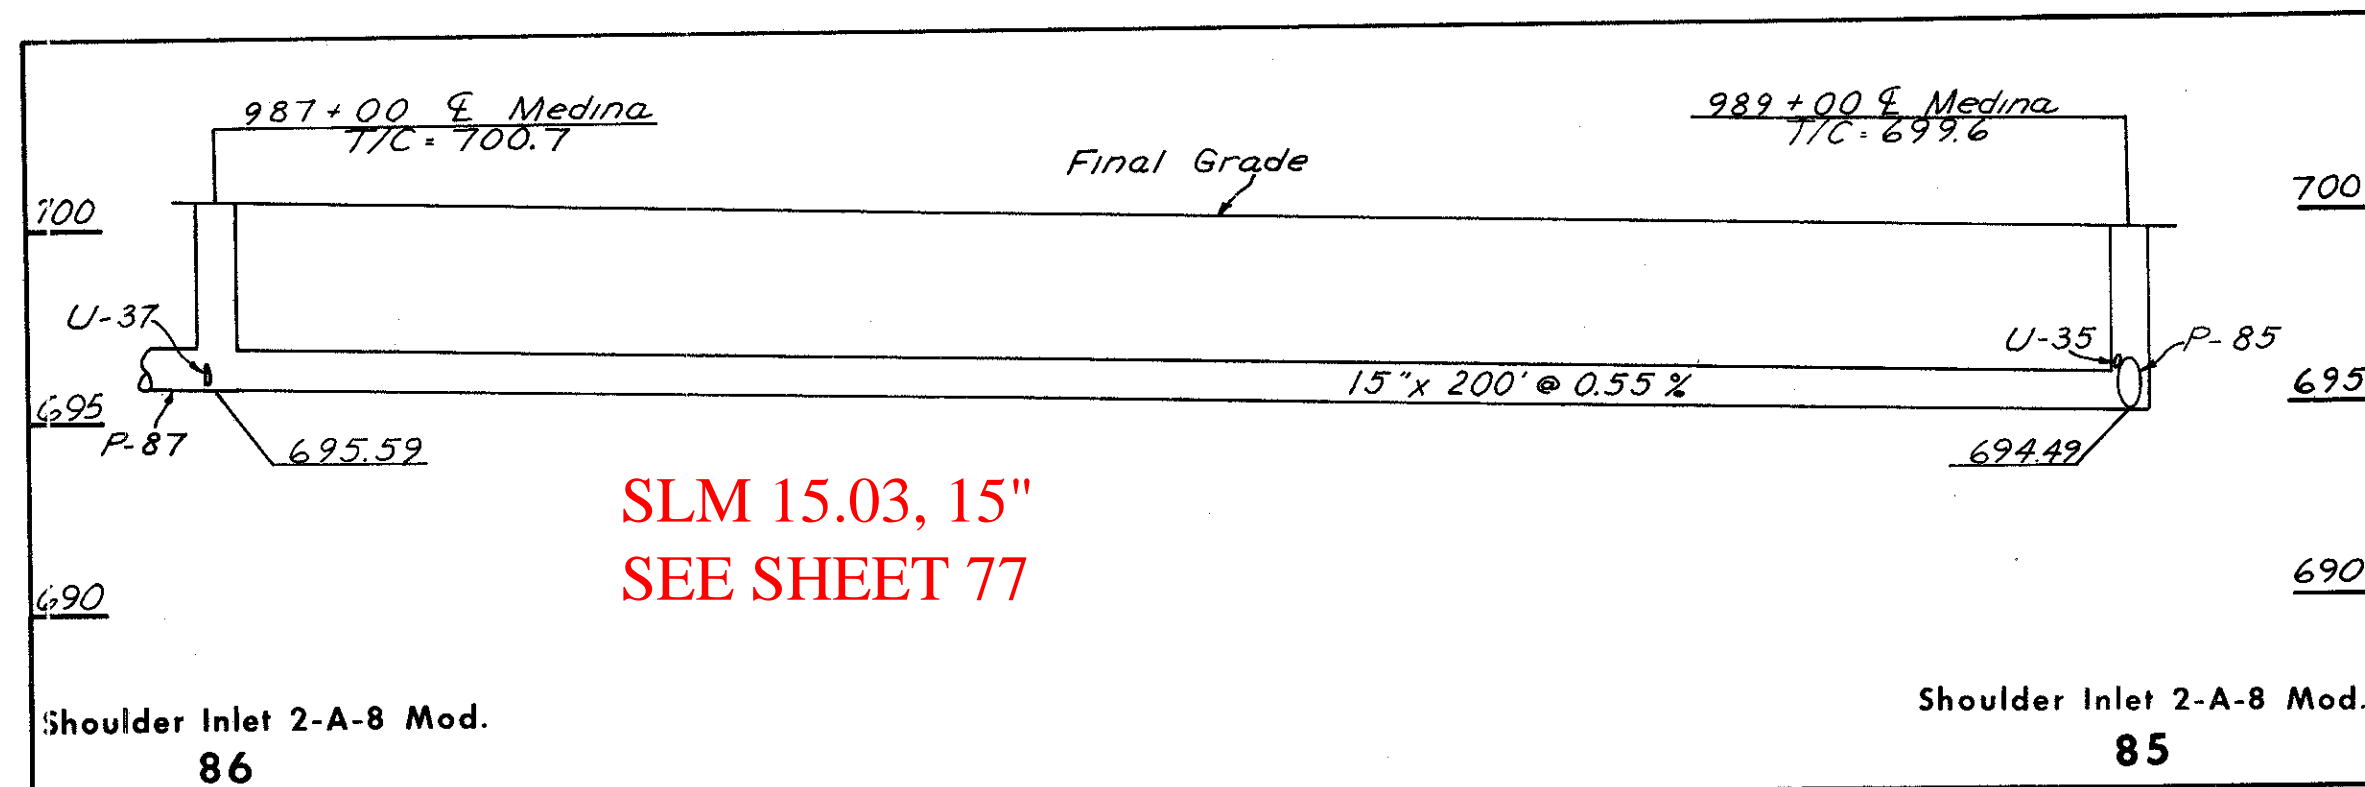
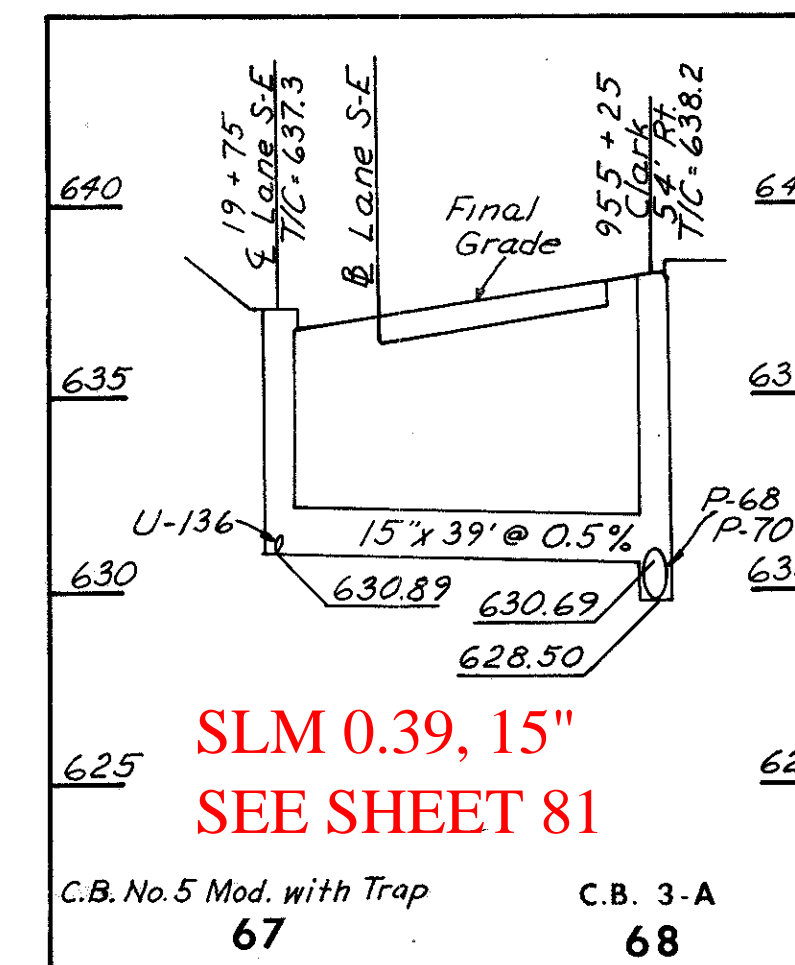


CUYAHOGA COUNTY
CITY OF CLEVELAND
MEDINA-CLARK INTERCHANGE
CUY-71-18.54
CUY-90-13.81

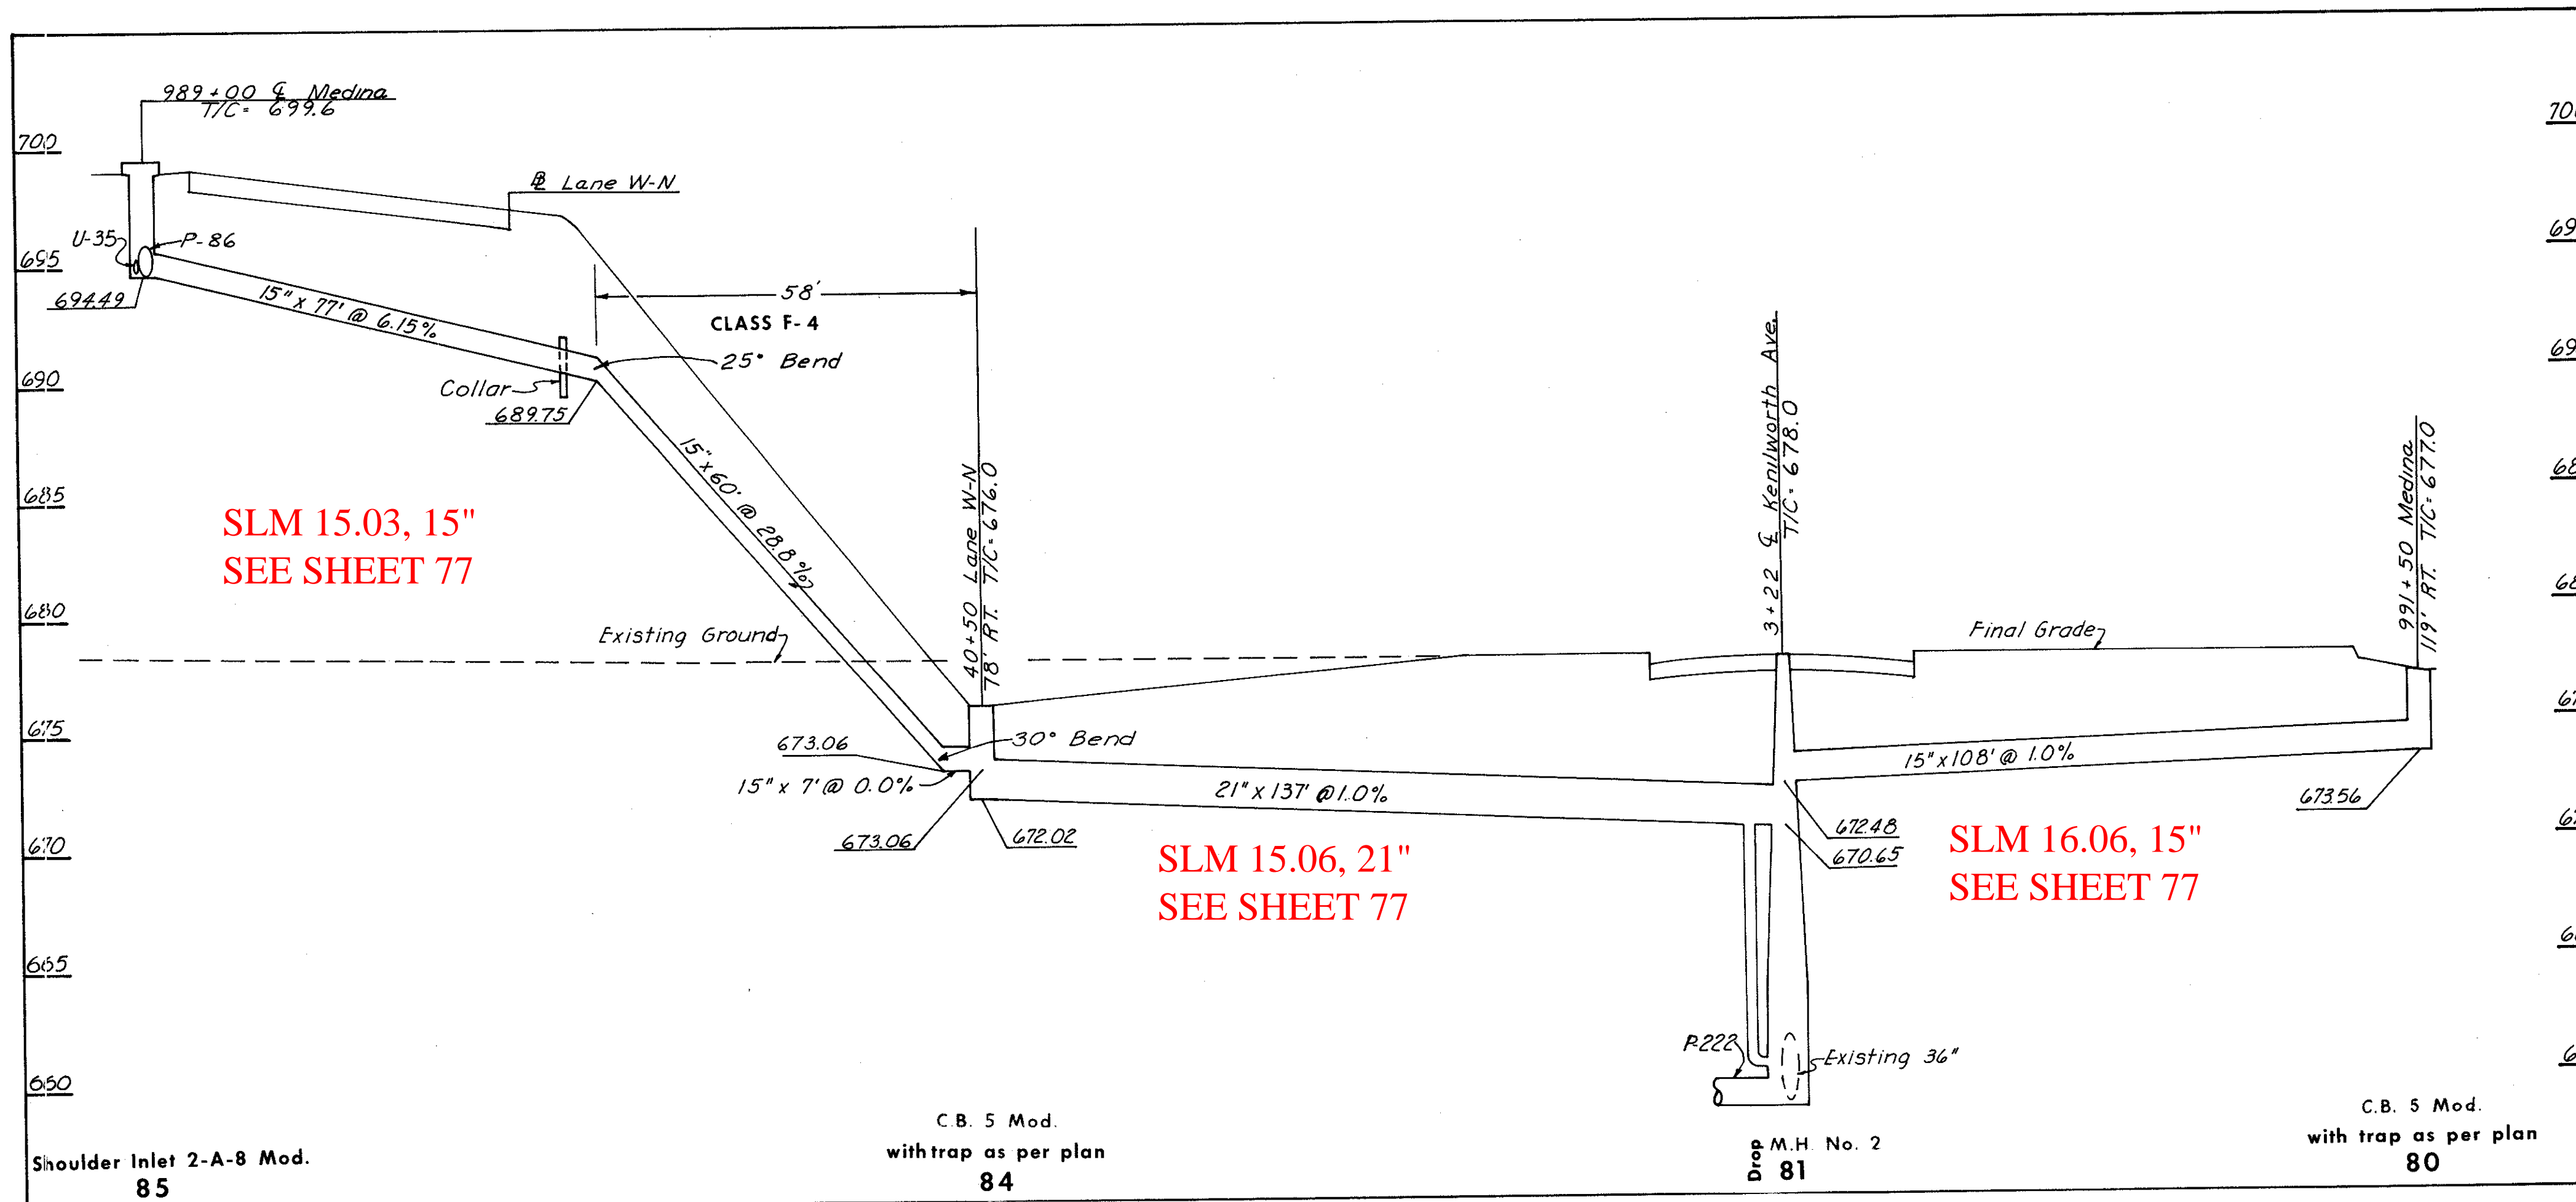

ESTIMATED QUANTITIES

CODE	LOCATION	I-8 STRUCTURES			
		Shoulder Inlet 2-A-8 Mod.	Shoulder Inlet 2-A-10	C.B. 5 Mod. with trap	M.H. No. 2 with drop
67	19+75 Lane S-E			1	
80	991+50 Medina Freeway			1*	
81	3+22 Kenilworth Avenue				1*
84	40+50 Lane W-N			1*	
85	989+00 Medina Freeway	1*			
86	987+00 Medina Freeway		1*		
CUY-71-18.54 TOTALS				1	
CUY-90-13.81 TOTALS		1*	1*	2*	1*

CODE	ROADWAY	INLET CODE		I-1 Pipe			I-5 Pipe Specials	
		FROM	TO	CLASS B-1	CLASS F-4	CLASS B-1	CLASS F-4	CLASS F-4
P-67	Lane S-E	67	68	39'	✓			
P-80	Medina Freeway*	80	81	108'	✓			
P-84	Lane W-N*	84	81			137'*		
P-85	Medina Freeway*	85	84	77'*	✓	67'*	✓	1
CUY-71-18.54 TOTALS					39'			
CUY-90-13.81 TOTALS					185'*	67'*	137'*	1*

CODE	ROADWAY	INLET CODE		I-1 Pipe
		FROM	TO	CLASS E-1
P-86	Medina Freeway*	86	85	200'*
CUY-90-13.81 TOTALS				200'*

P-67, P-80,
P-84 thru P-86
SEWER PROFILES