


CFN 280870816  
SLM 8.16, 4'x2'  
CONCRETE BOX  
SEE SHEET 7  
AND 79

**UTILITIES INVOLVED**  
The Cleveland Electric Illuminating Co.  
Western Reserve Telephone Co.  
Scale 1"=50'

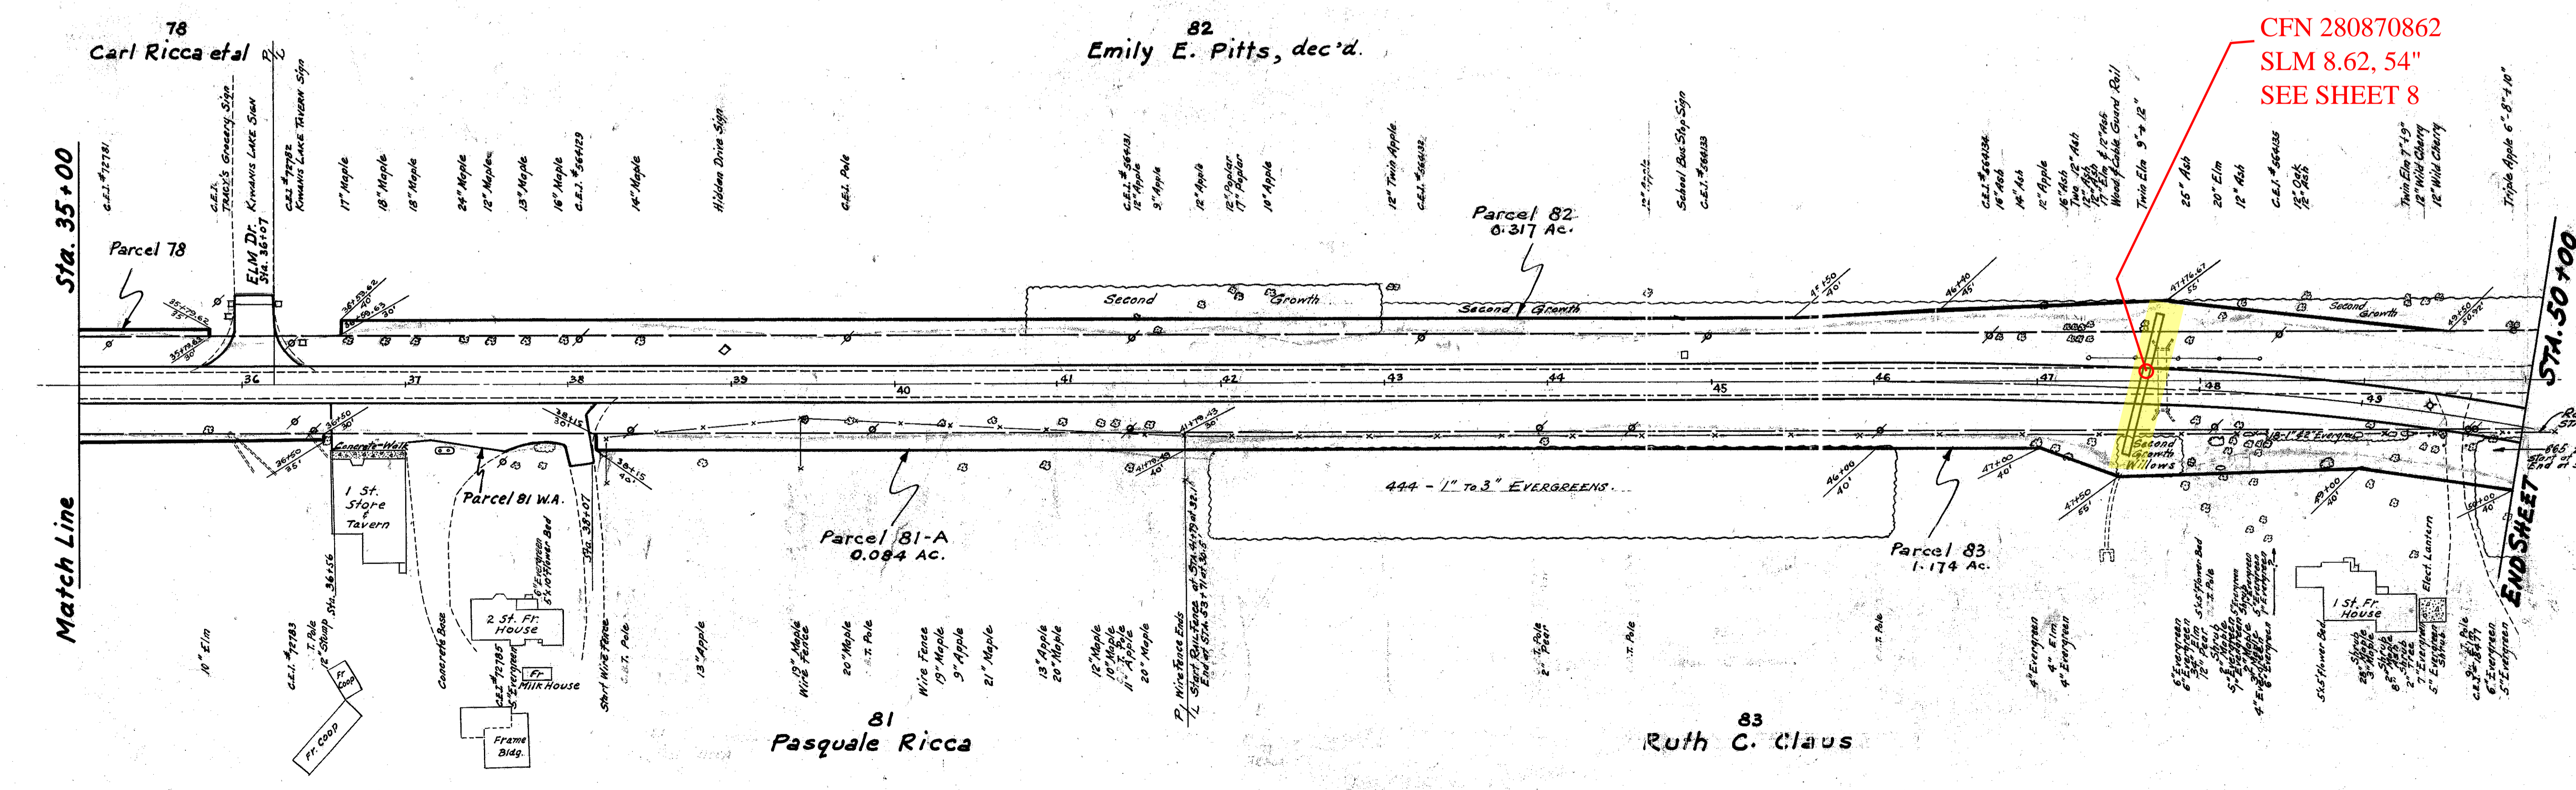

CFN 280870862  
SLM 8.62, 54"  
SEE SHEET 8