


FED. RD. DIVISION	STATE	PROJECT
2	OHIO	LAK-1-1038

302
306

LAK-1-1038
R/W PLAN
LIMITED ACCESS

7
11

CFN 430901274
SLM 12.74, 66"
SEE SHEET 21,
24 AND 263

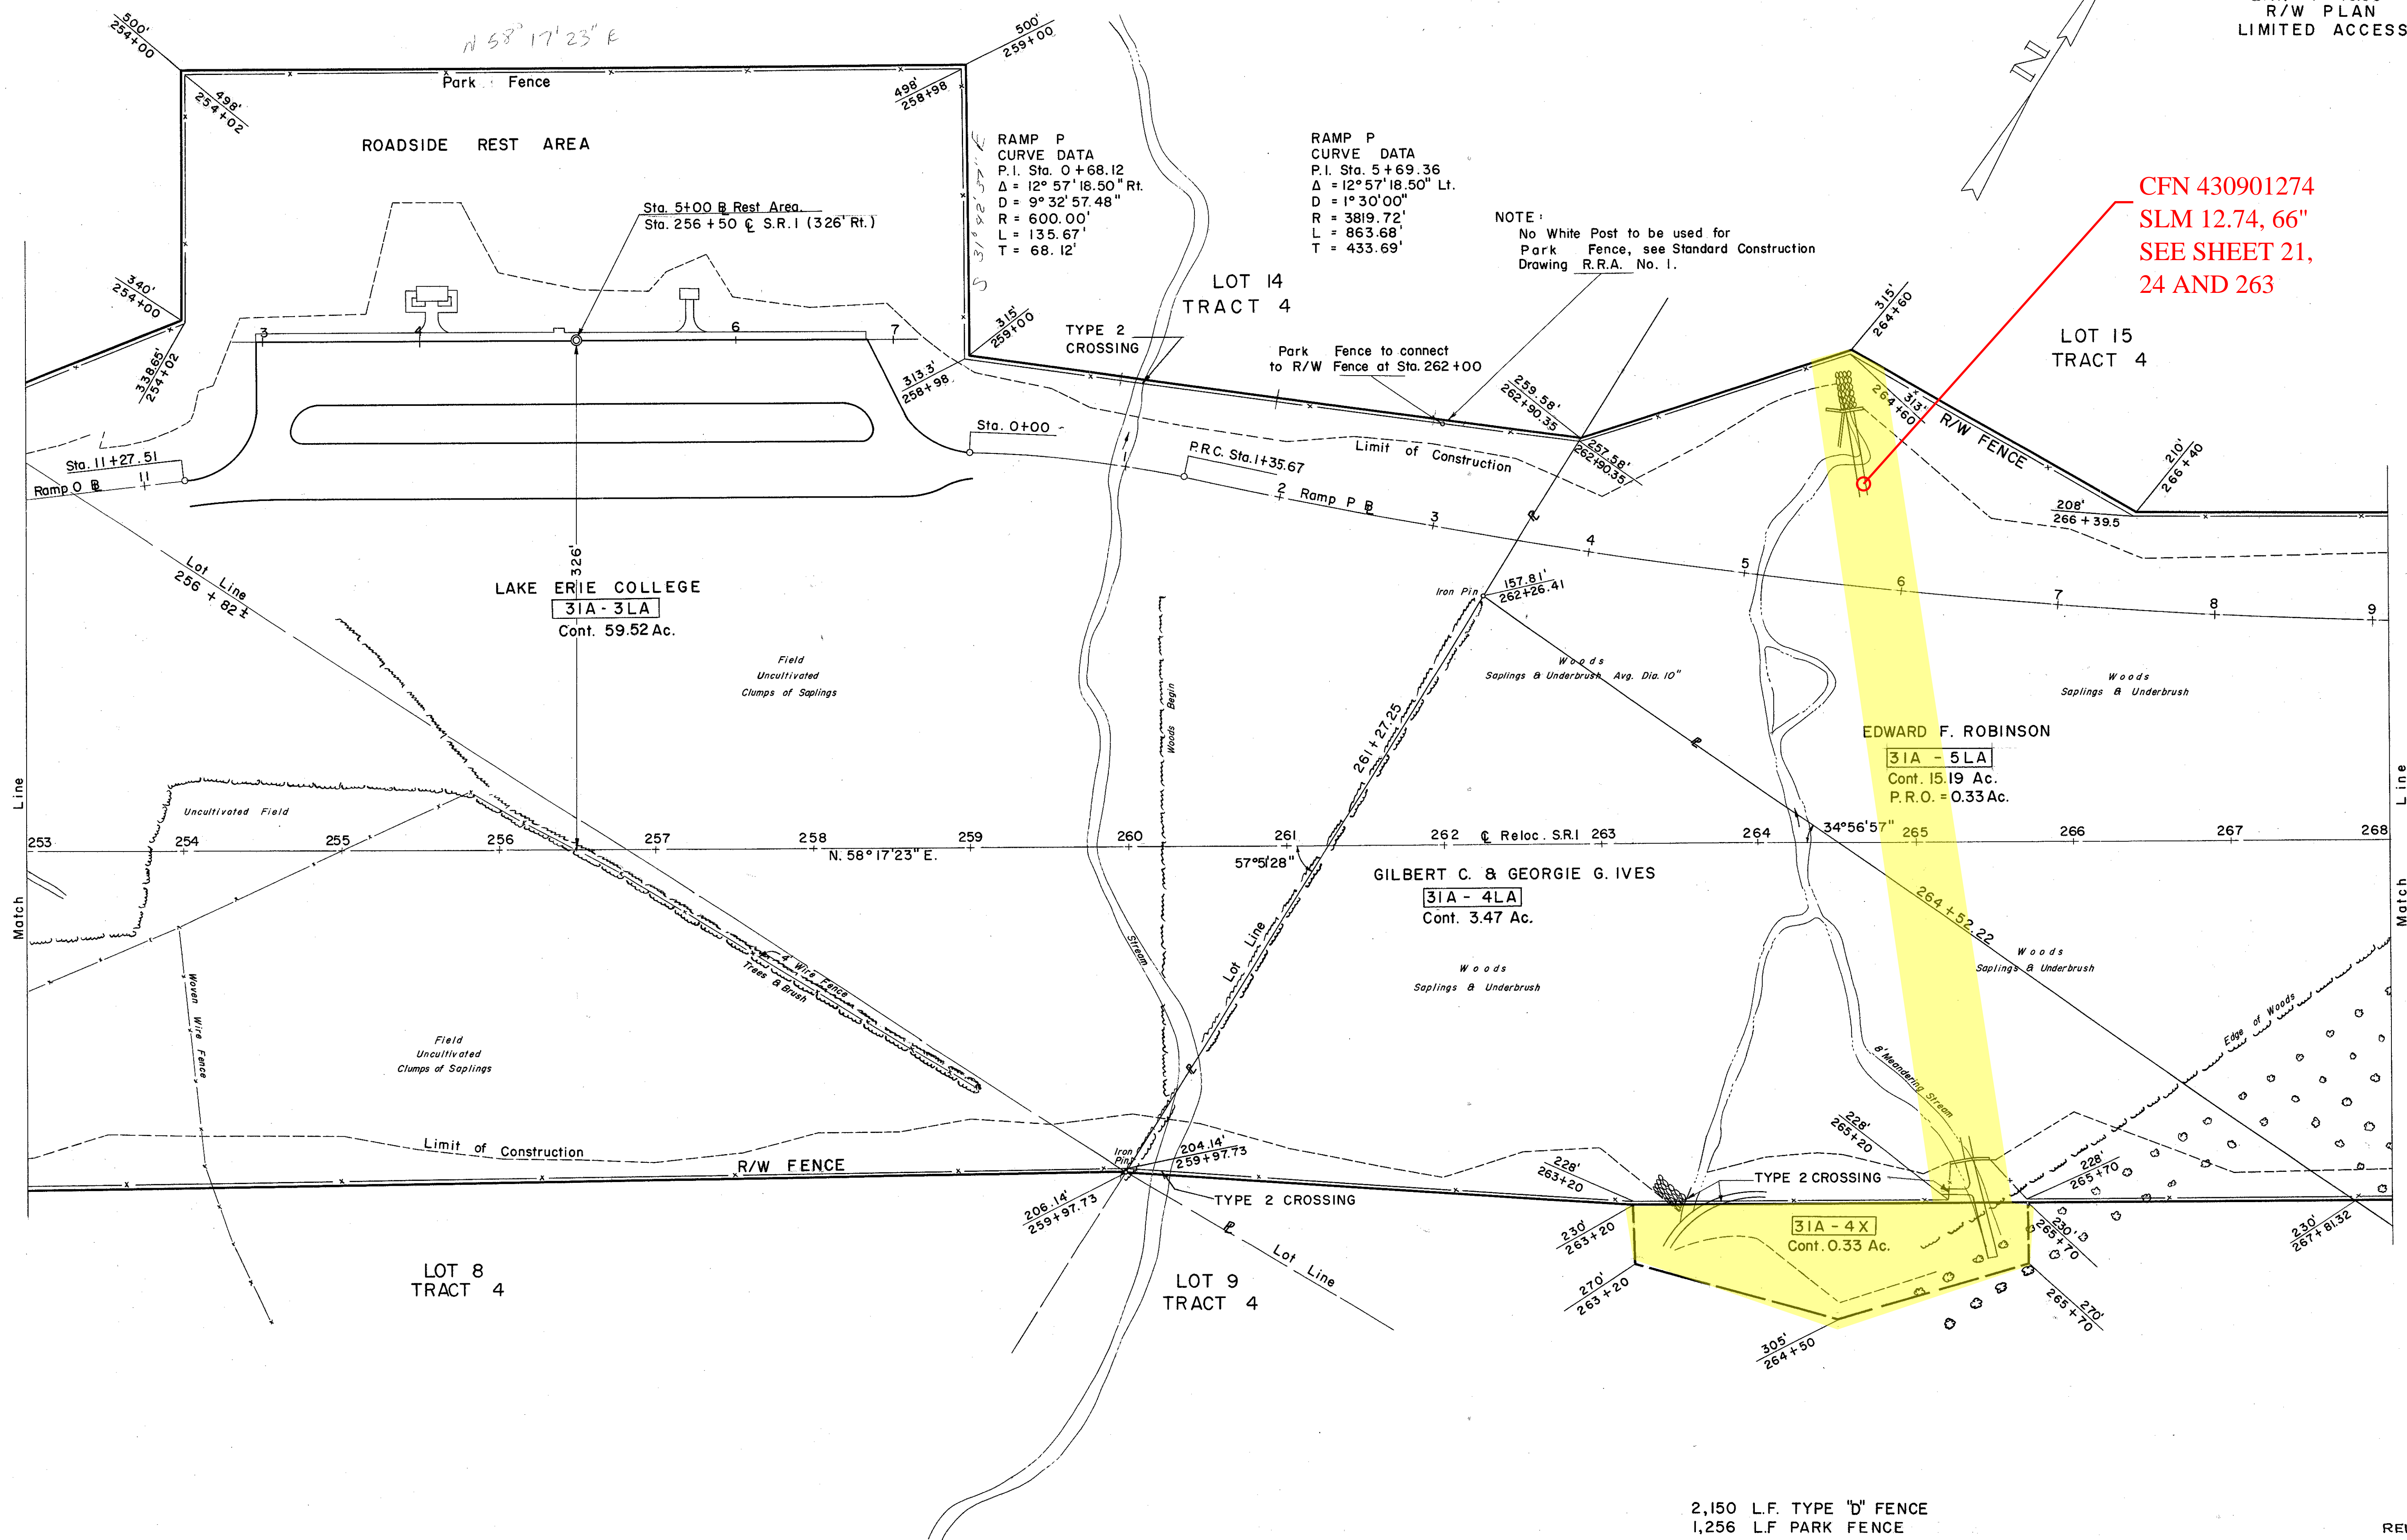

2,150 L.F. TYPE "b" FENCE
1,256 L.F. PARK FENCE