


CUYAHOGA COUNTY
CUY-71-10.16



FOR STORM SEWER PLAN VIEWS, See Sht. No 45

ESTIMATED QUANTITIES																	
PIPE REF	STRUCTURES INCLUDED	PIPE															
		I-1					I-2	I-5 PIPE			I-8					L-10	I-10
		CL. J-1	CL. B-1	CL. J-1	CLASS B-1	CL. F-4	MASONRY CL. F-4 15'x30' BEND	SPECIAL	STD.	STD. MOD.	1st B-1 Man	STD.	STD. NO. 5	SODDING SQ. YDS	DUMPED ROCK CHAN- NEL PROTECTION CU. YDS		
		12"	15"	15"	12" SEC. M-24"	15"		CL. F-4	NO. 2	NO. 2-8	NO. 2-10	NO. 2-4-12	CATCH				
		SEC. M-66(a)	SEC. M-66(d)	6.6(b) or 6.8(b)	SEC. M-66(c)	15'x30' BEND		MANHOLE	INLET	INLET	INLET	BA51N					
Under R.R.	L I N.	F.T.					Cu. Yds	EACH	EACH								
P-1	I-1 & H-1		70														
P-2	I-3		63				0.3			1					4	4	
P-3	I-4		82														
P-4	C-1 & H-2			113			39	0.3	2						4	6	
P-5	-	25															
P-6	C-2				43										1		
P-7	M-1					42				1							
P-8	M-2					107				1							

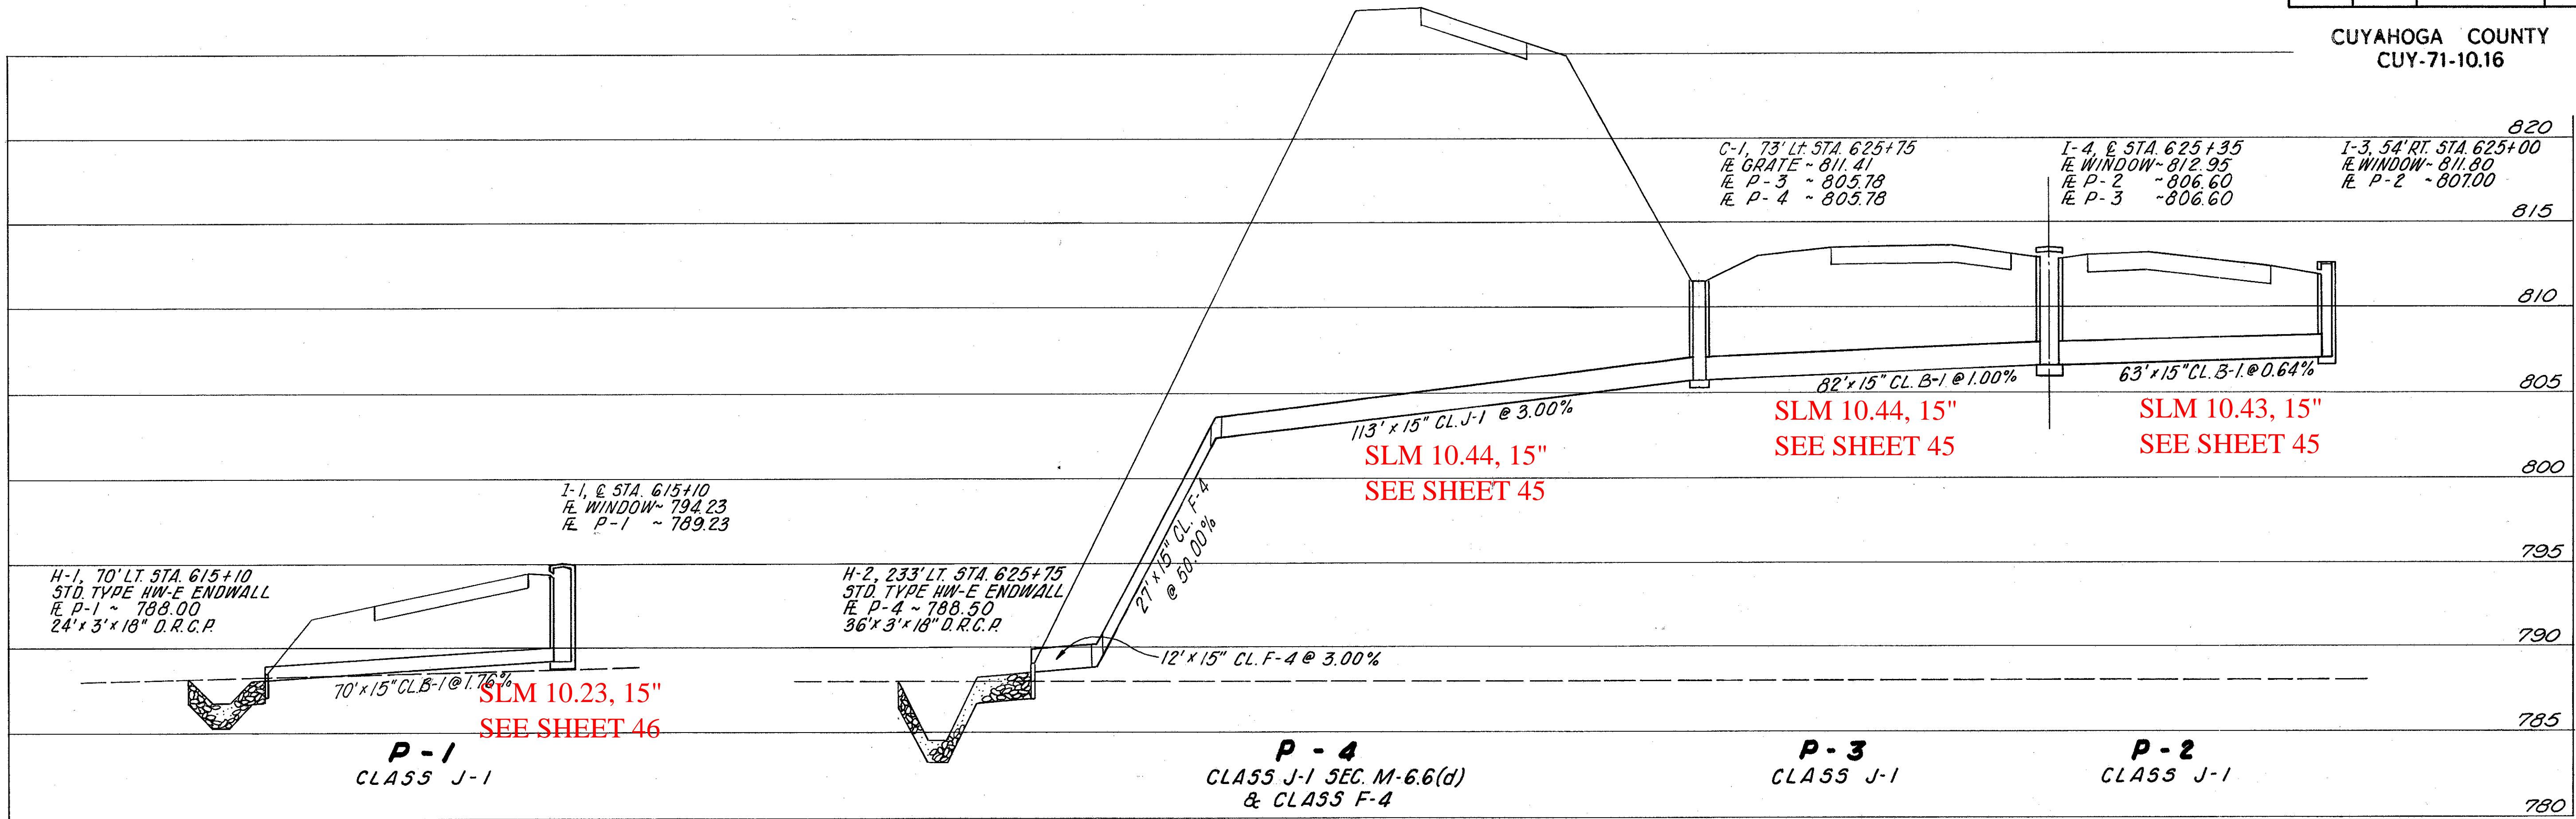