


LEGEND

- ✕ 571.23 AS-BUILT DATA LOCATED 10/22/2025
- 0.12 ✕ ELEVATION DIFFERENCE BETWEEN DESIGN AND AS-BUILT DATA LOCATED 10/22/2025

Elevations Table			
Number	Minimum Elevation	Maximum Elevation	Color
1	-0.503	-0.400	Dark Red
2	-0.400	-0.300	Red
3	-0.300	-0.200	Light Red
4	-0.200	-0.100	Red-Orange
5	-0.100	0.000	Orange
6	0.000	0.100	Light Blue
7	0.100	0.200	Blue
8	0.200	0.297	Dark Blue

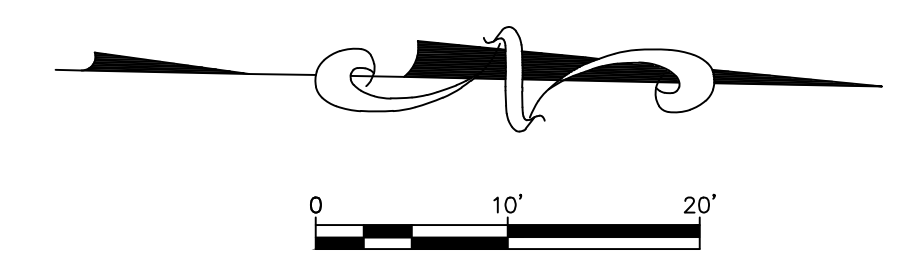

McCARTY ASSOCIATES LLC CONSTRUCTION SERVICES
 NEW POINTS IN
 ALAN STONE - GAL-7-19.94
 PAVEMENT ASBUILT
 DATE 10/22/2025
 SCALE 1" = 10'

U:\2025\25-131 Alan Stone Co. GAL-7-19.94\AutoCAD\DWG_Survey\25131_2025-10-22_EP_Asbuilt.dwg, layout1, 10/22/2025 11:58:41 PM, asb